



This document and the design it covers are the property of PARSONS. They are loaned only with the borrower's expressed written agreement that they will not be reproduced, copied, loaned, exhibited, or used in any other way, except by written consent from PARSONS to the borrower.


This document and the design it covers are the property of PARSONS. They are loaned only with the borrower's expressed written agreement that they will not be reproduced, copied, loaned, exhibited, or used in any other way, except by written consent from PARSONS to the borrower.

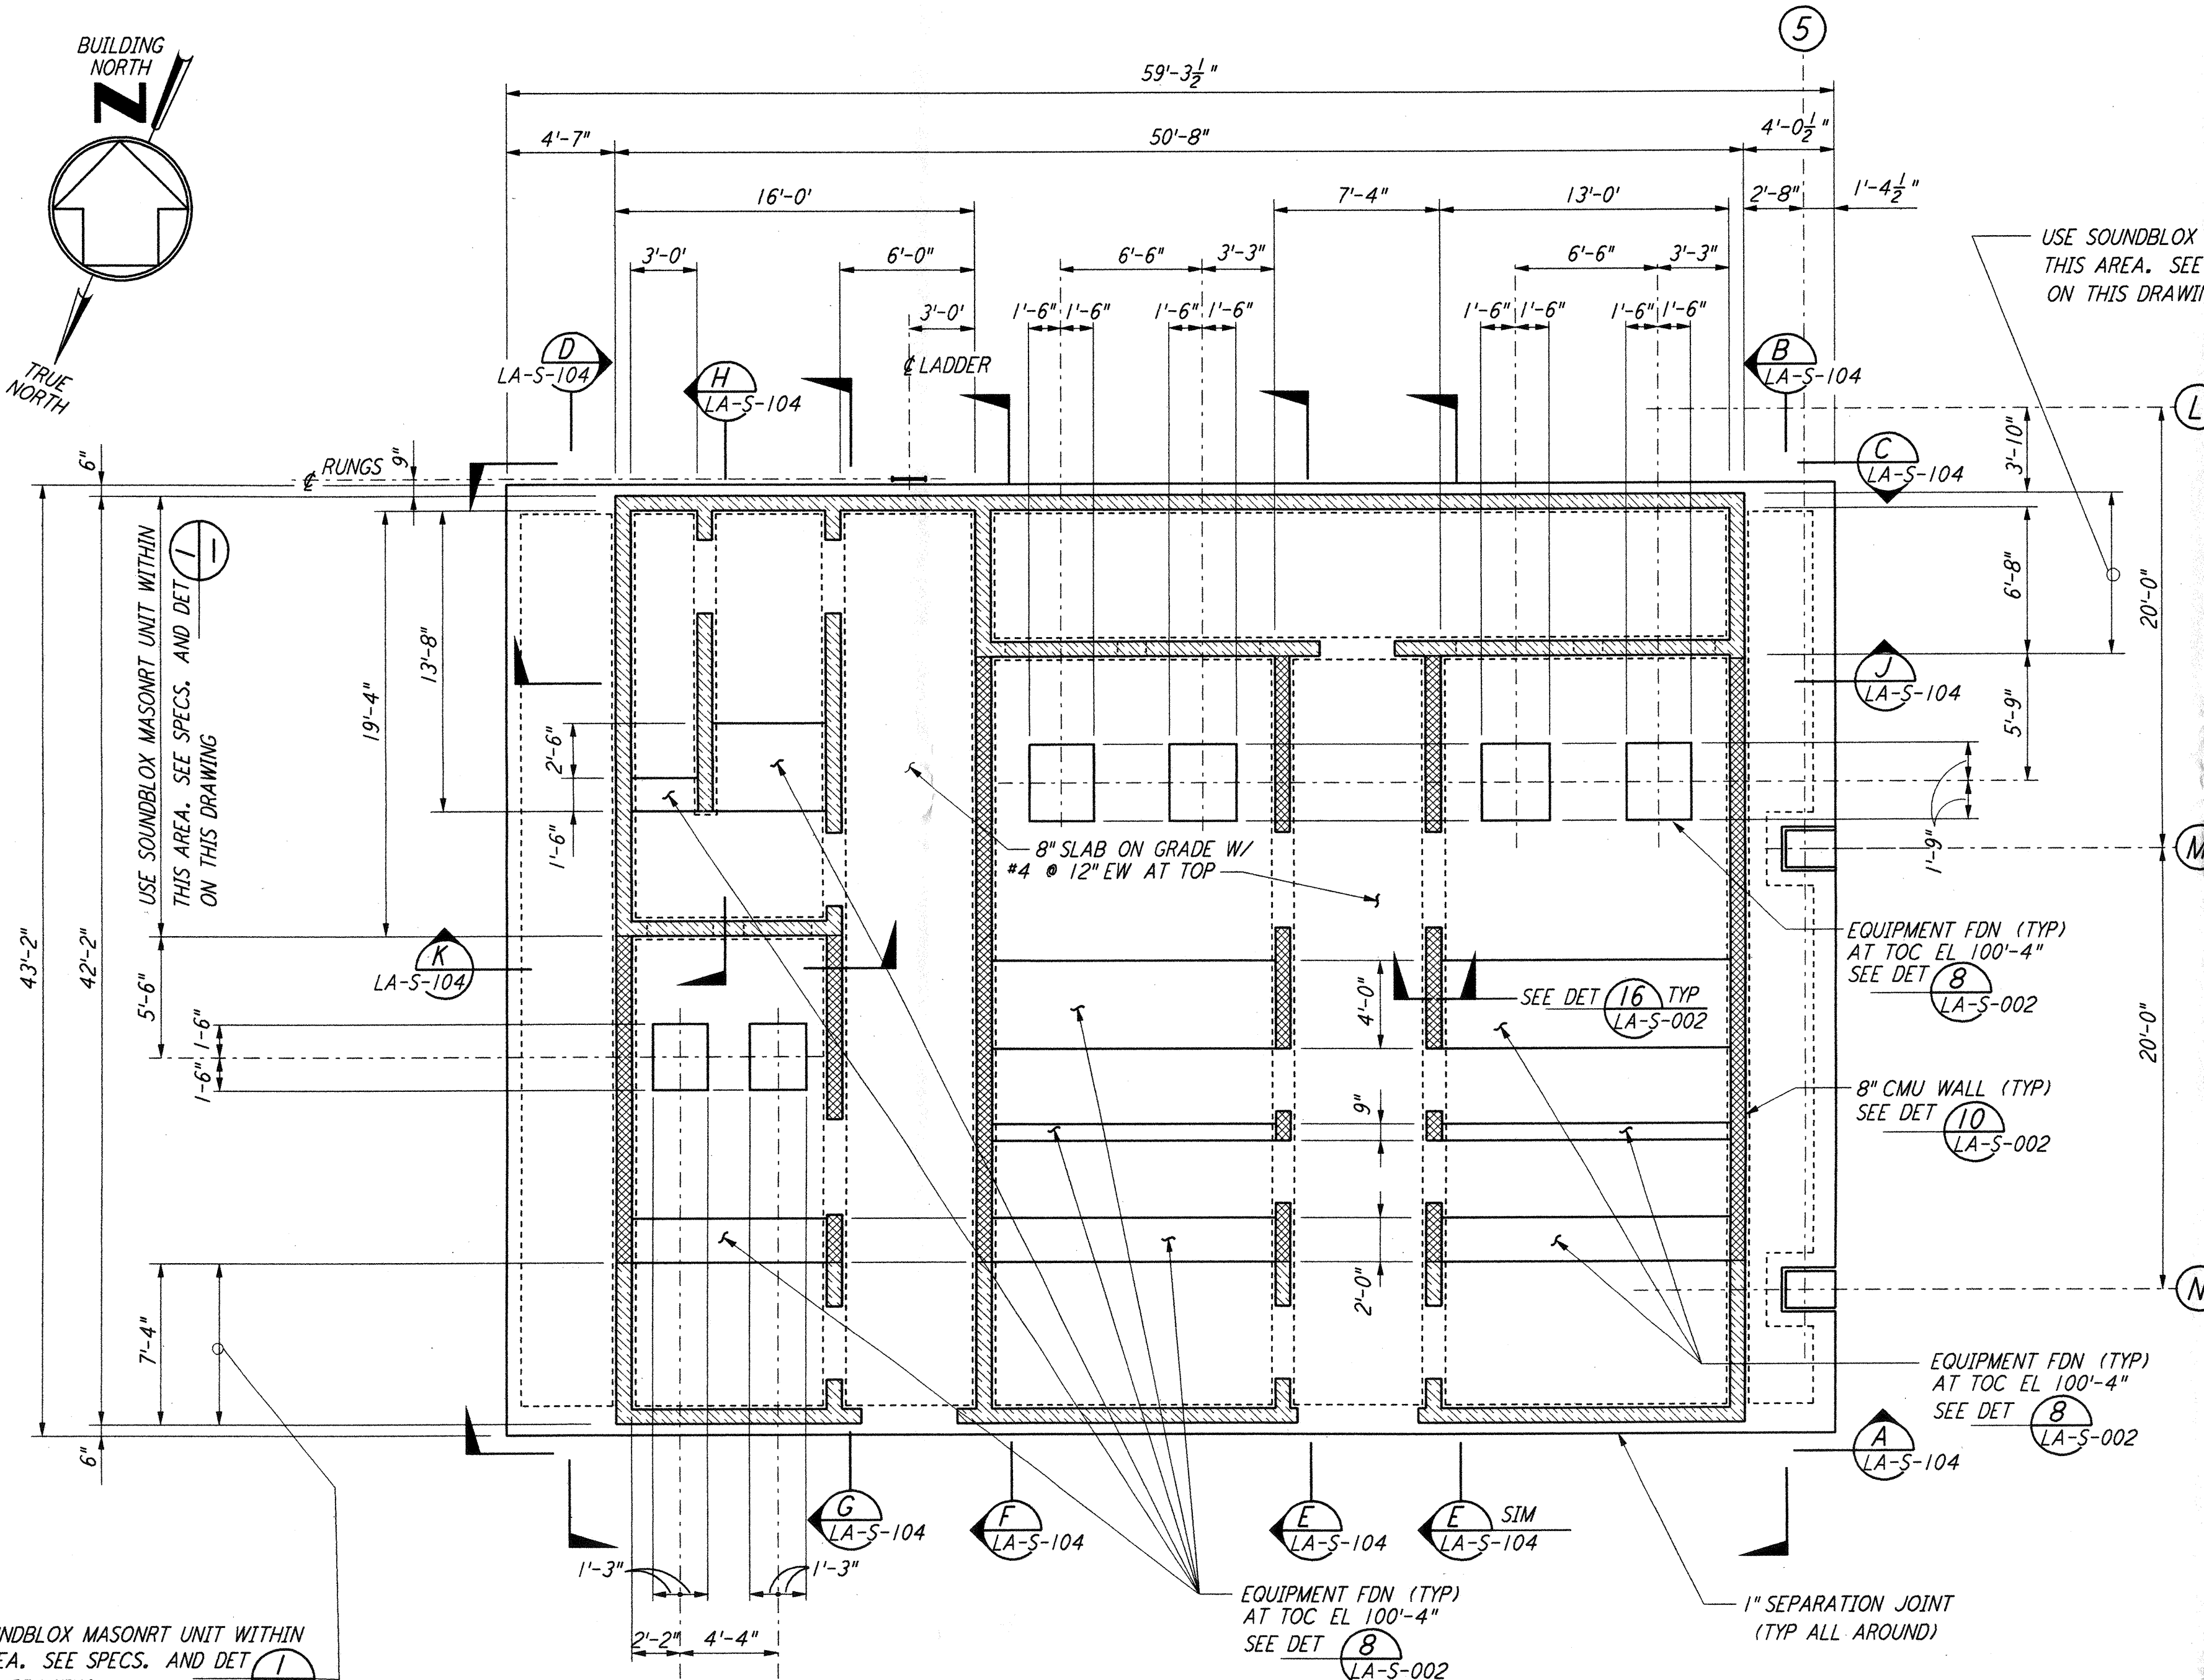


**AIR HANDLING UNIT STRUCTURE
 FOUNDATION PLAN**
 $\frac{3}{8}'' = 1'-0''$

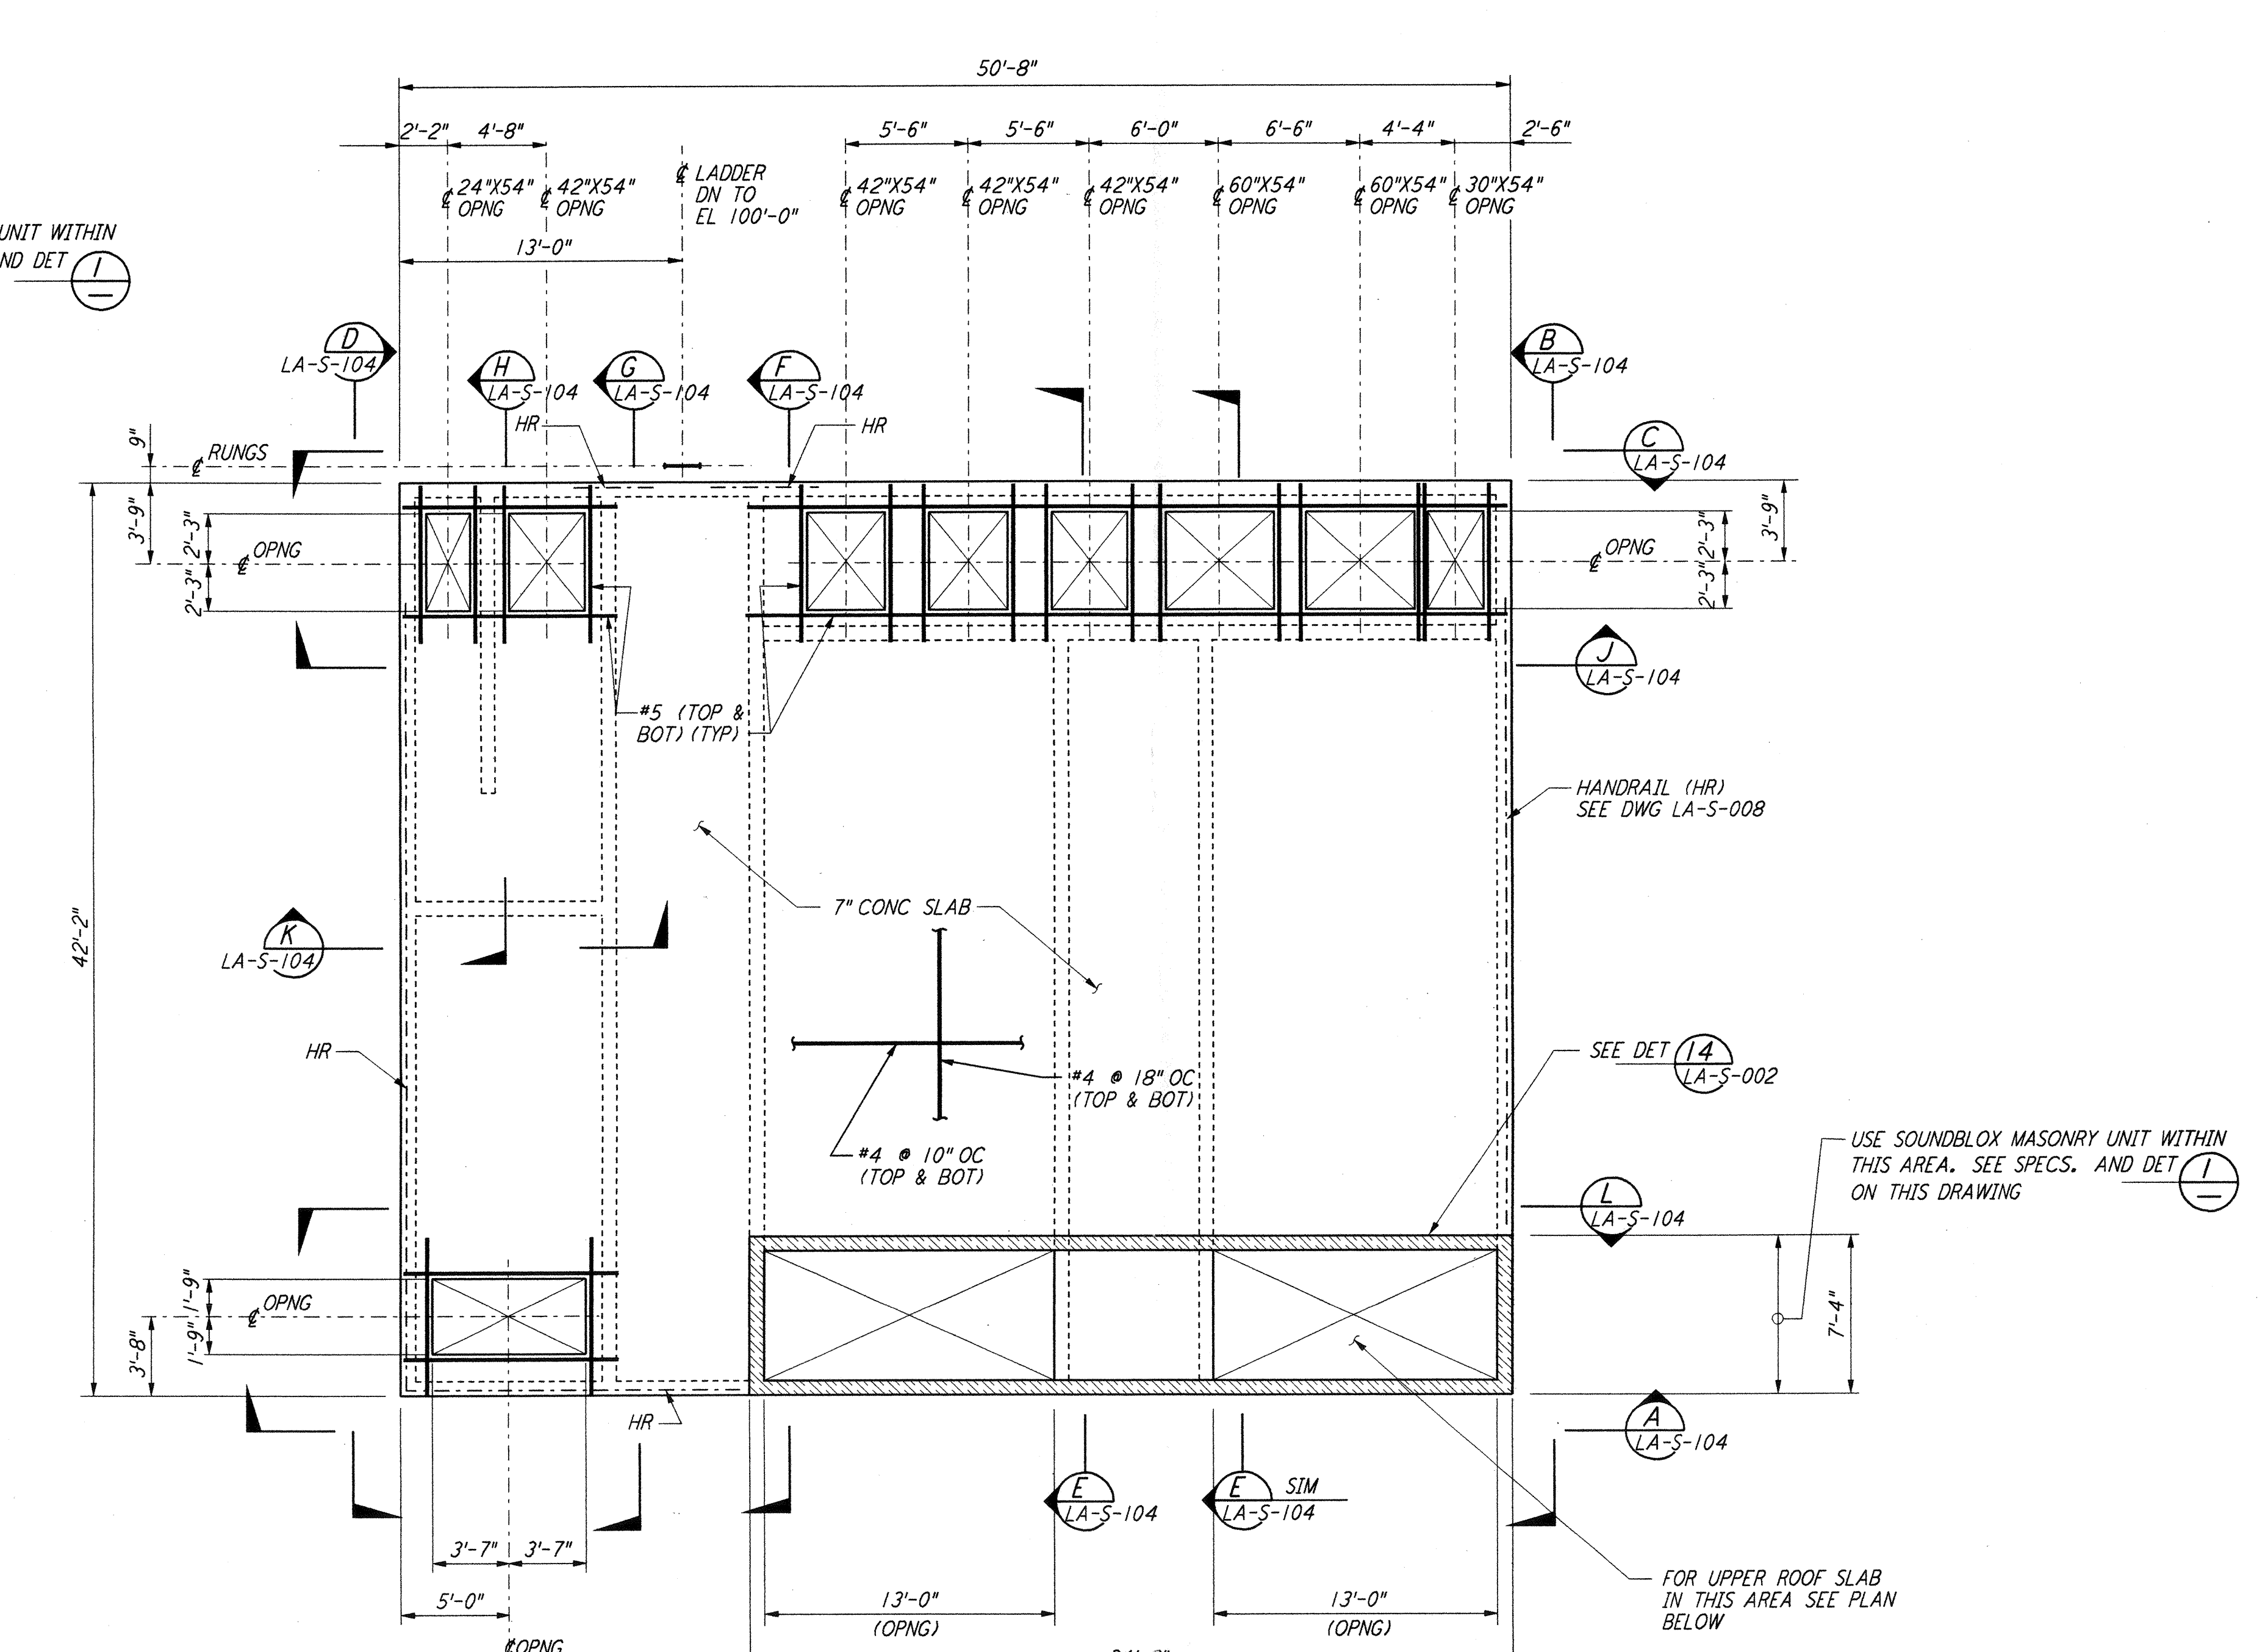

**AIR HANDLING UNIT STRUCTURE
 LOWER CONCRETE ROOF SLAB PLAN**
 $\frac{3}{8}'' = 1'-0''$
 TOC EL 110'-7"

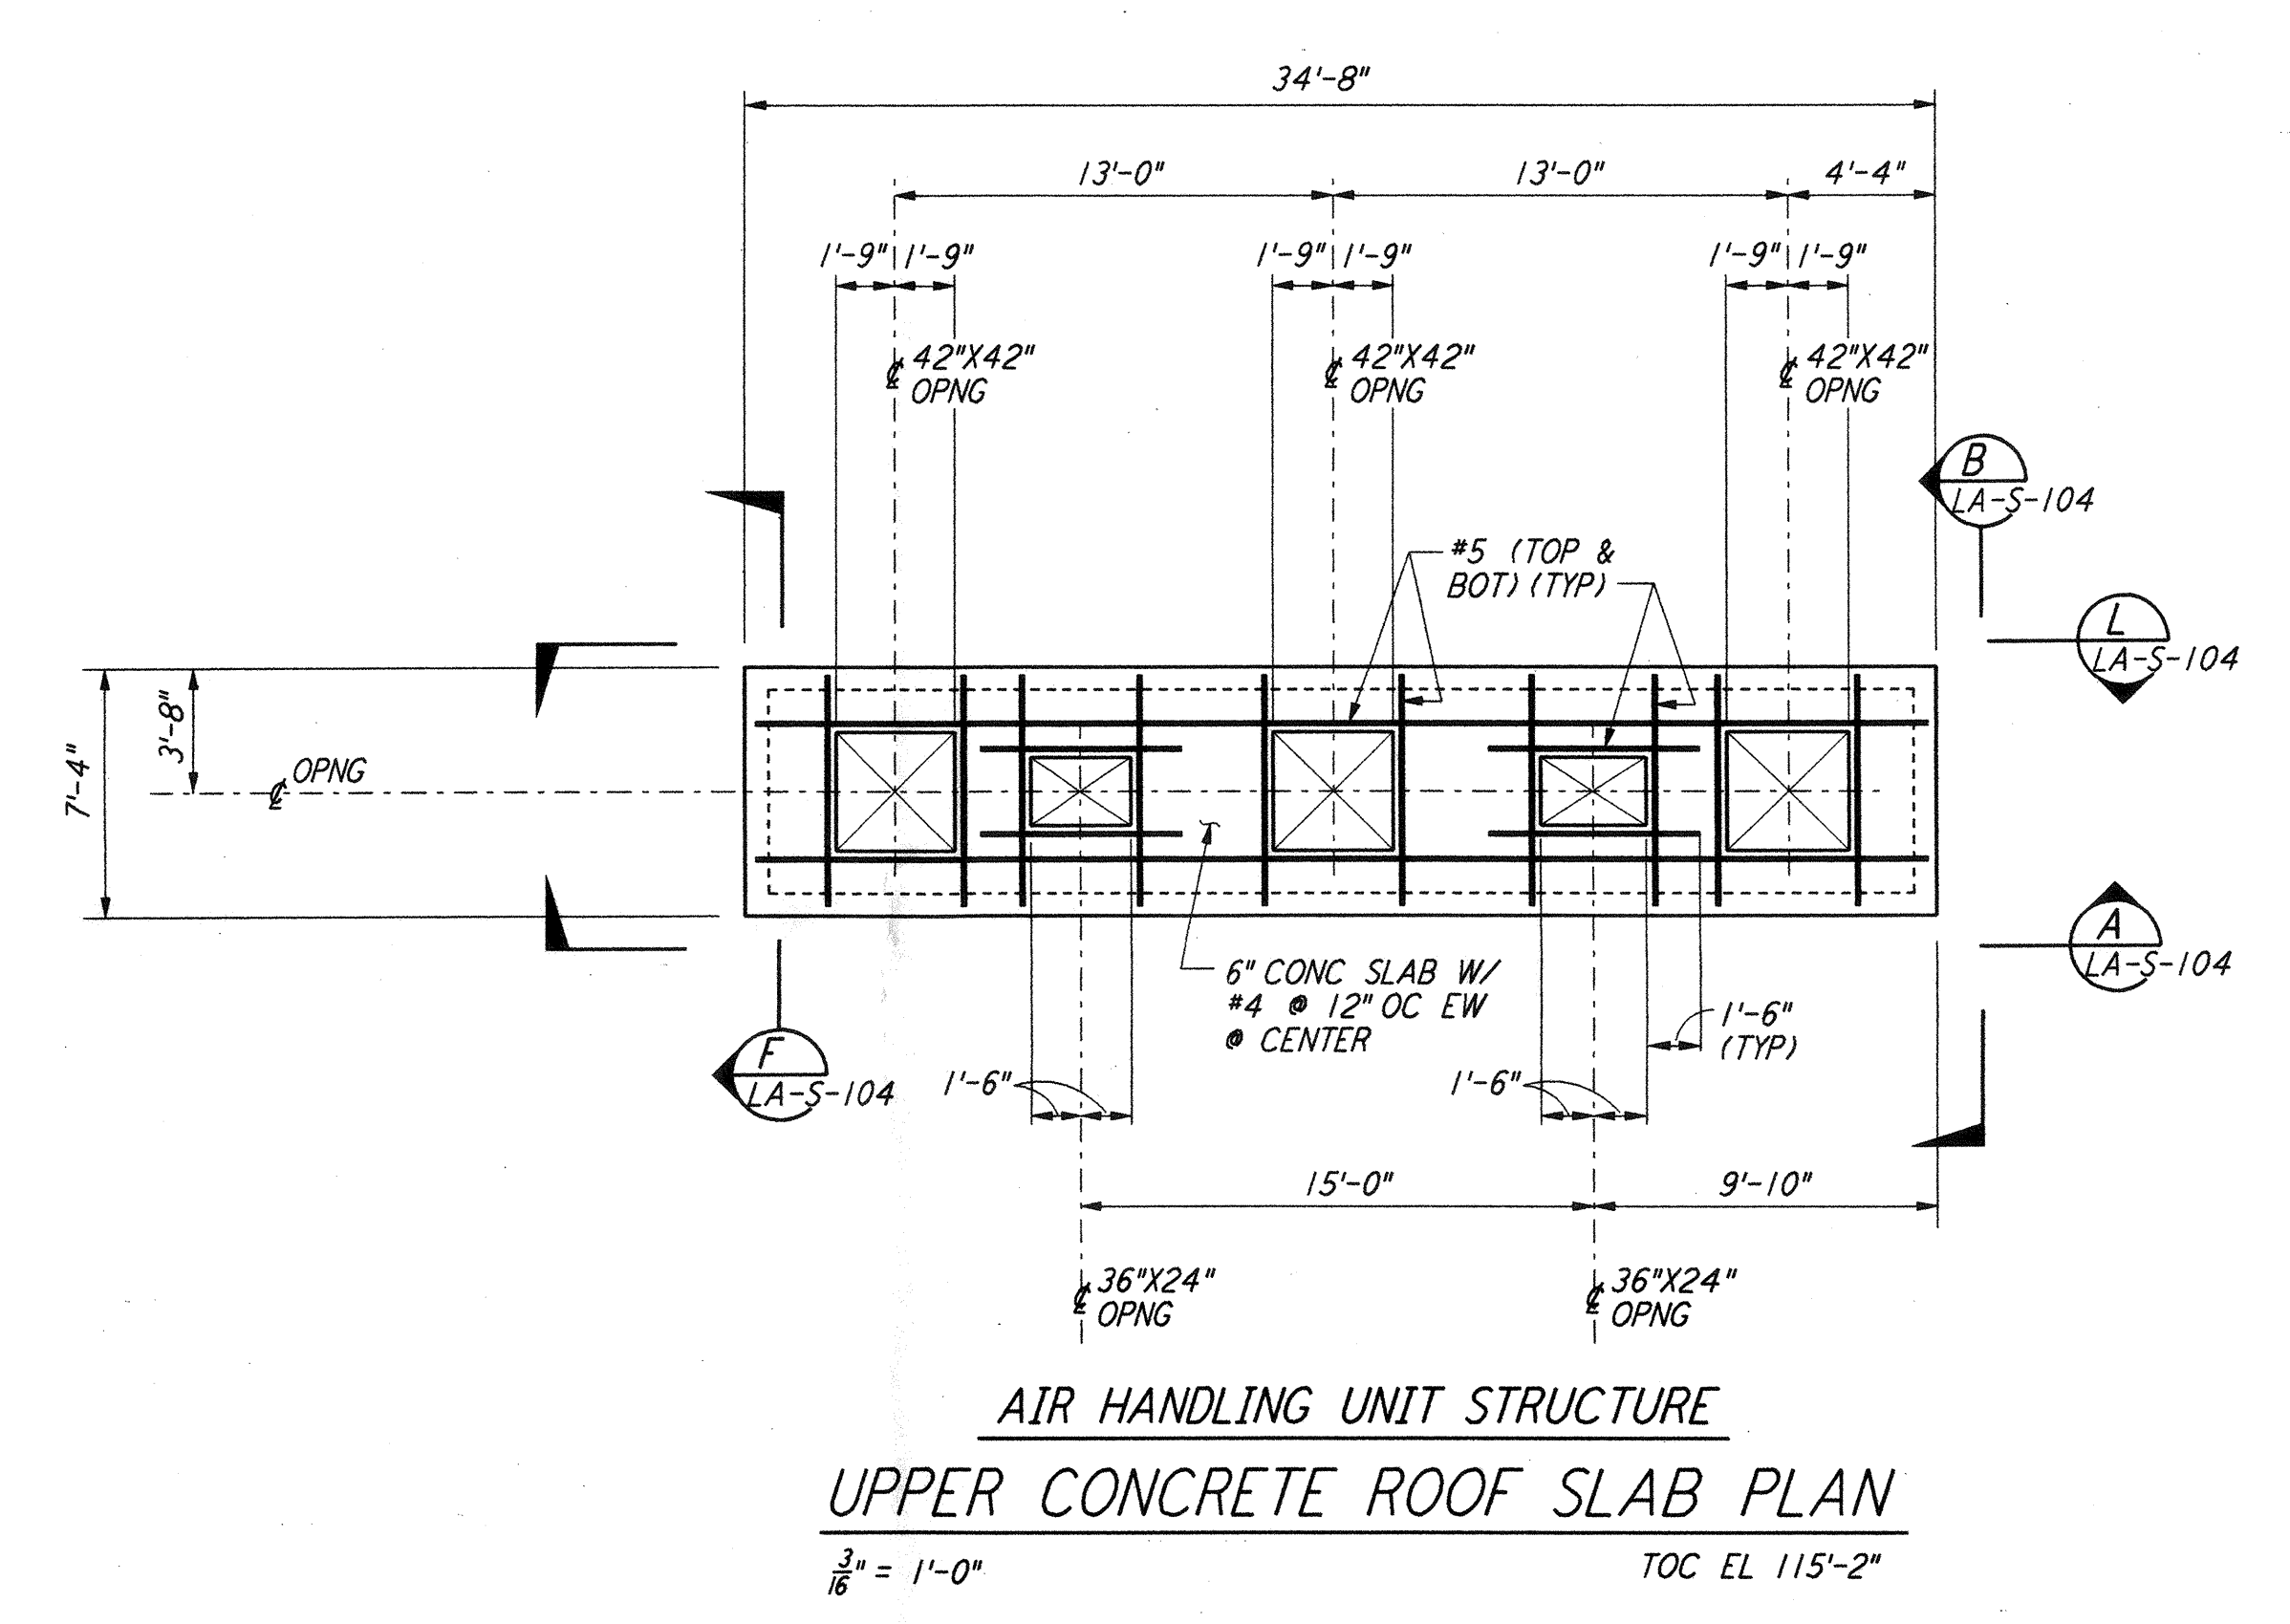


**AIR HANDLING UNIT STRUCTURE
 UPPER CONCRETE ROOF SLAB PLAN**
 $\frac{3}{8}'' = 1'-0''$
 TOC EL 115'-2"

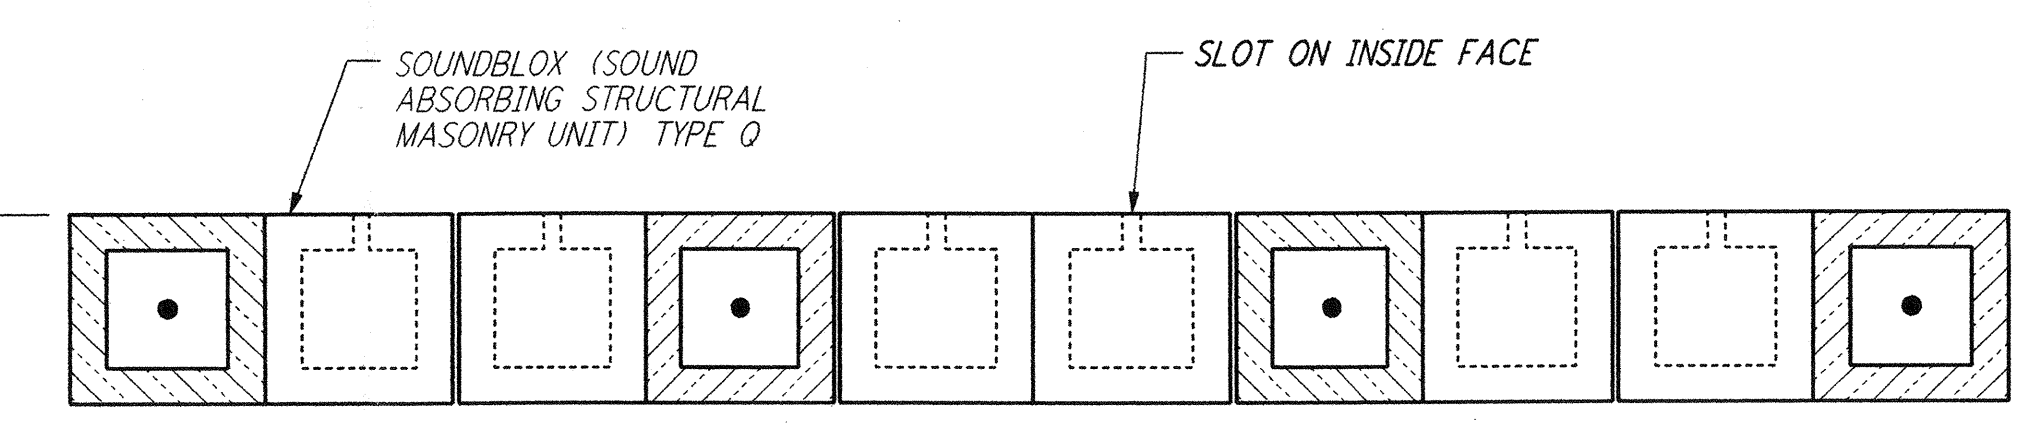

**TYPICAL SECTION OF SOUNDBLOX MASONRY WALL
 DETAIL**
 $\frac{1}{2}'' = 1'-0''$

- NOTES:**
- FOR GENERAL NOTES, ABBREVIATIONS & SYMBOLS SEE DRAWING LA-S-001.
 - CONTRACTOR SHALL ADJUST LOCATION AND SIZE OF ALL EQUIPMENT PADS TO SUIT ACTUAL VENDOR EQUIPMENTS.

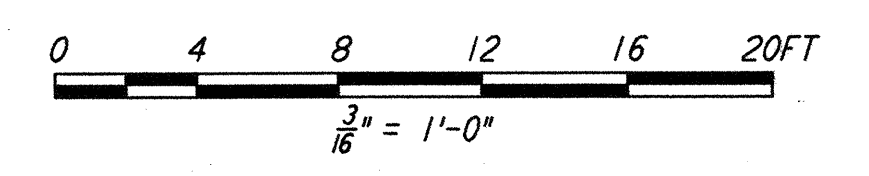

NO.	DATE	BY	CHKD	ENGR	PROJ	DESCRIPTION
1	08-07-98	WA	DDM	BP	TDM	ISSUED FOR AS-BUILT

ISSUED FOR CONSTRUCTION
 DRAWN: MCS 11-15-96
 CHECKED: DDM 11-15-96
 ENGINEER: BP 11-15-96
 PROJ: TDM 11-15-96

**AS-BUILT
 DRAWINGS**

PARSONS

100 WEST WALNUT STREET
 PASADENA, CALIFORNIA

LIGO

CALIFORNIA INSTITUTE OF TECHNOLOGY
 MASSACHUSETTS INSTITUTE OF TECHNOLOGY

LASER INTERFEROMETER
 GRAVITATIONAL-WAVE OBSERVATORY
 SITE NO. 2 - LIVINGSTON, LOUISIANA

**STRUCTURAL
 CORNER STATION
 AIR HANDLING UNIT
 ENCLOSURE PLAN**

SCALE: AS NOTED
 CONTRACT NUMBER: PPI50969
 PROJECT NUMBER: 8094

SHEET NUMBER: **LA-S-103**

LIGO-D960919-01-0