




ELEVATION A REF  
 $\frac{3}{16}'' = 1'-0''$   
 LA-S-104 LA-S-103

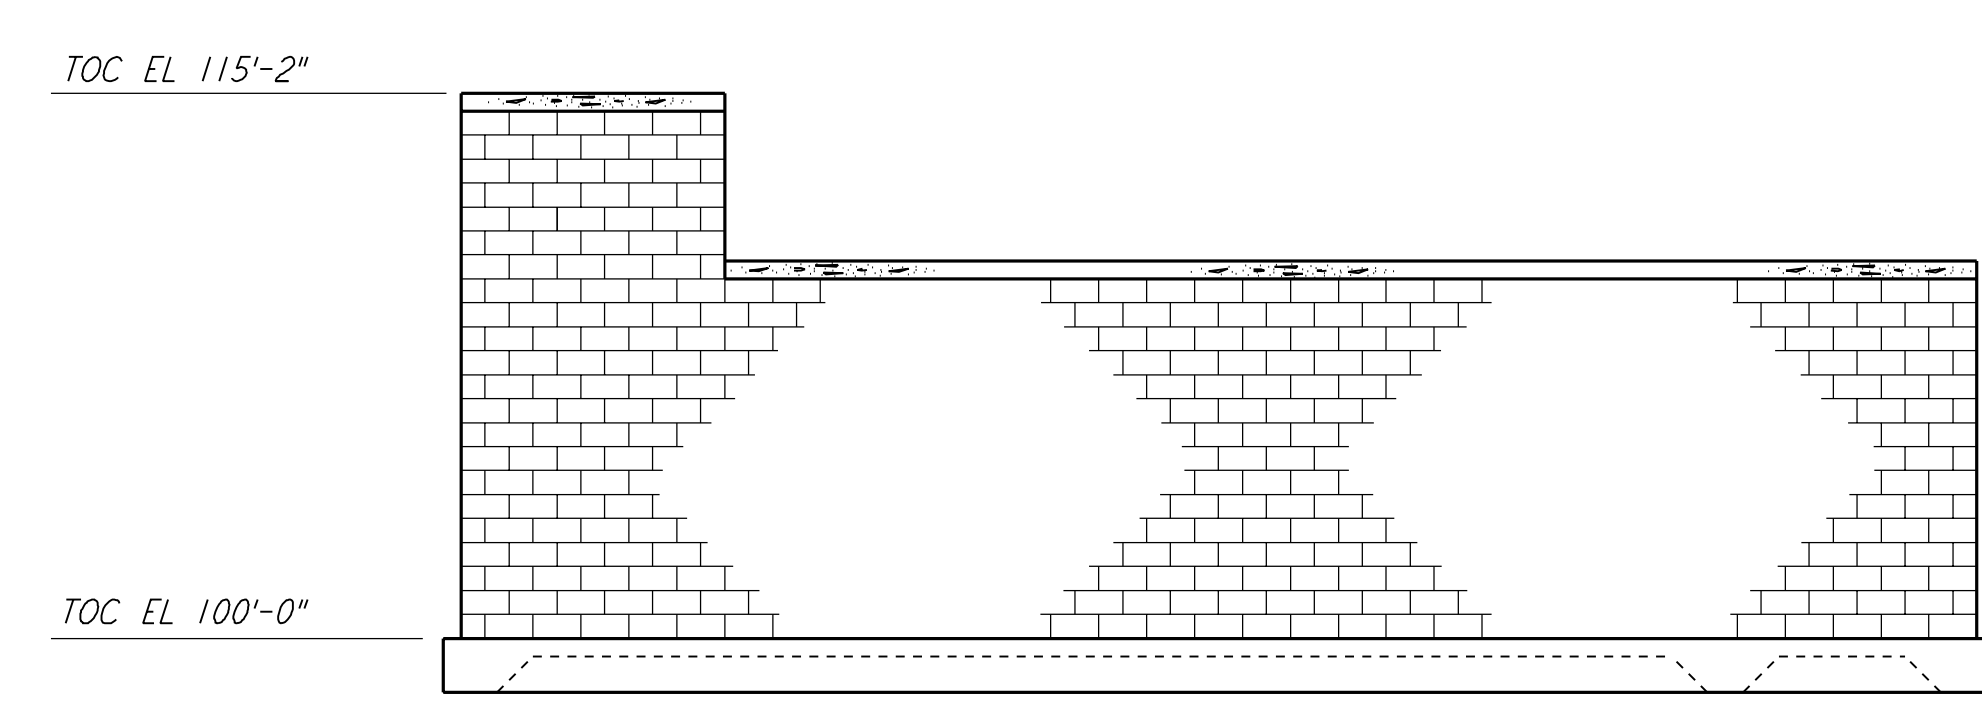


ELEVATION B REF  
 $\frac{3}{16}'' = 1'-0''$   
 LA-S-104 LA-S-103

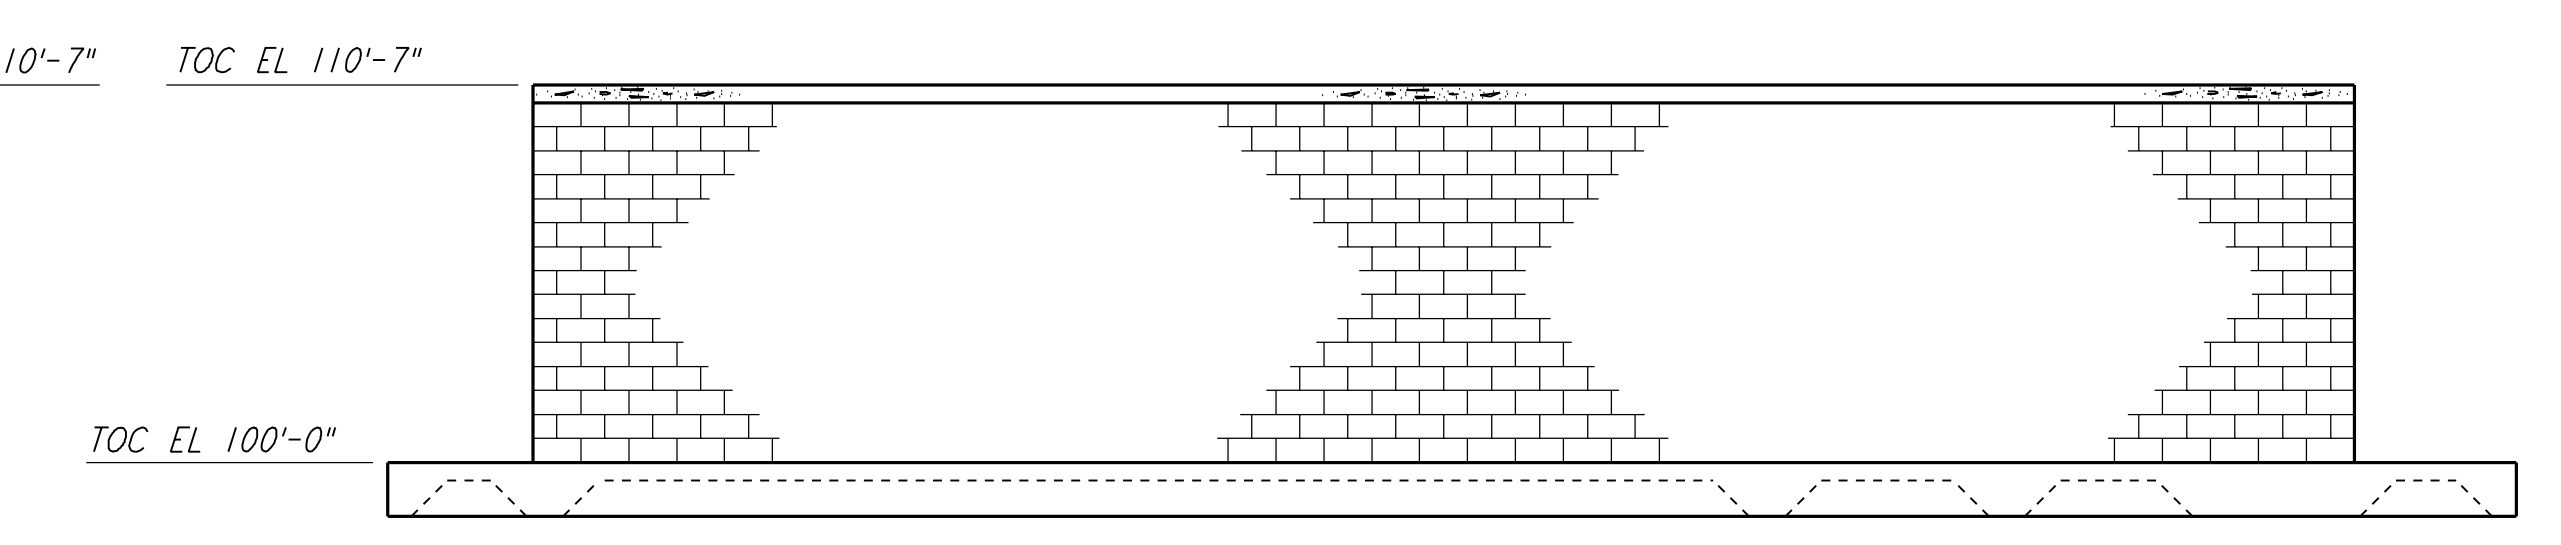


ELEVATION C REF  
 $\frac{3}{16}'' = 1'-0''$   
 LA-S-104 LA-S-103

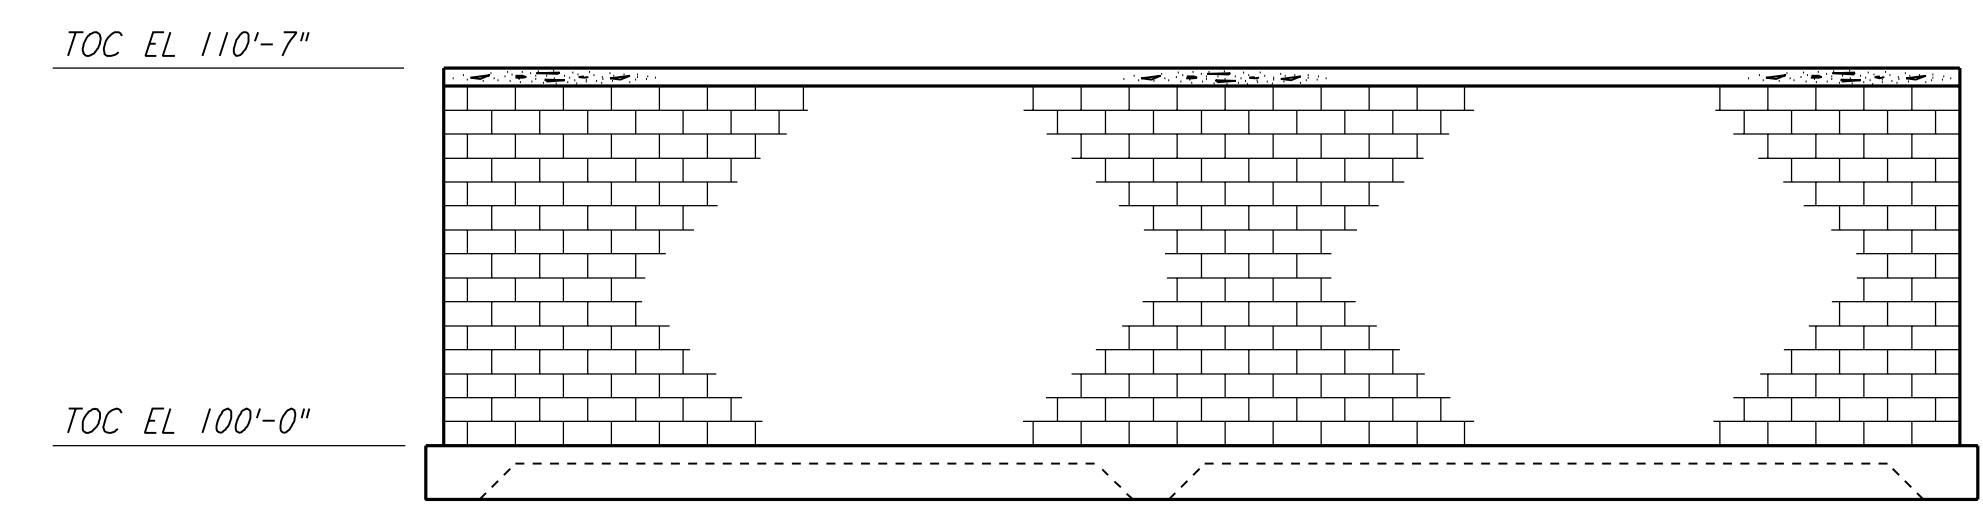


ELEVATION D REF  
 $\frac{3}{16}'' = 1'-0''$   
 LA-S-104 LA-S-103

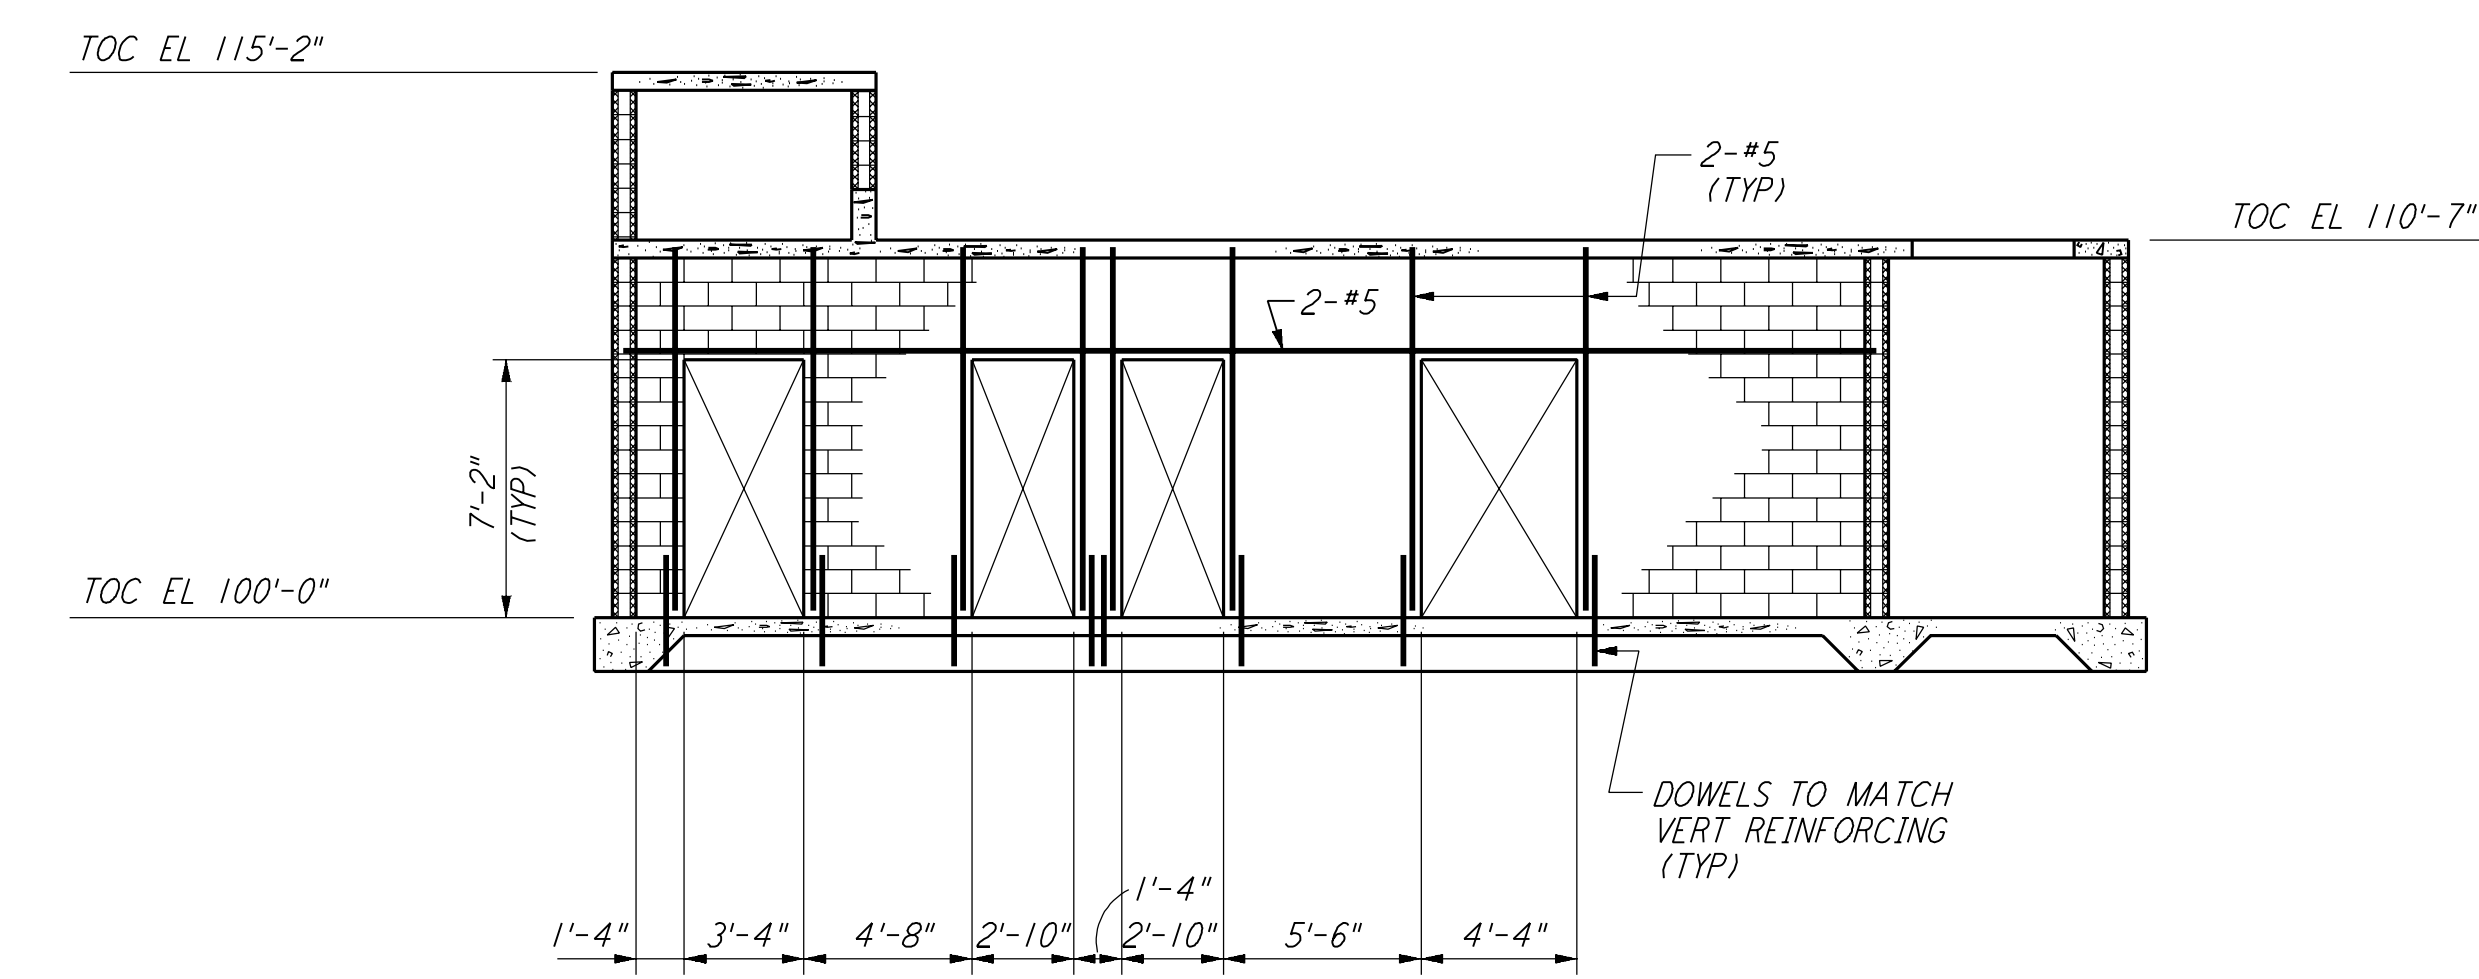


SECTION E REF  
 $\frac{3}{16}'' = 1'-0''$   
 LA-S-104 LA-S-103

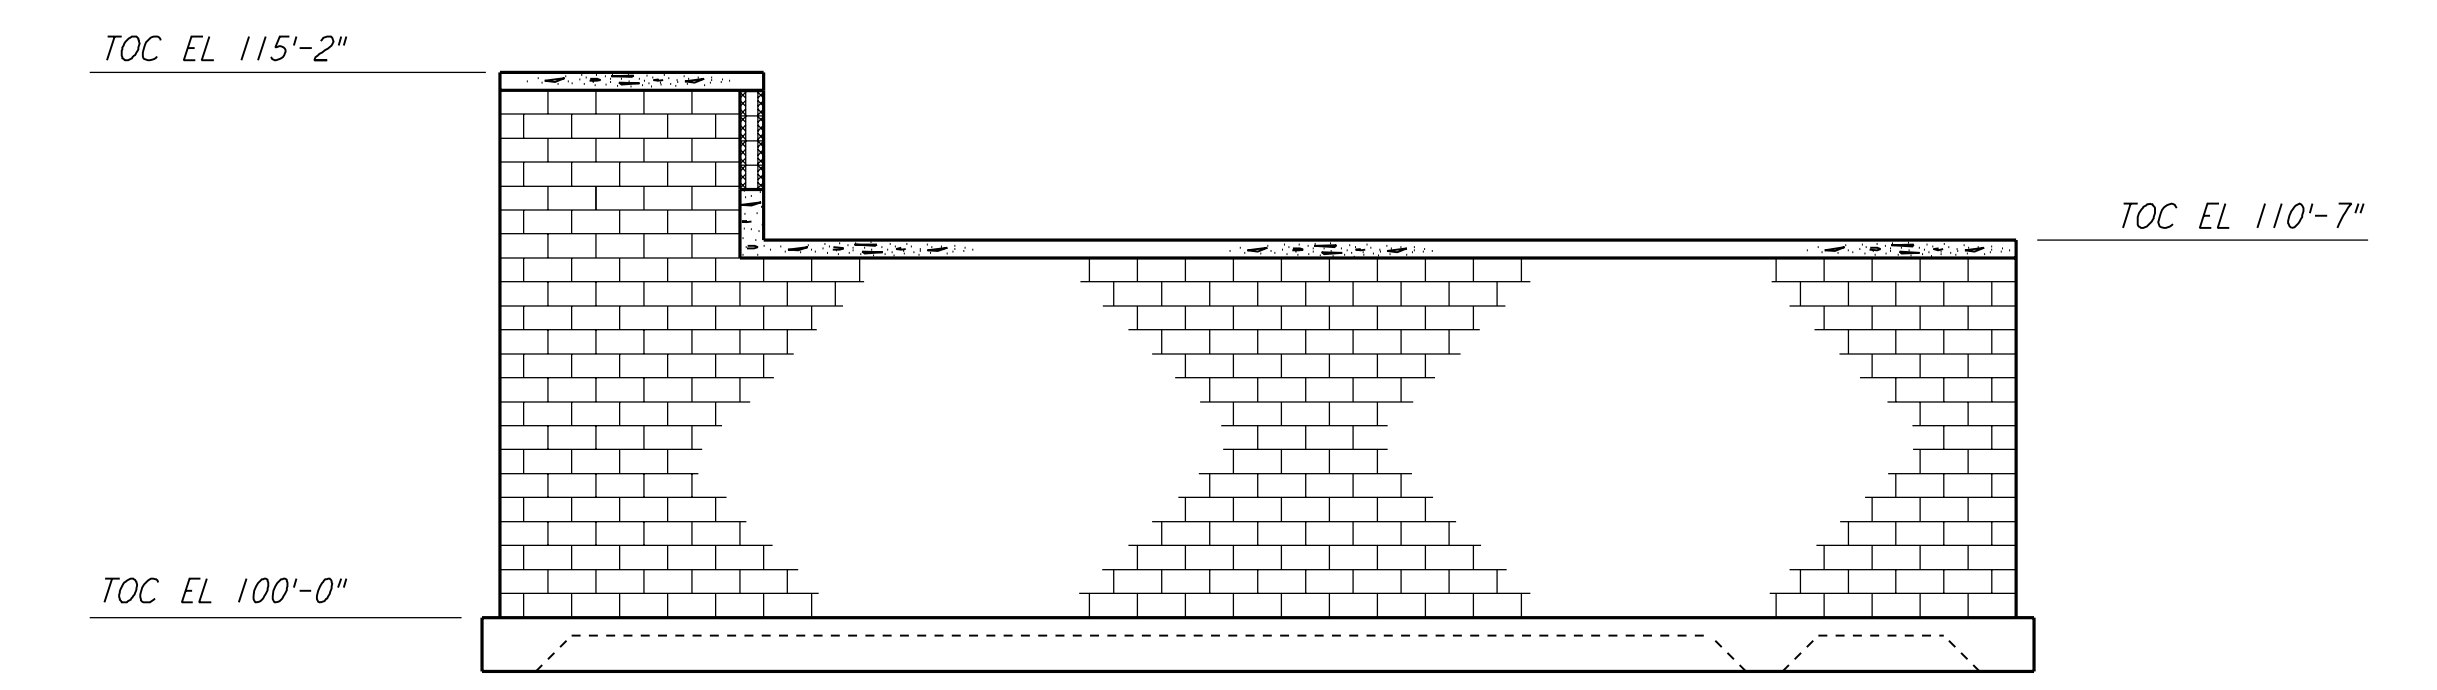


SECTION F REF  
 $\frac{3}{16}'' = 1'-0''$   
 LA-S-104 LA-S-103

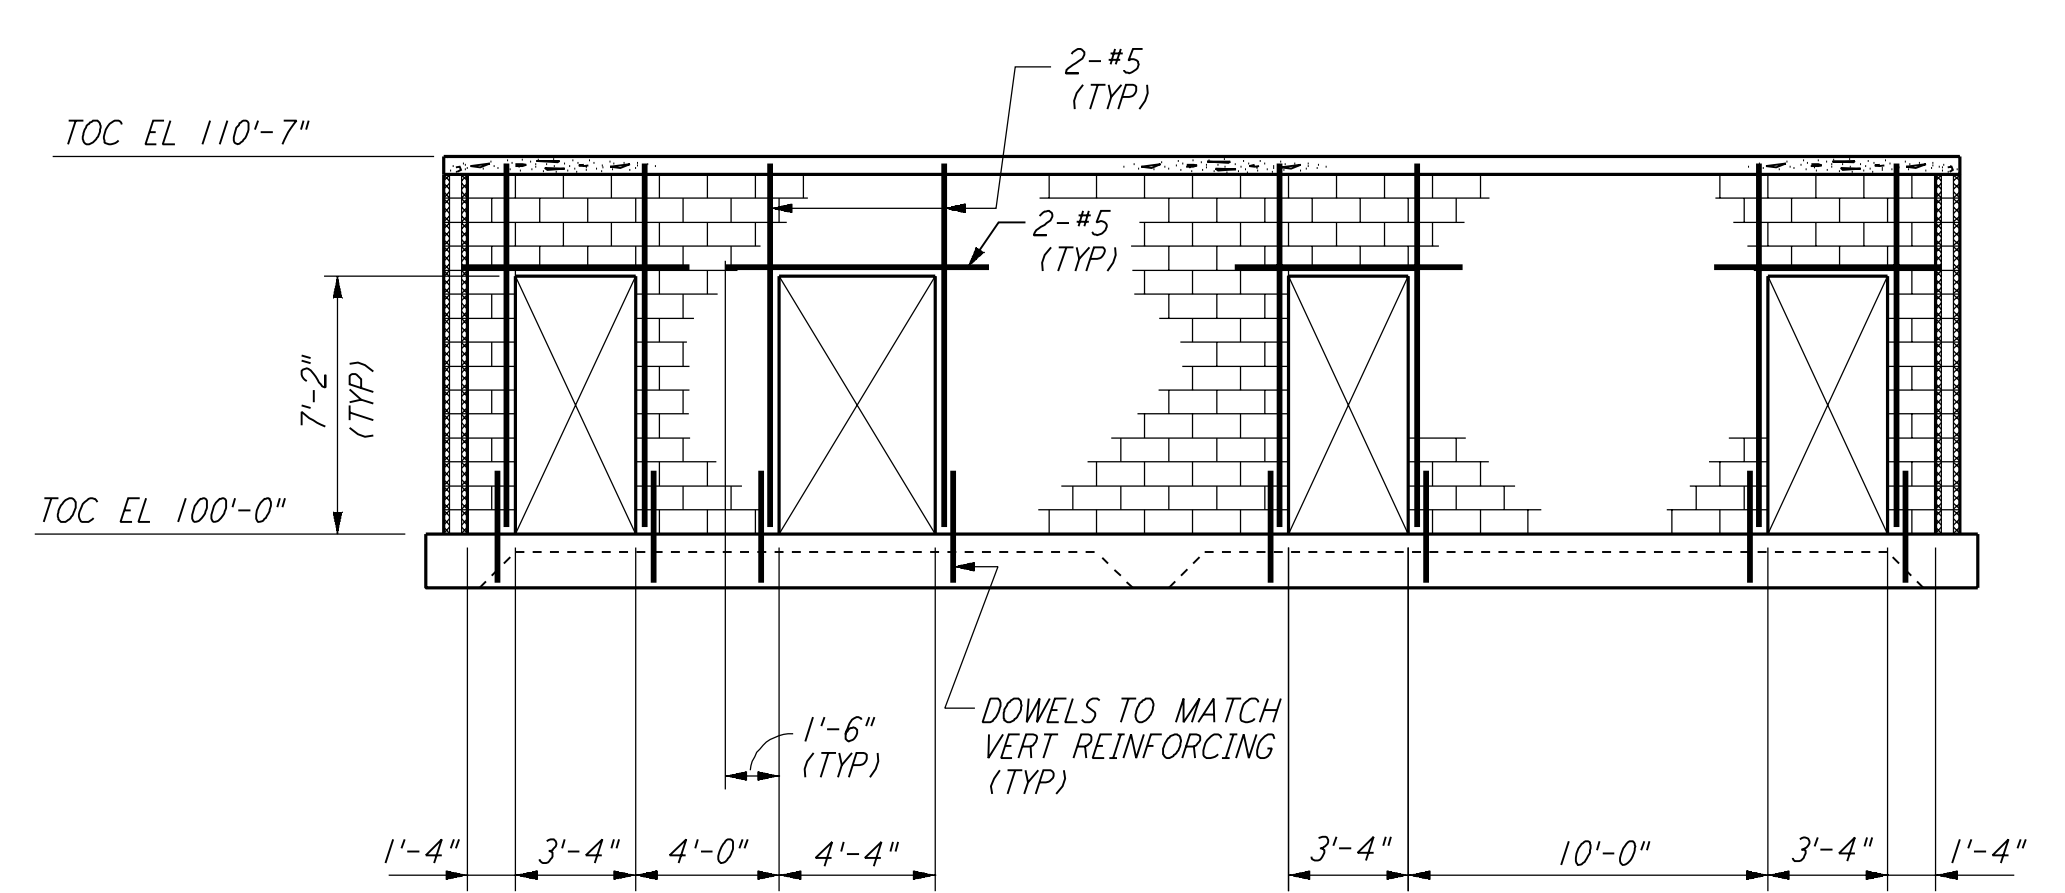


SECTION G REF  
 $\frac{3}{16}'' = 1'-0''$   
 LA-S-104 LA-S-103

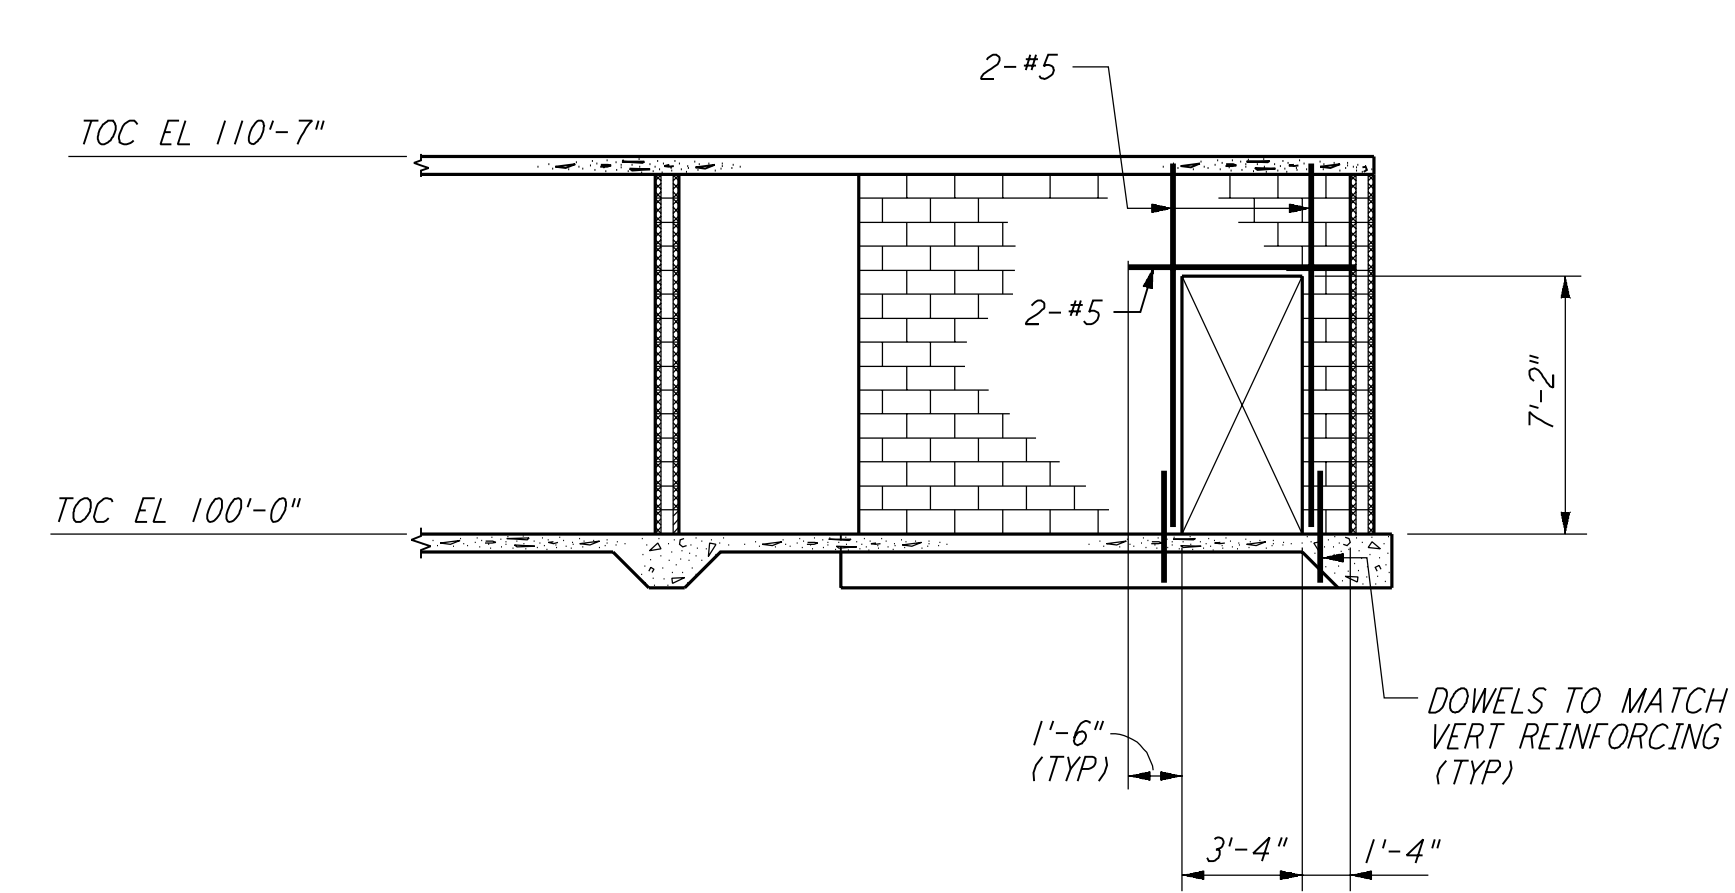


SECTION H REF  
 $\frac{3}{16}'' = 1'-0''$   
 LA-S-104 LA-S-103

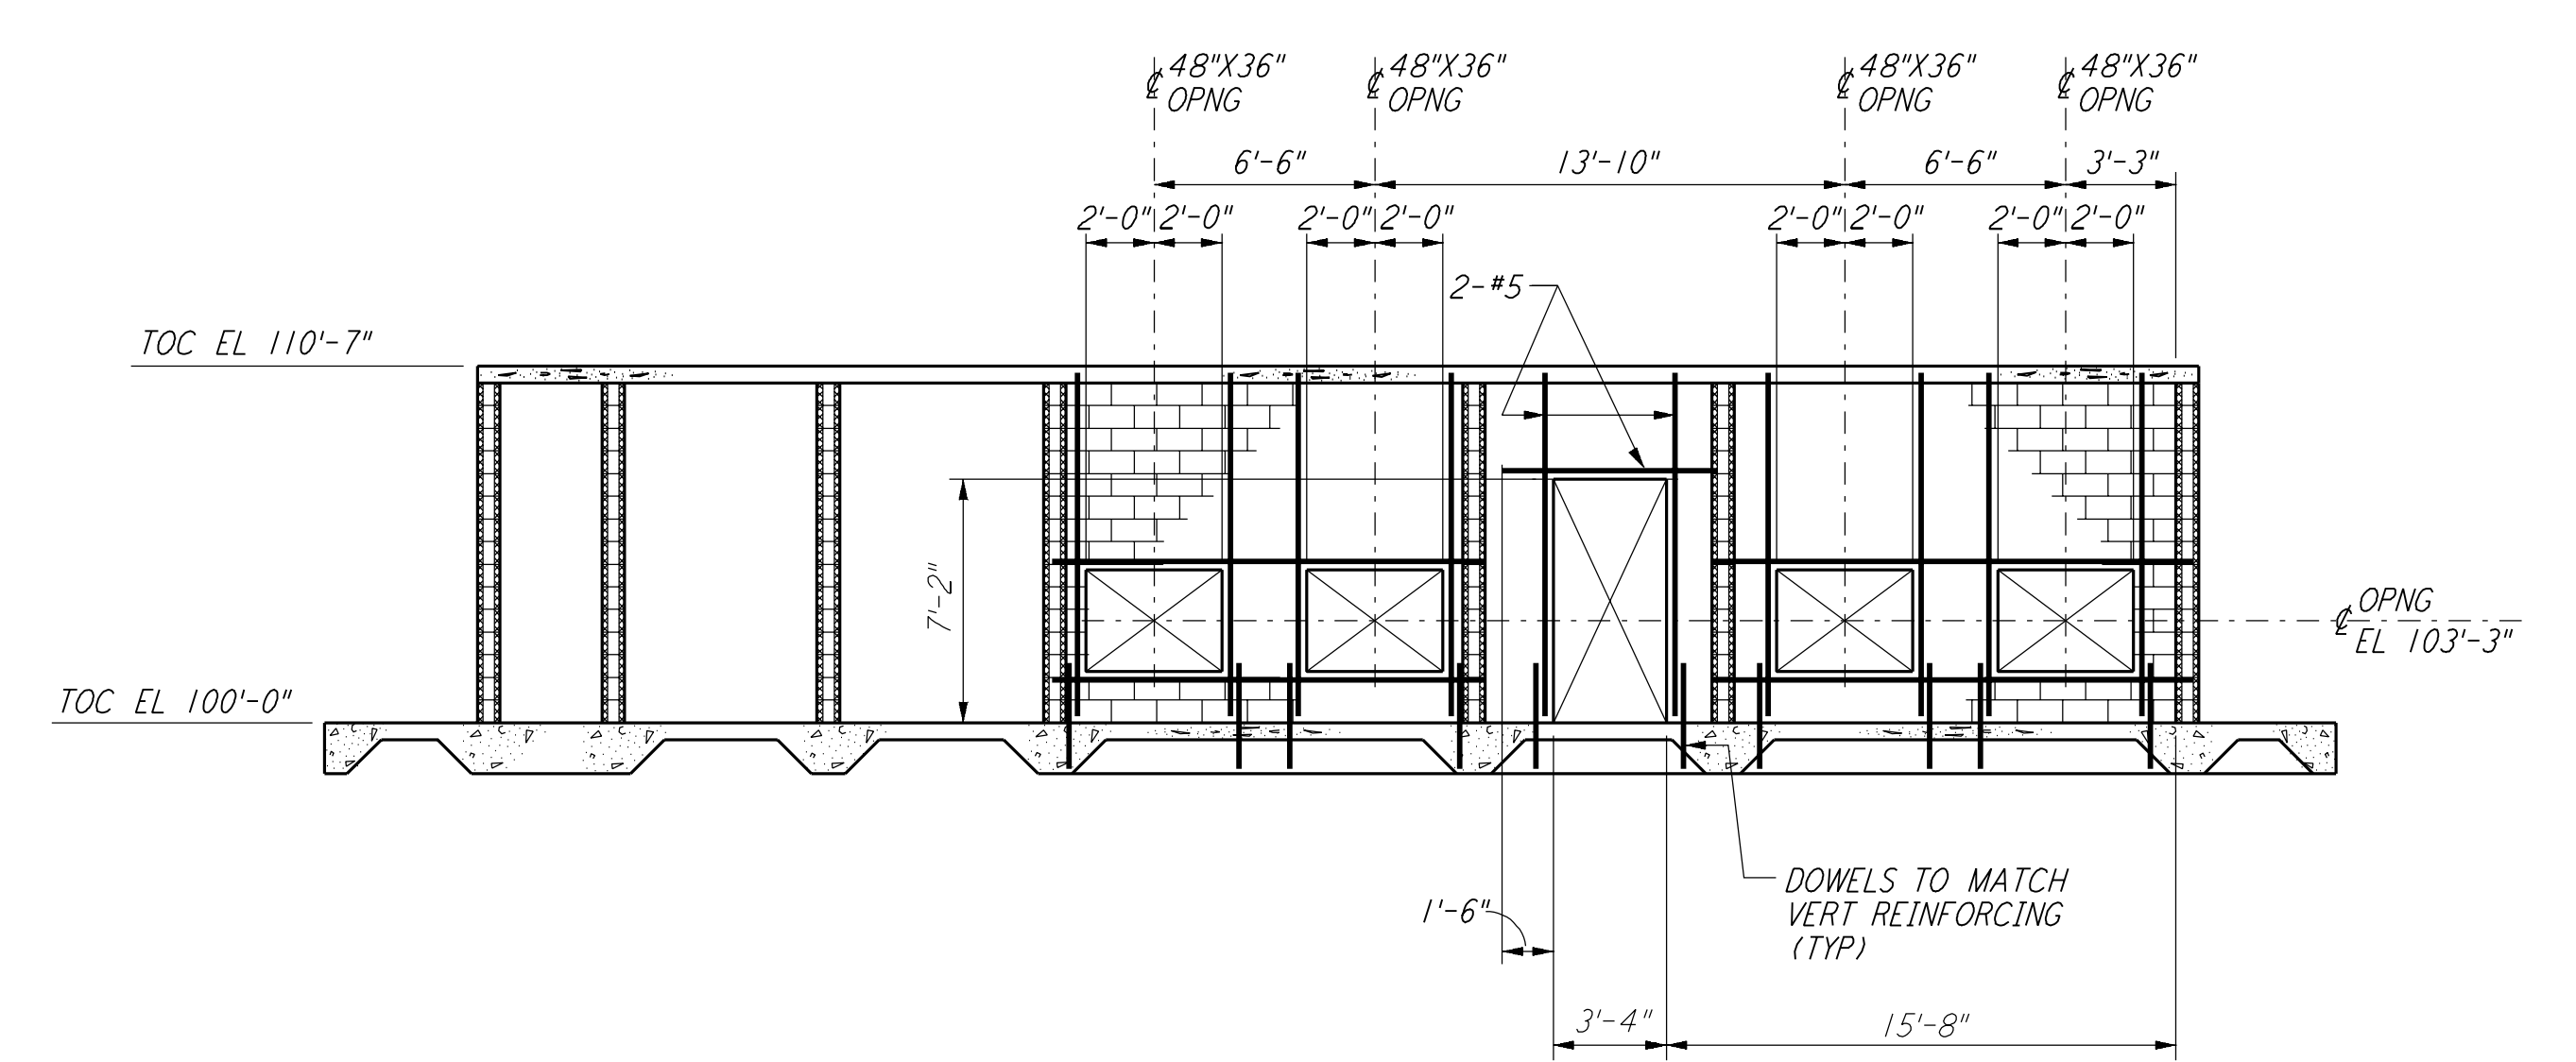

SECTION J REF  
 $\frac{3}{16}'' = 1'-0''$   
 LA-S-104 LA-S-103

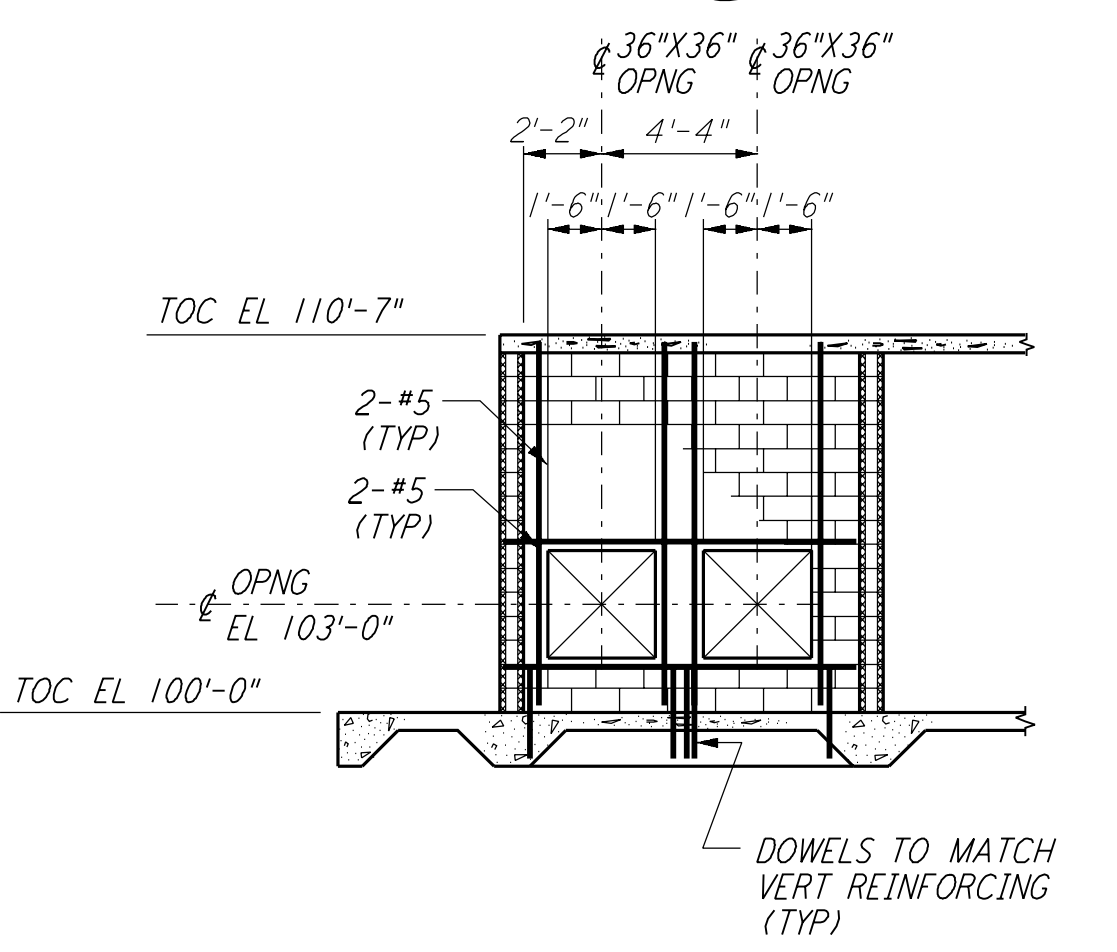


SECTION K REF  
 $\frac{3}{16}'' = 1'-0''$   
 LA-S-104 LA-S-103

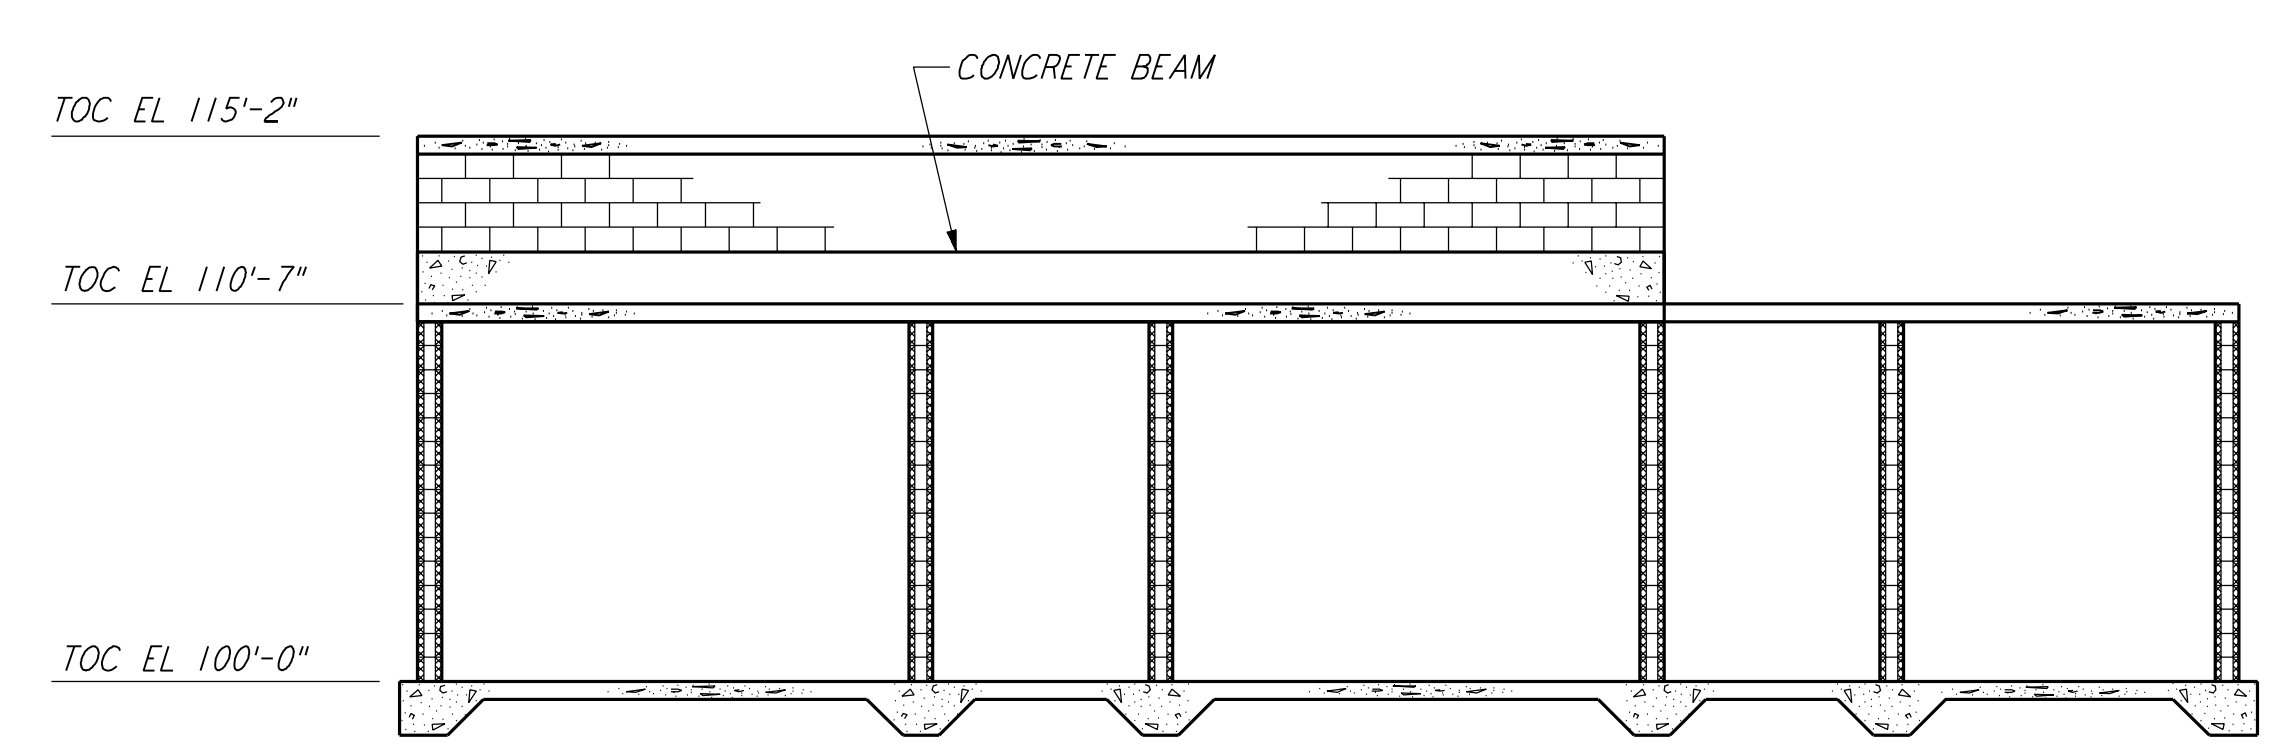

SECTION L REF  
 $\frac{3}{16}'' = 1'-0''$   
 LA-S-104 LA-S-103

NOTE:  
 1. FOR NOTES SEE DRAWING LA-S-103.

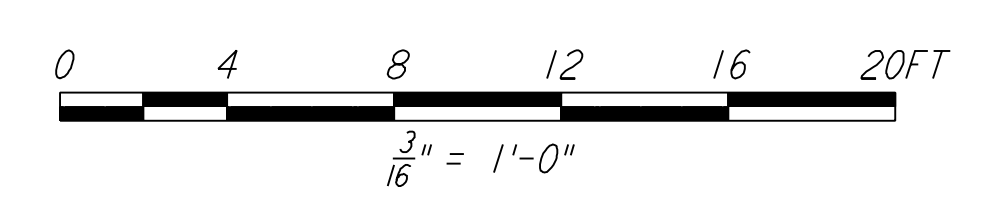

This document and the design it covers are the property of PARSONS. They are loaned only with the borrower's expressed written agreement that they will not be reproduced, copied, loaned, exhibited, or used in any other way, except by written consent from PARSONS to the borrower.

NO.	DATE	BY	CHKD	ENGR	PROJ	DESCRIPTION
1	08-07-98	WA				ISSUED FOR AS-BUILT

ISSUED FOR CONSTRUCTION			
DRAWN	MCS	11-15-96	
CHECKED	DDM	11-15-96	
ENGINEER	BP	11-15-96	
PROJ	TDM	11-15-96	

**AS-BUILT DRAWINGS**

**PARSONS**  
 100 WEST WALNUT STREET  
 PASADENA, CALIFORNIA

**LIGO**  
 CALIFORNIA INSTITUTE OF TECHNOLOGY  
 MASSACHUSETTS INSTITUTE OF TECHNOLOGY

LIGO-D960920-01-O  
 LASER INTERFEROMETER  
 GRAVITATIONAL-WAVE OBSERVATORY  
 SITE NO. 2 - LIVINGSTON, LOUISIANA

TITLE	SCALE	CONTRACT NUMBER	PROJECT NUMBER
STRUCTURAL CORNER STATION AIR HANDLING UNIT ENCLOSURE ELEV & SECTS	AS NOTED	PP150969	8094
SHEET NUMBER		REVISIONS	
<b>LA-S-104</b>			