



PARTIAL ELEVATION AT COLUMN LINE J
 $\frac{3}{16}'' = 1'-0''$

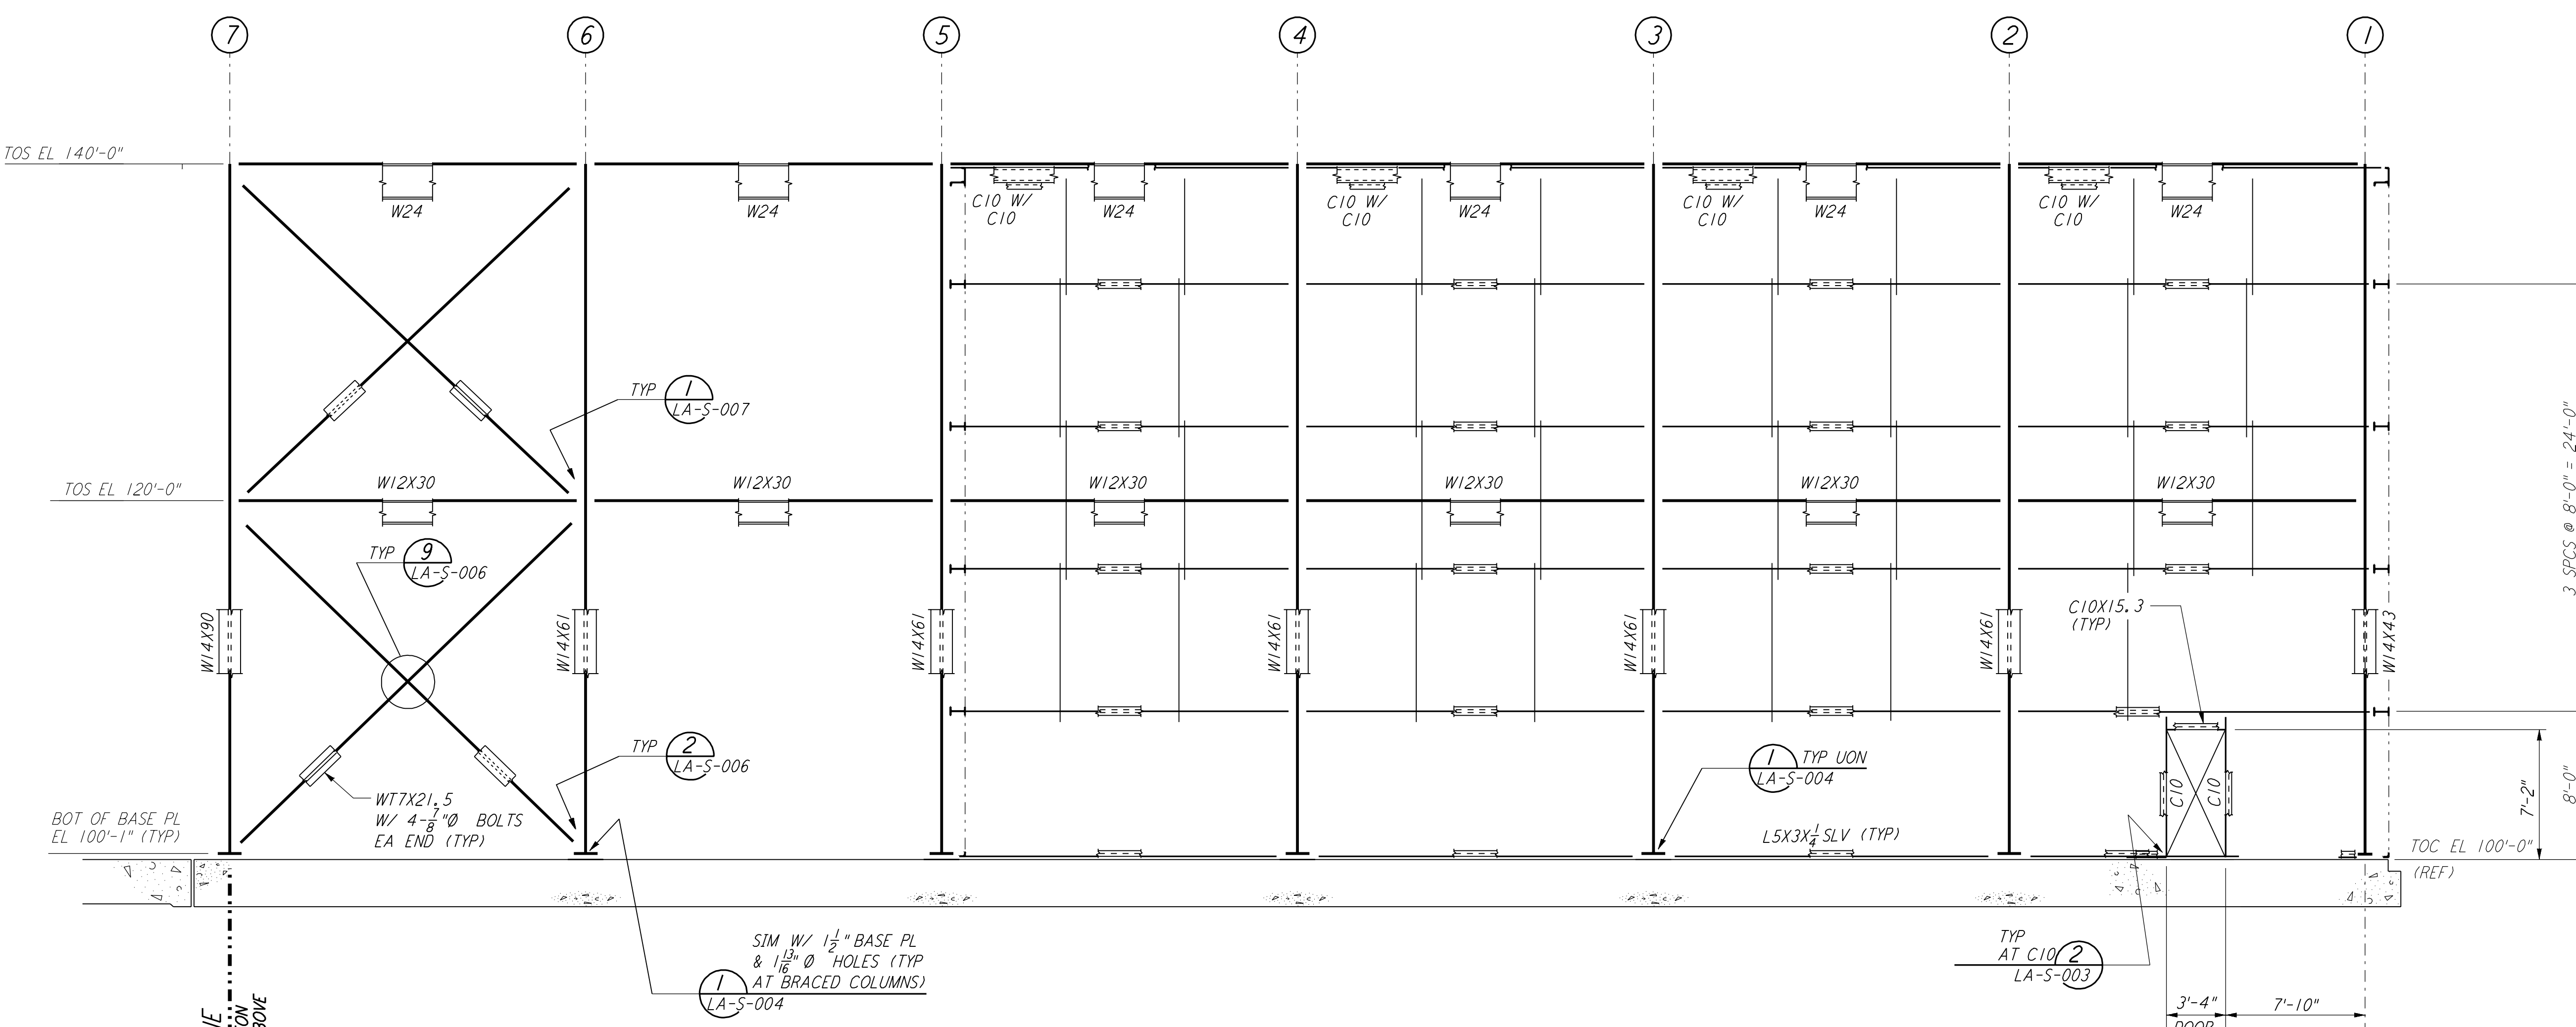

PARTIAL ELEVATION AT COLUMN LINE J
 $\frac{3}{16}'' = 1'-0''$

NOTE:
 1. FOR NOTES SEE DRAWING LA-S-107.

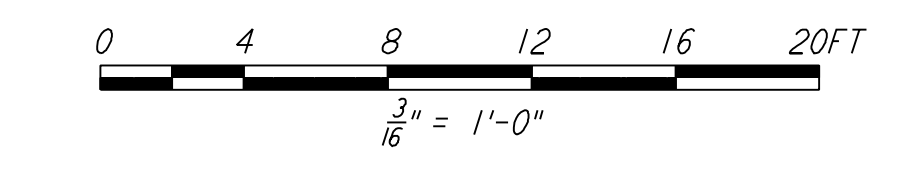

LIGO-D960929-01-0

DRAWING NO.	DESCRIPTION	REVISIONS					
		NO.	DATE	BY	CHKD	ENGR	PROJ
		1	08-07-98	WA			ISSUED FOR AS-BUILT

ISSUED FOR CONSTRUCTION		
DRAWN	MCS	11-15-96
CHECKED	DDM	11-15-96
ENGINEER	BP	11-15-96
PROJ	TDM	11-15-96
AS-BUILT DRAWINGS		

100 WEST WALNUT STREET
 PASADENA, CALIFORNIA



LASER INTERFEROMETER GRAVITATIONAL-WAVE OBSERVATORY SITE NO. 2 - LIVINGSTON, LOUISIANA		
TITLE	SCALE	CONTRACT NUMBER
STRUCTURAL CORNER STATION LVEA FRAMING ELEVATIONS SHEET 7	AS NOTED	PP150969
	SHEET NUMBER	PROJECT NUMBER
	LA-S-113	8094

This document and the design it covers are the property of **PARSONS**. They are loaned only with the borrower's expressed written agreement that they will not be reproduced, copied, loaned, exhibited, or used in any other way, except by written consent from **PARSONS** to the borrower.

Wed Oct 7 15:48:49 1998 c:\p1\st\loc113.dwg 15:48:49 10/07/98 15:48:49