




PARTIAL FRAMING ELEVATION AT COLUMN LINE 14.3  
 3/8" = 1'-0"

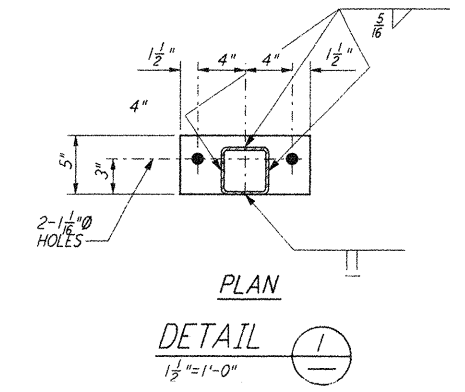

DETAIL 1  
 1 1/2" = 1'-0"

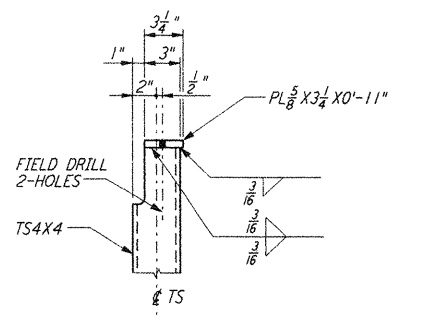


SECTION A  
 1 1/2" = 1'-0"

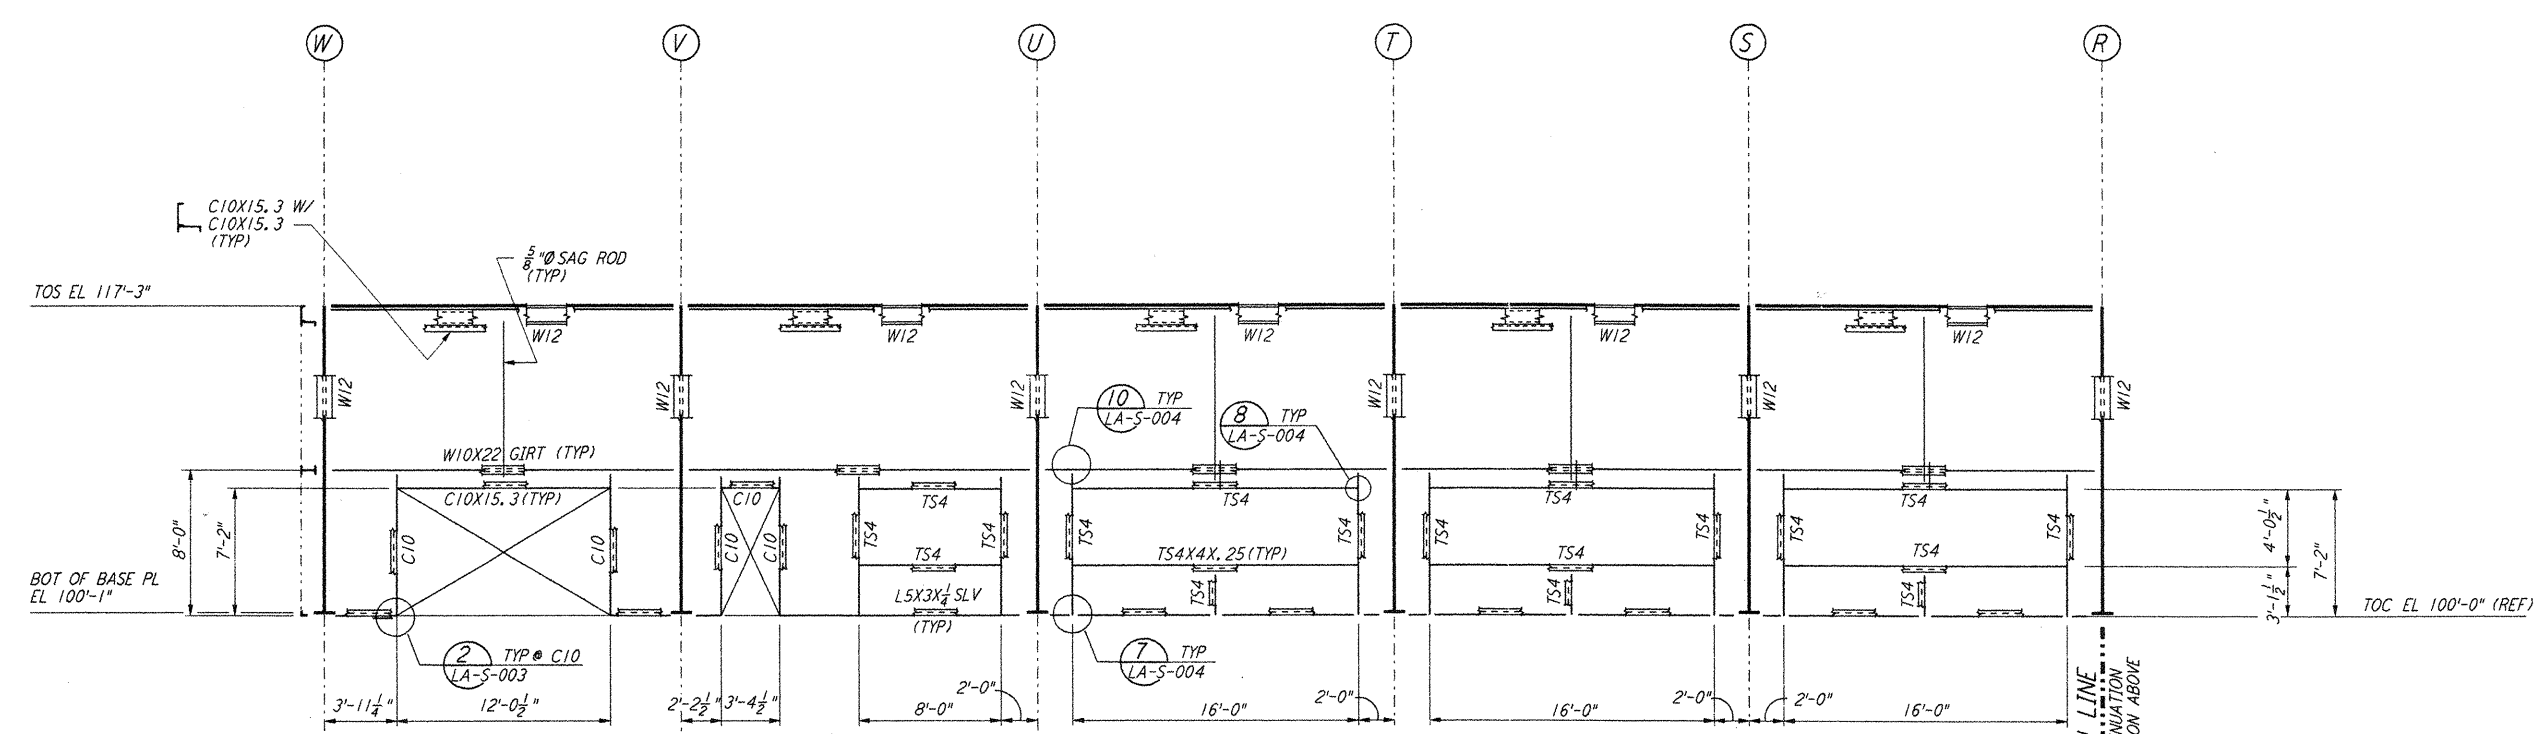

PARTIAL FRAMING ELEVATION AT COLUMN LINE 14.3  
 3/8" = 1'-0"

- NOTES:
1. FOR GENERAL NOTES, ABBREVIATIONS AND SYMBOLS SEE DRAWING LA-S-001.
  2. FOR CHANNEL, GIRT AND EAVE STRUT CONNECTION DETAILS SEE DRAWING LA-S-005.
  3. FOR W BEAM TO COLUMN WEB/FLANGE CONNECTIONS, SEE DETAILS (6) LA-S-004 & (4) LA-S-007 TYPICAL UNLESS OTHERWISE NOTED.
  4. FOR BASE ANGLE (LSX3) CONNECTIONS, SEE SECTION (A) LA-S-003
  5. FOR VERT BRCC CONNECTIONS SEE (2) LA-S-006 (B) LA-S-006 (1) LA-S-007 (2) LA-S-007 TYP UON.

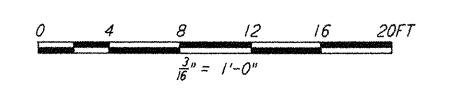

not be reproduced, copied, loaned, exhibited, or used in any other way, except by written consent from PARSONS to the borrower.

This document and the design it covers are the property of PARSONS. They are loaned only with the borrower's expressed written agreement that they will

NO.	DATE	BY	CHKD	ENGR	PROJ	DESCRIPTION
2	08-07-98	WA				ISSUED FOR AS-BUILT
1	2-28-97	RM	AB	BP		REV DIM AT ELEV LN 14.3

ISSUED FOR CONSTRUCTION  
 DRAWN MCS 11-15-96  
 CHECKED DDM 11-15-96  
 ENGINEER BP 11-15-96  
 PROJ TDM 11-15-96

**AS-BUILT DRAWINGS**

**PARSONS**  
 100 WEST WALNUT STREET  
 PASADENA, CALIFORNIA

**LIGO**  
 CALIFORNIA INSTITUTE OF TECHNOLOGY  
 MASSACHUSETTS INSTITUTE OF TECHNOLOGY

**LIGO-D960937-02-0**  
 LASER INTERFEROMETER  
 GRAVITATIONAL-WAVE OBSERVATORY  
 SITE NO. 2 - LIVINGSTON, LOUISIANA

SCALE: AS NOTED  
 CONTRACT NUMBER: PPI50969  
 PROJECT NUMBER: 8094

TITLE: STRUCTURAL CORNER STATION OSB FRAMING ELEVATIONS SHEET 5  
 SHEET NUMBER: LA-S-121

Sun Aug 17 11:02:11 1998 C:\PLOT\LDUE\53-Y98B2.ZDF 52885 KLV98B2.V121.dwg LIGOLAF.BDR