



PARTIAL FRAMING ELEVATION AT COLUMN LINE 16.3
 $\frac{3}{16}'' = 1'-0''$

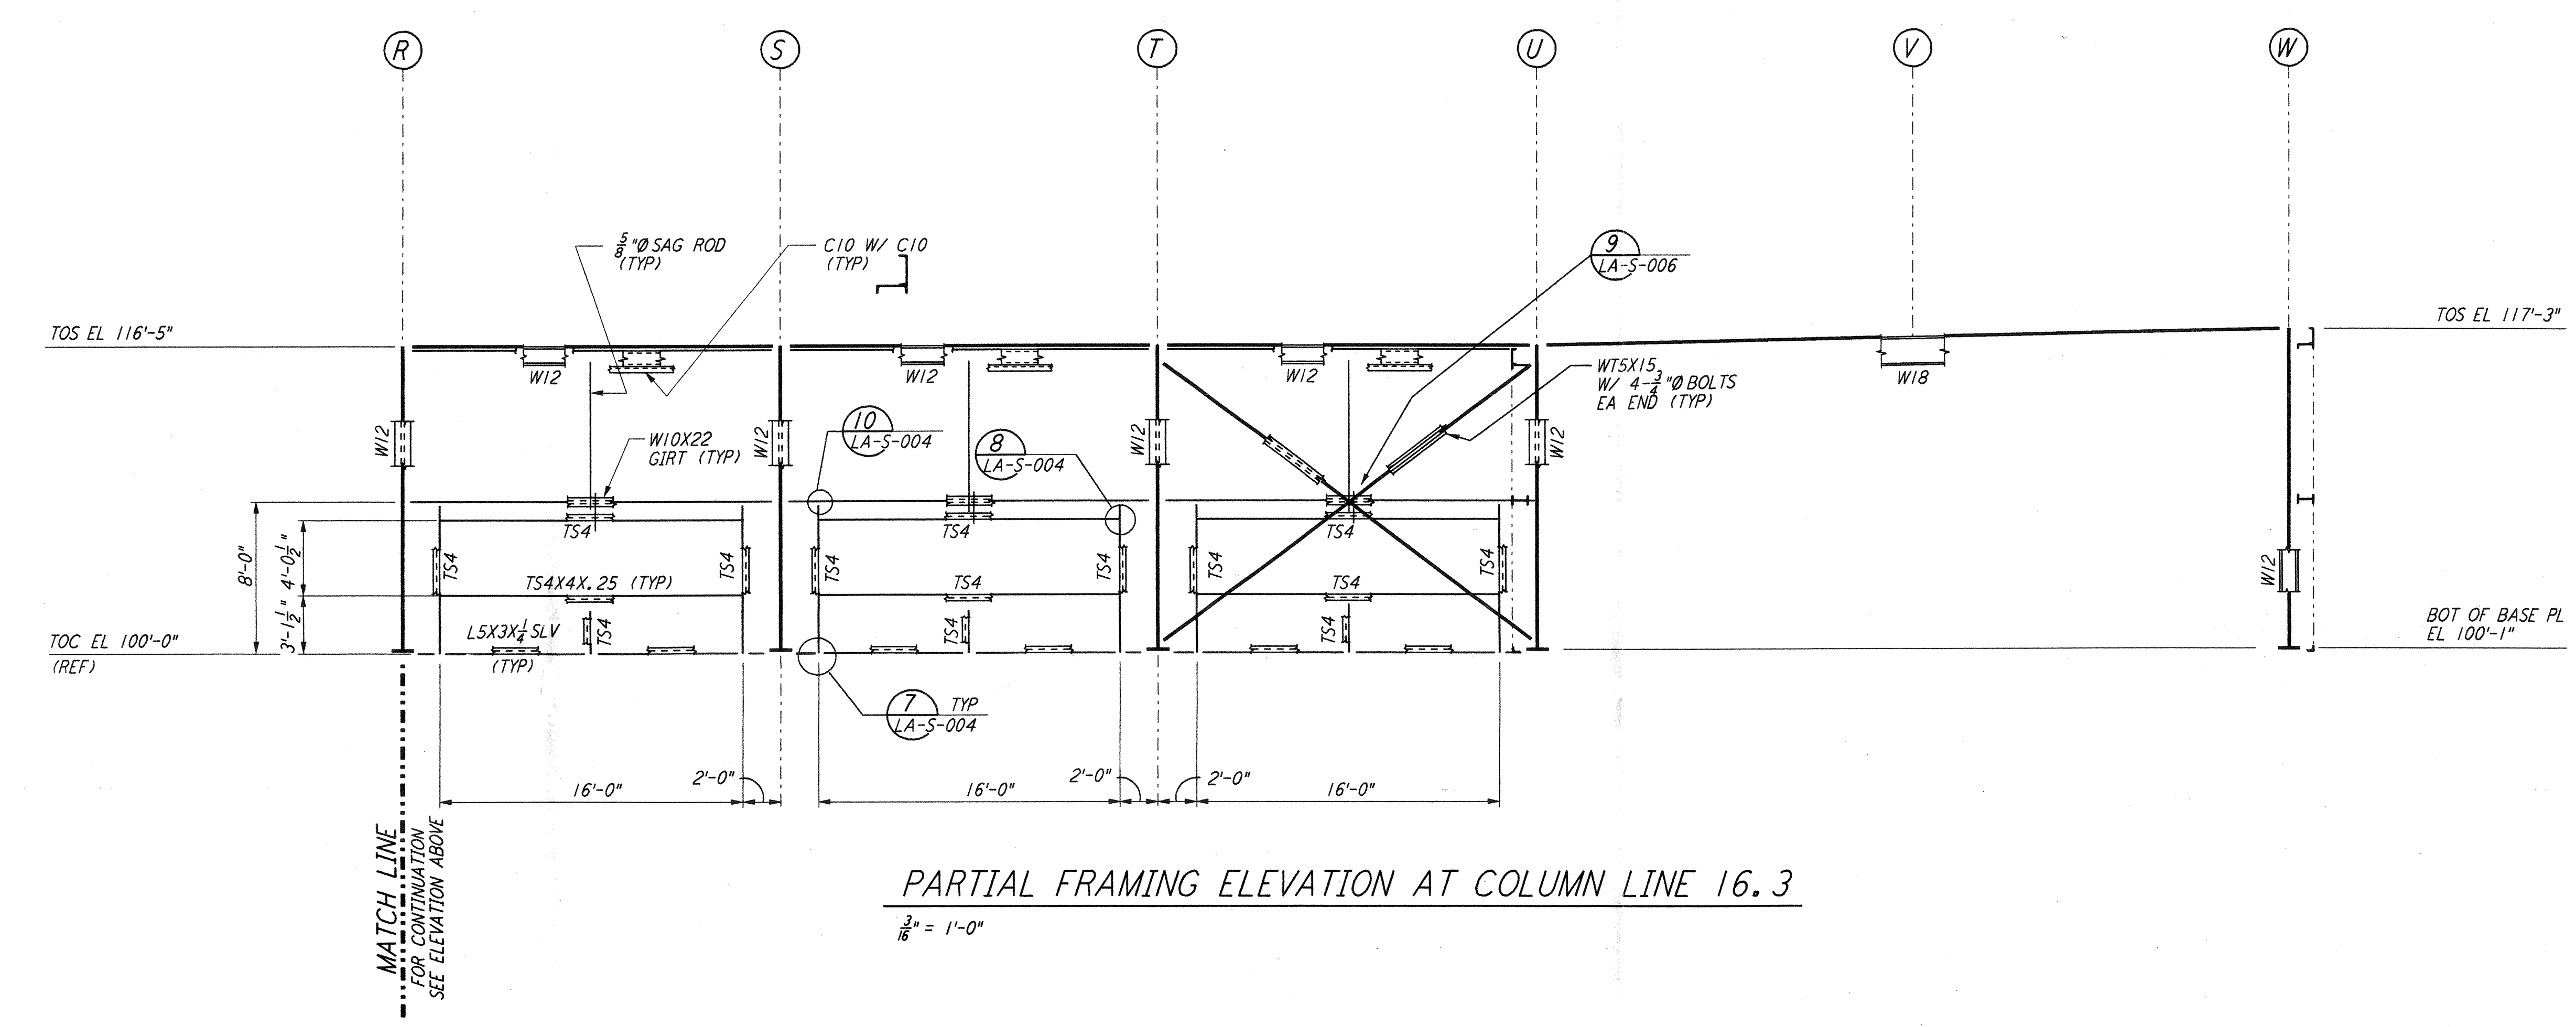

PARTIAL FRAMING ELEVATION AT COLUMN LINE 16.3
 $\frac{3}{16}'' = 1'-0''$

- NOTES:**
1. FOR GENERAL NOTES, ABBREVIATIONS AND SYMBOLS SEE DRAWING LA-S-001.
 2. FOR CHANNEL, GIRTS AND EAVE STRUT CONNECTION DETAILS SEE DRAWING LA-S-005.
 3. FOR W BEAM TO COLUMN WEB/FLANGE CONNECTIONS, SEE DETAILS (6) LA-S-004 & (4) LA-S-007 TYPICAL UNLESS OTHERWISE NOTED.
 4. FOR BASE ANGLE (L5X3) CONNECTIONS, SEE SECTION (A) LA-S-003
 5. FOR VERT BRGG CONNECTIONS SEE (2) LA-S-006 (8) LA-S-006 (1) LA-S-007 (2) LA-S-007 TYP UON.

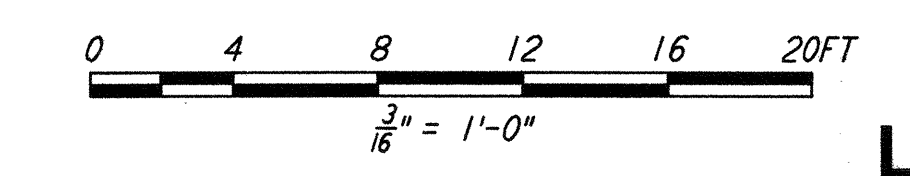

This document and the design it covers are the property of PARSONS. They are loaned only with the borrower's expressed written agreement that they will not be reproduced, copied, loaned, exhibited, or used in any other way, except by written consent from PARSONS to the borrower.

This document and the design it covers are the property of PARSONS. They are loaned only with the borrower's expressed written agreement that they will not be reproduced, copied, loaned, exhibited, or used in any other way, except by written consent from PARSONS to the borrower.

NO.	DATE	BY	CHKD	ENGR	PROJ	DESCRIPTION
2	08-07-98	WA	AB	BP	WU	ISSUED FOR AS-BUILT
1	2-28-97	RM	AB	BP		REV DIM AT ELEV LN 16.3

ISSUED FOR CONSTRUCTION		
DRAWN	MCS	11-15-96
CHECKED	DDM	11-15-96
ENGINEER	BP	11-15-96
PROJ	TDM	11-15-96

AS-BUILT DRAWINGS

PARSONS
 100 WEST WALNUT STREET
 PASADENA, CALIFORNIA

LIGO
 CALIFORNIA INSTITUTE OF TECHNOLOGY
 MASSACHUSETTS INSTITUTE OF TECHNOLOGY

LIGO-D960938-02-O

LASER INTERFEROMETER
 GRAVITATIONAL-WAVE OBSERVATORY
 SITE NO. 2 - LIVINGSTON, LOUISIANA

TITLE	SCALE	CONTRACT NUMBER	PROJECT NUMBER							
STRUCTURAL CORNER STATION OSB FRAMING ELEVATIONS SHEET 6	AS NOTED	PP150969	8094							
SHEET NUMBER	REVISIONS									
LA-S-122	<table border="1"> <tr> <td>NO.</td> <td>DATE</td> <td>BY</td> <td>CHKD</td> <td>ENGR</td> <td>PROJ</td> <td>DESCRIPTION</td> </tr> </table>			NO.	DATE	BY	CHKD	ENGR	PROJ	DESCRIPTION
NO.	DATE	BY	CHKD	ENGR	PROJ	DESCRIPTION				