




FRAMING ELEVATION AT COLUMN LINE 17
 3/8" = 1'-0"

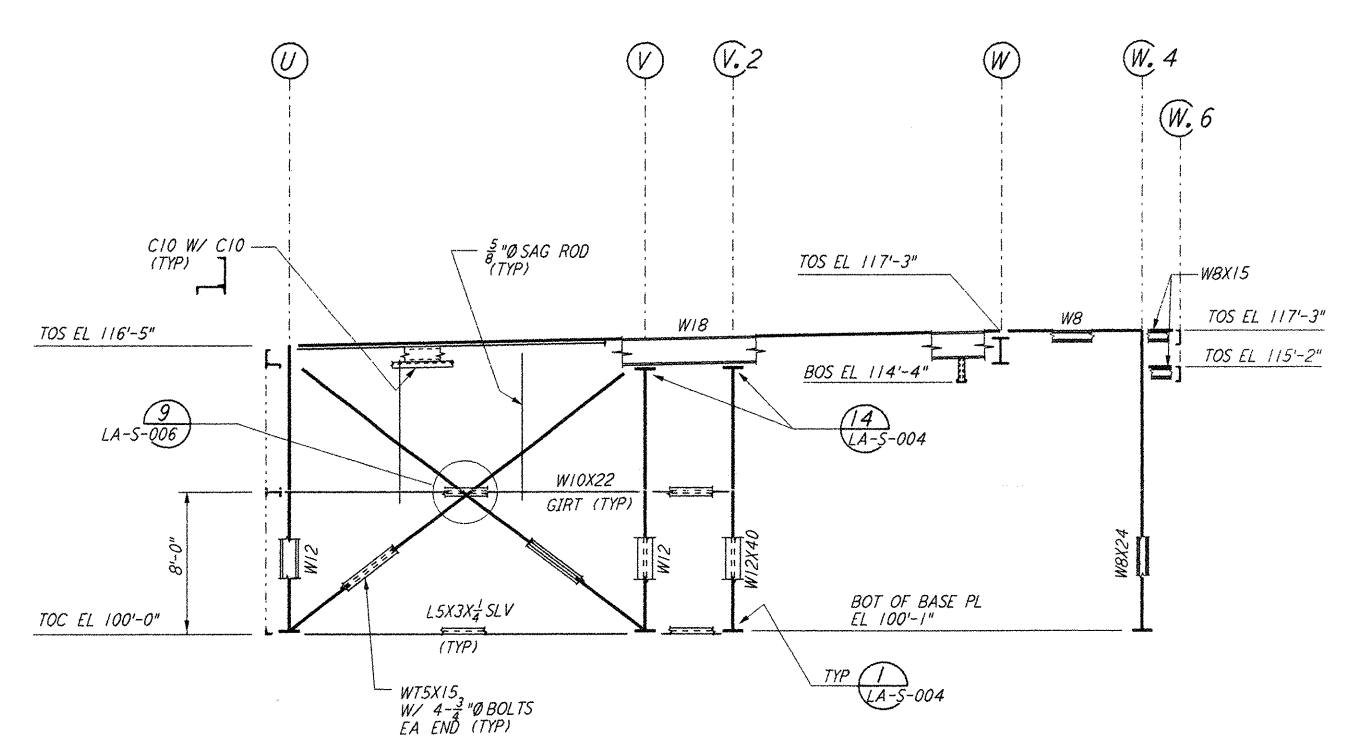


FRAMING ELEVATION AT COLUMN LINE 18
 3/8" = 1'-0"

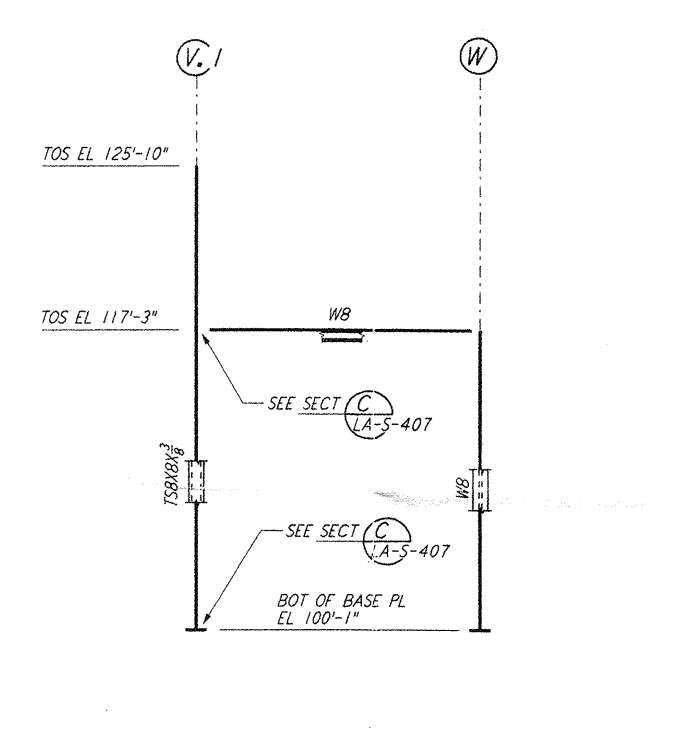


FRAMING ELEVATION AT COLUMN LINE 18.4
 3/8" = 1'-0"

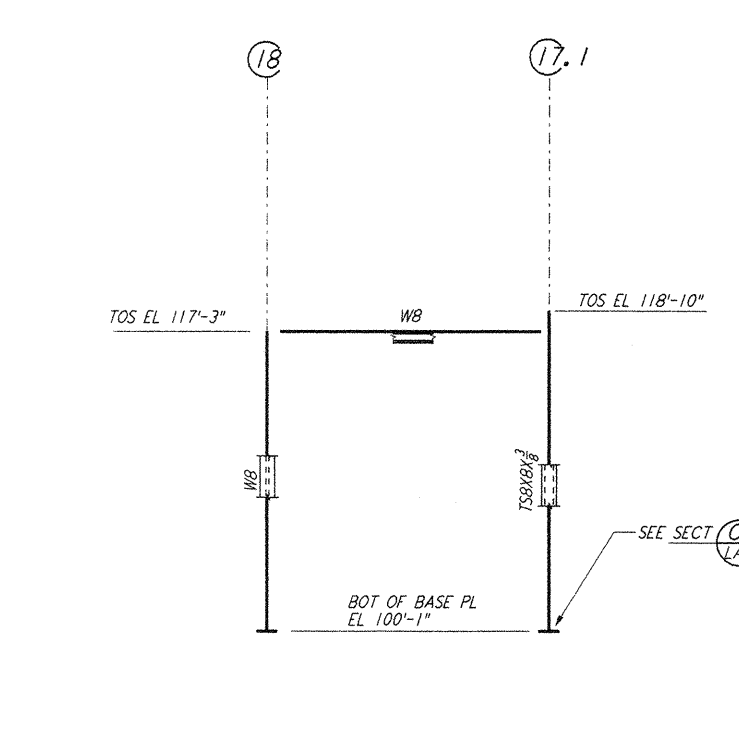


FRAMING ELEVATION AT COLUMN LINE W.4
 3/8" = 1'-0"

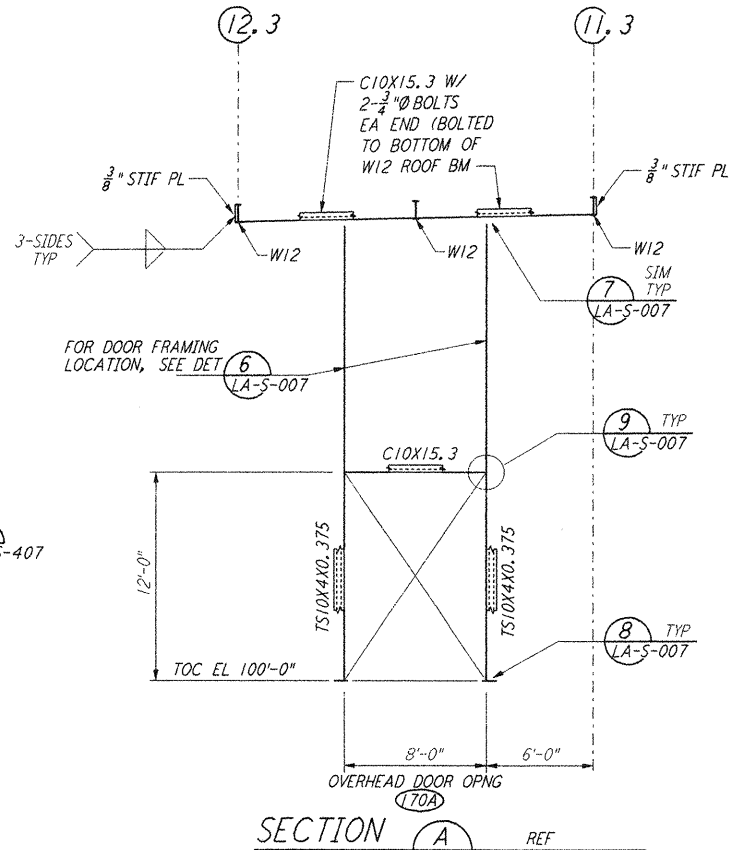


SECTION A REF
 3/8" = 1'-0" LA-S-123 LA-S-116

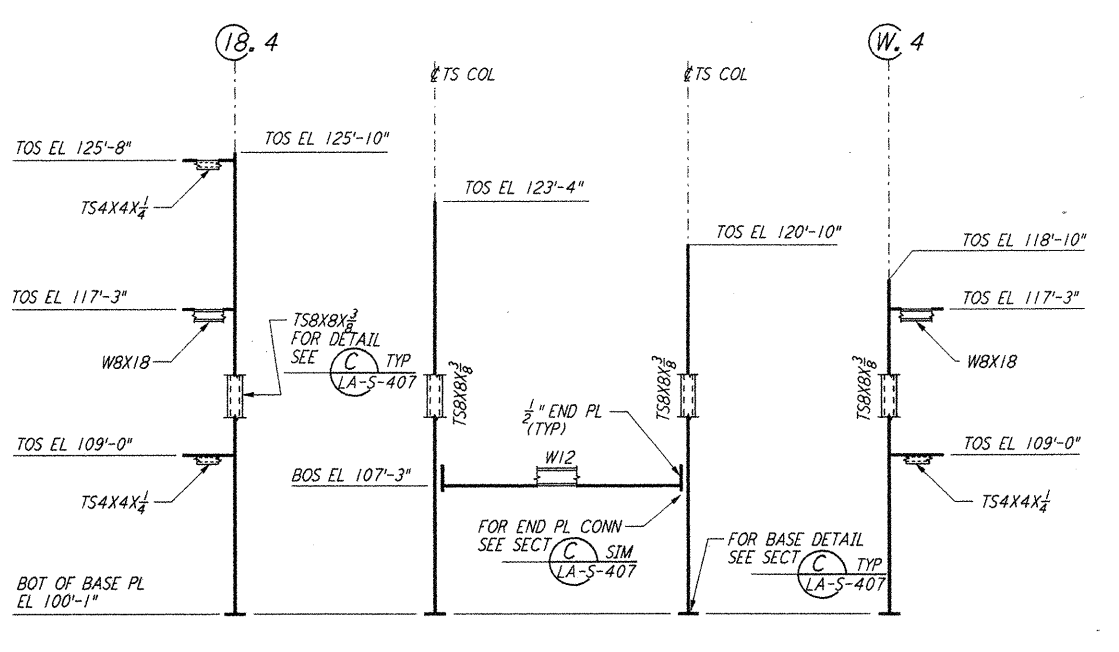


DEVELOPED FRAMING ELEVATION
 3/8" = 1'-0" B REF LA-S-123 LA-S-116

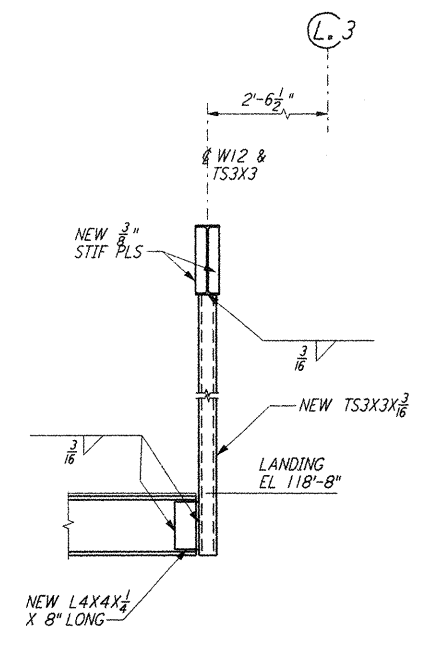

SECTION C REF
 3/8" = 1'-0" LA-S-123 LA-S-116

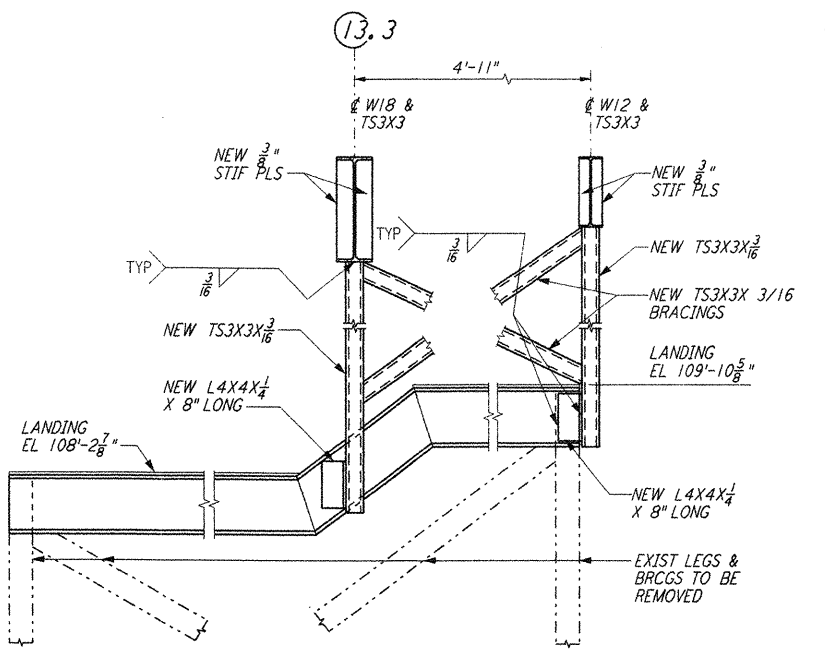


SECTION D REF
 3/8" = 1'-0" LA-S-123 LA-S-116

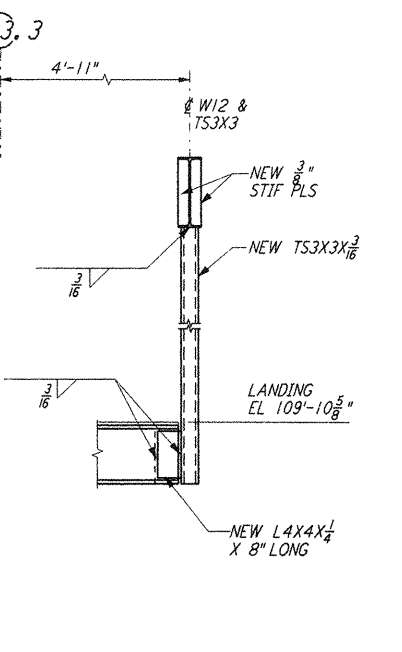

SECTION E REF
 3/8" = 1'-0" LA-S-123 LA-S-116

- NOTES:
1. FOR GENERAL NOTES, ABBREVIATIONS AND SYMBOLS SEE DRAWING LA-S-001.
 2. FOR CHANNEL, GIRT AND EAVE STRUT CONNECTION DETAILS SEE DRAWING LA-S-005.
 3. FOR W BEAM TO COLUMN WEB/FLANGE CONNECTIONS, SEE DETAILS (6) LA-S-004 & (4) LA-S-007 TYPICAL UNLESS OTHERWISE NOTED.
 4. FOR BASE ANGLE (LSX) CONNECTIONS, SEE SECTION (A) LA-S-003.
 5. FOR VERT BRCCG CONNECTIONS SEE (2) LA-S-006 (B) LA-S-006 (1) LA-S-007 (2) LA-S-007 TYP UNON.

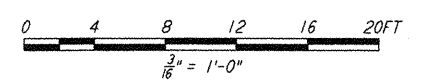

| NO. | DATE | BY | CHKD | ENGR | PROJ | DESCRIPTION |
|-----|----------|----|------|------|------|---------------------|
| 1 | 08-07-98 | WA | | | | ISSUED FOR AS-BUILT |

| ISSUED FOR CONSTRUCTION | | |
|-------------------------|-----|----------|
| DRAWN | MCS | 11-15-96 |
| CHECKED | DDM | 11-15-96 |
| ENGINEER | BP | 11-15-96 |
| PROJ | TDM | 11-15-96 |

AS-BUILT DRAWINGS

PARSONS
 100 WEST WALNUT STREET
 PASADENA, CALIFORNIA

LIGO
 CALIFORNIA INSTITUTE OF TECHNOLOGY
 MASSACHUSETTS INSTITUTE OF TECHNOLOGY

LIGO-D960939-01-0
 LASER INTERFEROMETER
 GRAVITATIONAL-WAVE OBSERVATORY
 SITE NO. 2 - LIVINGSTON, LOUISIANA

SCALE: AS NOTED
 CONTRACT NUMBER: PP150969
 PROJECT NUMBER: 8094

SHEET NUMBER: LA-S-123
 SHEET 7

This document and the design it covers are the property of PARSONS. They are loaned only with the borrower's expressed written agreement that they will not be reproduced, copied, loaned, exhibited, or used in any other way, except by written consent from PARSONS to the borrower.

Non-Avg 17 08/57/98 1998 C:\PILOT\Q\ME\33-V\3862.DCF 52885 K:\V3862\4123.dwg