




ROOF FRAMING PLAN  
 $\frac{1}{4}'' = 1'-0''$

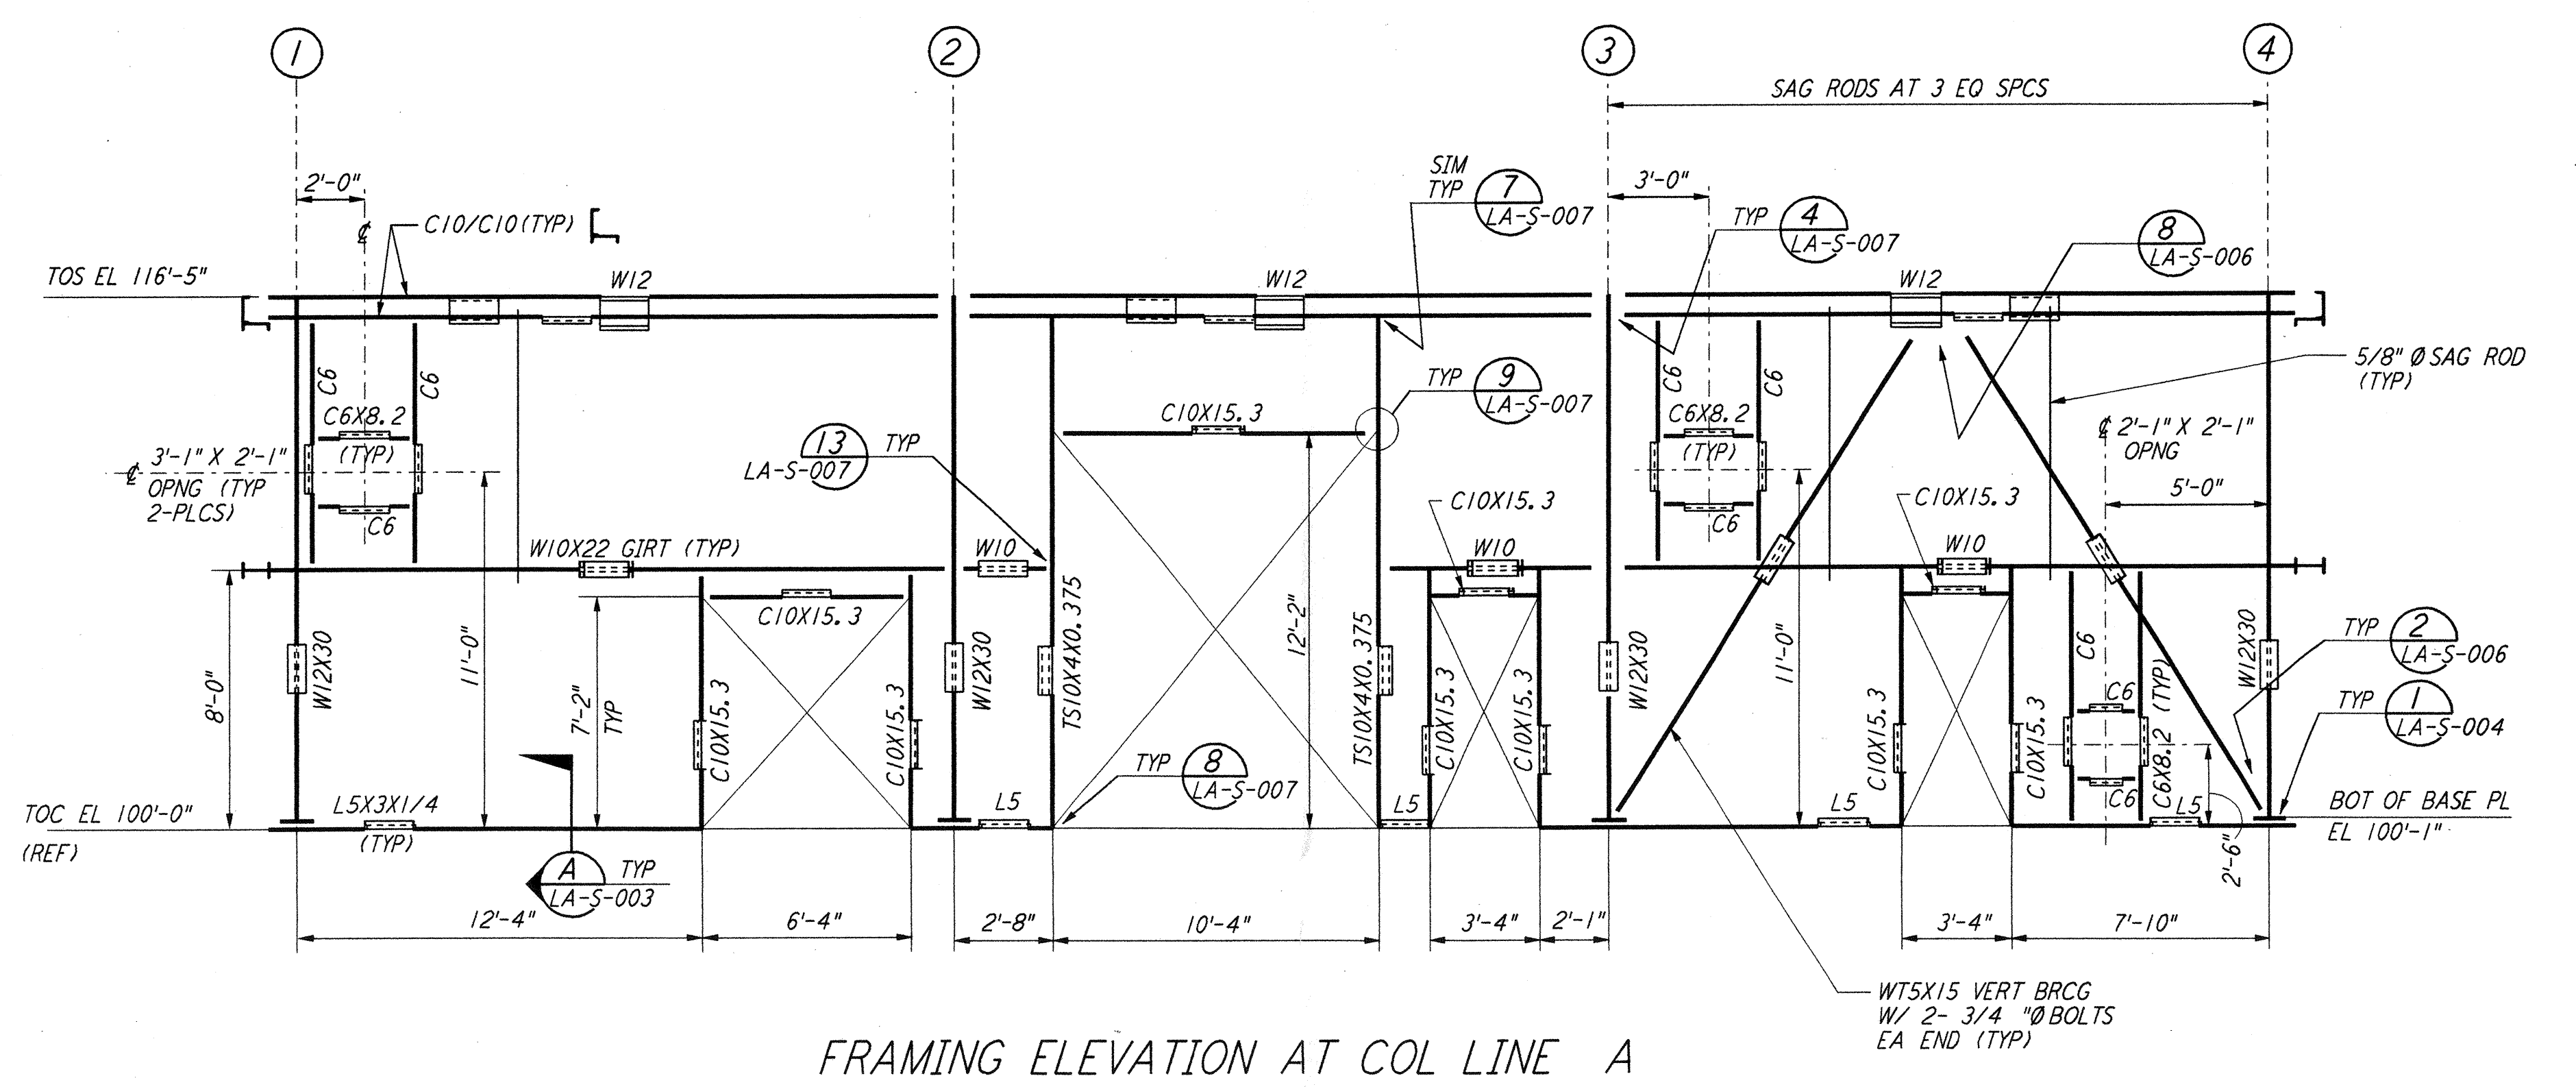


FRAMING ELEVATION AT COL LINE A  
 $\frac{1}{4}'' = 1'-0''$

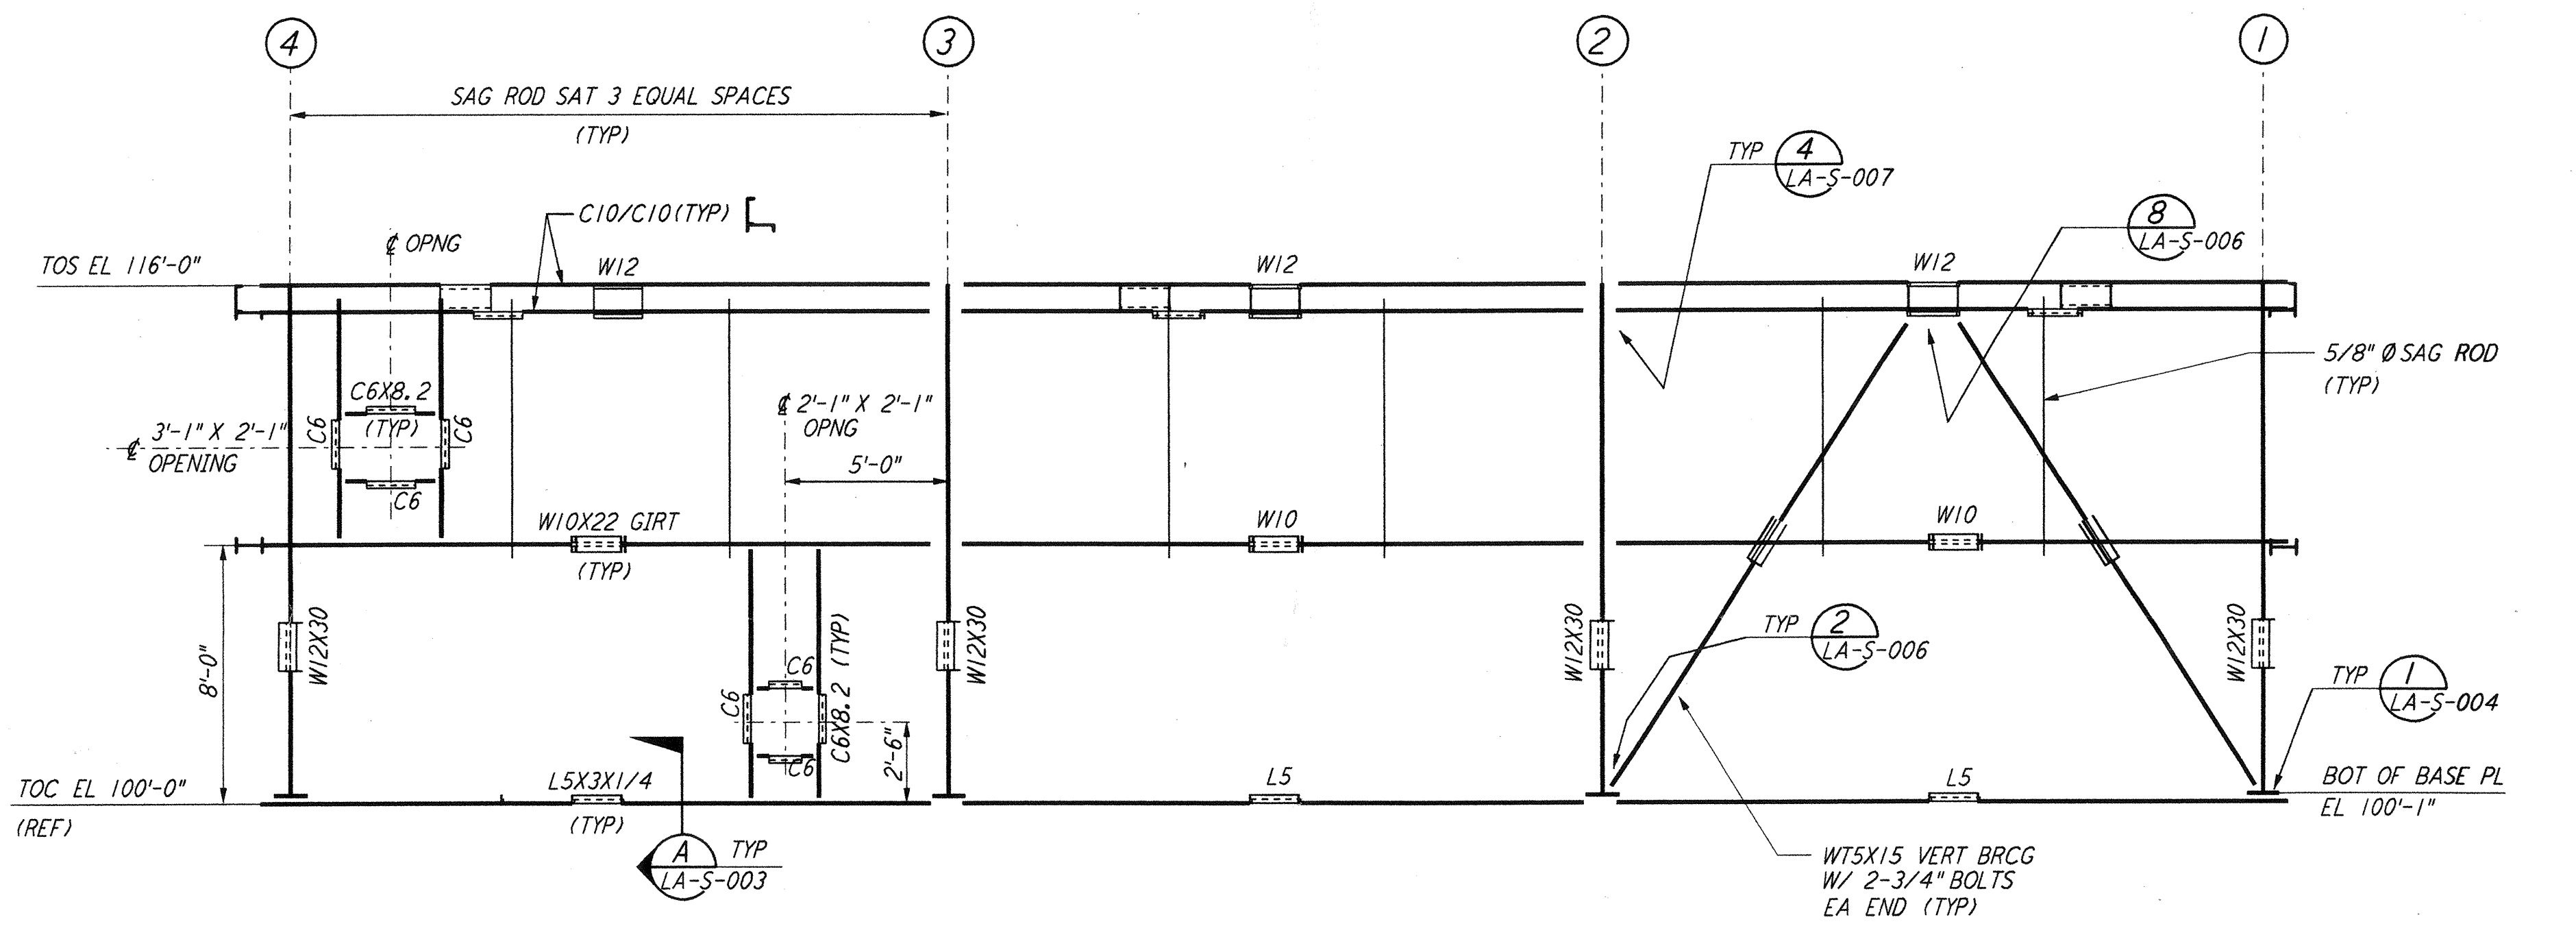

FRAMING ELEVATION AT COL LINE B  
 $\frac{1}{4}'' = 1'-0''$


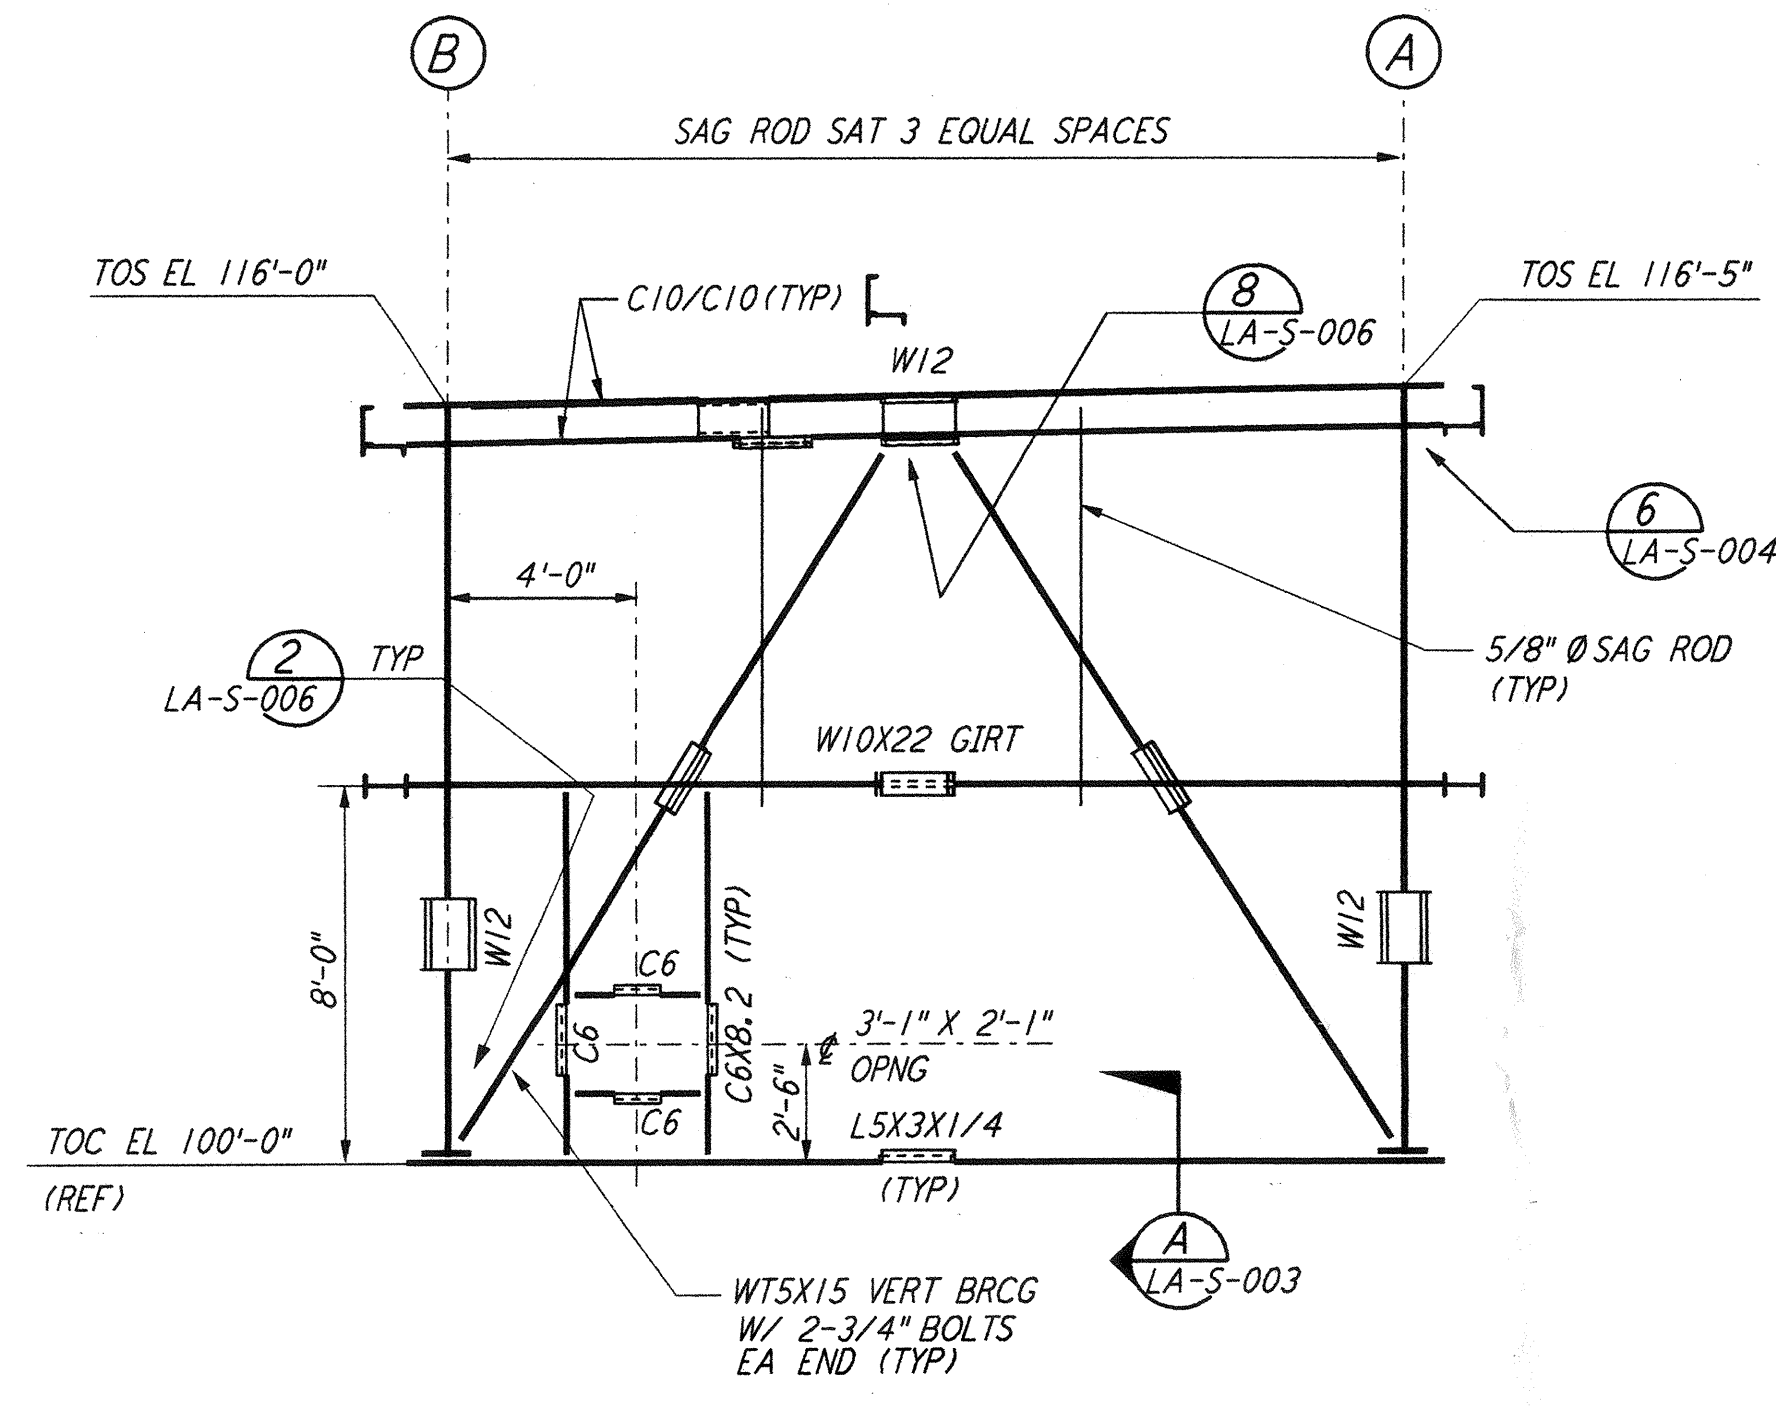


FRAMING ELEVATION AT COL LINE 1  
 $\frac{1}{4}'' = 1'-0''$

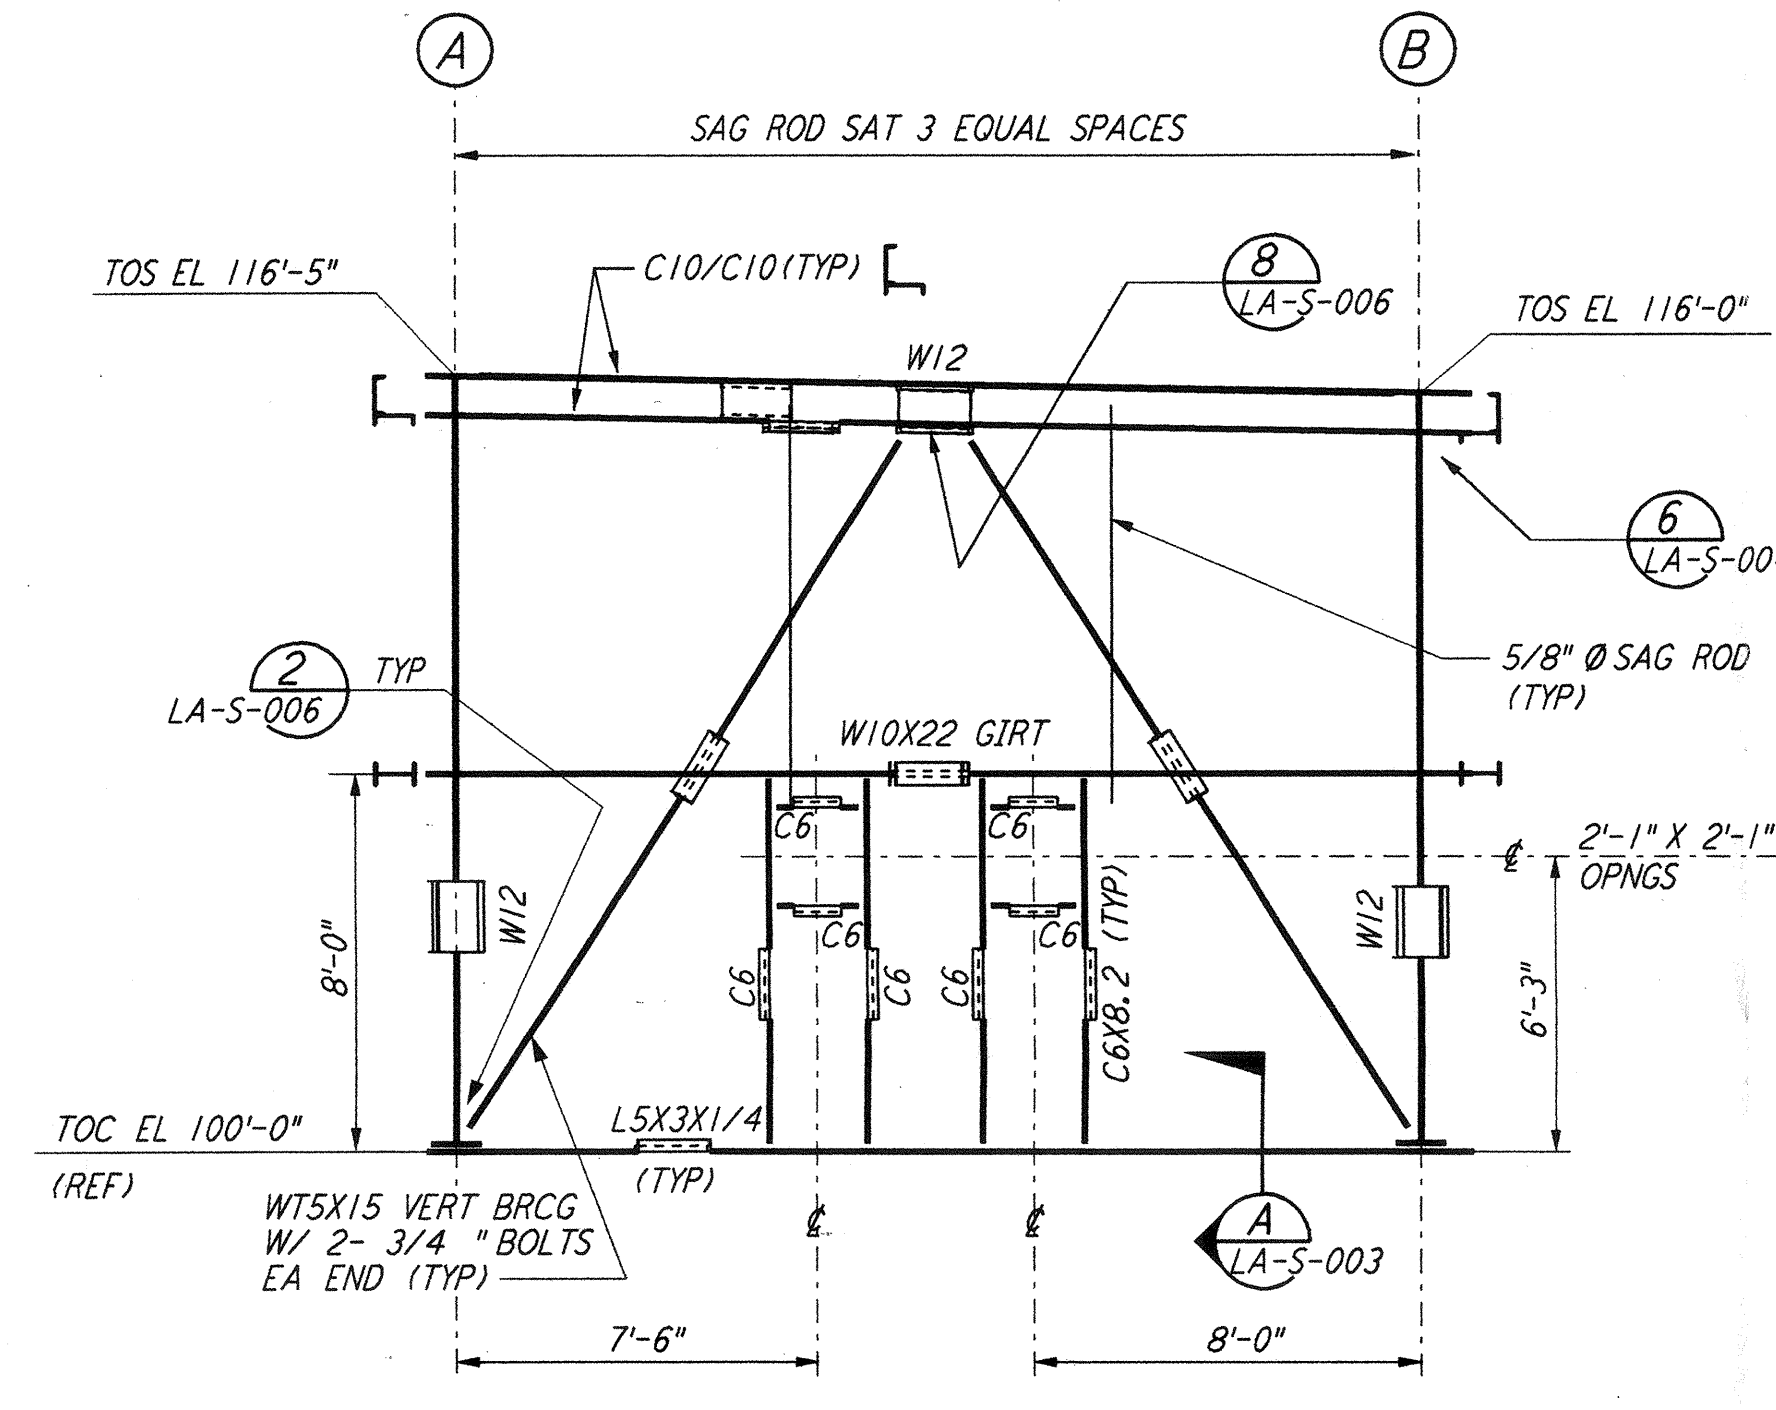

FRAMING ELEVATION AT COL LINE 4  
 $\frac{1}{4}'' = 1'-0''$

- NOTES:
- FOR GENERAL NOTES, ABBREVIATIONS AND SYMBOLS, SEE DRAWING LA-S-001.
  - FOR CHANNEL, GIRT AND EAVE STRUT CONNECTION DETAILS, SEE DRAWING LA-S-005.

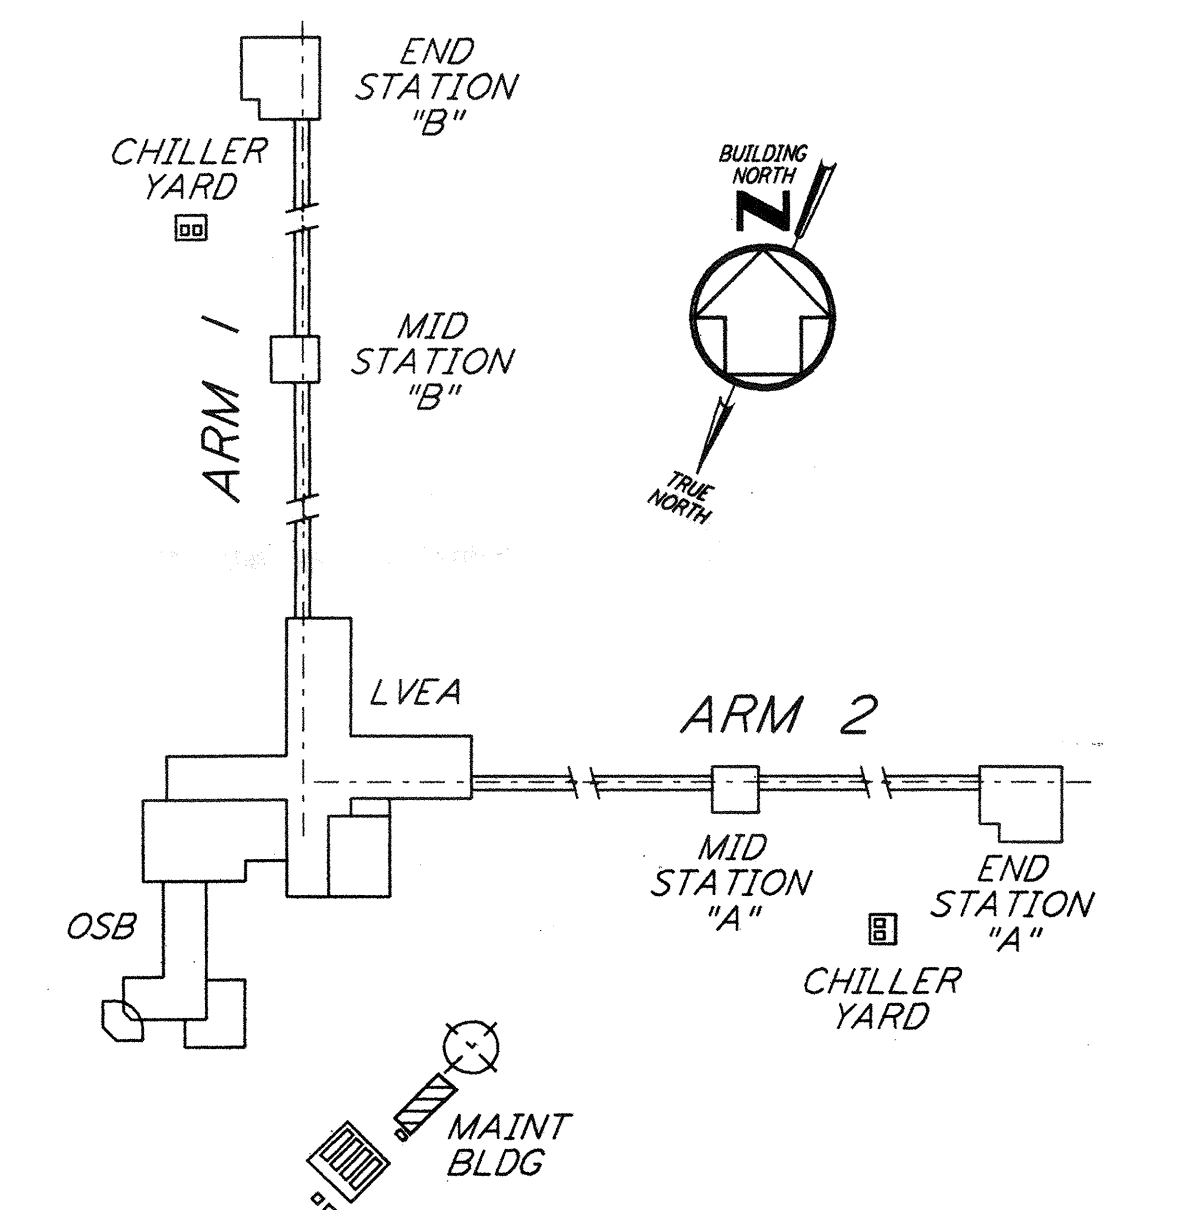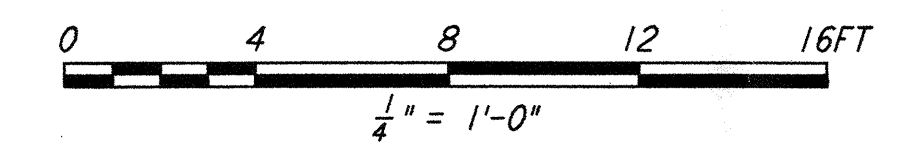

KEY PLAN  
**LIGO-D960941-02-0**

NO.	DATE	BY	CHKD	ENGR	PROJ	DESCRIPTION
2	08-07-98	WA	PK	DM	WV	ISSUED FOR AS-BUILT
1	2-28-97	RM	AB	BP		REV OPNG HEAD DIM AT ELEV LN A

ISSUED FOR CONSTRUCTION  
 DRAWN PK 11-15-96  
 CHECKED DDM 11-15-96  
 ENGINEER BP 11-15-96  
 PROJ TDM 11-15-96

**AS-BUILT DRAWINGS**

**PARSONS**  
 100 WEST WALNUT STREET  
 PASADENA, CALIFORNIA

**LIGO**  
 CALIFORNIA INSTITUTE OF TECHNOLOGY  
 MASSACHUSETTS INSTITUTE OF TECHNOLOGY

LASER INTERFEROMETER  
 GRAVITATIONAL-WAVE OBSERVATORY  
 SITE NO. 2 - LIVINGSTON, LOUISIANA

STRUCTURAL  
 MAINTENANCE BUILDING  
 ROOF FRAMING PLAN &  
 FRAMING ELEVATIONS

SCALE: AS NOTED  
 CONTRACT NUMBER: PPI50969  
 PROJECT NUMBER: 8094

SHEET NUMBER: **LA-S-125**

This document and the design it covers are the property of PARSONS. They are loaned only with the borrower's expressed written agreement that they will not be reproduced, copied, loaned, exhibited, or used in any other way, except by written consent from PARSONS to the borrower.