




ROOF FRAMING PLAN
 $\frac{1}{4}'' = 1'-0''$

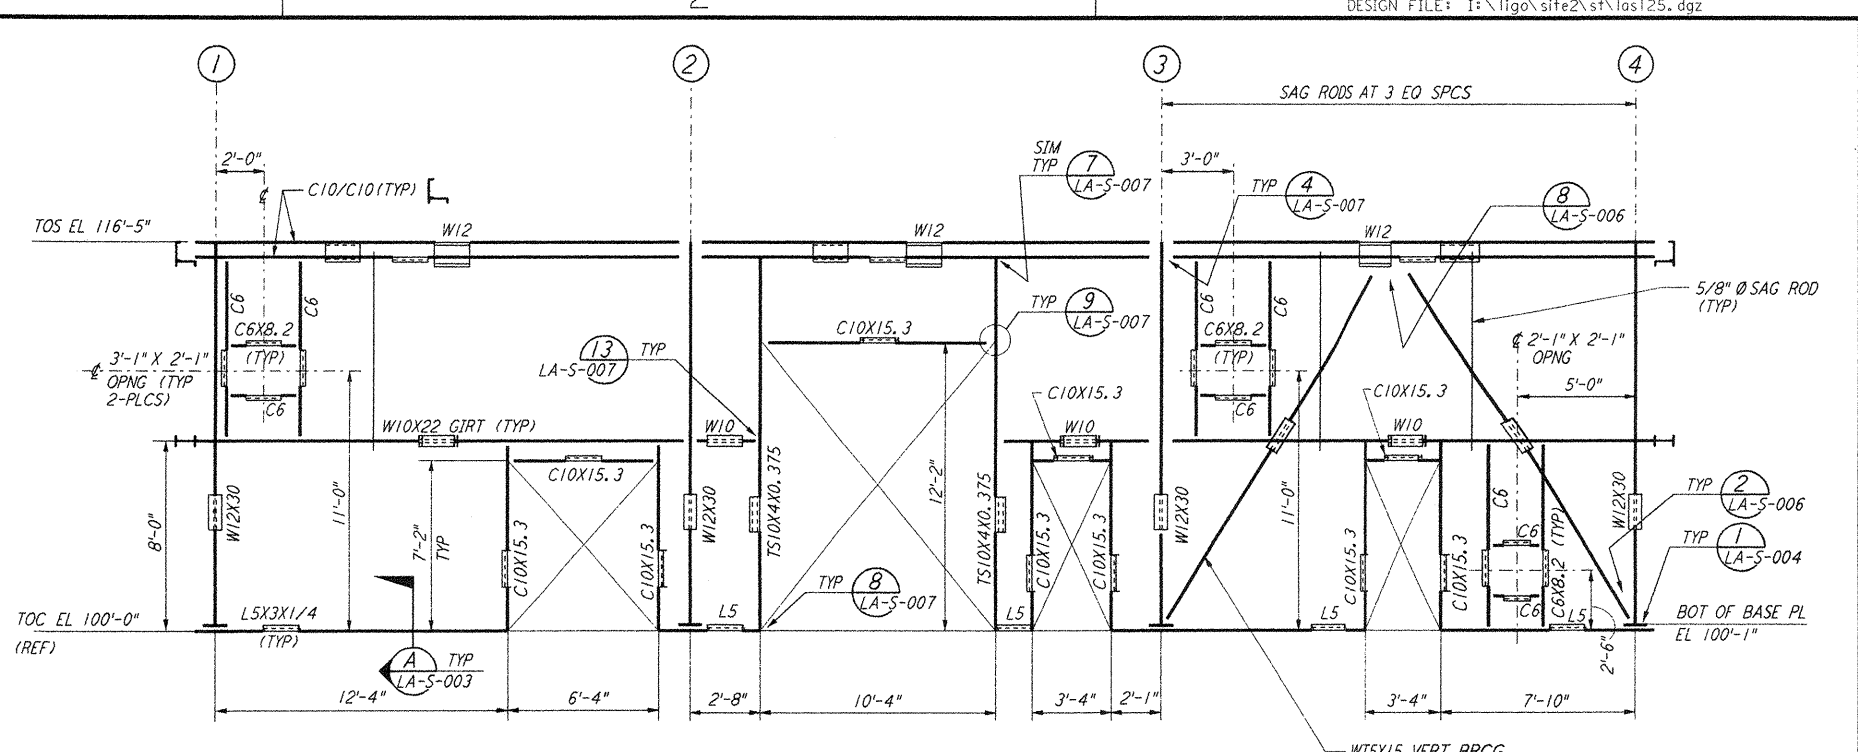


FRAMING ELEVATION AT COL LINE A
 $\frac{1}{4}'' = 1'-0''$

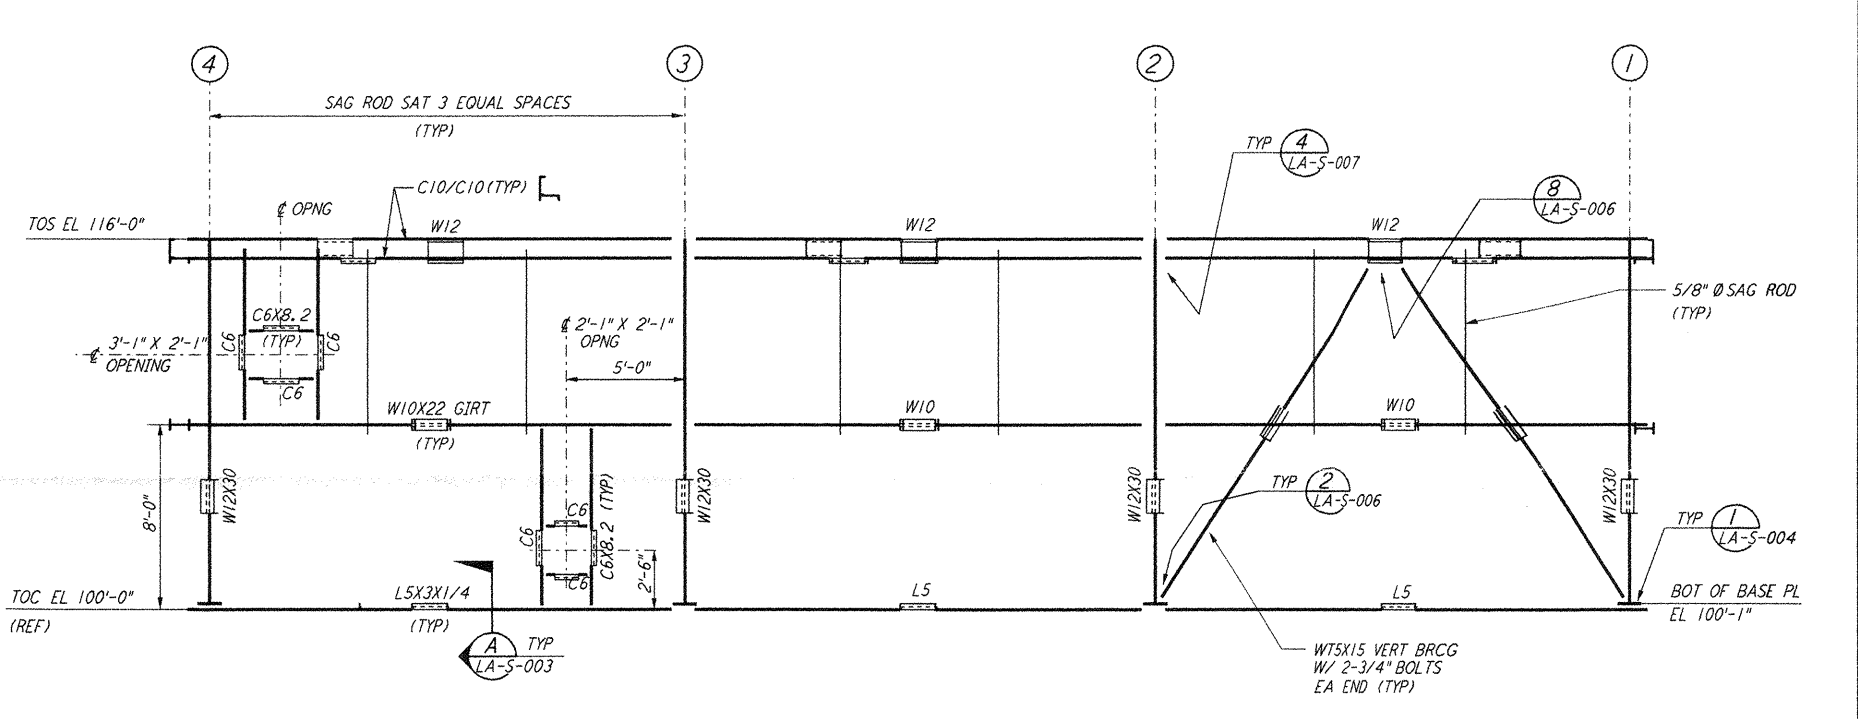

FRAMING ELEVATION AT COL LINE B
 $\frac{1}{4}'' = 1'-0''$

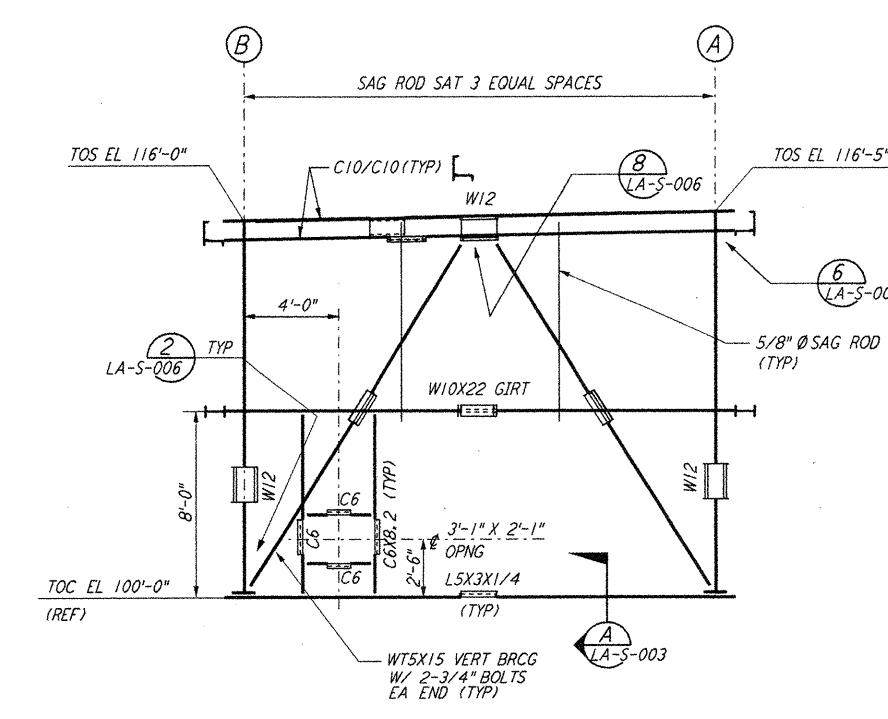


FRAMING ELEVATION AT COL LINE 1
 $\frac{1}{4}'' = 1'-0''$

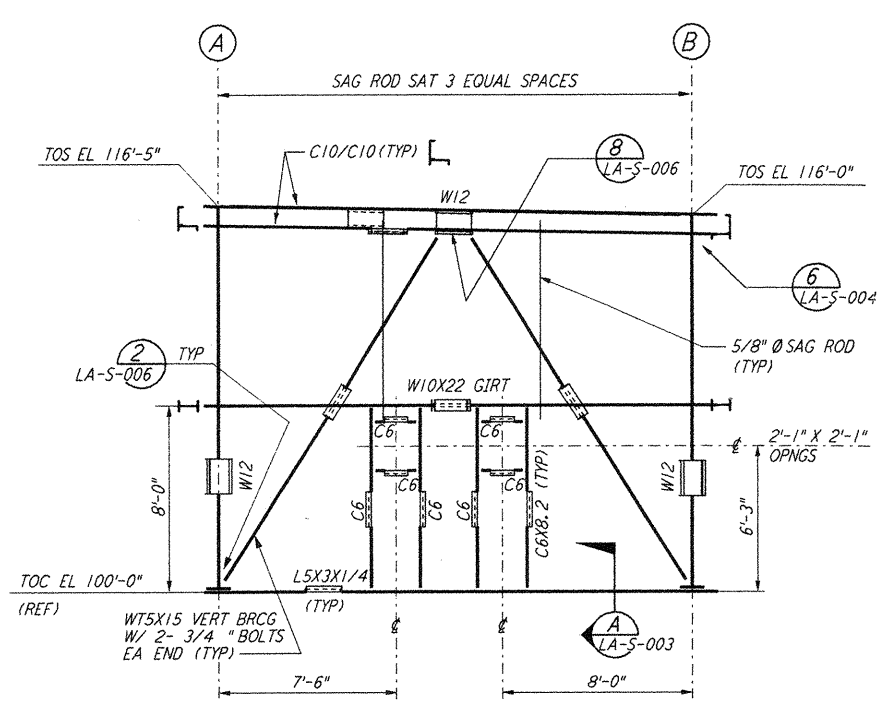

FRAMING ELEVATION AT COL LINE 4
 $\frac{1}{4}'' = 1'-0''$

- NOTES:**
- FOR GENERAL NOTES, ABBREVIATIONS AND SYMBOLS, SEE DRAWING LA-S-001.
 - FOR CHANNEL, GIRT AND EAVE STRUT CONNECTION DETAILS, SEE DRAWING LA-S-005.

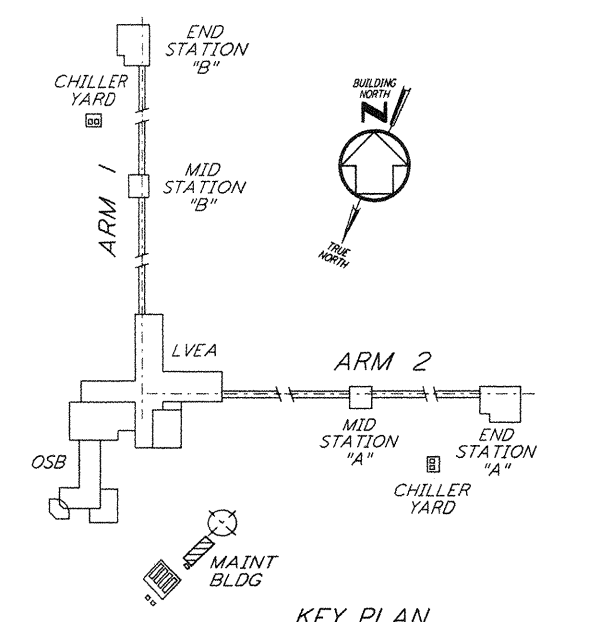

KEY PLAN
LIGO-D960941-02-0

NO.	DATE	BY	CHKD	ENGR	PROJ	DESCRIPTION
2	08-07-98	WA	AB	BP	WJW	ISSUED FOR AS-BUILT
1	2-28-97	AM	AB	BP		REV OPNG HEAD DIM AT ELEV LN A

ISSUED FOR CONSTRUCTION		
DRAWN	PK	11-15-96
CHECKED	DDM	11-15-96
ENGINEER	BP	11-15-96
PROJ	TDM	11-15-96

AS-BUILT DRAWINGS

PARSONS
 100 WEST WALNUT STREET
 PASADENA, CALIFORNIA

LIGO
 CALIFORNIA INSTITUTE OF TECHNOLOGY
 MASSACHUSETTS INSTITUTE OF TECHNOLOGY

LASER INTERFEROMETER GRAVITATIONAL-WAVE OBSERVATORY SITE NO. 2 - LIVINGSTON, LOUISIANA

TITLE: **STRUCTURAL MAINTENANCE BUILDING ROOF FRAMING PLAN & FRAMING ELEVATIONS**

SCALE: AS NOTED

CONTRACT NUMBER: PP150969

PROJECT NUMBER: 8094

SHEET NUMBER: **LA-S-125**

REVISIONS: 2

This document and the design it covers are the property of PARSONS. They are loaned only with the borrower's expressed written agreement that they will not be reproduced, copied, loaned, exhibited, or used in any other way, except by written consent from PARSONS to the borrower.