




ROOF FRAMING PLAN
 $\frac{1}{4}'' = 1'-0''$

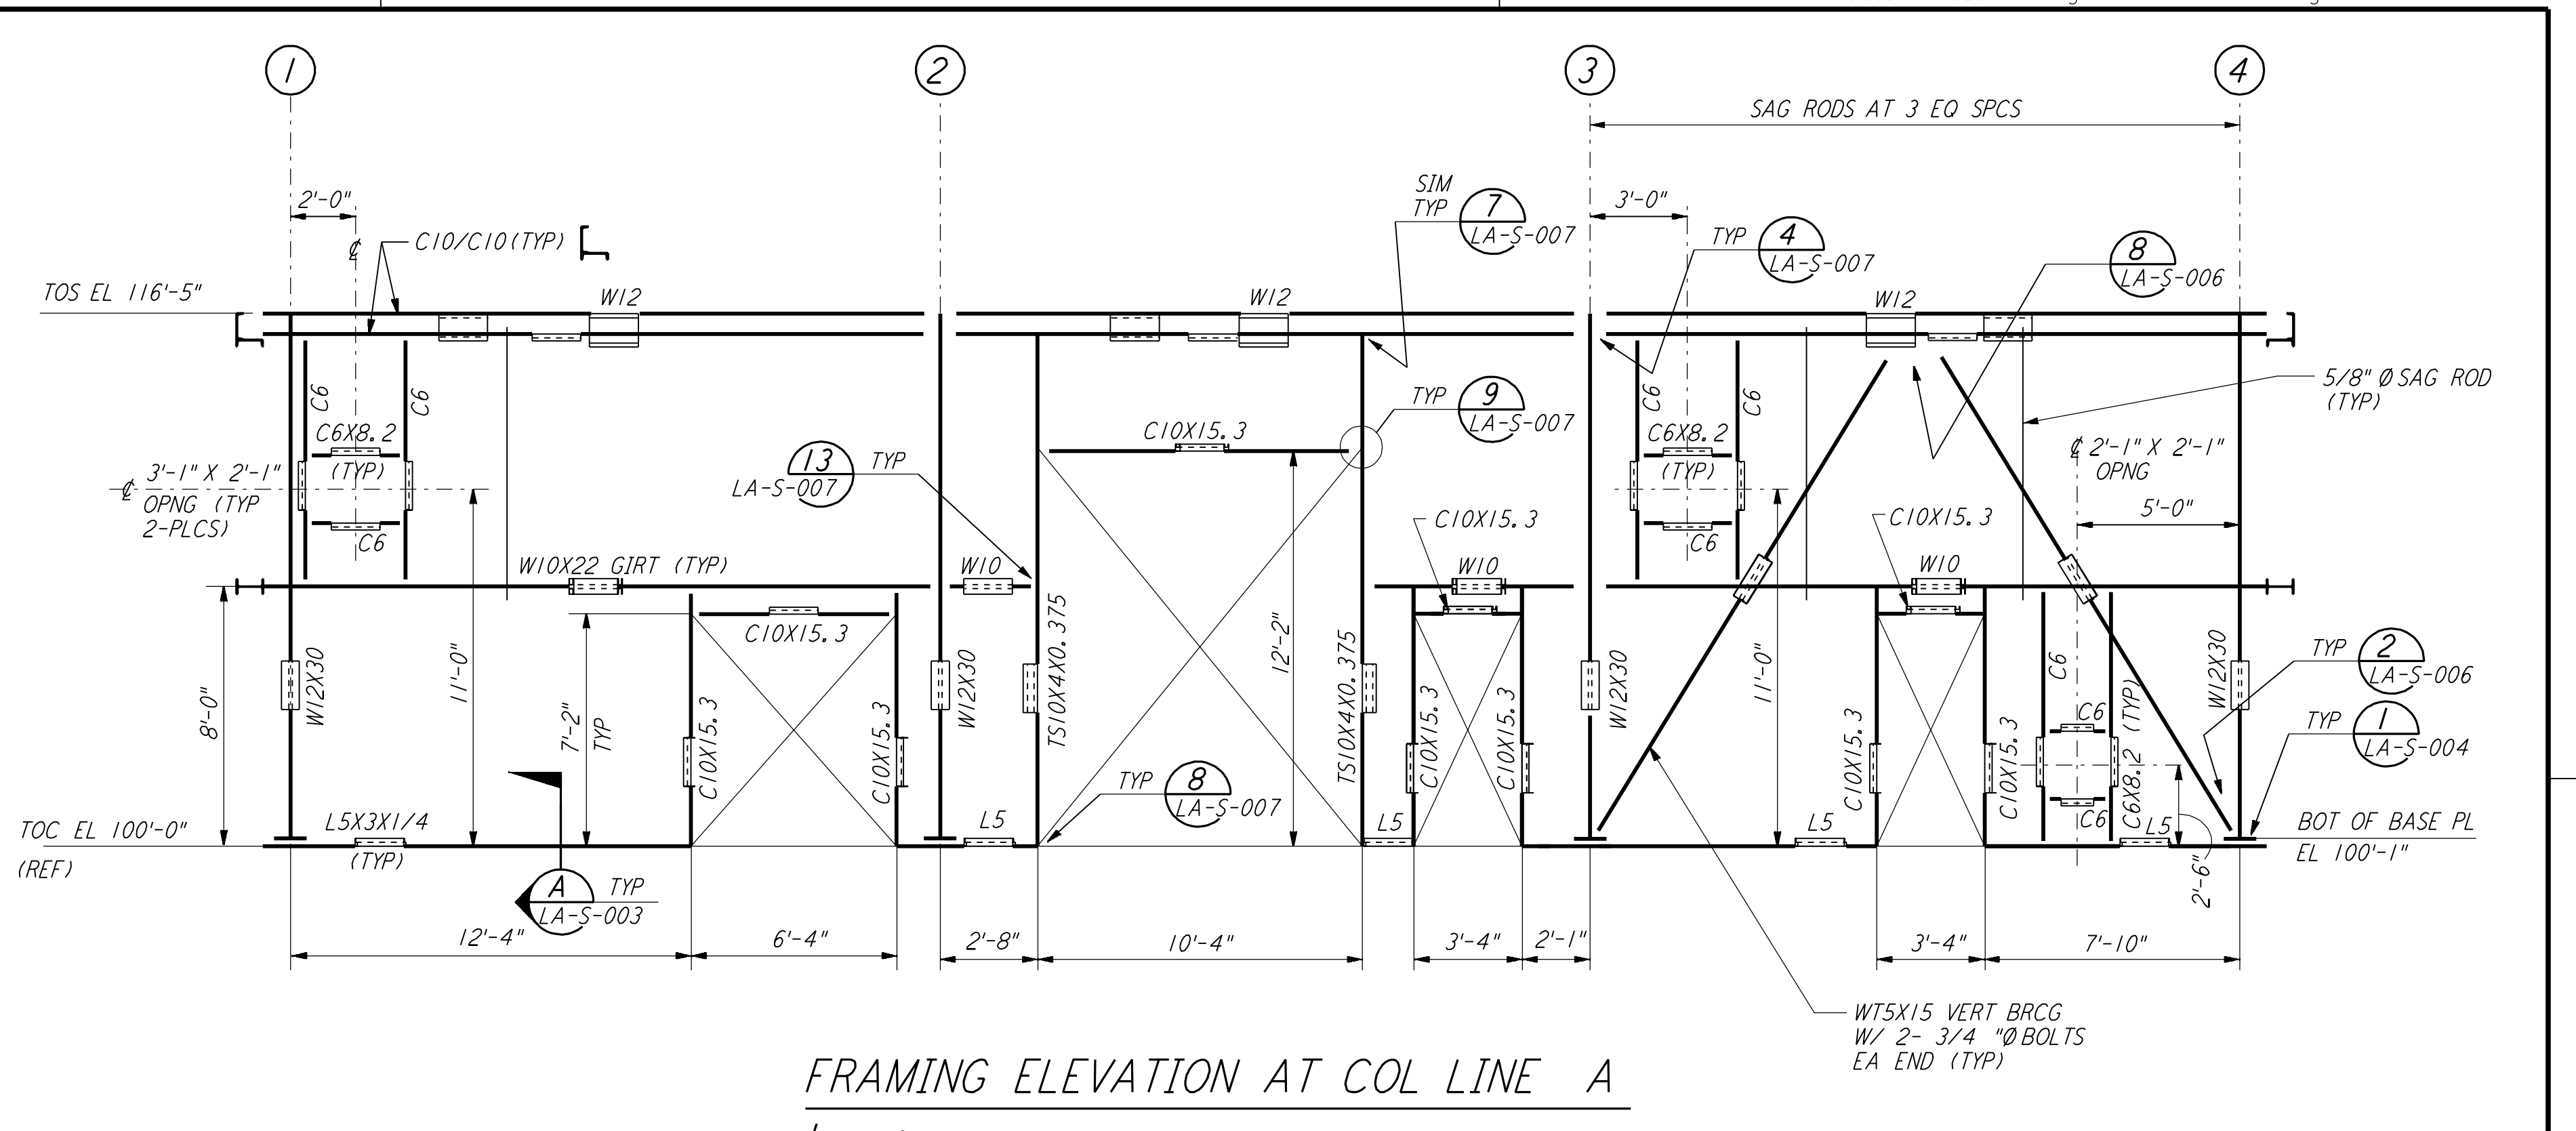


FRAMING ELEVATION AT COL LINE A
 $\frac{1}{4}'' = 1'-0''$

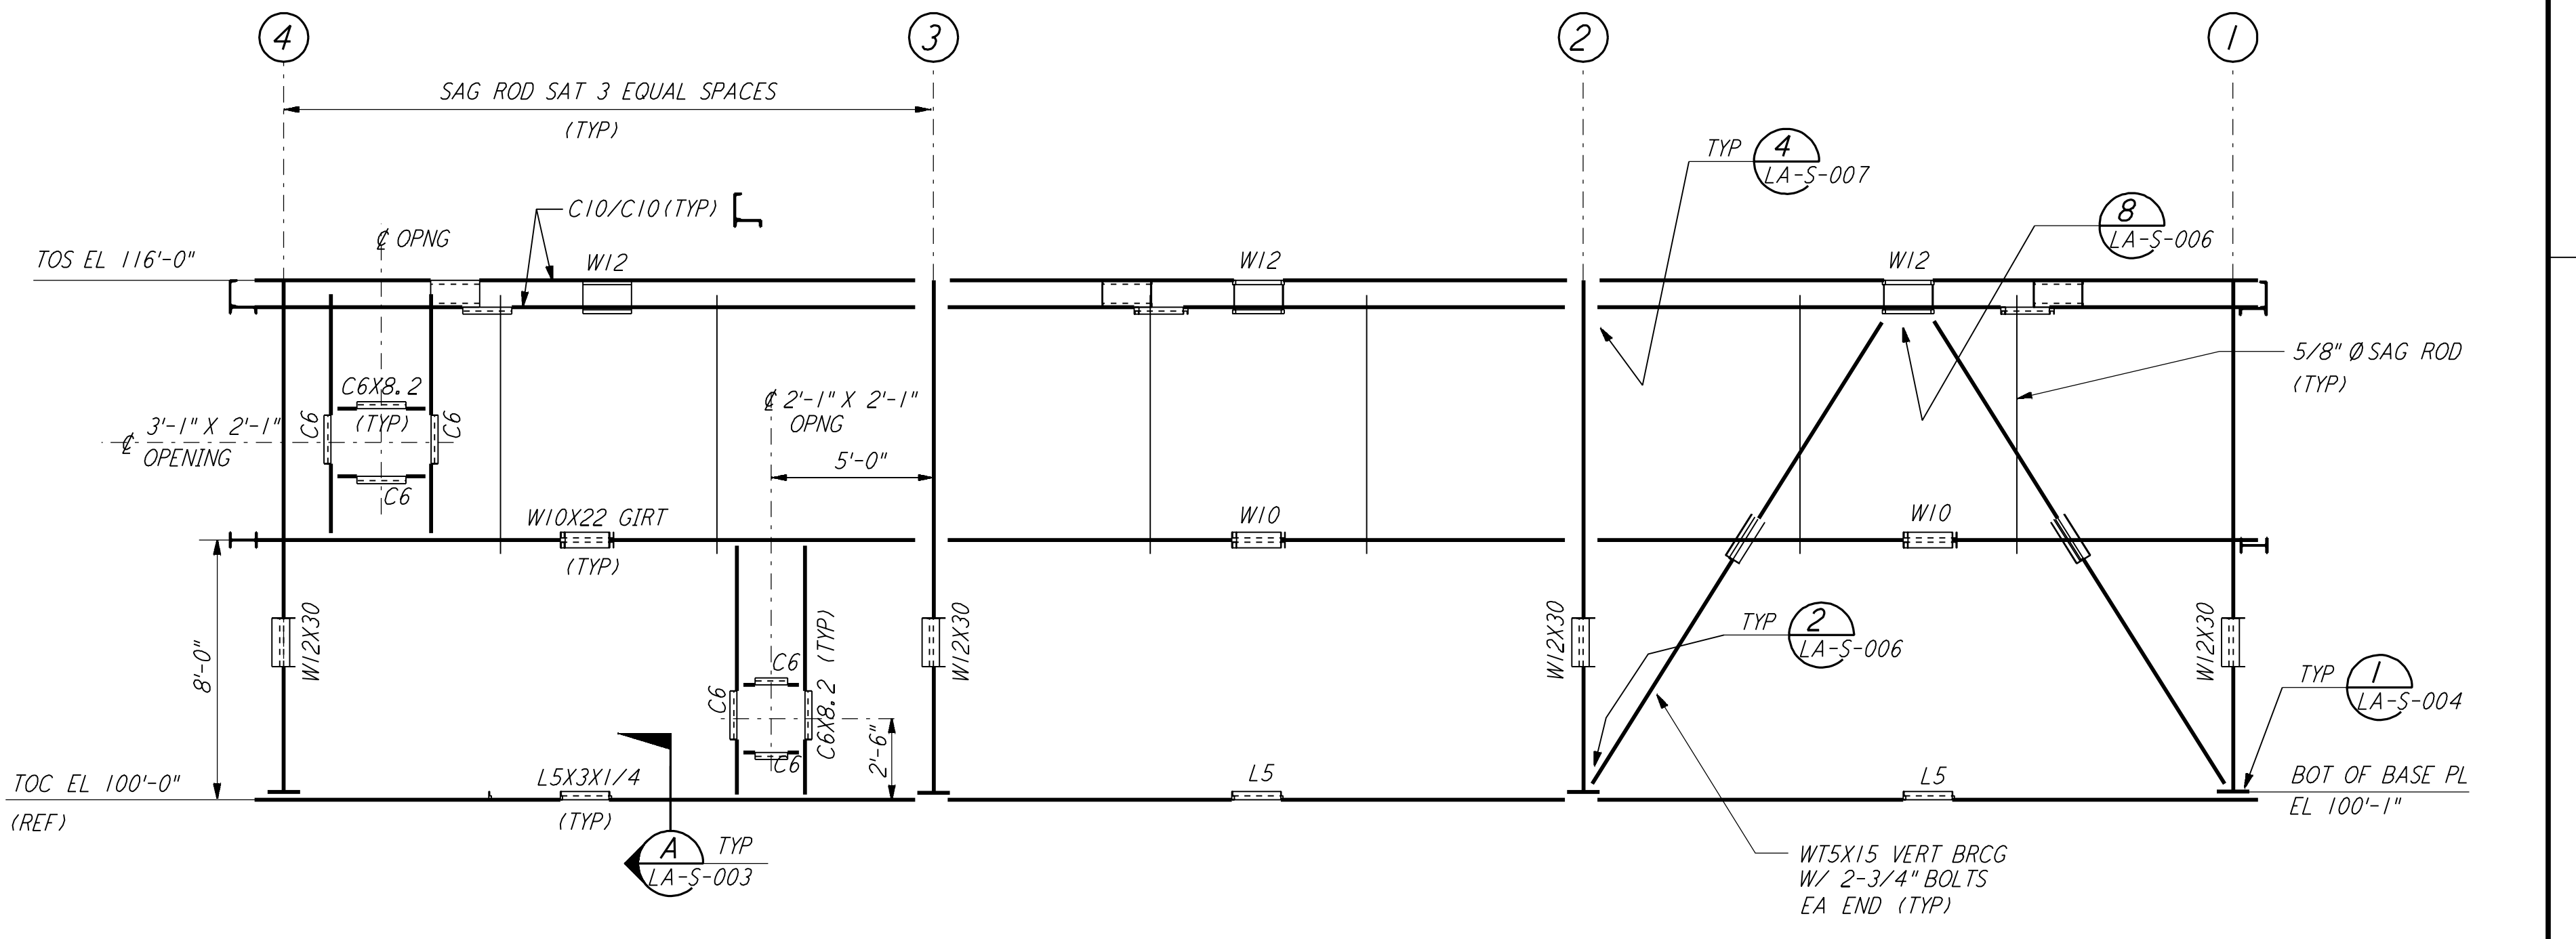

FRAMING ELEVATION AT COL LINE B
 $\frac{1}{4}'' = 1'-0''$


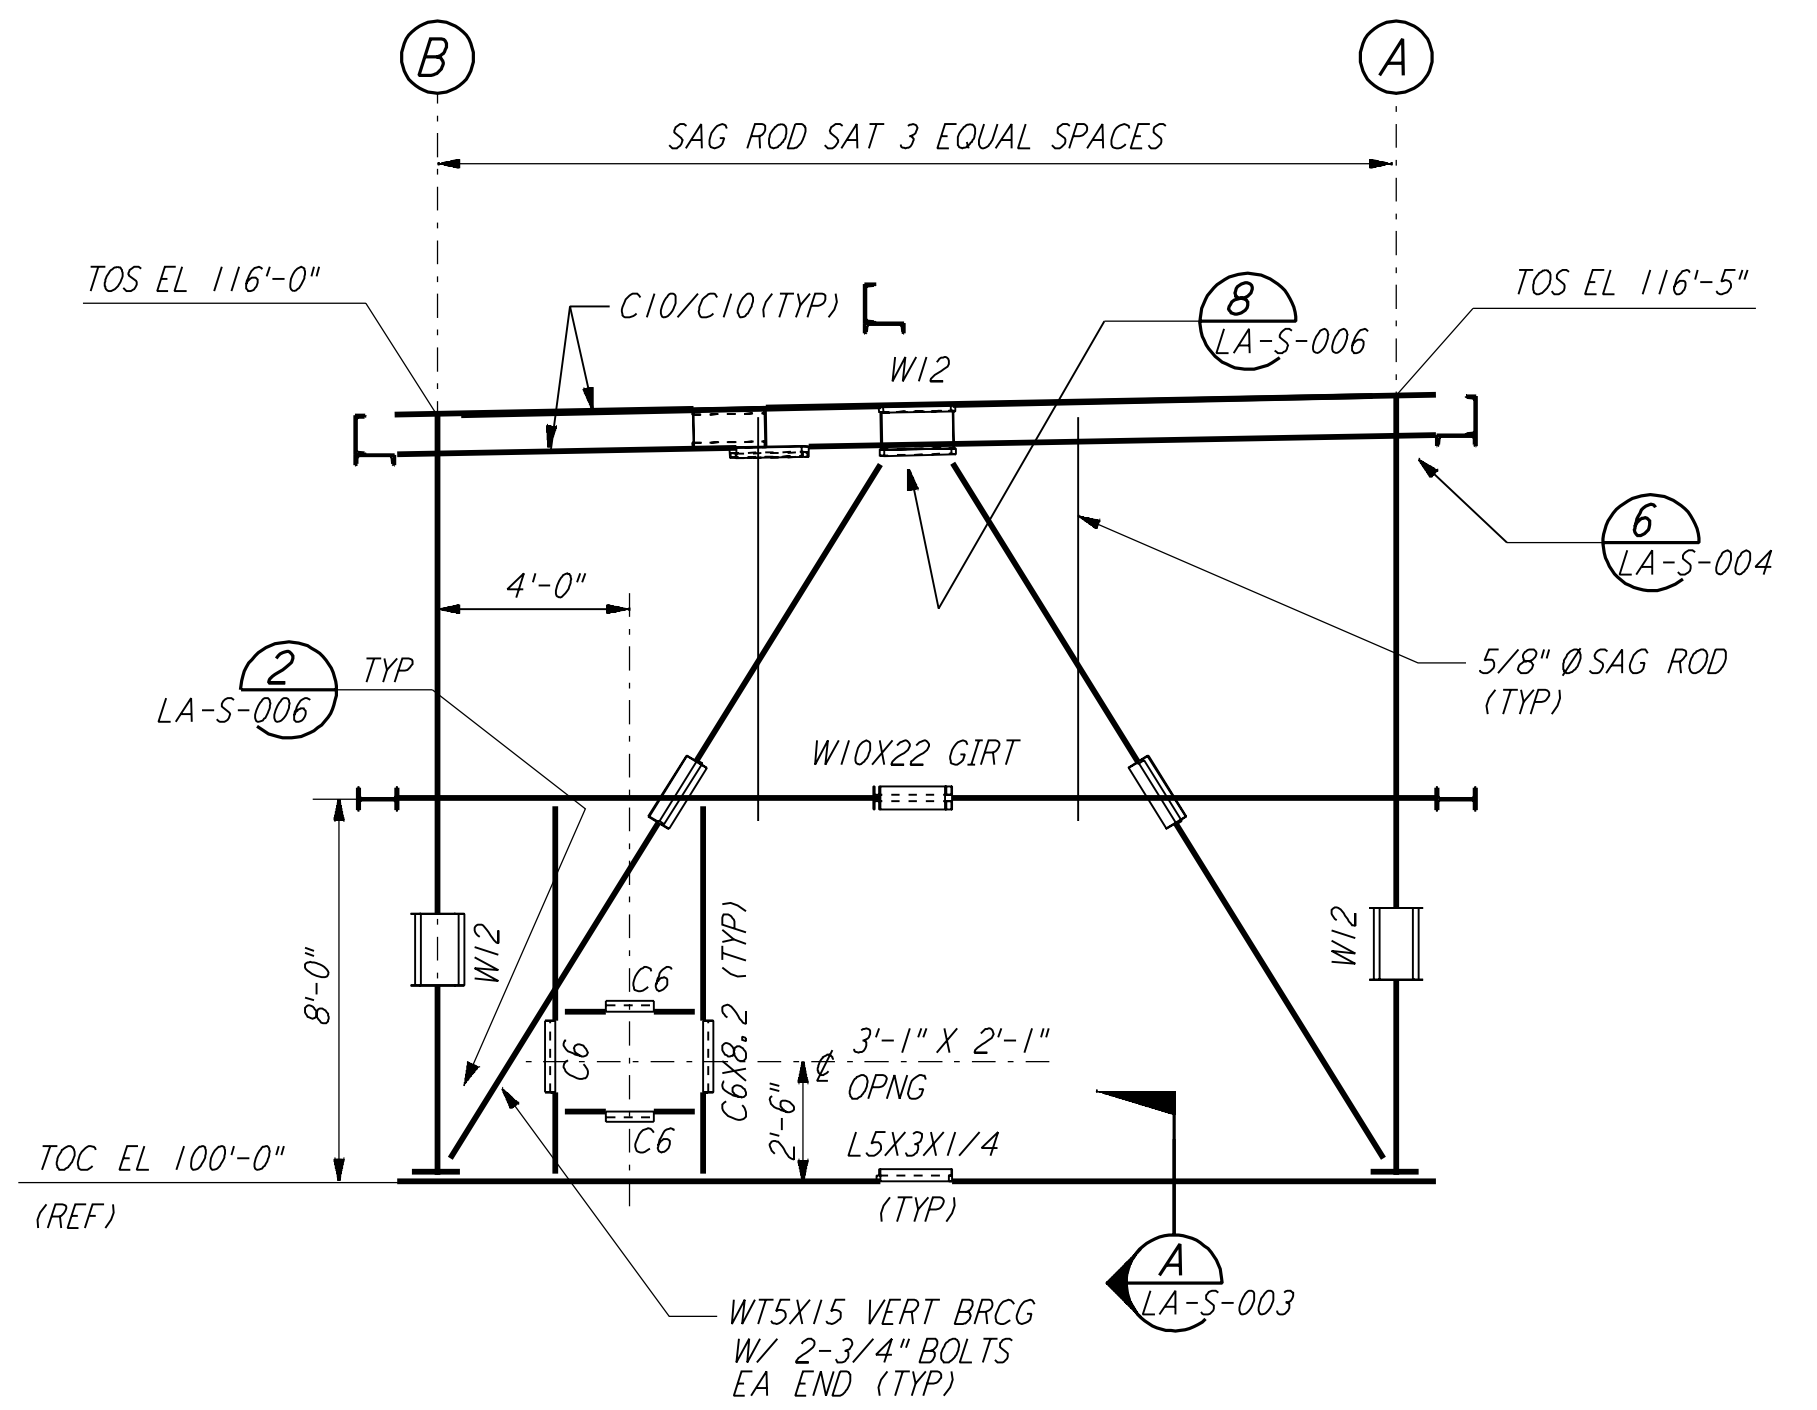


FRAMING ELEVATION AT COL LINE 1
 $\frac{1}{4}'' = 1'-0''$

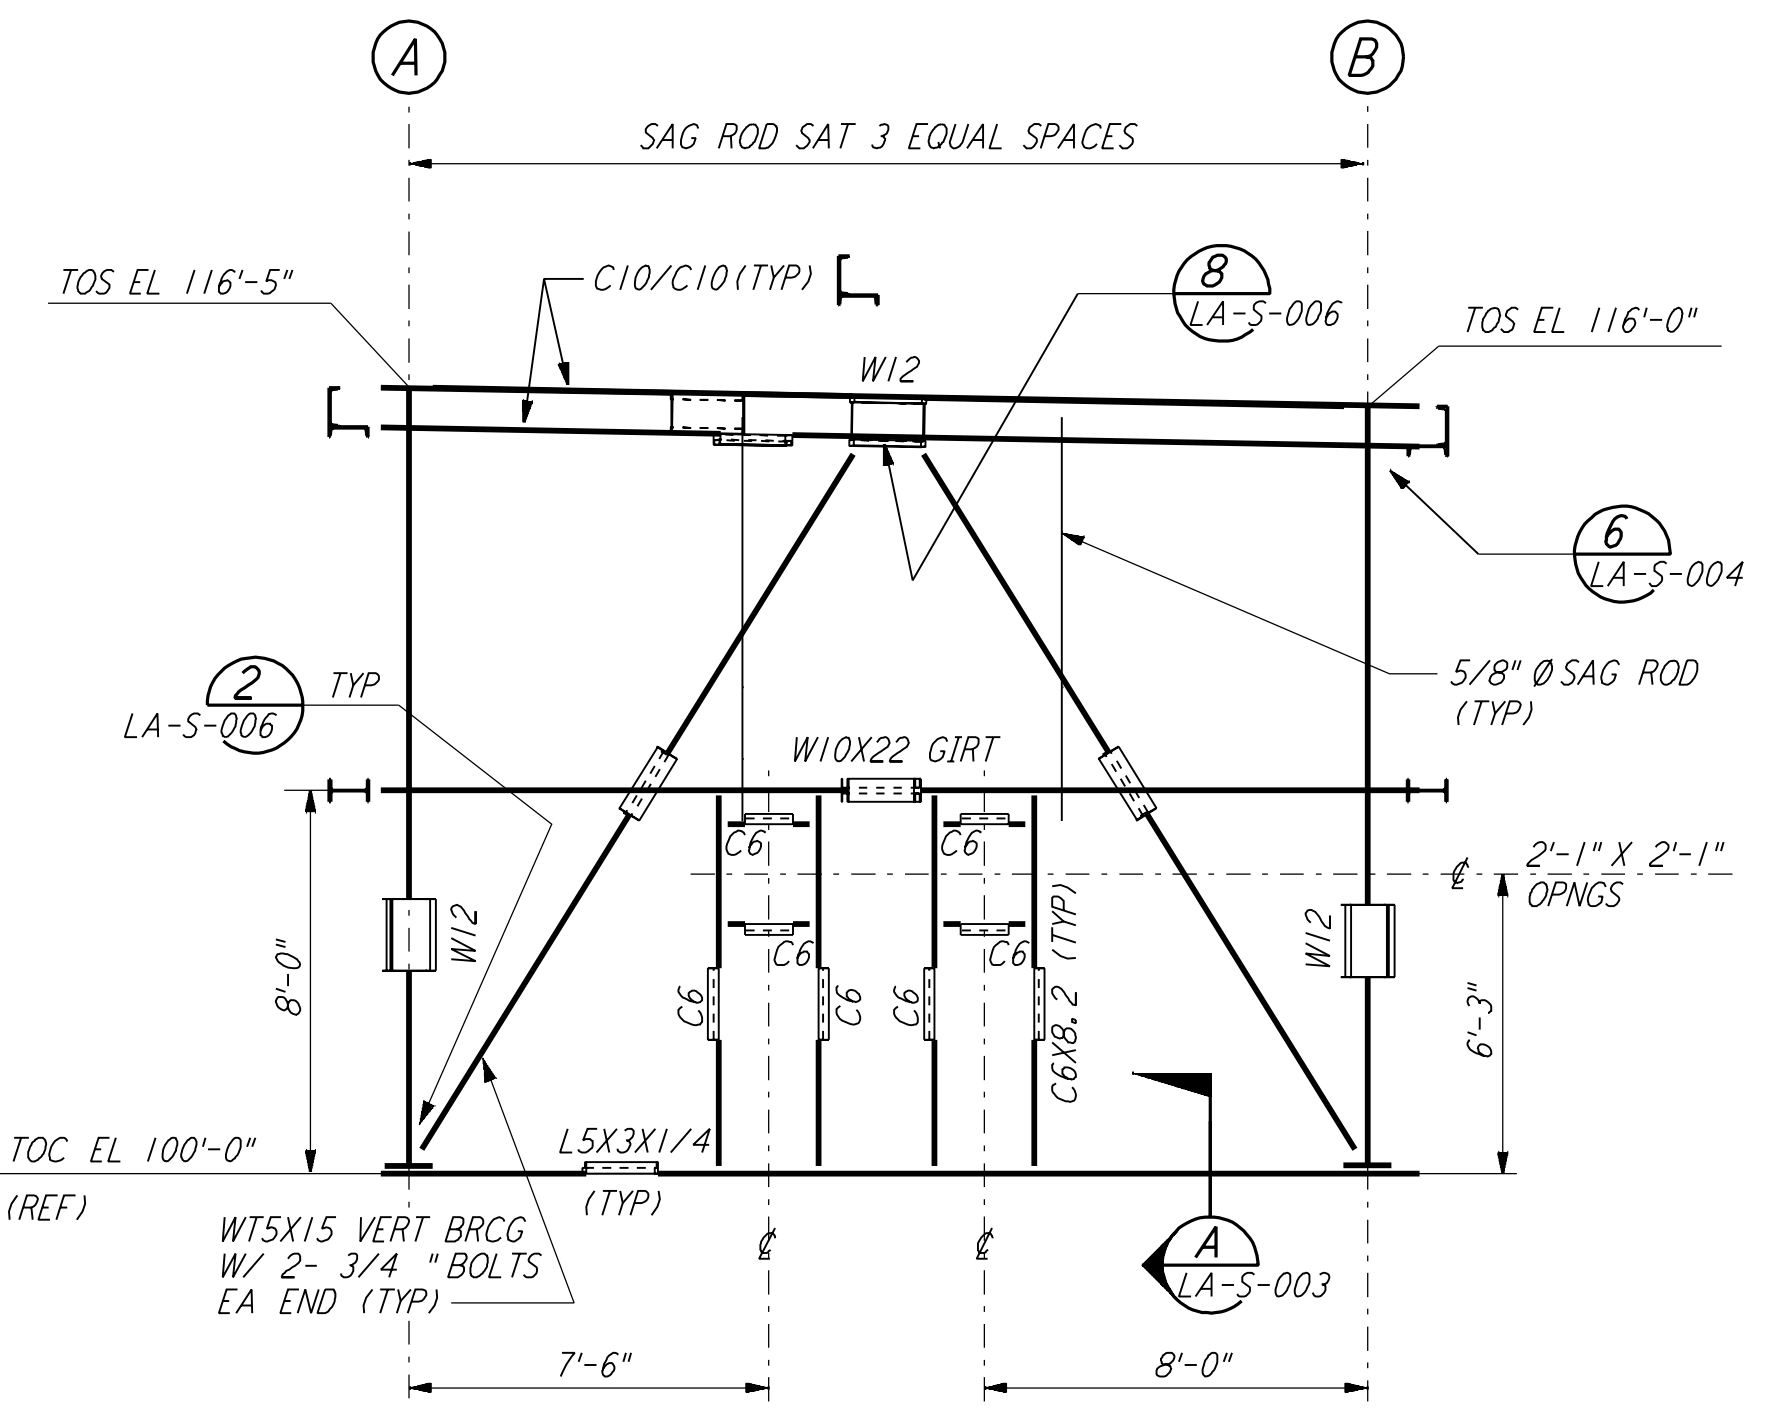

FRAMING ELEVATION AT COL LINE 4
 $\frac{1}{4}'' = 1'-0''$

- NOTES:**
- FOR GENERAL NOTES, ABBREVIATIONS AND SYMBOLS, SEE DRAWING LA-S-001.
 - FOR CHANNEL, GIRT AND EAVE STRUT CONNECTION DETAILS, SEE DRAWING LA-S-005.

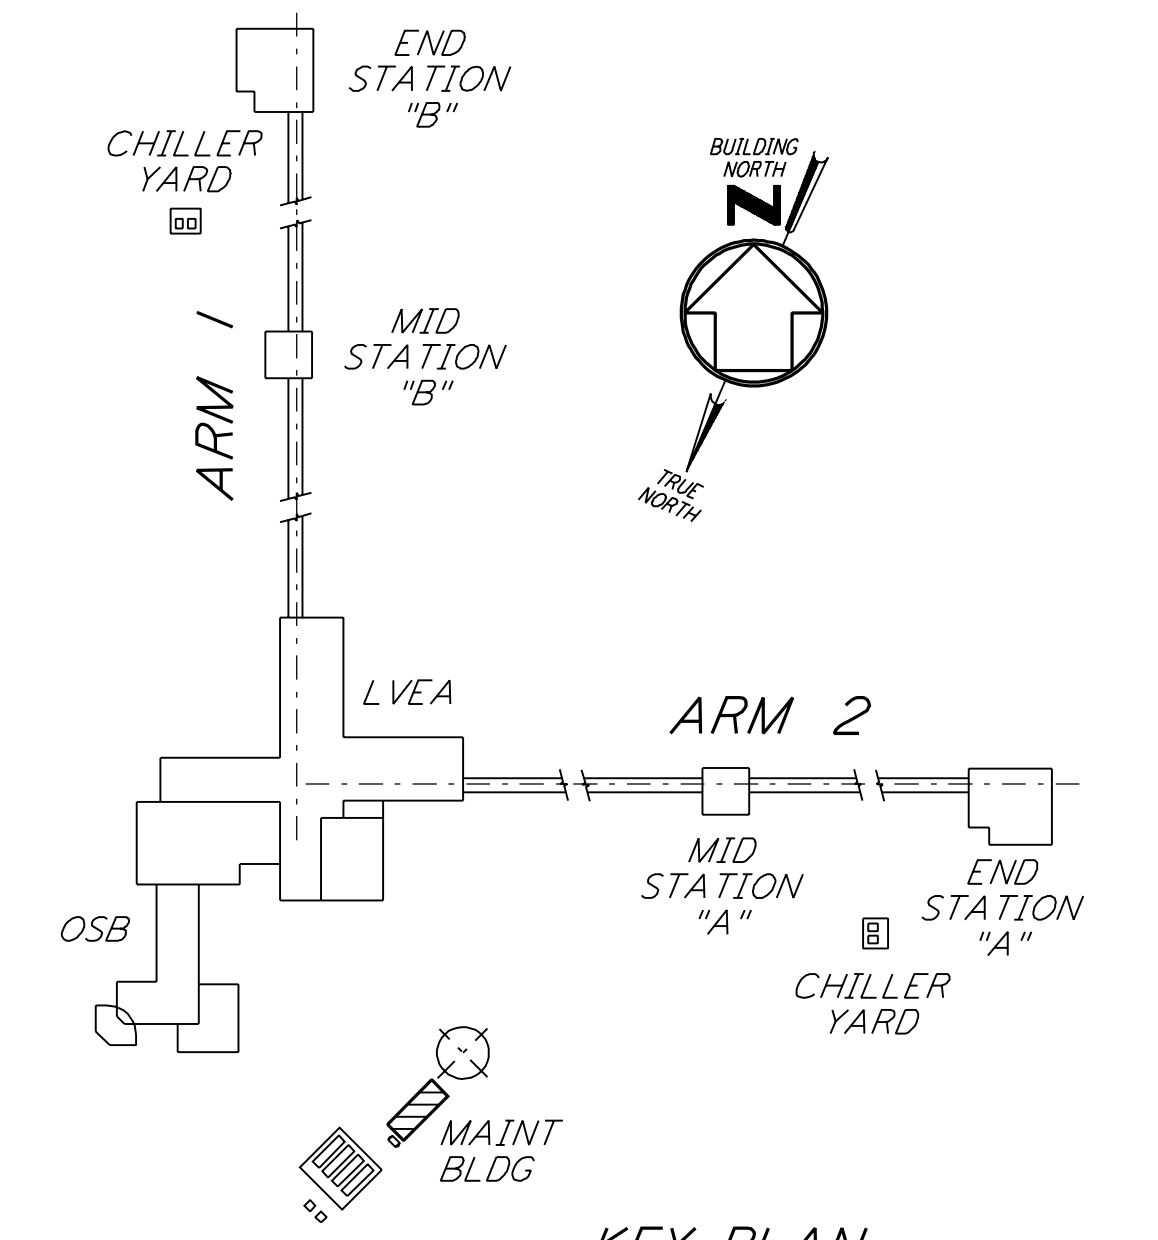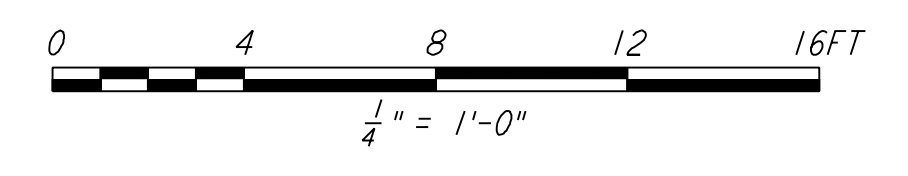

KEY PLAN
LIGO-D960941-02-0

This document and the design it covers are the property of PARSONS. They are loaned only with the borrower's expressed written agreement that they will not be reproduced, copied, loaned, exhibited, or used in any other way, except by written consent from PARSONS.

NO.	DATE	BY	CHKD	ENGR	PROJ	DESCRIPTION
2	08-07-98	IWA				ISSUED FOR AS-BUILT
1	2-28-97	RM	AB	BP		REV OPNG HEAD DIM AT ELEV LN A

ISSUED FOR CONSTRUCTION			
DRAWN	PK	11-15-96	
CHECKED	DDM	11-15-96	
ENGINEER	BP	11-15-96	
PROJ	TDM	11-15-96	

AS-BUILT DRAWINGS

PARSONS
 100 WEST WALNUT STREET
 PASADENA, CALIFORNIA

LIGO
 CALIFORNIA INSTITUTE OF TECHNOLOGY
 MASSACHUSETTS INSTITUTE OF TECHNOLOGY

LASER INTERFEROMETER GRAVITATIONAL-WAVE OBSERVATORY SITE NO. 2 - LIVINGSTON, LOUISIANA

TITLE	STRUCTURAL MAINTENANCE BUILDING ROOF FRAMING PLAN & FRAMING ELEVATIONS	SCALE	AS NOTED	CONTRACT NUMBER	PP150969	PROJECT NUMBER	8094
SHEET NUMBER	LA-S-125	REVISIONS					