
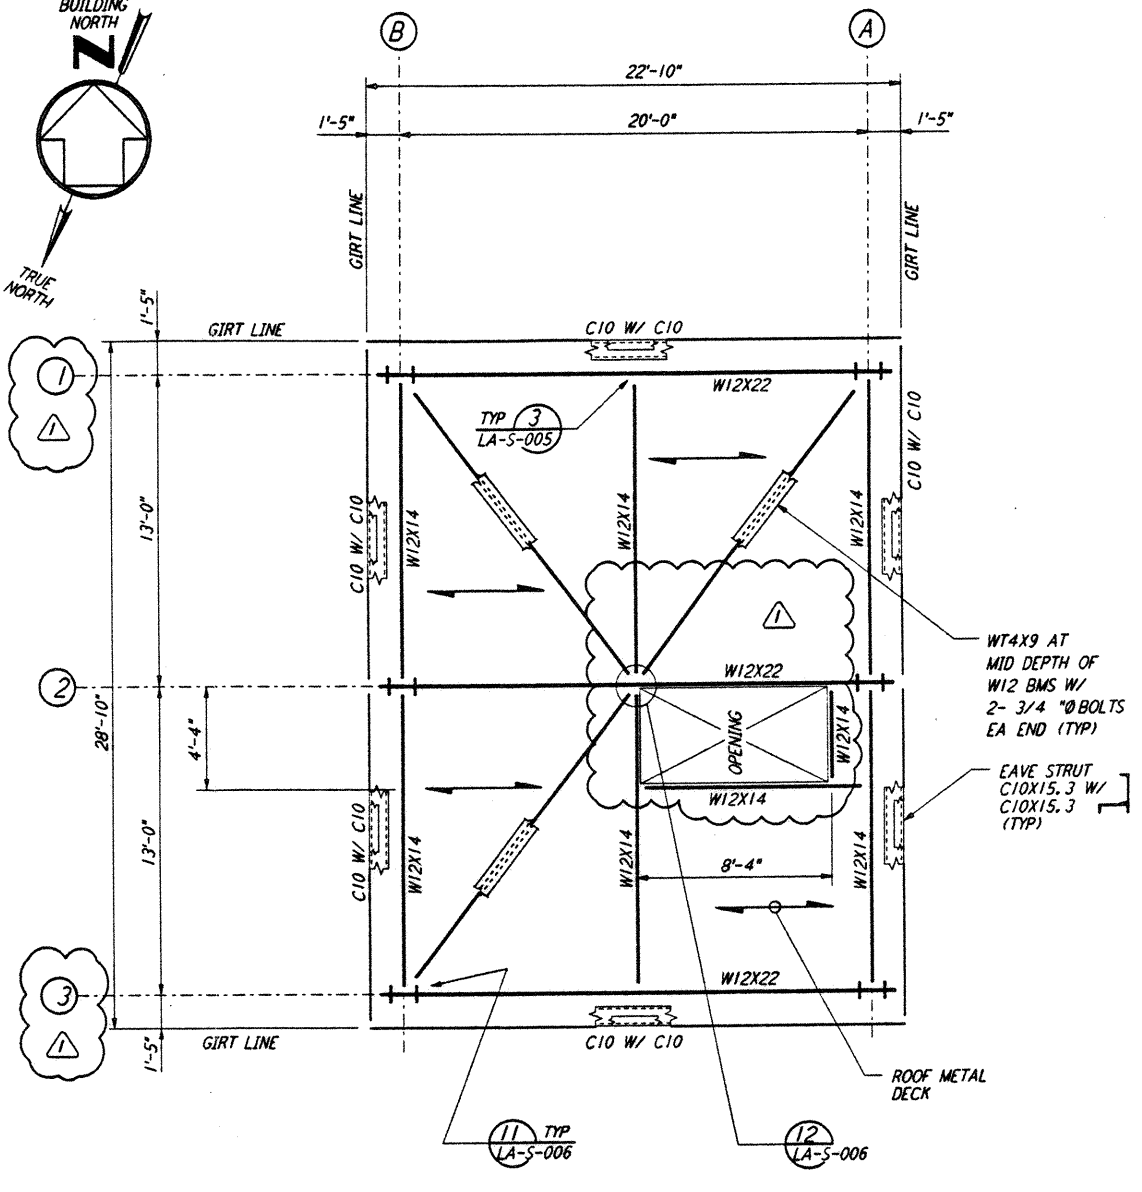


ARM 2
MID STATION "A" - ROOF FRAMING PLAN
 1/4" = 1'-0"

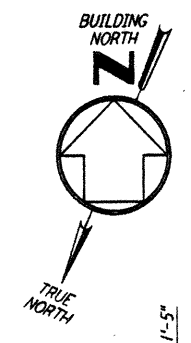


ARM 1
MID STATION "B" - ROOF FRAMING PLAN
 1/4" = 1'-0"

- NOTES:**
- FOR GENERAL NOTES, ABBREVIATIONS AND SYMBOLS, SEE DRAWING LA-5-001.
 - FOR EAVE STRUT CONNECTION DETAILS, SEE DRAWING LA-5-005.

not be reproduced, copied, loaned, exhibited, or used in any other way, except by written consent from **PARSONS** to the borrower.


This document and the design it covers are the property of **PARSONS**. They are loaned only with the borrower's expressed written agreement that they will

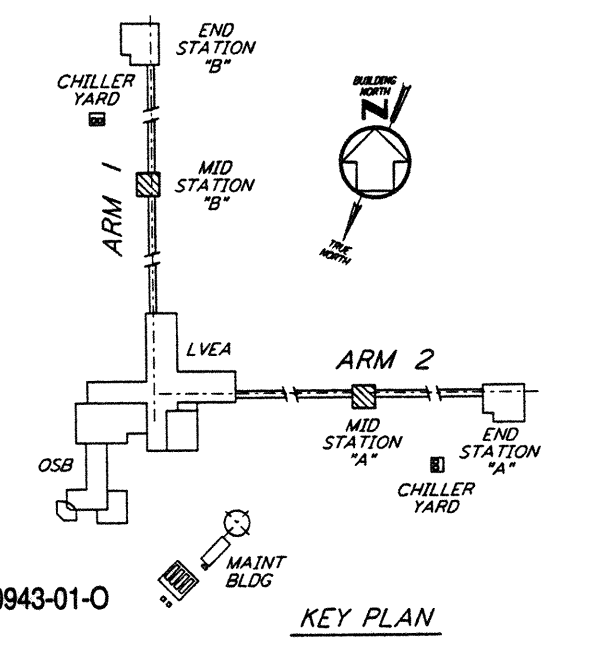

LIGO-D960943-01-0
 1/4" = 1'-0"

NO.	DATE	BY	CHKD	ENGR	PROJ	DESCRIPTION
1	2-28-97	AM	GP			REV RF FRMG PLAN FOR MID STA "A" & "B"

ISSUED FOR CONSTRUCTION	
DRAWN	MCS 11-15-96
CHECKED	DDM 11-15-96
ENGINEER	BP 11-15-96
PROJ	TDM 11-15-96

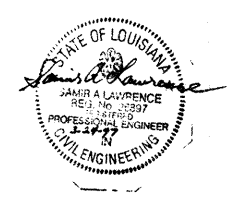

PARSONS
 100 WEST WALNUT STREET
 PASADENA, CALIFORNIA

LIGO
 CALIFORNIA INSTITUTE OF TECHNOLOGY
 MASSACHUSETTS INSTITUTE OF TECHNOLOGY

LASER INTERFEROMETER
 GRAVITATIONAL-WAVE OBSERVATORY
 SITE NO. 2 - LIVINGSTON, LOUISIANA

TITLE: STRUCTURAL MID STATIONS "A" & "B" ROOF FRAMING PLANS

SCALE: AS NOTED

CONTRACT NUMBER: PP150969

PROJECT NUMBER: 8094

SHEET NUMBER: **LA-S-202**