



**ARM 2**  
**MID STATION "A" - ROOF FRAMING PLAN**  
 1/4" = 1'-0"

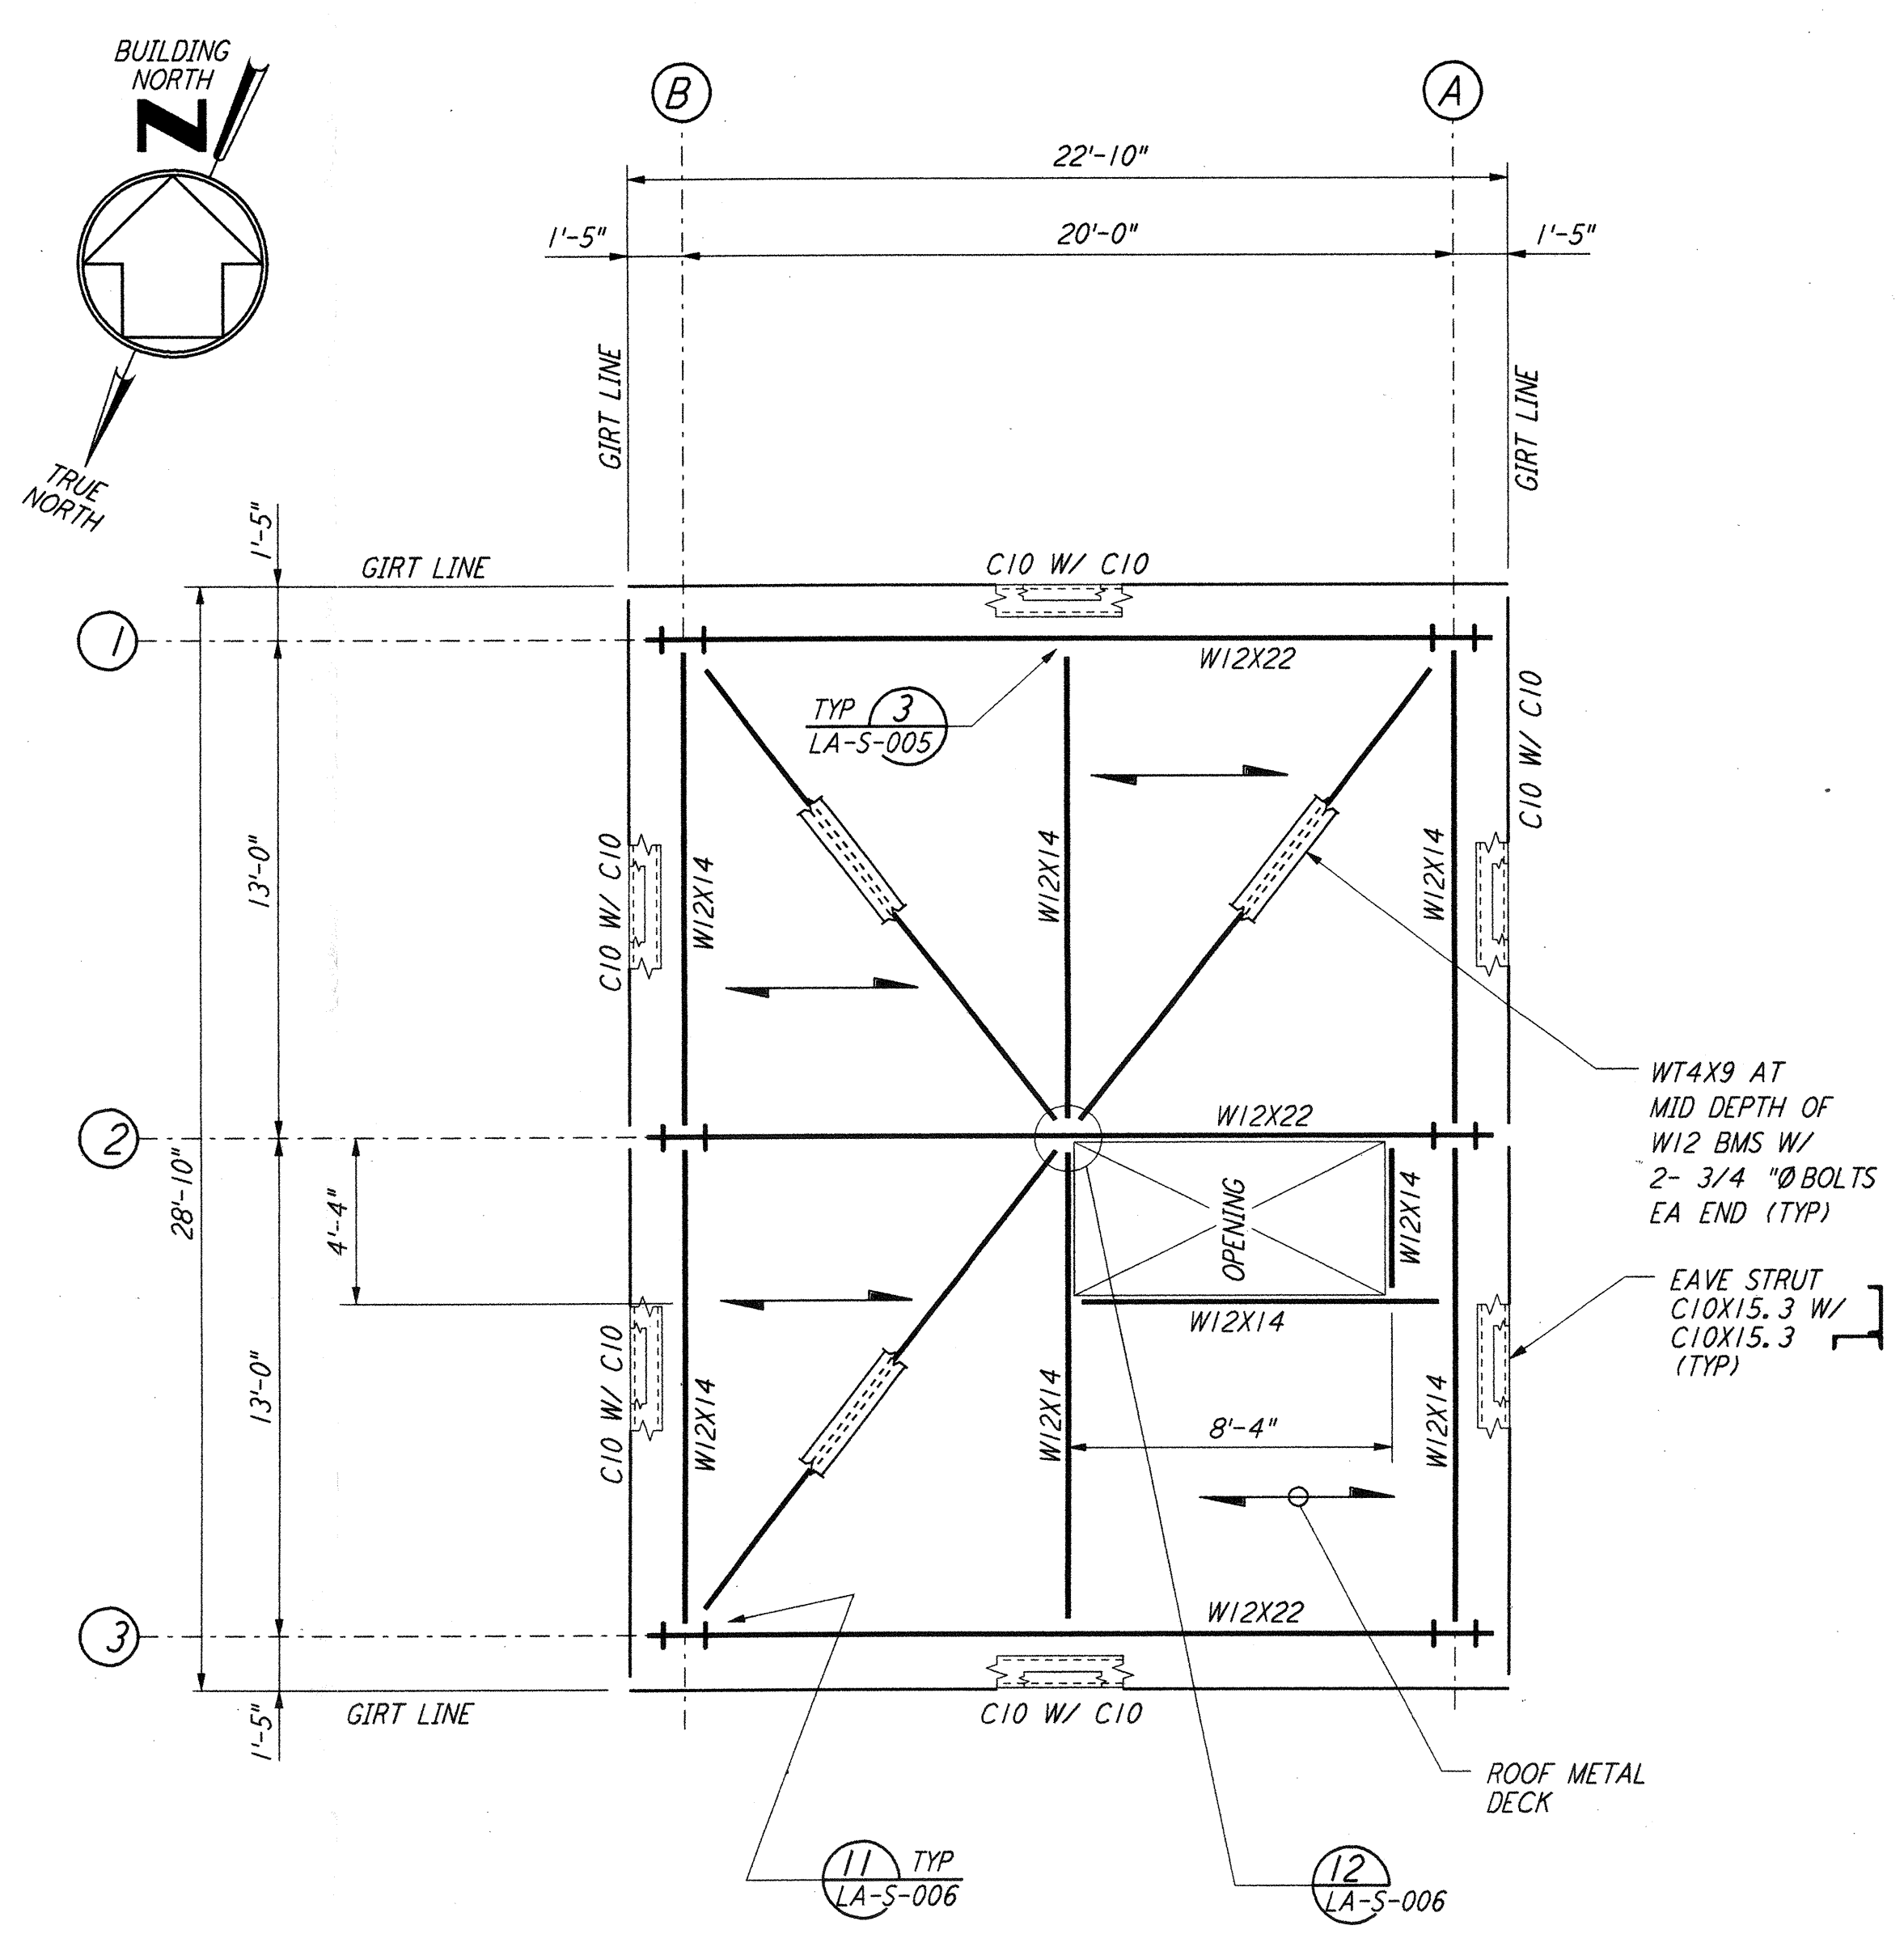

**ARM 1**  
**MID STATION "B" - ROOF FRAMING PLAN**  
 1/4" = 1'-0"

- NOTES:**
- FOR GENERAL NOTES, ABBREVIATIONS AND SYMBOLS, SEE DRAWING LA-5-001.
  - FOR EAVE STRUT CONNECTION DETAILS, SEE DRAWING LA-5-005.

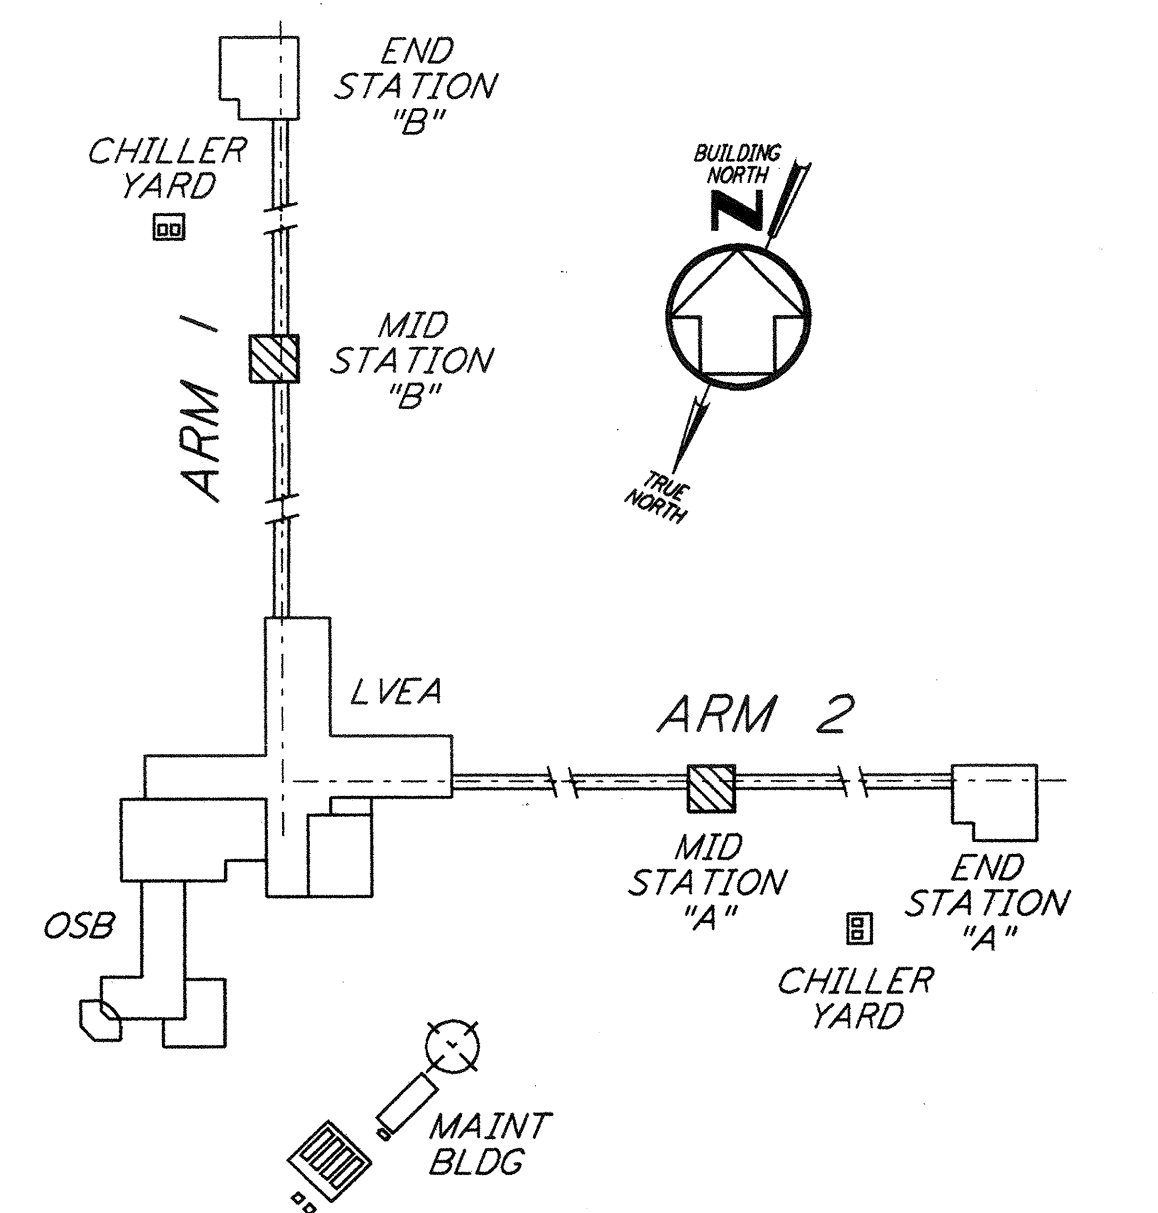

0 4 8 12 16 FT  
 1/4" = 1'-0"

**KEY PLAN**  
**LIGO-D960943-02-0**

NO.	DATE	BY	CHKD	ENGR	PROJ	DESCRIPTION
2	08-07-98	WA	GP	GP	WJ	ISSUED FOR AS-BUILT
1	2-28-97	RM	TDM	GP	TDM	REV RF FRMG PLAN FOR MID STA "A & B"

ISSUED FOR CONSTRUCTION			
DRAWN	MCS	11-15-96	
CHECKED	DDM	11-15-96	
ENGINEER	BP	11-15-96	
PROJ	TDM	11-15-96	

**AS-BUILT DRAWINGS**

**PARSONS**  
 100 WEST WALNUT STREET  
 PASADENA, CALIFORNIA

**LIGO**  
 CALIFORNIA INSTITUTE OF TECHNOLOGY  
 MASSACHUSETTS INSTITUTE OF TECHNOLOGY

**STRUCTURAL**  
**MID STATIONS "A" & "B"**  
**ROOF FRAMING PLANS**

SCALE: AS NOTED  
 CONTRACT NUMBER: PPI 50969  
 PROJECT NUMBER: 8094  
 SHEET NUMBER: **LA-S-202**

not be reproduced, copied, loaned, exhibited, or used in any other way, except by written consent from PARSONS to the borrower.

This document and the design it covers are the property of PARSONS. They are loaned only with the borrower's expressed written agreement that they will