

DUCT SILENCER SCHEDULE

Table with columns: UNIT NO, LOCATION, SERVICE (BUILDING, ROOM), CFM, DIMENSIONS W X D X L, PD IN. WC, MANUFACTURER/ MODEL NO, REMARKS. Lists various duct silencer units like L-CS-107-ST-01 through L-CS-107-ST-26 and L-EA-203-ST-01 through L-EA-203-ST-10.

AIR INLET & OUTLET SCHEDULE

Table with columns: UNIT NO, DESCRIPTION, FACE SIZE, NECK SIZE IN X IN, CONSTRUCTION, MANUFACTURER/ MODEL NO, REMARKS. Lists air inlet and outlet units like HF-1, HF-2, CD-1, etc.

- (1) PROVIDE WITH HANGING TAPS, STAINLESS STEEL TRIM, 1/2" INSULATION WITH ALUMINUM FOIL
(2) INITIAL PRESSURE DROP = 0.50" WC, REPLACEMENT PRESSURE DROP = 2.0" WC
(3) SEE PLANS

NOTES:

- 1. FOR LEGEND, ABBREVIATIONS AND GENERAL NOTES SEE SHEETS LA-H-001 AND LA-H-002.

VIBRATION ISOLATOR SCHEDULE

Table with columns: UNIT NO, NAME, LOCATION, (2) ISOLATOR TYPE, (3) SPRING DEFLECTION (INCH), (2) FRAME TYPE, (2) SEISMIC RESTRAINT, REMARKS. Lists various vibration isolator units like L-CS-107-SF-01, L-EA-203-SF-01, etc.

- (1) ISOLATOR HOUSING INCLUDES SEISMIC RESTRAINTS
(2) SEE SPECIFICATIONS FOR CODE LETTER
(3) STATIC DEFLECTION 3 HZ

not be reproduced, copied, loaned, exhibited, or used in any other way, except by written consent from PARSONS to the borrower.

This document and the design it covers are the property of PARSONS. They are loaned only with the borrower's expressed written agreement that they will

LIGO-D960965-02-0

LASER INTERFEROMETER GRAVITATIONAL-WAVE OBSERVATORY SITE NO. 2 - LIVINGSTON, LOUISIANA

TITLE: HVAC EQUIPMENT SCHEDULES SHEET 4

SCALE: NONE CONTRACT NUMBER: PP150969 PROJECT NUMBER: 8094

LA-H-006

Table with columns: DRAWN, CHECKED, ENGINEER, PROJ, CLP, MN, AA, TDM, 11-15-96, 10-25-96, 10-23-96, 11-15-96.

AS-BUILT DRAWINGS

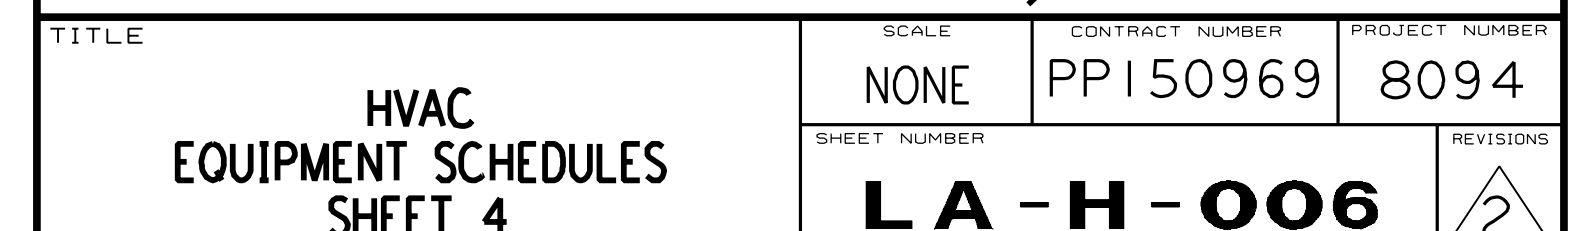


Table with columns: NO., DATE, BY, CHKD, ENGR, PROJ, DESCRIPTION. Includes revision 2 dated 8-7-98 by DJB and revision 1 dated 3-20-97 by WNK.

Note 1, LIGO, 04/07/99 07:40:59 PM
LIGO-D960965-02-O