


- NOTES:**
- FOR ABBREVIATIONS AND ACRONYMS SEE DWG LA-E-001.
 - FOR SYMBOLS SEE DWG LA-E-002.
 - FOR GENERAL NOTES, SEE DWG. LA-E-101.
 - ALL CIRCUITS SHOWN ON THIS DRAWING ARE FROM PANEL L-CS-144-RP-01 UNLESS OTHERWISE NOTED.
 - CIRCUITS SHOWN FEEDING THESE ITEMS ARE FROM PANEL L-CS-144-LP-01.
 - CIRCUITS SHOWN FEEDING THIS ITEM IS FROM PANEL L-CS-163-RP-01.
 - CIRCUITS SHOWN FEEDING THESE ITEMS ARE FROM PANEL L-CS-163-LP-01.
 - CONDUIT AND WIRE FEEDING RECEPTACLES LOCATED ON PATIO WALLS SHALL ROUTE WITHIN PATIO BLOCK WALLS TO EXTERIOR WALLS OF THE OSB AS REQUIRED.
 - CONDUIT AND WIRE SHALL ROUTE WITHIN FLOOR SLAB TO WALL AS INDICATED.
 - FOR ALL PANEL FEEDER CONDUIT AND CABLE SIZES SEE SINGLE LINE DIAGRAM DWG LA-E-006. ROUTE CABLES IN CONCEALED CONDUIT TO L-CS-107-SB-01. FOR LOCATION SEE DWG LA-E-100.
 - SEE PANEL SCHEDULES ON DWG LA-E-115 & LA-E-116 FOR GFCI CIRCUITS.

- REFERENCE DRAWINGS:**
- LA-E-115 LIGHTING AND POWER PANEL SCHEDULES
 - LA-E-116 LIGHTING AND POWER PANEL SCHEDULES

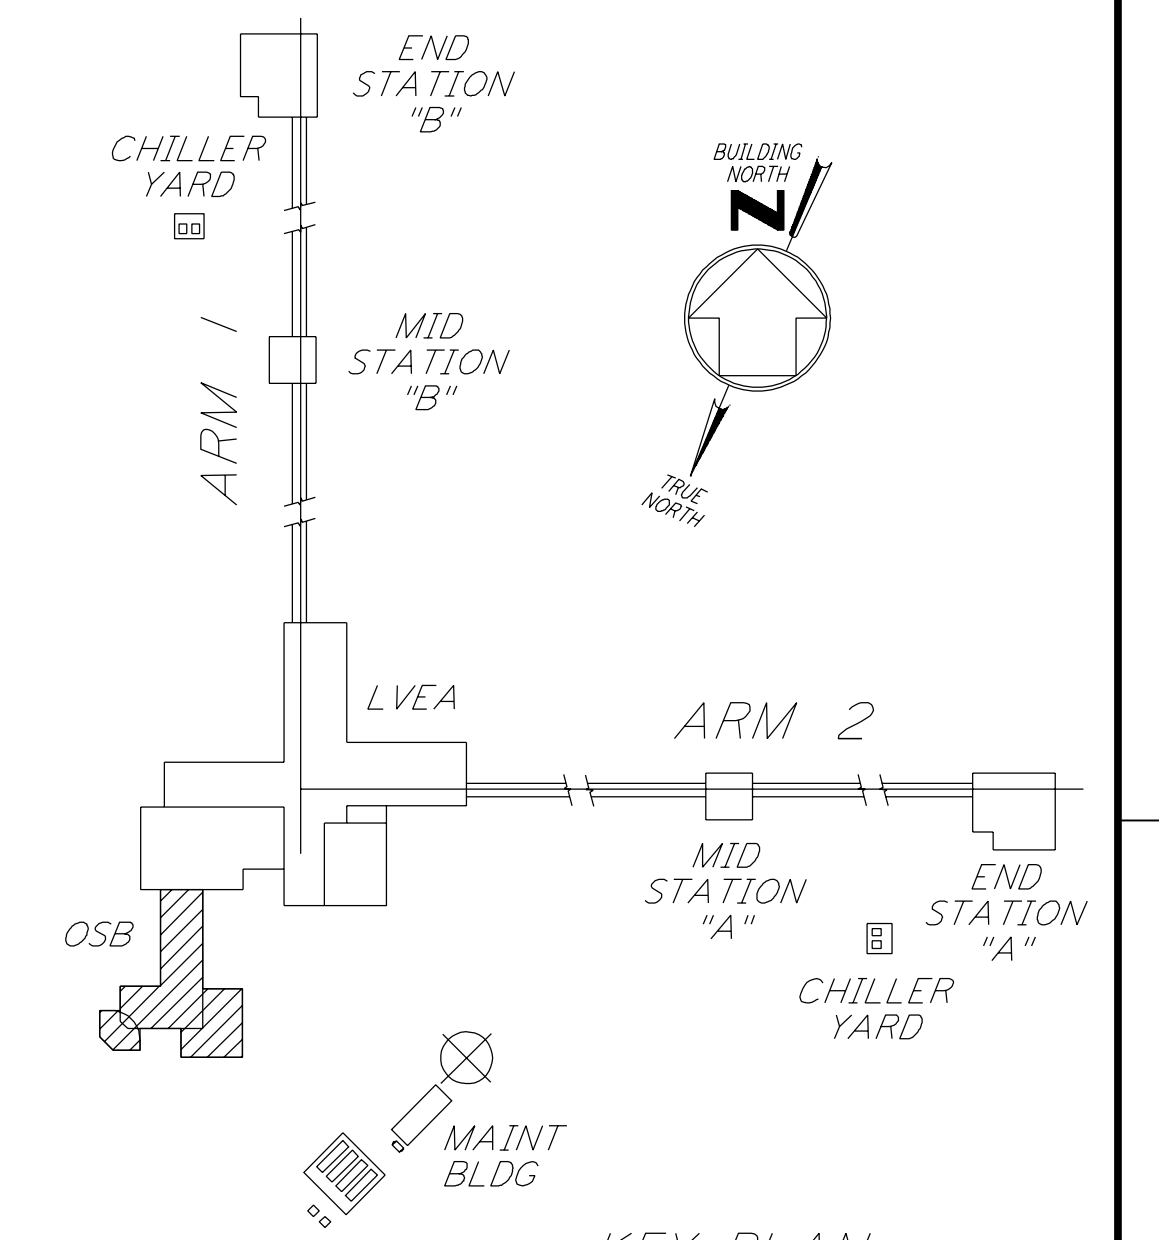

0 8 16 24 32 FT
 1/8" = 1'-0"

This document and the design it covers are the property of PARSONS. They are loaned only with the borrower's expressed written agreement that they will not be reproduced, copied, loaned, exhibited, or used in any other way, except by written consent from PARSONS to the borrower.

NO.	DATE	BY	CHKD	ENGR	PROJ	DESCRIPTION
2	8-7-98	JE				ISSUED FOR AS-BUILT
1	2-28-97	J.G.	RDC	KCR	T.D.M	GENERAL REVISIONS

ISSUED FOR CONSTRUCTION
 DRAWN M.M. 11-15-96
 CHECKED J.C.L. 7-24-96
 ENGINEER K.C.R. 10-25-96
 PROJ T.D.M. 11-15-96

AS-BUILT DRAWINGS

100 WEST WALNUT STREET
 PASADENA, CALIFORNIA

CALIFORNIA INSTITUTE OF TECHNOLOGY
 MASSACHUSETTS INSTITUTE OF TECHNOLOGY

LASER INTERFEROMETER
 GRAVITATIONAL-WAVE OBSERVATORY
 SITE NO. 2 - LIVINGSTON, LOUISIANA

ELECTRICAL CORNER STATION OSB OFFICE AREA RECEPTACLE & POWER PLAN

SCALE: NONE
 CONTRACT NUMBER: PP150969
 PROJECT NUMBER: 8094

LA-E-105