



This document and the design it covers are the property of **PARSONS**. They are loaned only with the borrower's expressed written agreement that they will not be reproduced, copied, loaned, exhibited, or used in any other way, except by written consent from **PARSONS** to the borrower.

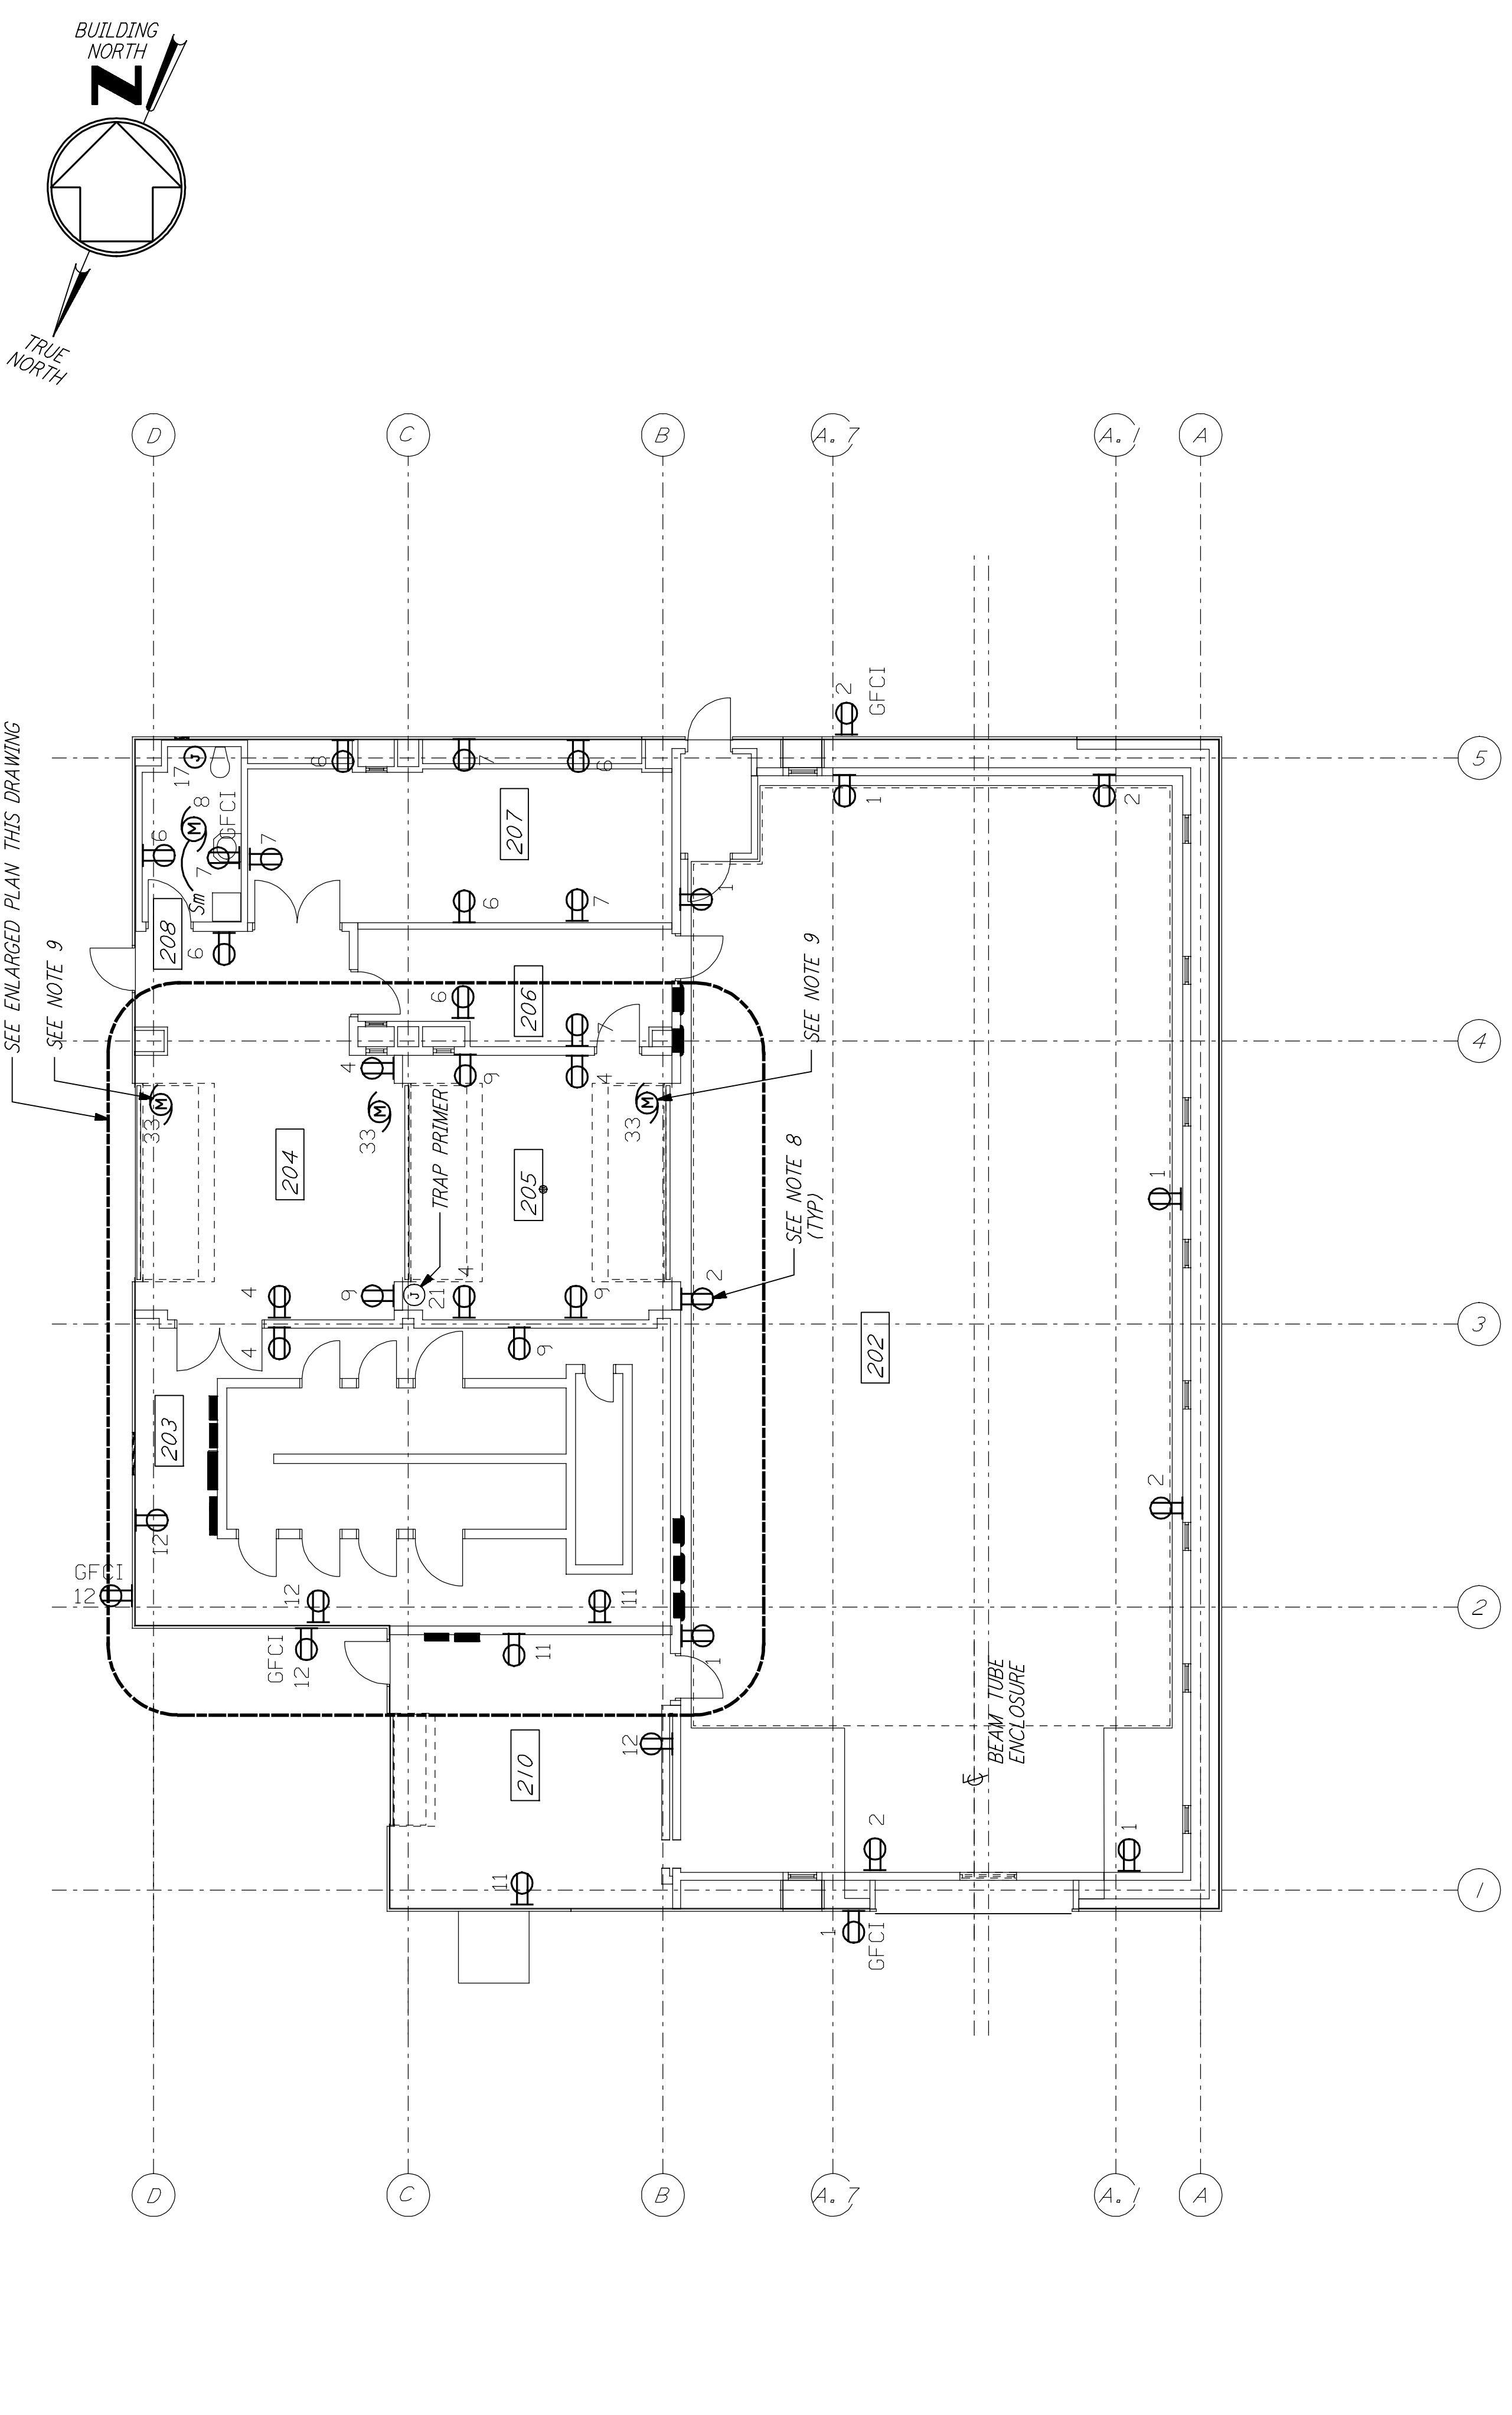


POWER PLAN
1/8" = 1'-0"

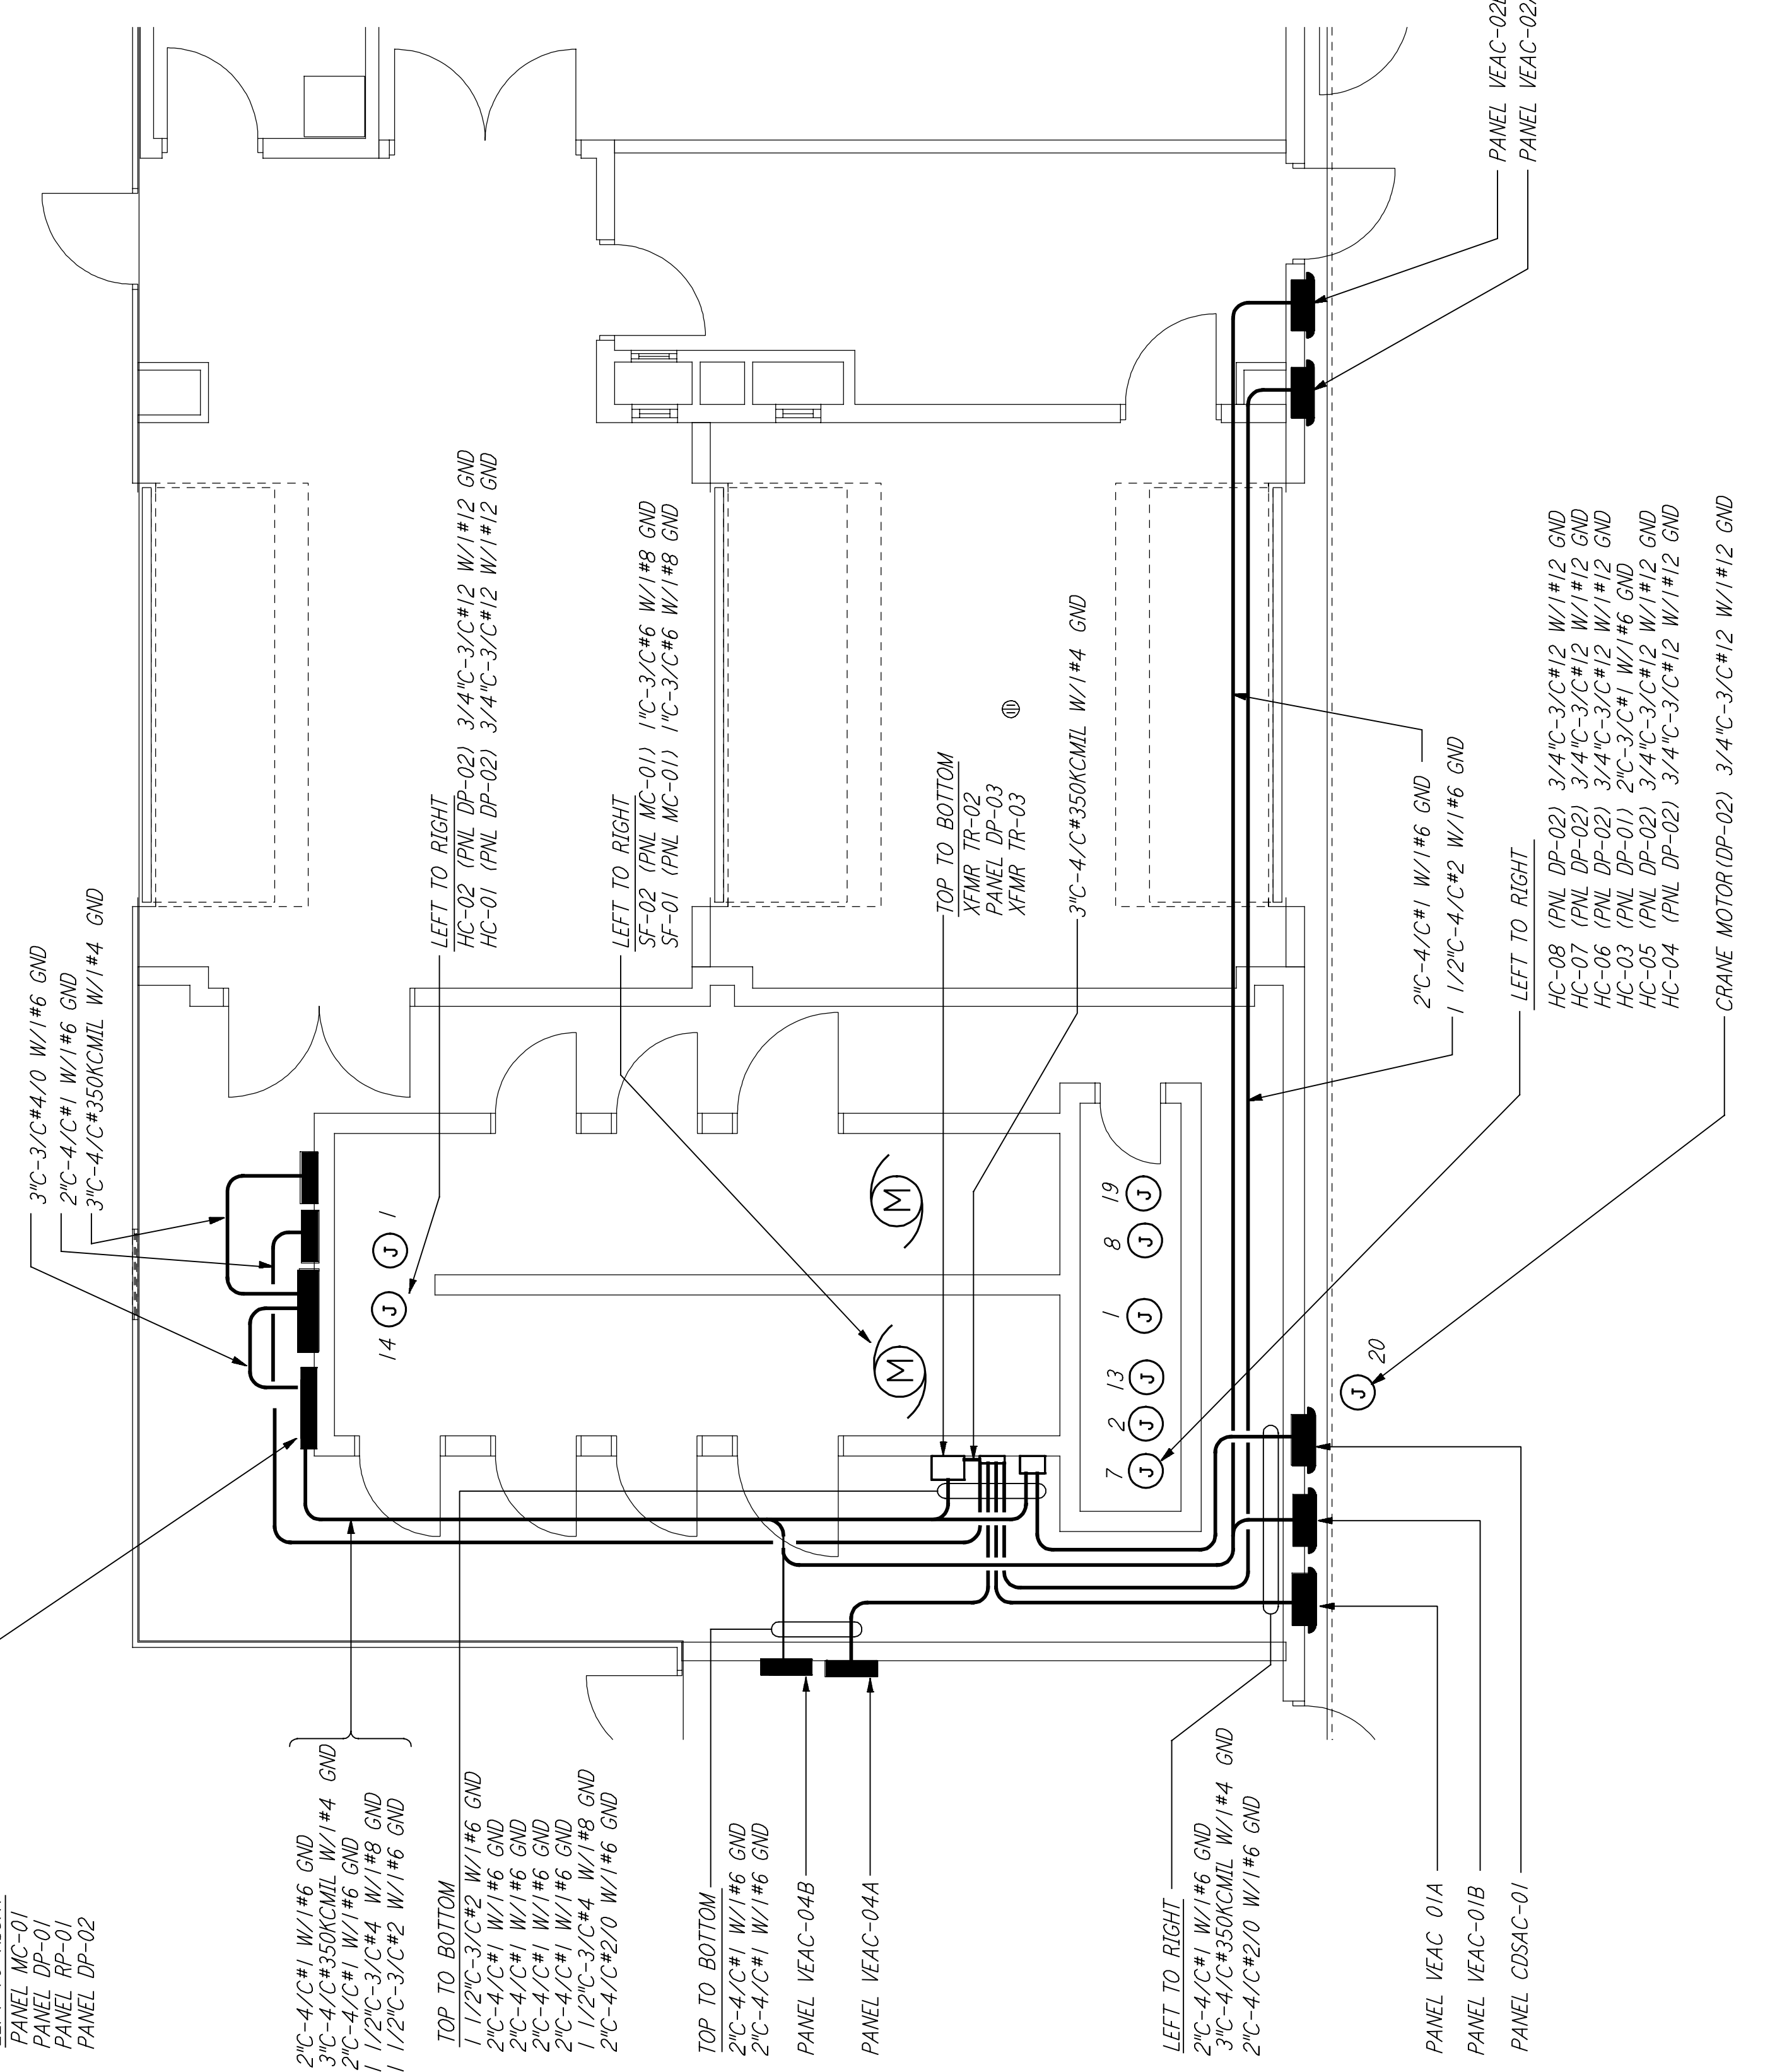

ENLARGED PLAN
1/4" = 1'-0"

- NOTES:**
- FOR STANDARD SYMBOLS, ABBREVIATIONS AND ACRONYMS SEE DWG. LA-E-001.
 - FOR ELECTRICAL SYMBOLS SEE DWG. LA-E-002.
 - FOR STANDARD INSTALLATION DETAILS SEE DWG. LA-E-404 AND LA-E-409.
 - FOR CABLE TYPE DESCRIPTION SEE DWG. LA-E-007.
 - ALL CONDUIT RUNS ARE SHOWN DIAGRAMMATICALLY ONLY. CONTRACTOR SHALL COORDINATE INSTALLATION WITH OTHER DISCIPLINES.
 - FOR SINGLE LINE DIAGRAM, SEE DWG. LA-E-008.
 - FOR EQUIPMENT LOCATION, SEE HVAC DWG. LA-H-211.
 - ALL CIRCUITS SHOWN ON THIS DRAWING ARE FROM PANEL RPO1 UNLESS OTHERWISE NOTED.
 - CIRCUIT SHOWN FEEDING THESE ITEMS ARE FROM DP-02.
 - PANEL SCHEDULES ARE SHOWN ON DRAWINGS LA-E-205 AND LA-E-206.

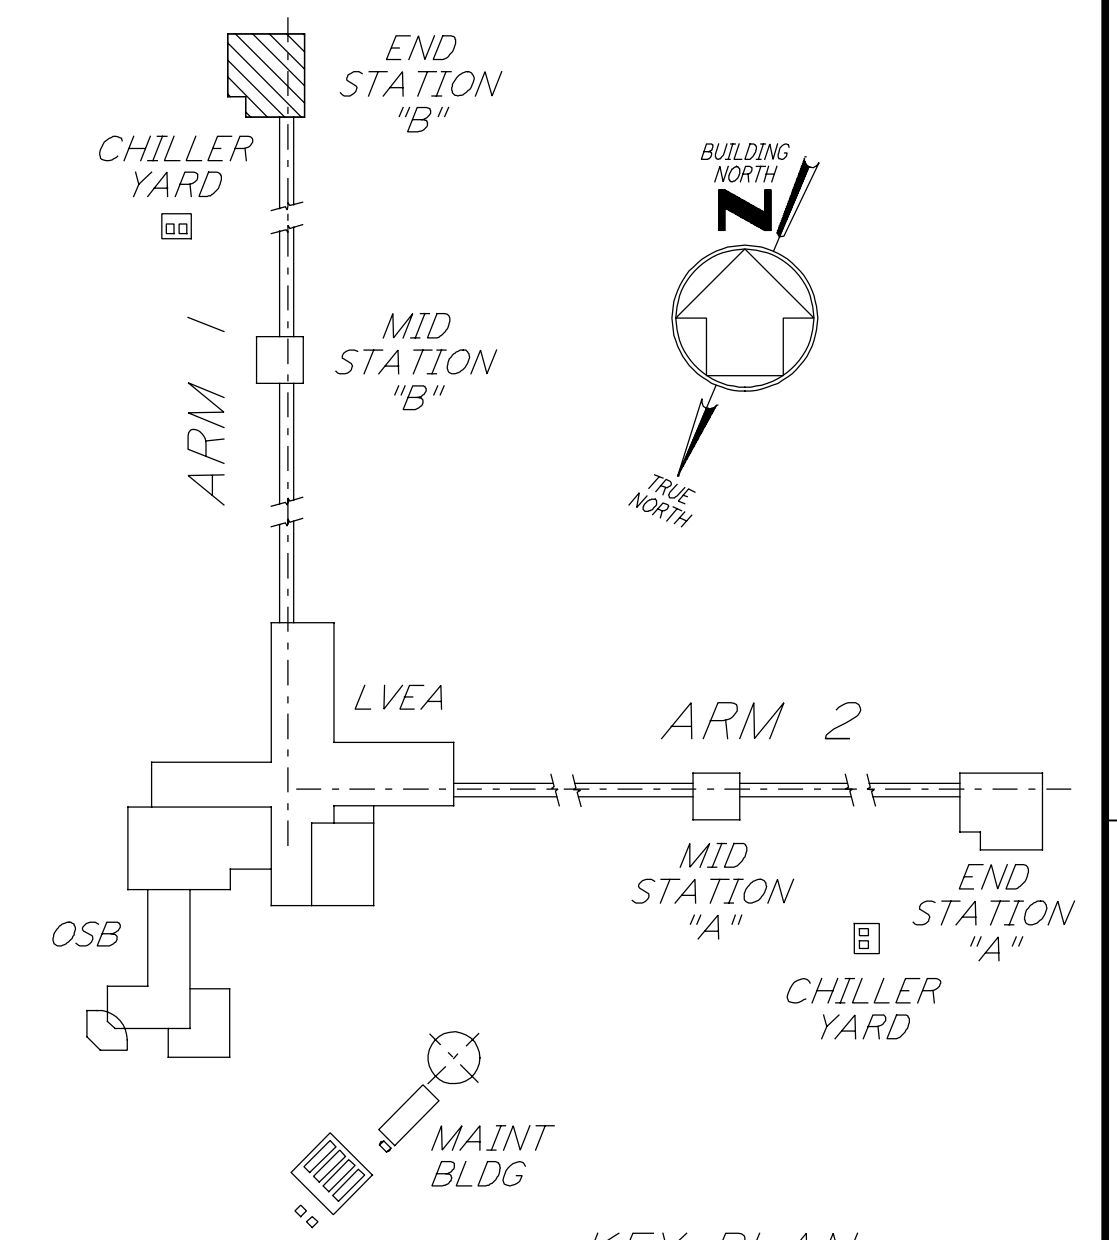

KEY PLAN

LIGO-D961035-03-0

NO.	DATE	BY	CHKD	ENGR	PROJ	DESCRIPTION
3	5-21-99	AO				ISSUED AS REVISED AS-BUILT
2	8-7-98	JE	AK	AG	MKW	ISSUED FOR AS-BUILT
1	2-28-97	J. G.	RDC	KCR	T. D. M	GENERAL REVISIONS

NO.	DATE	BY	CHKD	ENGR	PROJ	DESCRIPTION
ISSUED FOR CONSTRUCTION						
		DR				11-15-96
		CH				7-24-96
		EN				10-25-96
		PR				11-15-96

AS-BUILT DRAWINGS

PARSONS
 100 WEST WALNUT STREET
 PASADENA, CALIFORNIA

LIGO
 CALIFORNIA INSTITUTE OF TECHNOLOGY
 MASSACHUSETTS INSTITUTE OF TECHNOLOGY

LASER INTERFEROMETER GRAVITATIONAL-WAVE OBSERVATORY SITE NO. 2 - LIVINGSTON, LOUISIANA		CONTRACT NUMBER PPI50969		PROJECT NUMBER 8094	
ELECTRICAL END STATION B ABOVEGROUND POWER PLAN		SHEET NUMBER LA-E-214		REVISIONS 3	

