



ELEVATION N
V049-5-012, SHT.3

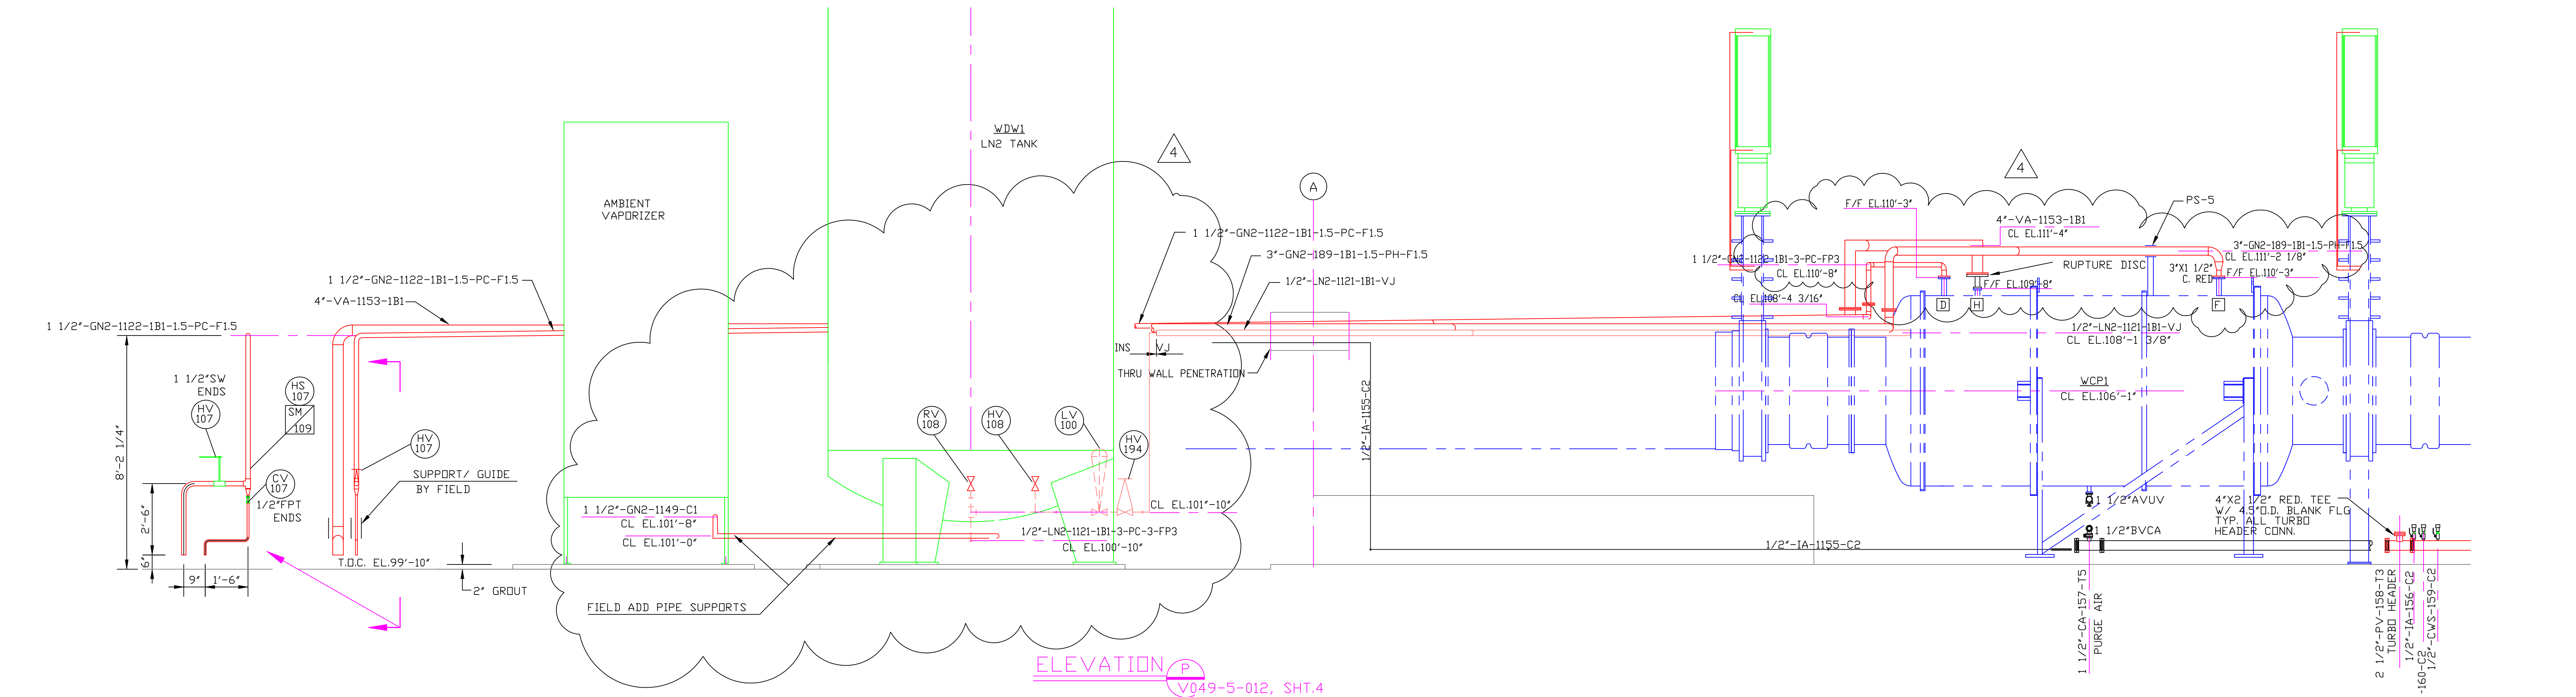

ELEVATION P
V049-5-012, SHT.4

 PROCESS SYSTEMS INTERNATIONAL INC. 20 WALKUP DR. WESTBOROUGH, MASSACHUSETTS 01581 USA			
PIPING ARRANGEMENT ELEVATIONS CORNER STATION WASHINGTON LIQD VACUUM EQUIPMENT			
CAD FILE	SIZE	DWG. NO.	REV.
V0495013/5013S2	D	V049-5-013	4
SCALE	SHEET		
3/8"=1'-0"	2 OF 2		

JUN 18, 1998 - 15:04:38