


ELEVATION J
V049-5-012, SHT.2

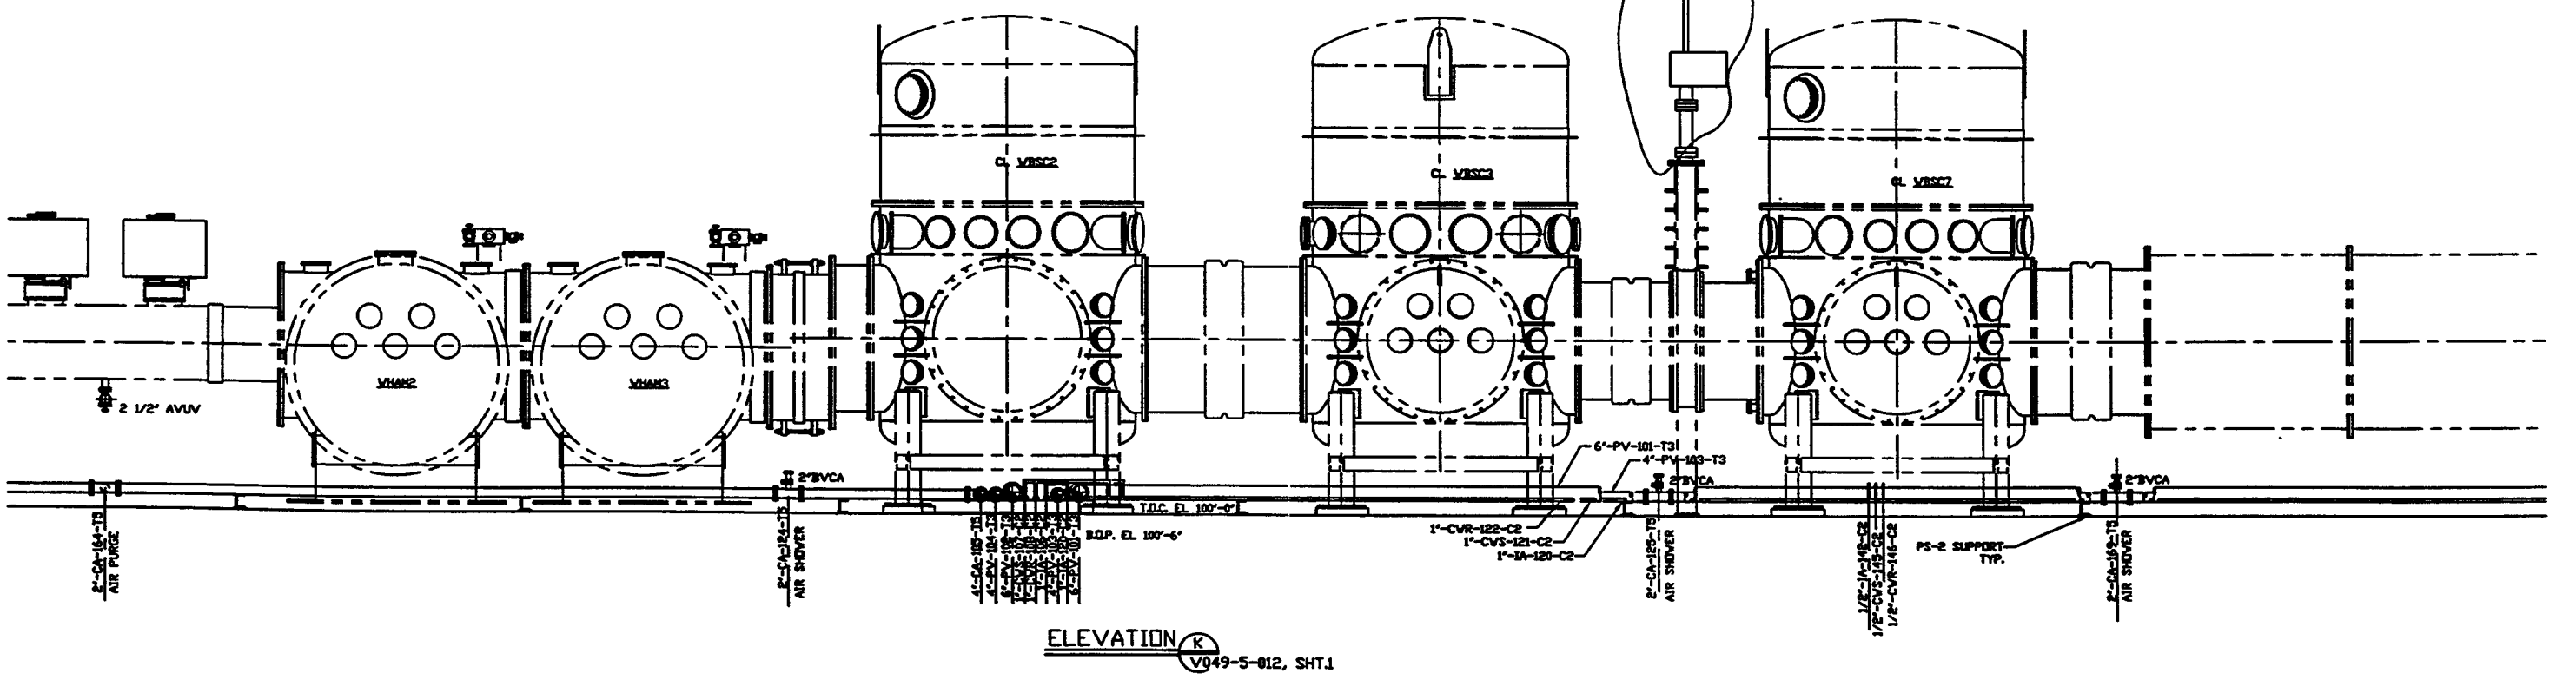

ELEVATION K
V049-5-012, SHT.1

<p>PROPRIETARY AND CONFIDENTIAL</p> <p>THIS DOCUMENT CONTAINS PROPRIETARY INFORMATION BELONGING TO PROCESS SYSTEMS INTERNATIONAL, INC. OR ITS AFFILIATED COMPANIES AND SHALL BE USED ONLY FOR THE PURPOSE FOR WHICH IT WAS SUPPLIED. IT SHALL NOT BE COPIED, REPRODUCED OR OTHERWISE USED, NOR SHALL SUCH INFORMATION BE FURNISHED BY WHOLE OR IN PART TO OTHERS EXCEPT IN ACCORDANCE WITH THE TERMS OF ANY AGREEMENT UNDER WHICH IT WAS SUPPLIED OR WITH THE PRIOR WRITTEN CONSENT OF PROCESS SYSTEMS INTERNATIONAL, INC. AND SHALL BE RETURNED UPON REQUEST.</p>		<p>UNLESS OTHERWISE SPECIFIED DIMENSIONS ARE IN INCHES</p> <p>FRAGMENTS & HOLES TO BE A TWO PLACE DECIMAL & THREE PLACE DECIMAL & FRESHED SURFACE OR BREAK CORNERS OR REMOVE ALL DRUGS</p> <p>DO NOT SCALE THIS DRAWING</p> <p>USED ON _____</p> <p>NEXT ASSY: _____</p>		<table border="1"> <tr> <th>REV</th> <th>DESCRIPTION</th> <th>ISSUE DESCRIPTION</th> <th>CHKD</th> <th>BRWN</th> <th>DATE</th> <th>BDOP</th> </tr> <tr> <td>3</td> <td>REISSUED FOR CONSTRUCTION AS NOTED</td> <td></td> <td></td> <td></td> <td>06.06.97</td> <td>0491</td> </tr> <tr> <td>2</td> <td>ISSUED FOR CONSTRUCTION</td> <td></td> <td></td> <td></td> <td>04.28.97</td> <td>0440</td> </tr> <tr> <td>1</td> <td>ISSUED FOR FBR UPDATE & BID</td> <td></td> <td></td> <td></td> <td>12.24.96</td> <td>0133</td> </tr> <tr> <td>0</td> <td>ISSUED FOR FINAL DESIGN REVIEW</td> <td></td> <td></td> <td></td> <td>5.2.96</td> <td>0033</td> </tr> </table>		REV	DESCRIPTION	ISSUE DESCRIPTION	CHKD	BRWN	DATE	BDOP	3	REISSUED FOR CONSTRUCTION AS NOTED				06.06.97	0491	2	ISSUED FOR CONSTRUCTION				04.28.97	0440	1	ISSUED FOR FBR UPDATE & BID				12.24.96	0133	0	ISSUED FOR FINAL DESIGN REVIEW				5.2.96	0033	<p>PROCESS SYSTEMS INTERNATIONAL, INC. 30 WALSH DR. WESTBOROUGH, MASSACHUSETTS 01581 USA</p> <p>PIPING ARRANGEMENT ELEVATIONS CORNER STATION WASHINGTON LIGO VACUUM EQUIPMENT</p> <p>DATE FILED: V0495013/301301 REV: 3 SHEET: 1 OF 2</p>	
REV	DESCRIPTION	ISSUE DESCRIPTION	CHKD	BRWN	DATE	BDOP																																				
3	REISSUED FOR CONSTRUCTION AS NOTED				06.06.97	0491																																				
2	ISSUED FOR CONSTRUCTION				04.28.97	0440																																				
1	ISSUED FOR FBR UPDATE & BID				12.24.96	0133																																				
0	ISSUED FOR FINAL DESIGN REVIEW				5.2.96	0033																																				
<p>PROPERTY AND CONFIDENTIAL</p> <p>THIS DOCUMENT CONTAINS PROPRIETARY INFORMATION BELONGING TO PROCESS SYSTEMS INTERNATIONAL, INC. OR ITS AFFILIATED COMPANIES AND SHALL BE USED ONLY FOR THE PURPOSE FOR WHICH IT WAS SUPPLIED. IT SHALL NOT BE COPIED, REPRODUCED OR OTHERWISE USED, NOR SHALL SUCH INFORMATION BE FURNISHED BY WHOLE OR IN PART TO OTHERS EXCEPT IN ACCORDANCE WITH THE TERMS OF ANY AGREEMENT UNDER WHICH IT WAS SUPPLIED OR WITH THE PRIOR WRITTEN CONSENT OF PROCESS SYSTEMS INTERNATIONAL, INC. AND SHALL BE RETURNED UPON REQUEST.</p>		<table border="1"> <tr> <th>BVG. NO.</th> <th>DESCRIPTION</th> <th>BVG. NO.</th> <th>DESCRIPTION</th> </tr> <tr> <td>V049-5-012</td> <td>PIPING ARRANGEMENT PLAN CORNER STATION</td> <td></td> <td></td> </tr> <tr> <td>V049-5-001</td> <td>EQUIPMENT ARRANGEMENT CORNER STATION</td> <td></td> <td></td> </tr> <tr> <td>001100</td> <td>LIGO VACUUM EQUIPMENT CORNER STATION</td> <td></td> <td></td> </tr> </table>		BVG. NO.	DESCRIPTION	BVG. NO.	DESCRIPTION	V049-5-012	PIPING ARRANGEMENT PLAN CORNER STATION			V049-5-001	EQUIPMENT ARRANGEMENT CORNER STATION			001100	LIGO VACUUM EQUIPMENT CORNER STATION			<p>SCALE: 1/8" = 1'-0"</p>		<p>REV: 3</p>																				
BVG. NO.	DESCRIPTION	BVG. NO.	DESCRIPTION																																							
V049-5-012	PIPING ARRANGEMENT PLAN CORNER STATION																																									
V049-5-001	EQUIPMENT ARRANGEMENT CORNER STATION																																									
001100	LIGO VACUUM EQUIPMENT CORNER STATION																																									

