



not be reproduced, copied, loaned, exhibited, or used in any other way, except by written consent from PARSONS to the borrower.

This document and the design it covers are the property of PARSONS. They are loaned only with the borrower's expressed written agreement that they will

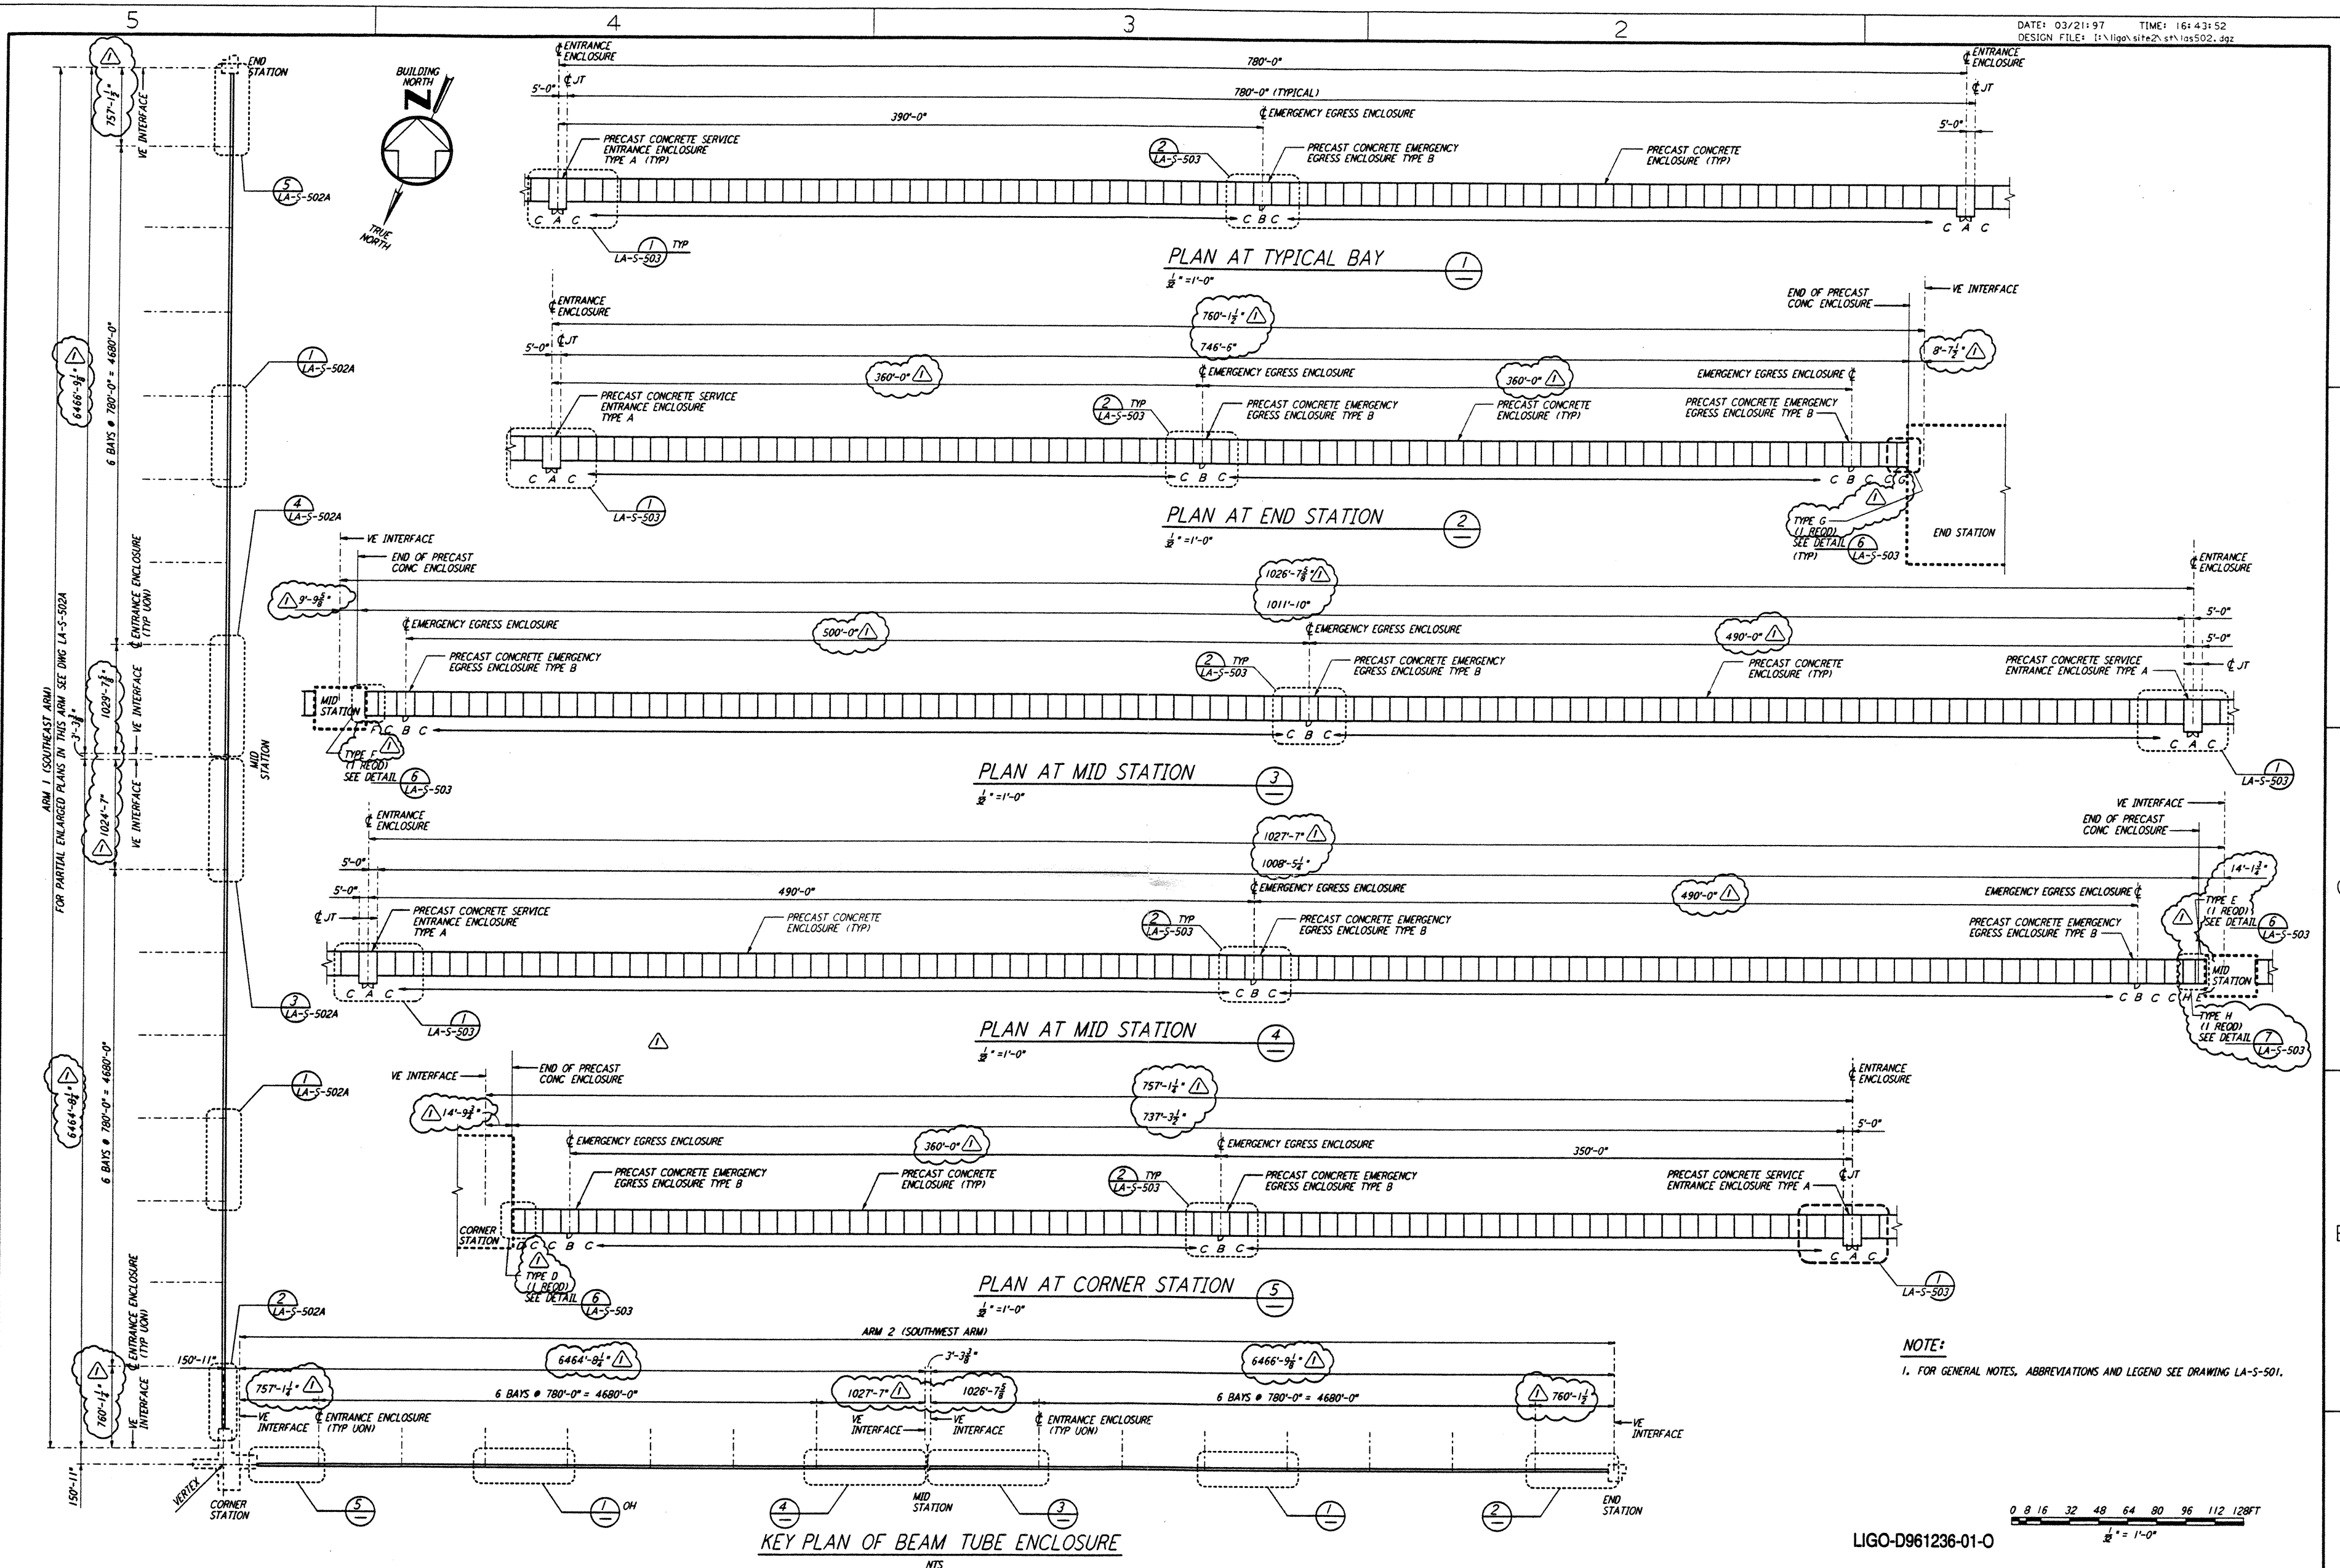


NOTE:  
 1. FOR GENERAL NOTES, ABBREVIATIONS AND LEGEND SEE DRAWING LA-S-501.

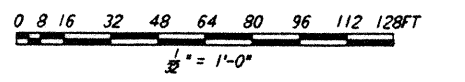

KEY PLAN OF BEAM TUBE ENCLOSURE

REFERENCES		REVIEWS		ISSUED FOR CONSTRUCTION	
NO.	DATE	BY	CHKD	ENGR	PROJ
1	2-28-97	GP			

DRAWN	MCS	11-15-96
CHECKED	DDM	11-15-96
ENGINEER	BP	11-15-96
PROJ	TDM	11-15-96

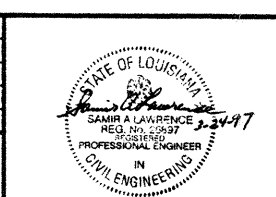

**PARSONS**  
 100 WEST WALNUT STREET  
 PASADENA, CALIFORNIA

**LIGO**  
 CALIFORNIA INSTITUTE OF TECHNOLOGY  
 MASSACHUSETTS INSTITUTE OF TECHNOLOGY

LASER INTERFEROMETER  
 GRAVITATIONAL-WAVE OBSERVATORY  
 BEAM TUBE ENCLOSURE - LIVINGSTON, LA

STRUCTURAL  
 KEY PLAN OF BEAM TUBE ENCLOSURE & PARTIAL ENLARGED PLANS

AS NOTED PPI50969 8094  
**LA-S-502**