
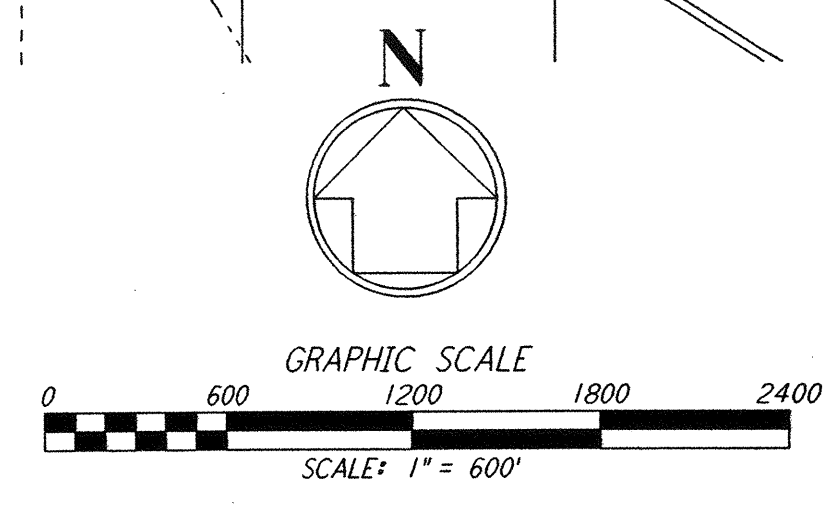


This document and the design it covers are the property of PARSONS. They are loaned only with the borrower's expressed written agreement that they will not be reproduced, copied, loaned, exhibited, or used in any other way, except by written consent from PARSONS to the borrower.

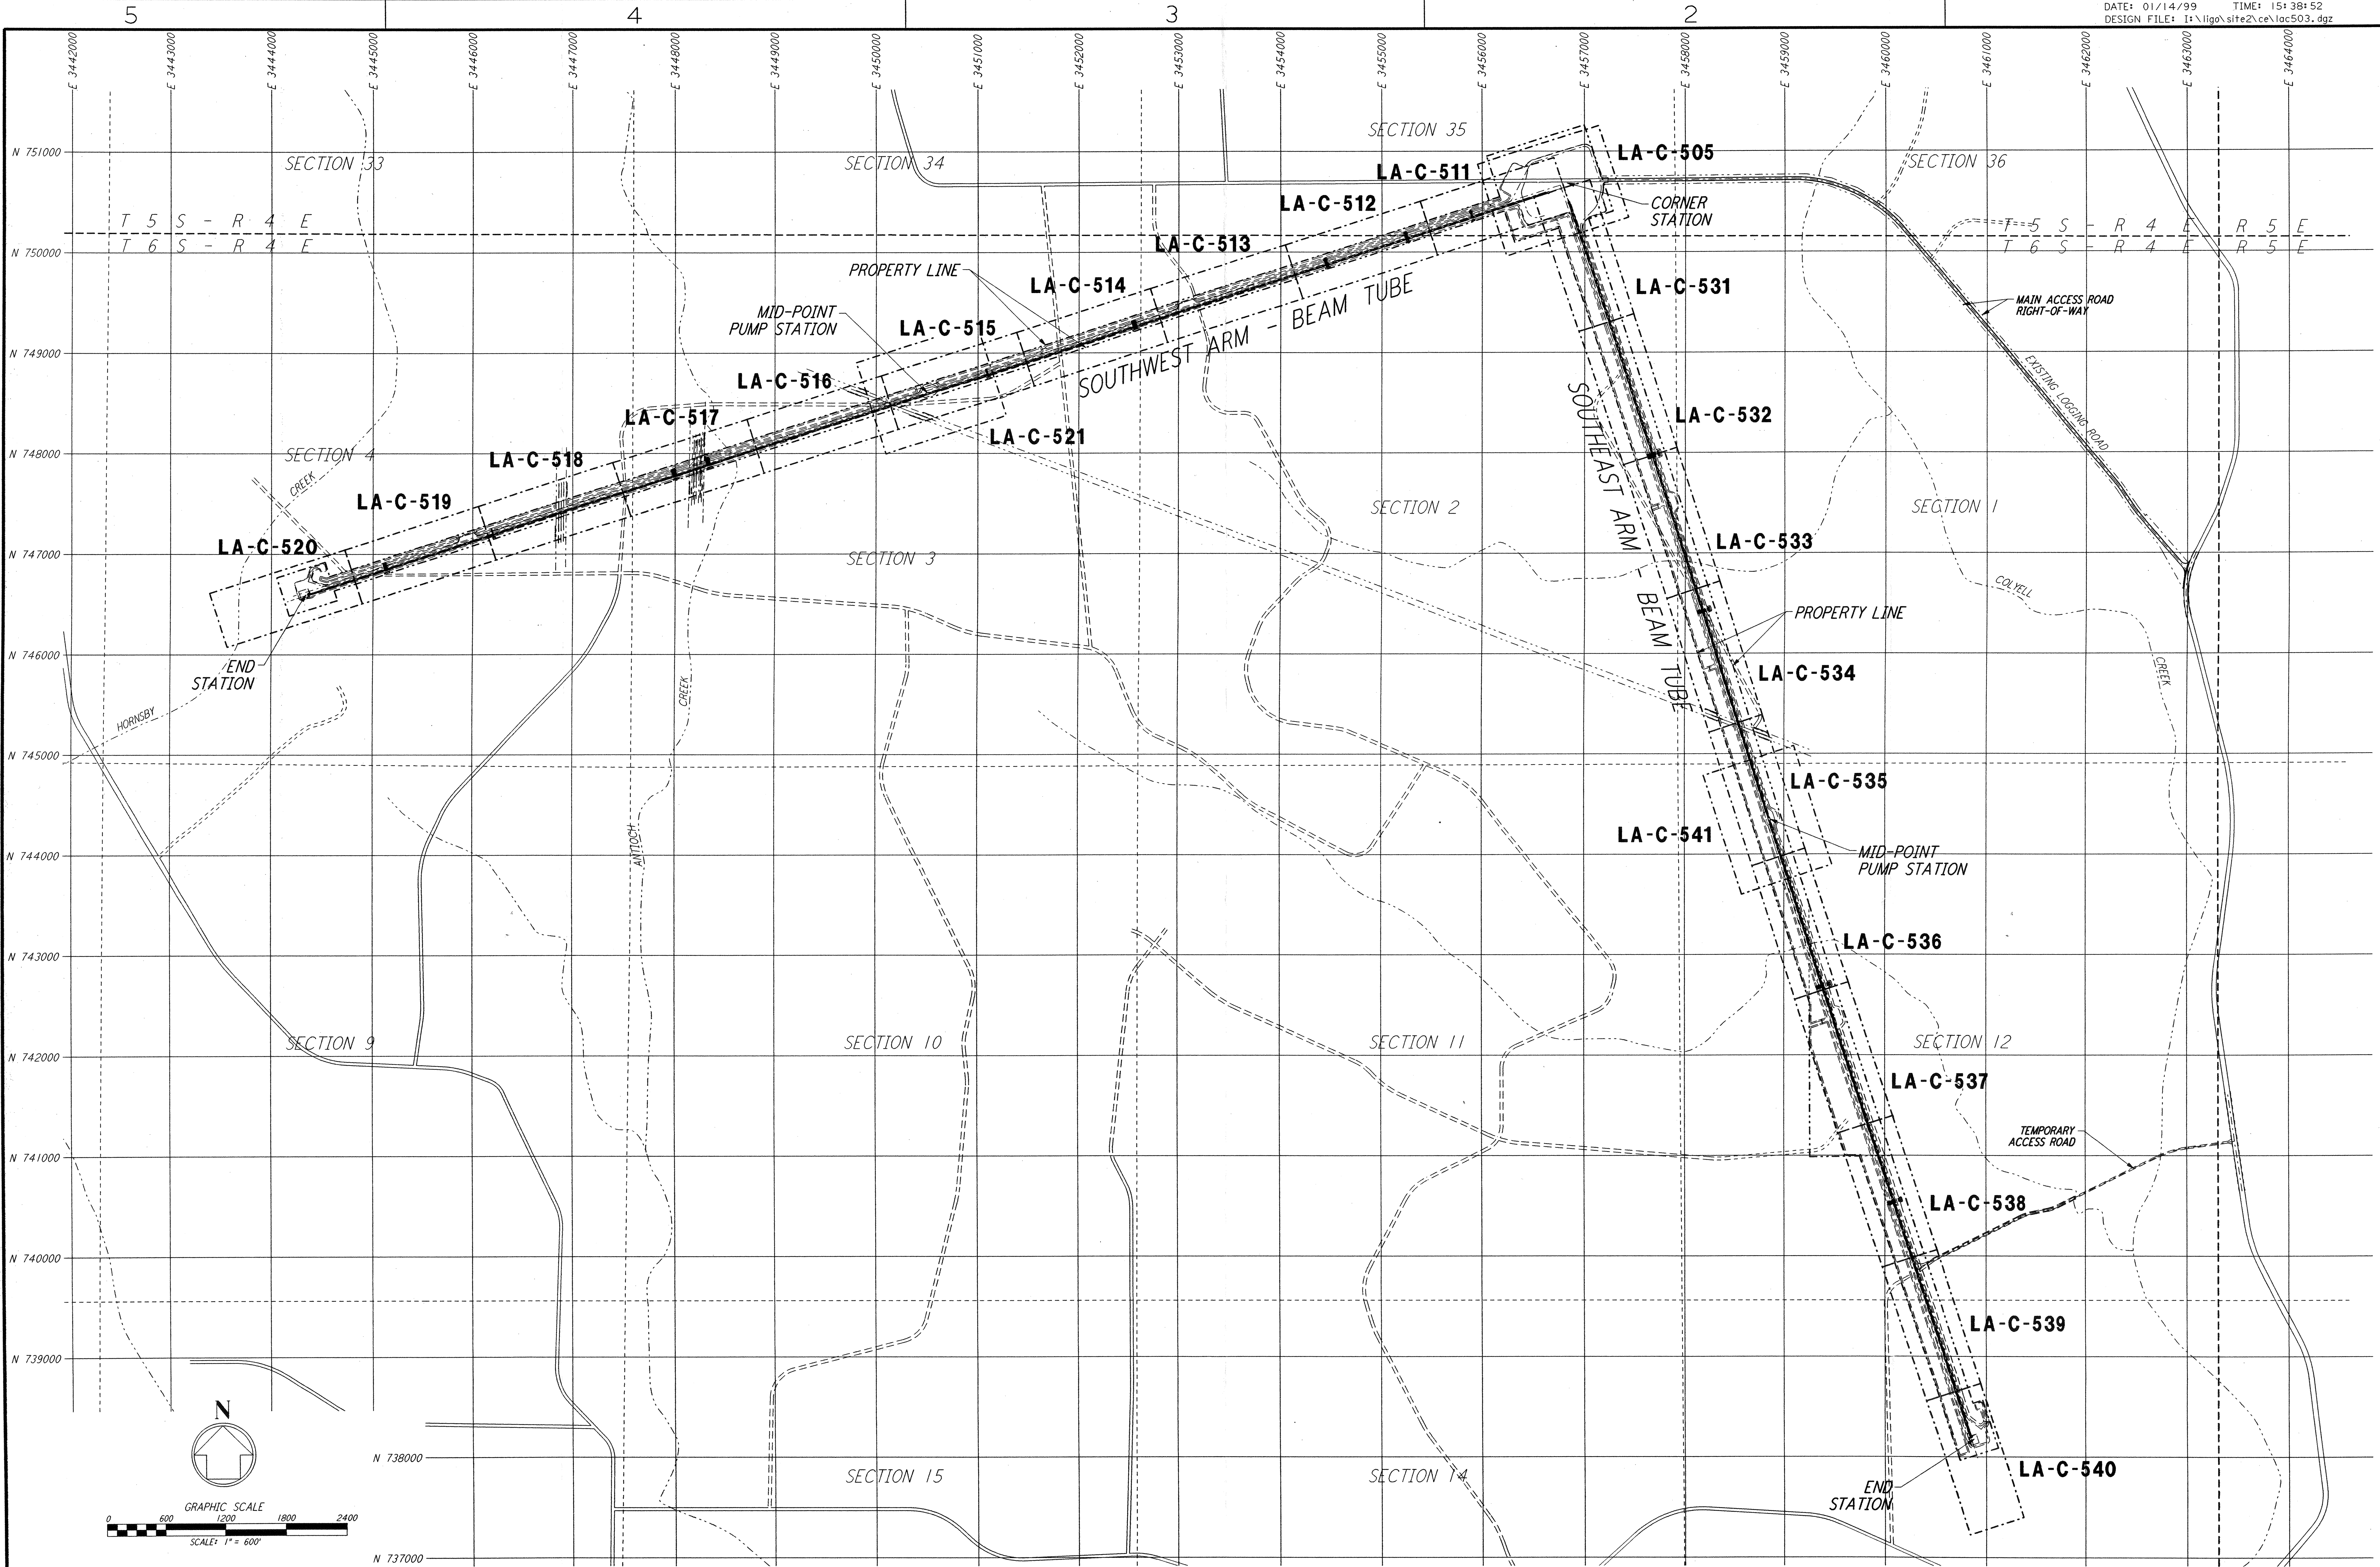

LIGO-D961260-01-O

REFERENCES	REVISIONS	ISSUED FOR CONSTRUCTION
DRAWING NO. DESCRIPTION	NO. DATE BY CHKD ENGR PROJ	DRAWN WRB 11-15-96 CHECKED ENGINEER PROJ
1 1-15-99 MEI -- -- MDW ISSUED FOR AB BUILT		

AS-BUILT DRAWINGS

PARSONS
 100 WEST WALNUT STREET
 PASADENA, CALIFORNIA

LIGO
 CALIFORNIA INSTITUTE OF TECHNOLOGY
 MASSACHUSETTS INSTITUTE OF TECHNOLOGY

LASER INTERFEROMETER
 GRAVITATIONAL-WAVE OBSERVATORY
 BEAM TUBE ENCLOSURE - LIVINGSTON, MA

CIVIL DRAWING MATRIX

SCALE: 1" = 600'
 SHEET NUMBER: PP150969
 PROJECT NUMBER: 8094
LA-C-503