


Mon Sep 30 05:25:39 1996 63-1182 J:\PLOTS\MLFUSV18B2\CF505A.PRF


DATE: 09/30/96 TIME: 05:26:26  
 DESIGN FILE: I:\ligno\site2\c\l\lac505.dwg

CURVE DATA (TEMPORARY SERVICE ROAD)					
STATION	R	Δ	L	T	REMARK
1	35'	96°10'05"	57.70'	38.99'	EDGE OF ROAD
2	35'	72°25'43"	43.95'	25.63'	EDGE OF ROAD
3	215'	31°12'13"	117.09'	60.04'	TEMPORARY SERVICE ROAD
4	215'	31°01'25"	116.42'	59.67'	
5	110'	62°14'25"	119.49'	66.41'	
6	50'	90°00'00"	78.54'	50.00'	
7	110'	45°00'00"	86.39'	45.56'	
8	110'	45°00'00"	78.54'	41.42'	



**NOTES:**  
 1. SEE SHEET LA-C-502 FOR GENERAL NOTES, LEGEND AND ABBREVIATIONS.  
 2. FOR PROPERTY CORNER LOCATIONS, SEE SHEET LA-C-501.

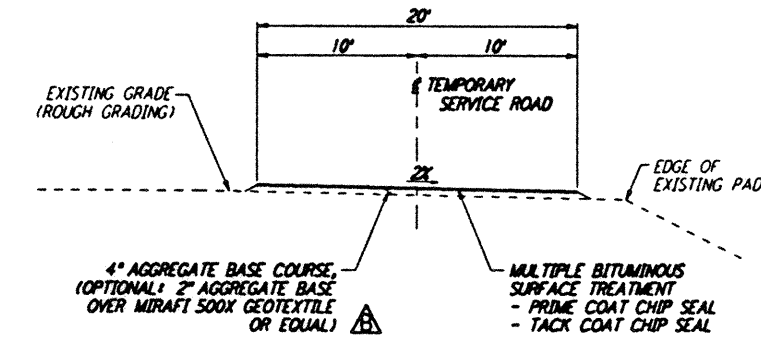

TEMPORARY SERVICE ROAD (1)  
 NOT TO SCALE

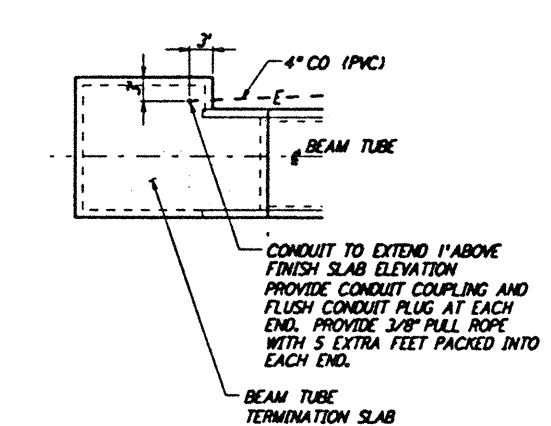

DETAIL (2)  
 NOT TO SCALE

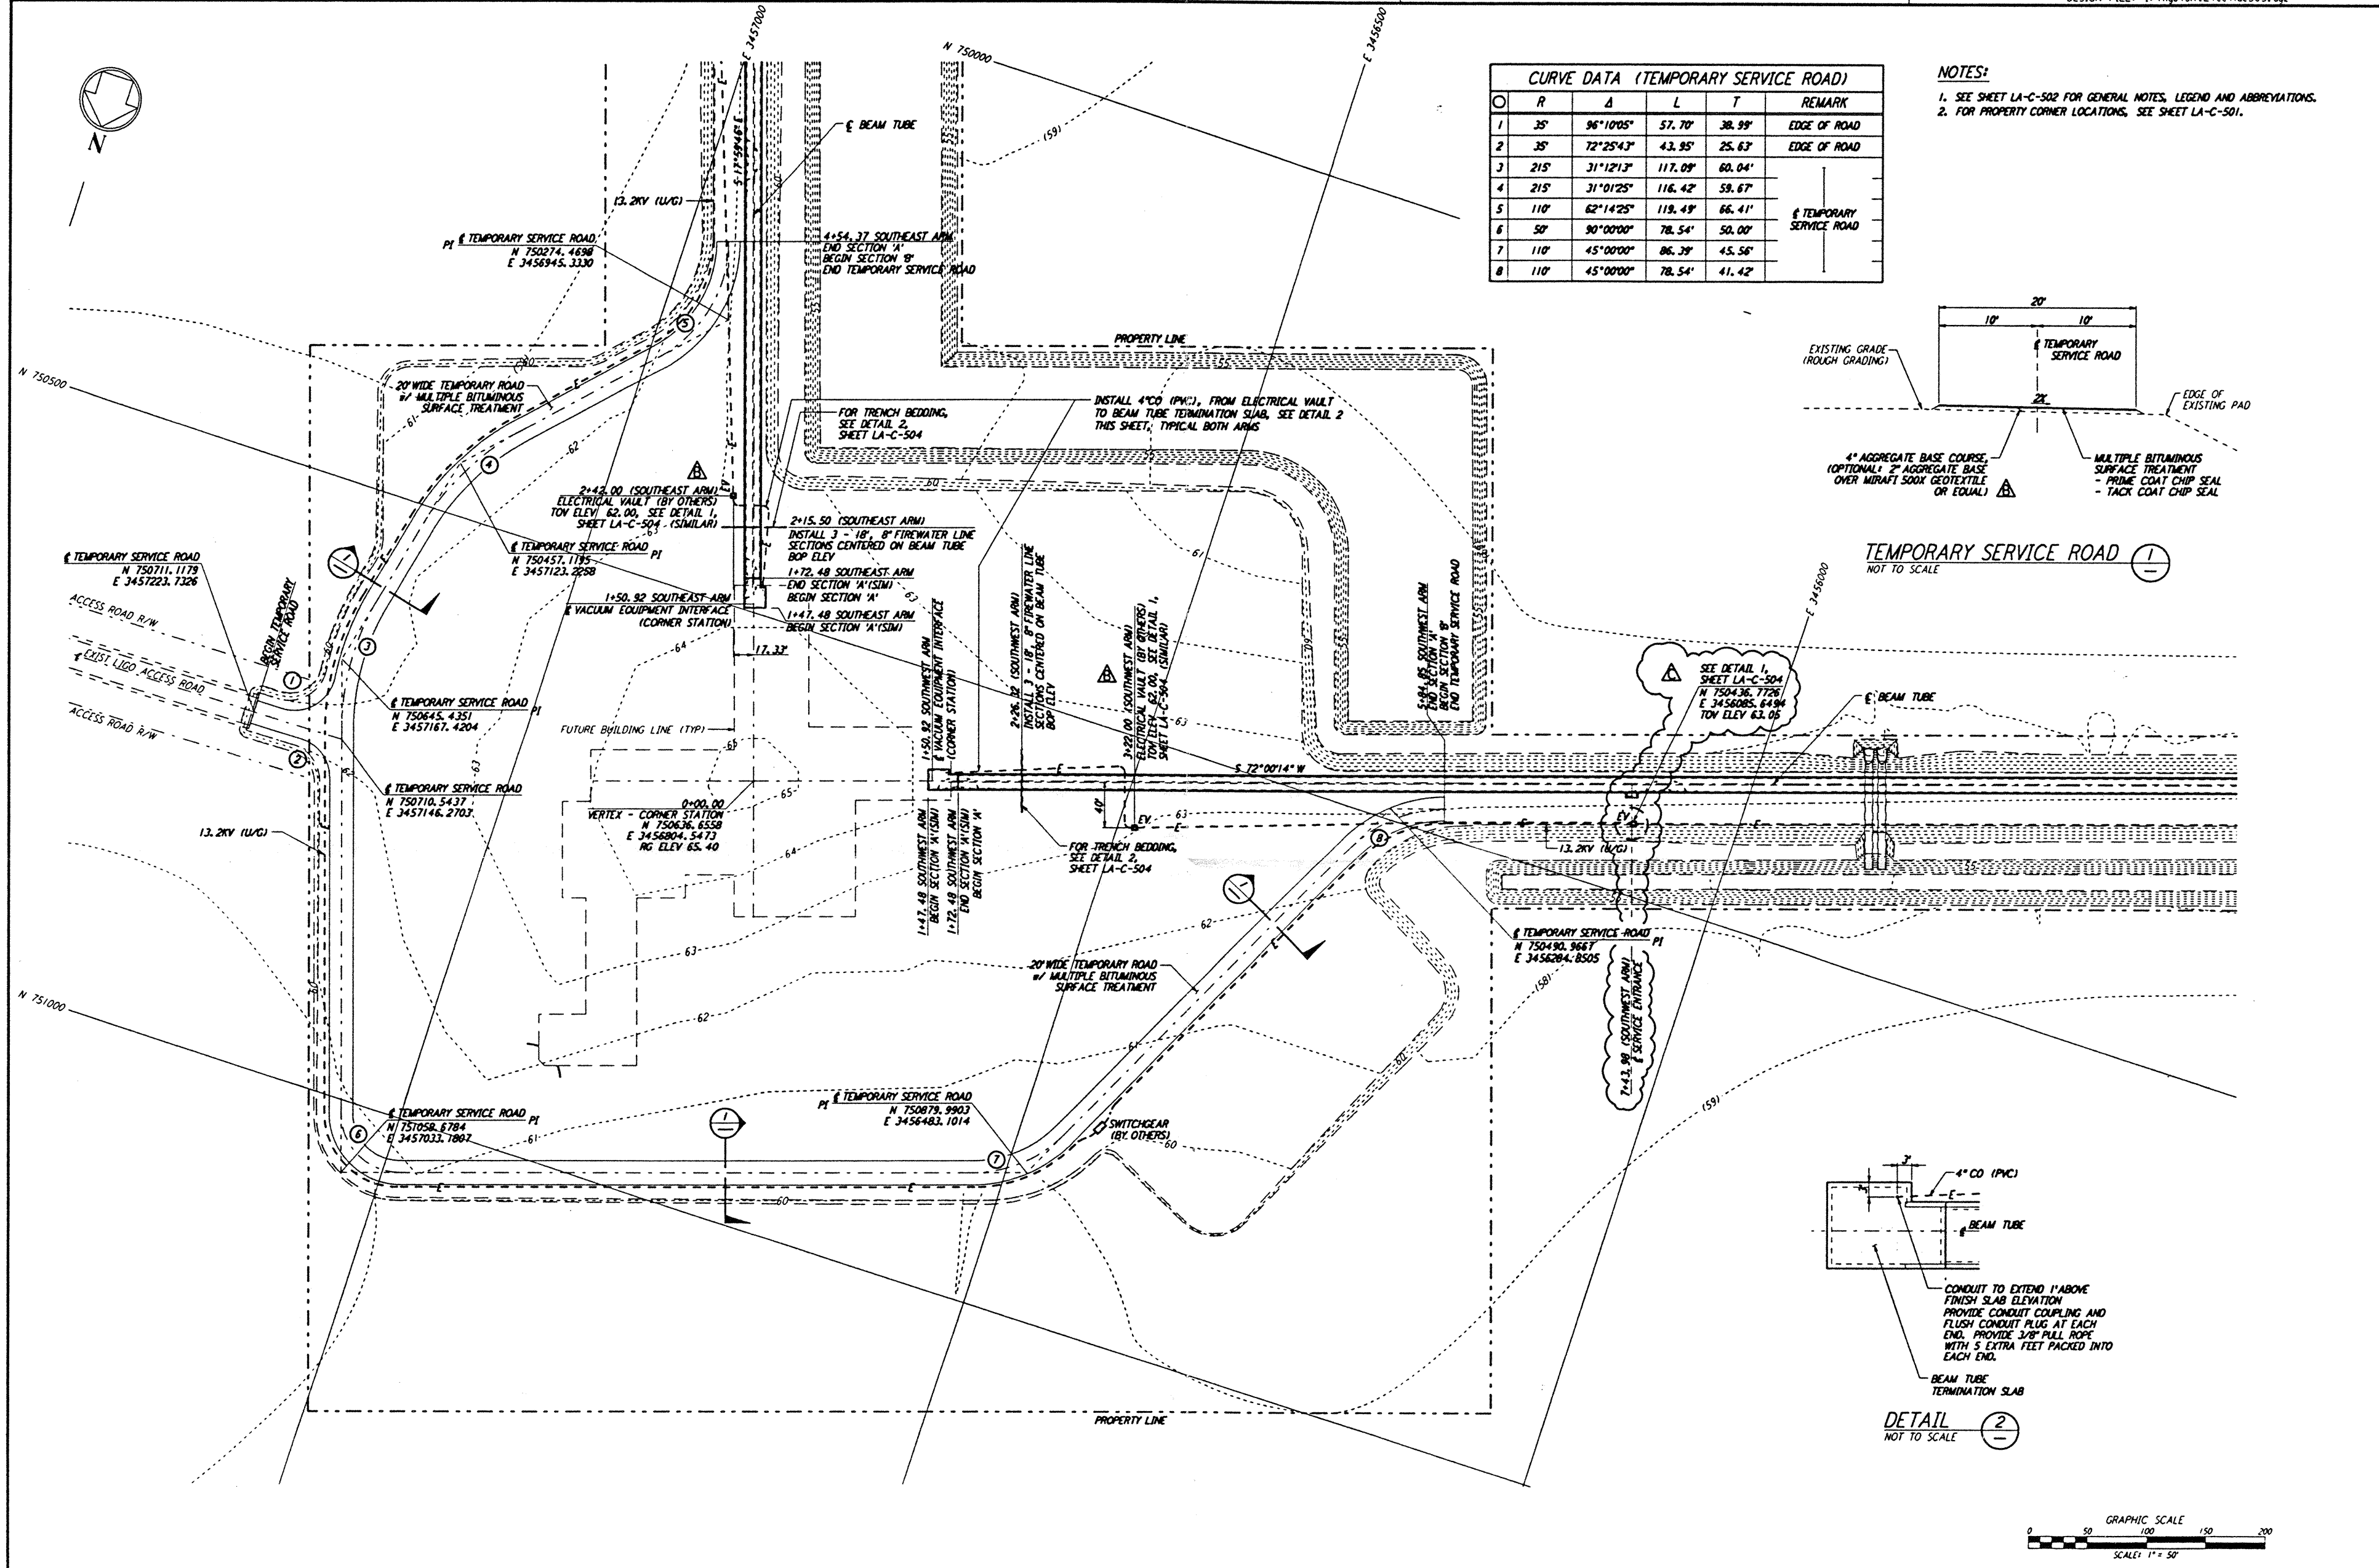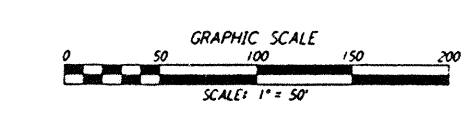

This document and the design it covers are the property of PARSONS. They are loaned only with the borrower's expressed written agreement that they will not be reproduced, copied, loaned, exhibited, or used in any other way, except by written consent from PARSONS to the borrower.

NO.	DATE	BY	CHKD	ENGR	PROJ	DESCRIPTION
C	9/27/96	WRB	ML	JB	TDM	BID ADDENDUM NO. 3
B	9/10/96	WRB	ML	JB	TDM	BID ADDENDUM NO. 2
A	6/28/96	WRB	ML	JB	TDM	FINAL DESIGN REVIEW

DRAWN	WRB	6/24/96
CHECKED		
ENGINEER		
PROJ		

**PARSONS**  
 100 WEST WALNUT STREET  
 PASADENA, CALIFORNIA

**LIGO**  
 CALIFORNIA INSTITUTE OF TECHNOLOGY  
 MASSACHUSETTS INSTITUTE OF TECHNOLOGY

LASER INTERFEROMETER  
 GRAVITATIONAL-WAVE OBSERVATORY  
 BEAM TUBE ENCLOSURE - LIVINGSTON, LA

CIVIL  
 CORNER STATION  
 PLAN

SCALE: 1" = 50'  
 CONTRACT NUMBER: PP150969  
 PROJECT NUMBER: 8094  
**LA-C-505**