



NOTES:
 1. SEE SHEET LA-C-502 FOR GENERAL NOTES, LEGEND AND ABBREVIATIONS.
 2. SEE SHEET LA-C-504 FOR TYPICAL SECTIONS AND DETAILS.

CURVE DATA					
Δ	RADIUS	LENGTH	TANGENT	REMARK	
1	35°00'00"	110'	67.19'	34.68'	§ ROAD
2	35°00'00"	100'	61.07'	31.53'	§ ROAD



PROFILE
 SCALES: HORIZ: 1" = 50'
 VERT: 1" = 5'

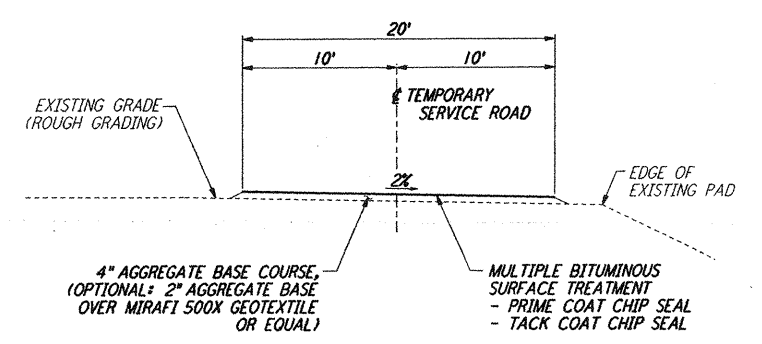

TEMPORARY SERVICE ROAD
 NOT TO SCALE

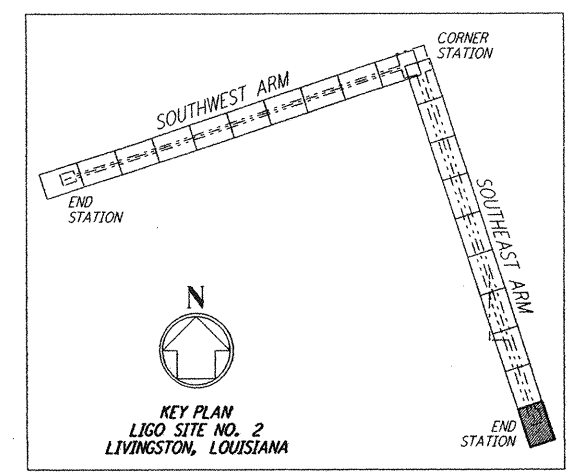

LIGO-D961285-02-0

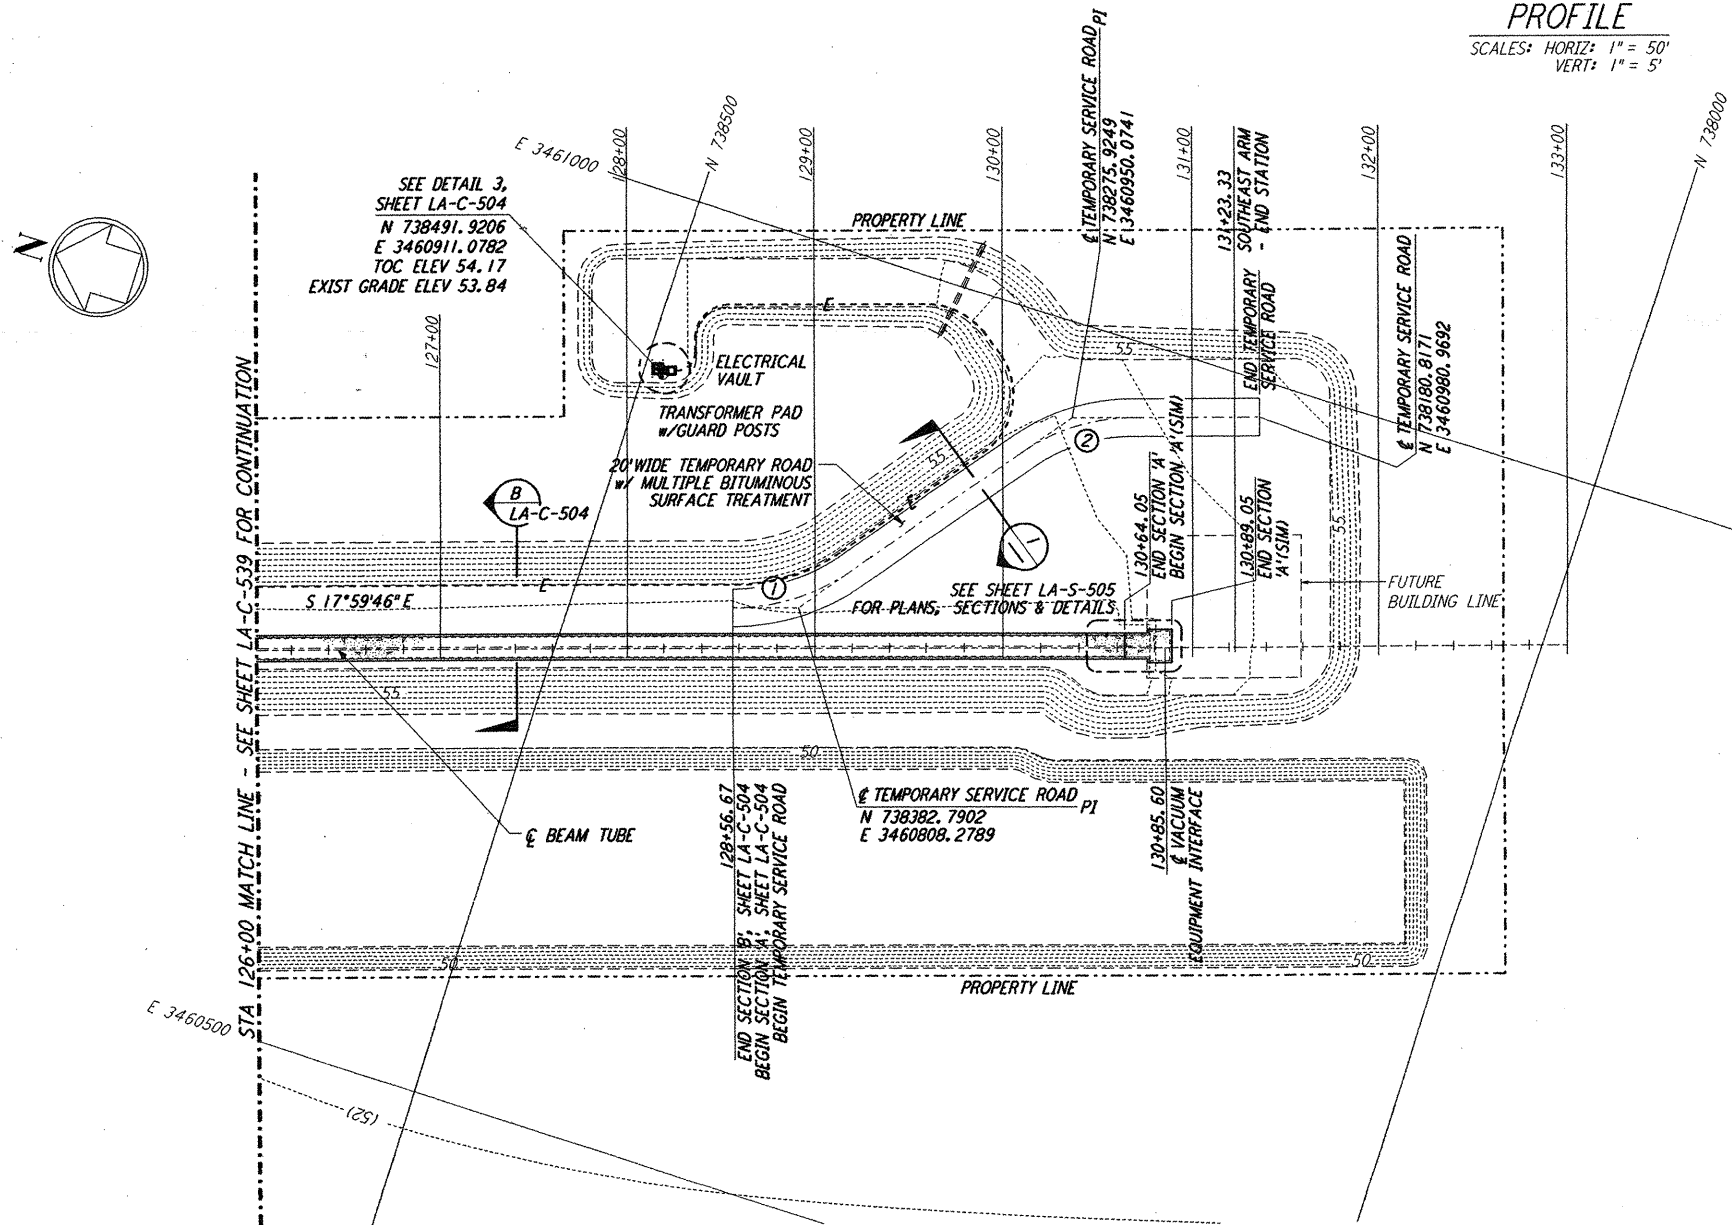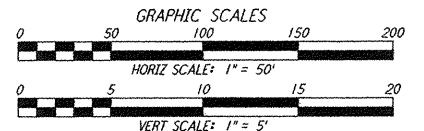

PLAN
 SCALE: 1" = 50'

not be reproduced, copied, loaned, exhibited, or used in any other way, except by written consent from PARSONS to the borrower.

This document and the design it covers are the property of PARSONS. They are loaned only with the borrower's expressed written agreement that they will

NO.	DATE	BY	CHKD	ENGR	PROJ	DESCRIPTION
2	1-15-99	MEI			MDW	ISSUED FOR AS BUILT
1	2-3-97	WRB				REVISED PROFILE ELEVATIONS

ISSUED FOR CONSTRUCTION		
DRAWN	WRB	11-15-96
CHECKED	ML	11-15-96
ENGINEER	JB	11-15-96
PROJ	TDM	11-15-96

AS-BUILT DRAWINGS

PARSONS
 100 WEST WALNUT STREET
 PASADENA, CALIFORNIA

LIGO
 CALIFORNIA INSTITUTE OF TECHNOLOGY
 MASSACHUSETTS INSTITUTE OF TECHNOLOGY

LASER INTERFEROMETER
 GRAVITATIONAL-WAVE OBSERVATORY
 BEAM TUBE ENCLOSURE - LIVINGSTON, LA

TITLE	SCALE	CONTRACT NUMBER	PROJECT NUMBER
CIVIL	AS NOTED	PP150969	8094
SOUTHEAST ARM	SHEET NUMBER	LA-C-540	REVISION
PLAN AND PROFILE			
STA 126+00 TO STA 133+00			

7:1 Jan 15 12:42:42 1999 C:\PLOT\GLES9-19862.DWG \$2086 K:\V\BBS\csp540.dgn