


This document and the design it covers are the property of PARSONS. They are loaned only with the borrower's expressed written agreement that they will not be reproduced, copied, loaned, exhibited, or used in any other way, except by written consent from PARSONS to the borrower.

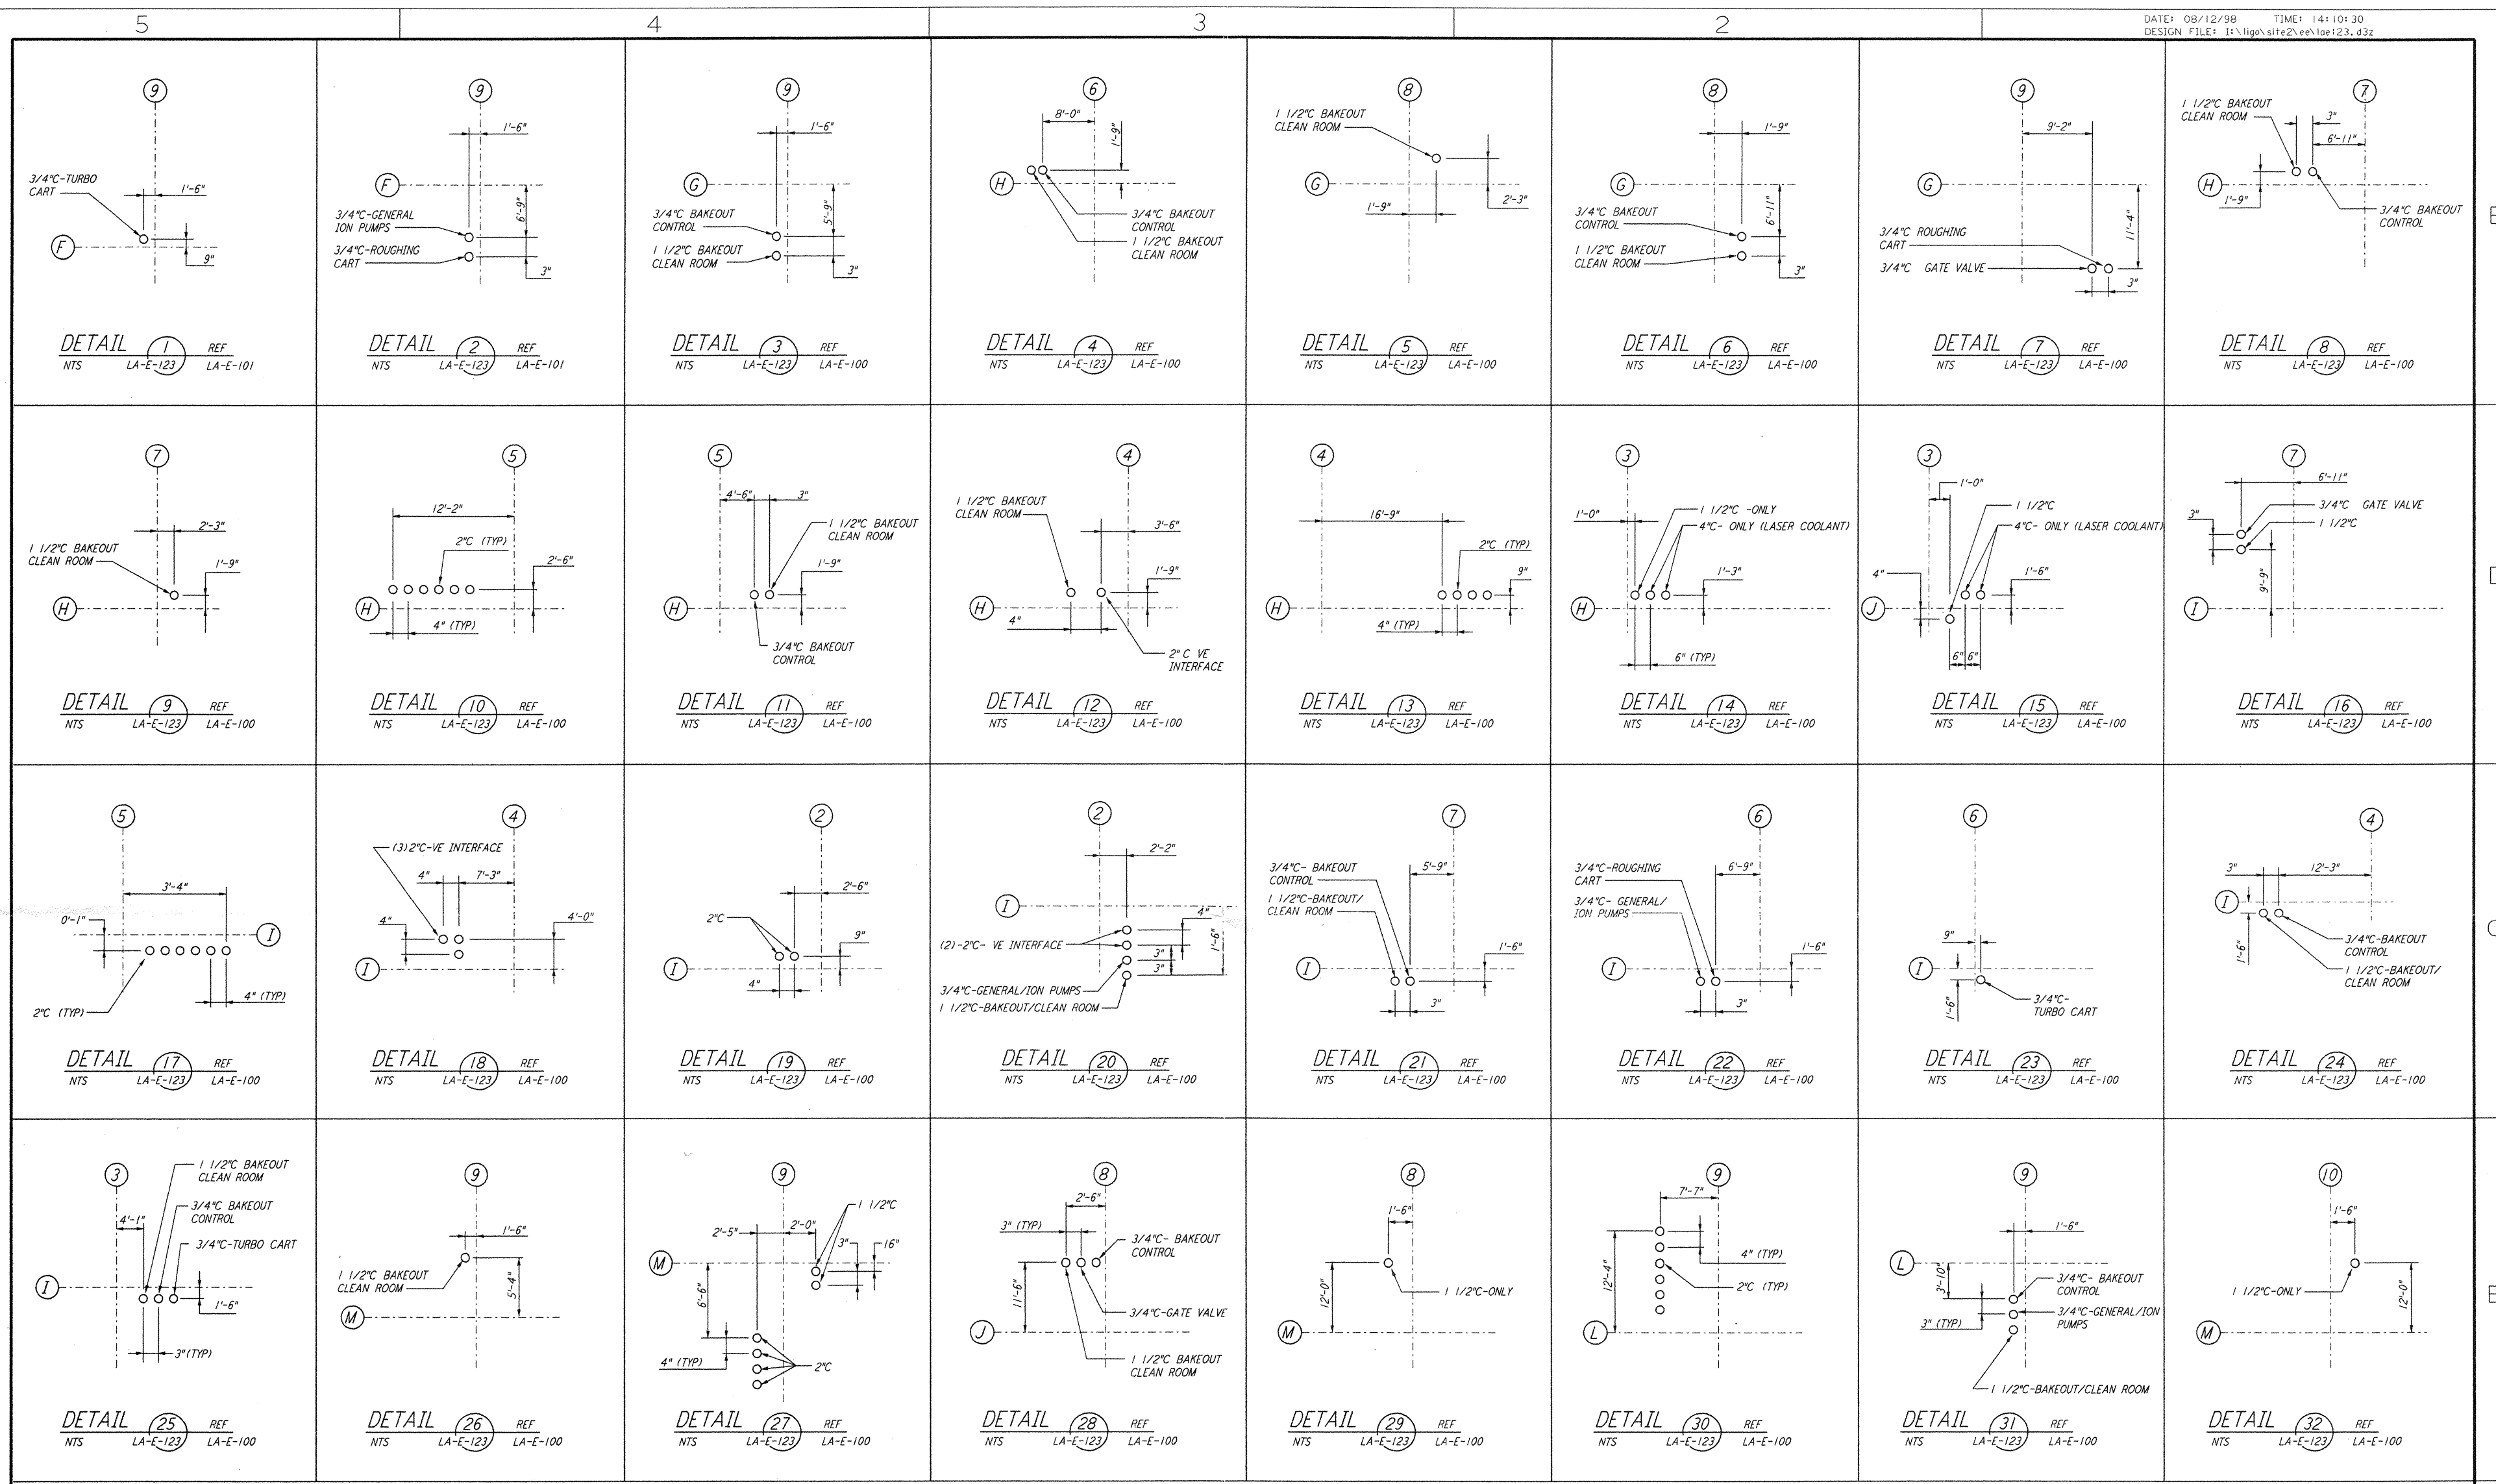

NOTE: THE DETAILS ON SHEETS LA-E-123, LA-E-124 AND LA-E-125 SUPERSEDE, ENTIRELY THE DETAILS ON SHEET LA-E-114

NO.	DATE	BY	CHKD	ENGR	PROJ	DESCRIPTION
3	8-7-98	JE	AK	MM		ISSUED FOR AS-BUILT
2	4-21-97	J.G.	KR	Y.D.M.		REVISED FOR CDS AND VAC. EQUIP.
1	4-4-97	J.G.	KR	TOM		GENERAL REVISIONS

ISSUED FOR CONSTRUCTION
 DRAWN J.G. 3-21-97
 CHECKED B.K. 3-21-97
 ENGINEER K.C.R. 3-21-97
 PROJ T.D.M. 3-21-97

AS-BUILT DRAWINGS

PARSONS

100 WEST WALNUT STREET
 PASADENA, CALIFORNIA

LIGO

CALIFORNIA INSTITUTE OF TECHNOLOGY
 MASSACHUSETTS INSTITUTE OF TECHNOLOGY

LIGO-D961479-03-0

LASER INTERFEROMETER
 GRAVITATIONAL-WAVE OBSERVATORY
 SITE NO. 2 - LIVINGSTON, LOUISIANA

ELECTRICAL CORNER STATION
 LVEA AREAS 101, 102, 103, 104
 DETAILS

REVISION NUMBER: NONE
 PROJECT NUMBER: PPI50969
 SHEET NUMBER: 8094
LA-E-123

Wed Aug 12 14:06:55 1998 C:\PILOT\QUE\53\10882\JCF 52085 K:\V\882\ee\l23.d3z