


This document and the design it covers are the property of PARSONS. They are loaned only with the borrower's expressed written agreement that they will not be reproduced, copied, loaned, exhibited, or used in any other way, except by written consent from PARSONS.

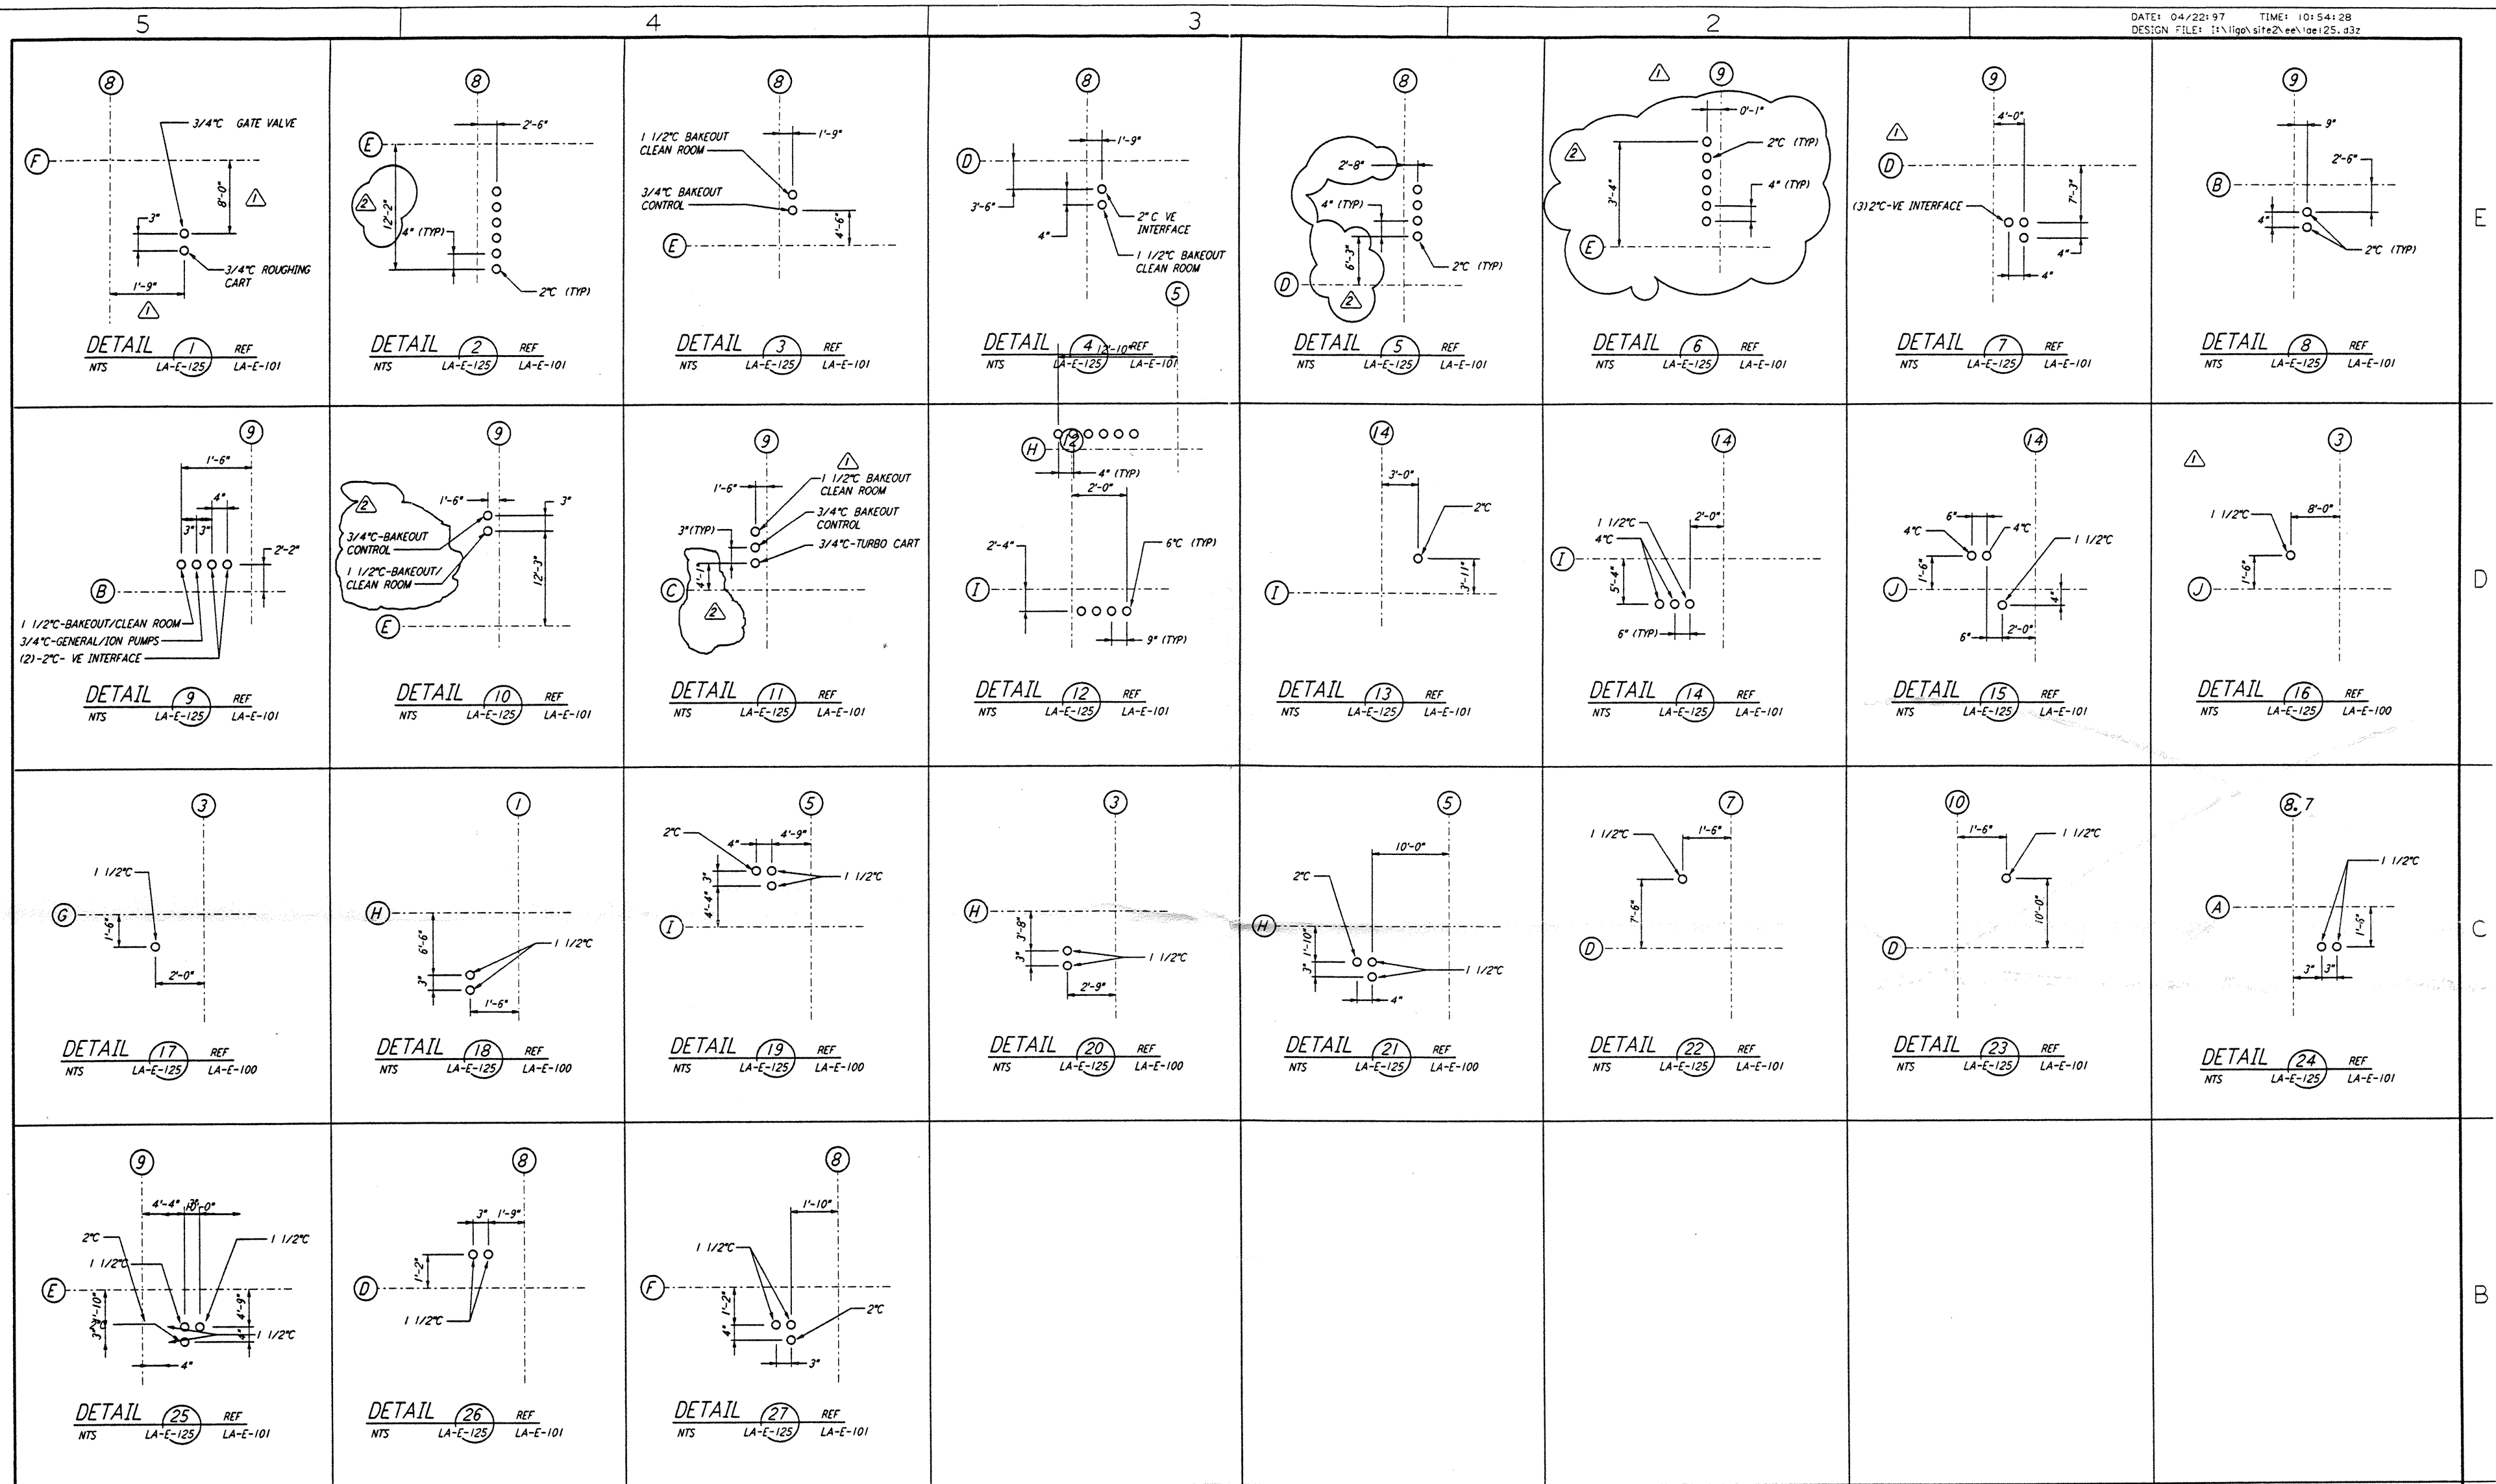


NOTE: THE DETAILS ON SHEETS LA-E-123, LA-E-124 AND LA-E-125 SUPERSEDE, ENTIRELY THE DETAILS ON SHEET LA-E-114

LIGO-D961481-02-0

NO.	DATE	BY	CHKD	ENGR	PROJ	DESCRIPTION
2	4-21-97	J.G.	KR	KR	TDM	REVISED FOR CDS AND VAC. EQUIP.
1	4-4-97	J.G.	KR	TDM		GENERAL REVISIONS

ISSUED FOR CONSTRUCTION		
DRAWN	J.G.	3-21-97
CHECKED	B.K.	3-21-97
ENGINEER	K.C.R.	3-21-97
PROJ	T.D.M.	3-21-97

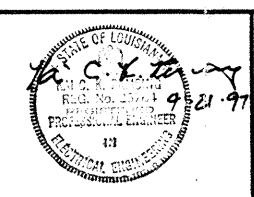

PARSONS
 100 WEST WALNUT STREET
 PASADENA, CALIFORNIA

LIGO
 CALIFORNIA INSTITUTE OF TECHNOLOGY
 MASSACHUSETTS INSTITUTE OF TECHNOLOGY

LASER INTERFEROMETER
 GRAVITATIONAL-WAVE OBSERVATORY
 SITE NO. 2 - LIVINGSTON, LOUISIANA

TITLE	SHEET	CONTRACT NUMBER	PROJECT NUMBER
ELECTRICAL CORNER STATION LVEA AREAS 101, 102, 103, 104 DETAILS	NONE	PP150969	8094
SHEET NUMBER			REVISIONS
LA-E-125			