




This document and the design it covers are the property of PARSONS. They are loaned only with the borrower's expressed written agreement that they will not be reproduced, copied, loaned, exhibited, or used in any other way, except by written consent from PARSONS to the borrower.

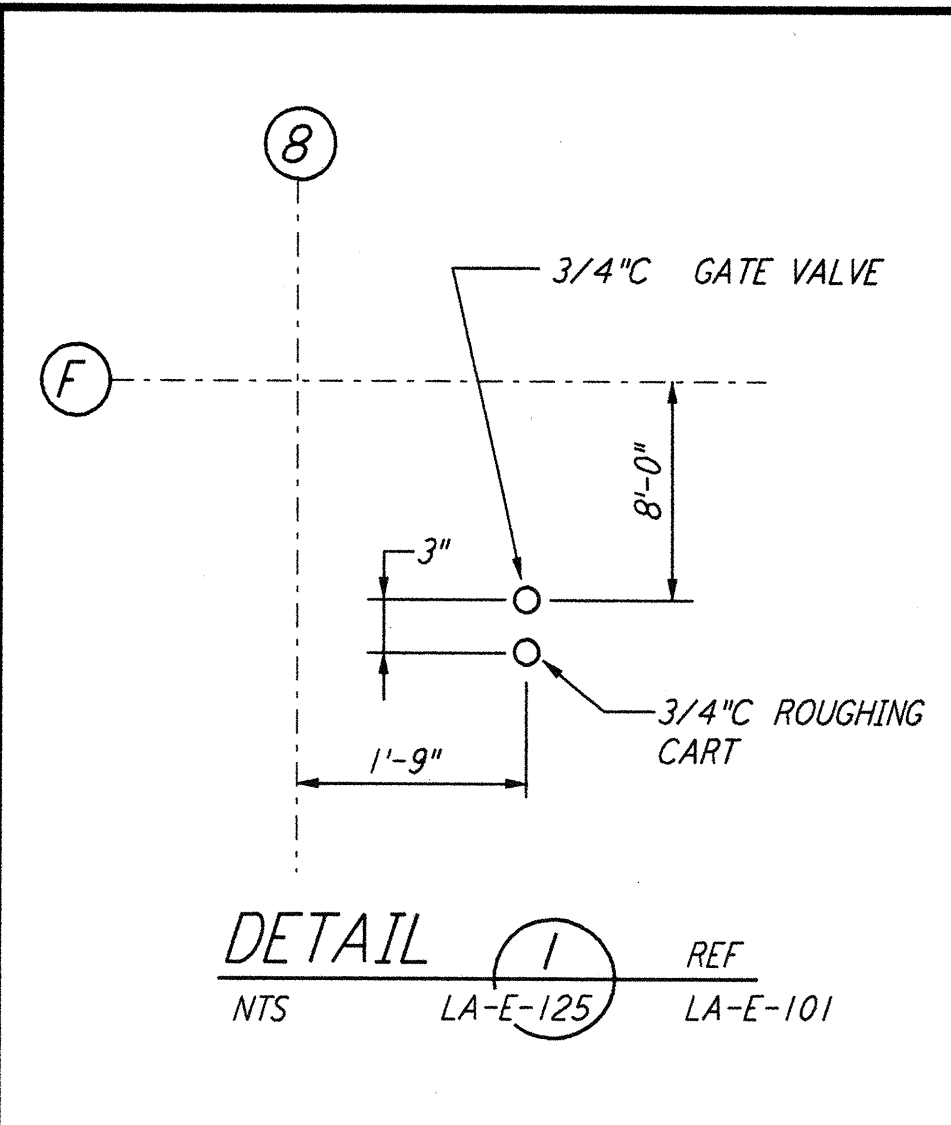


DETAIL 1 REF  
 NTS LA-E-125 LA-E-101

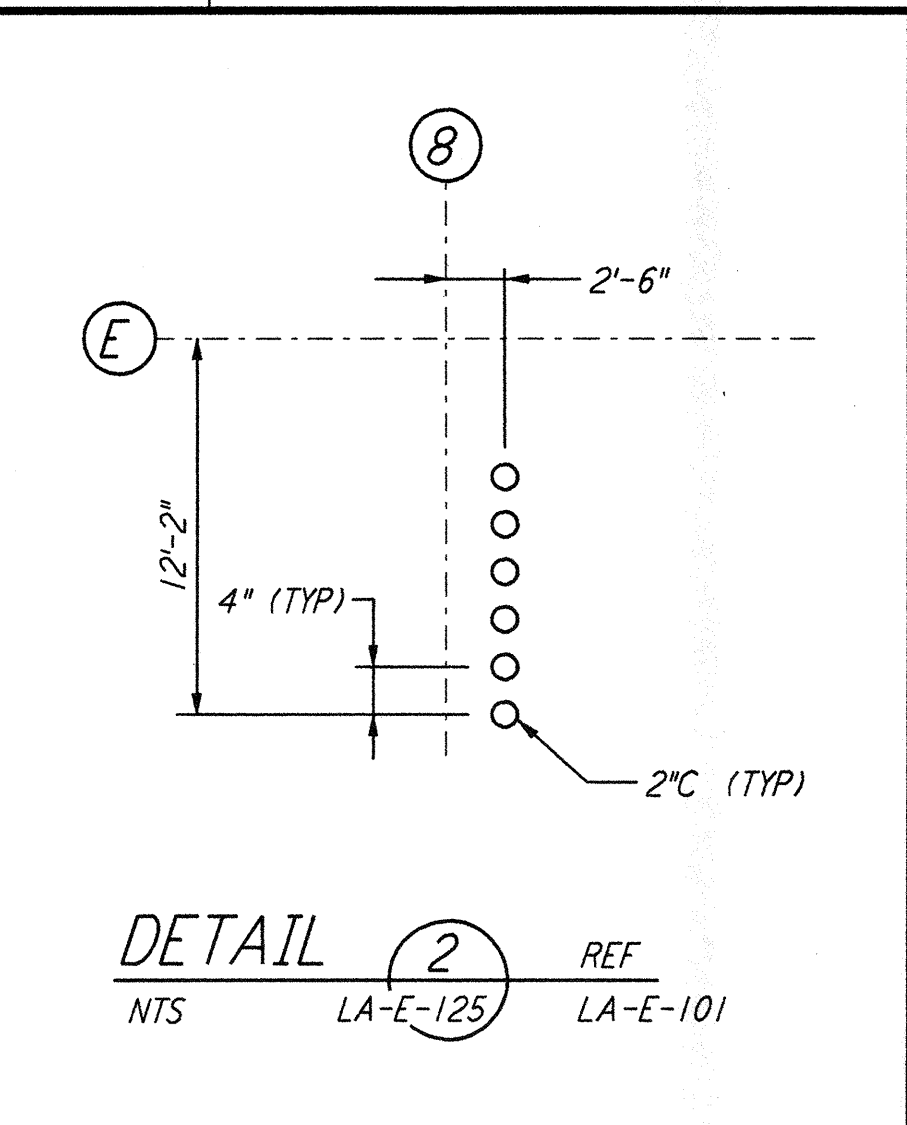


DETAIL 2 REF  
 NTS LA-E-125 LA-E-101

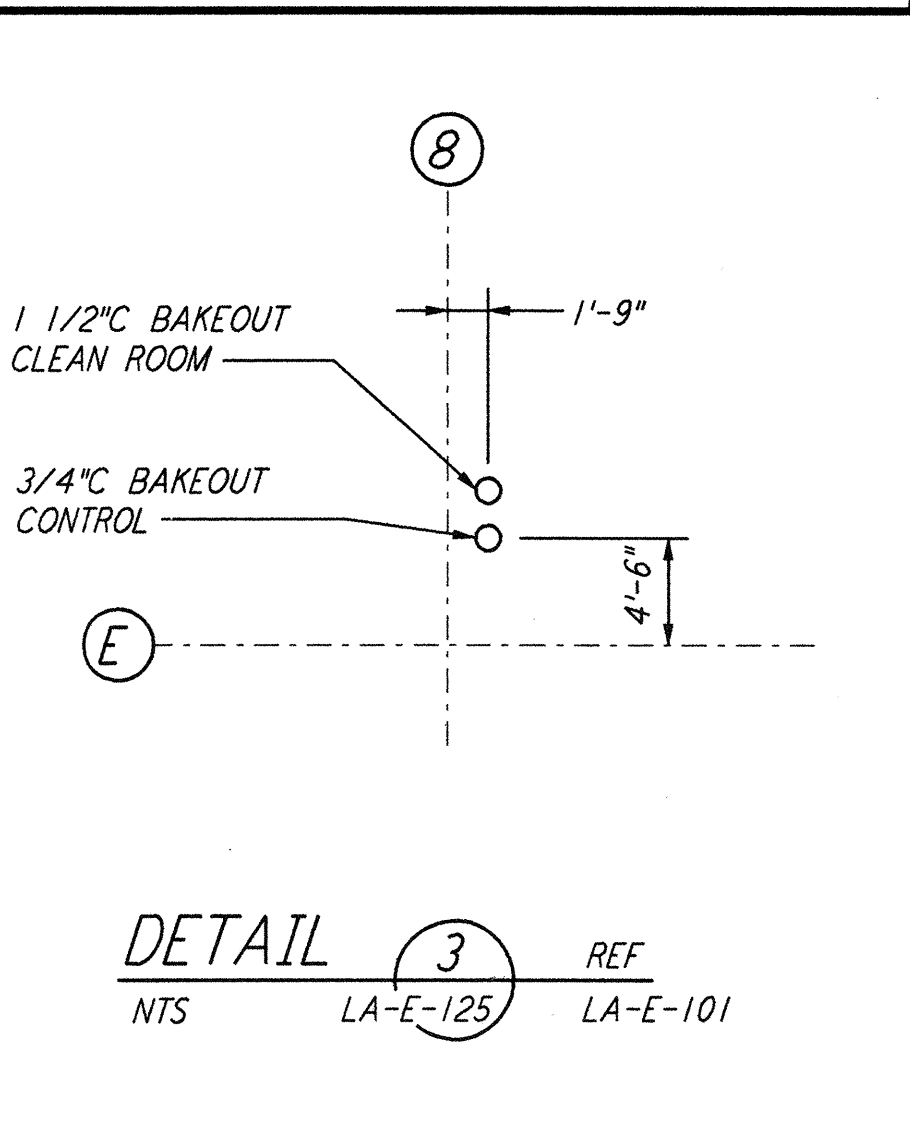


DETAIL 3 REF  
 NTS LA-E-125 LA-E-101

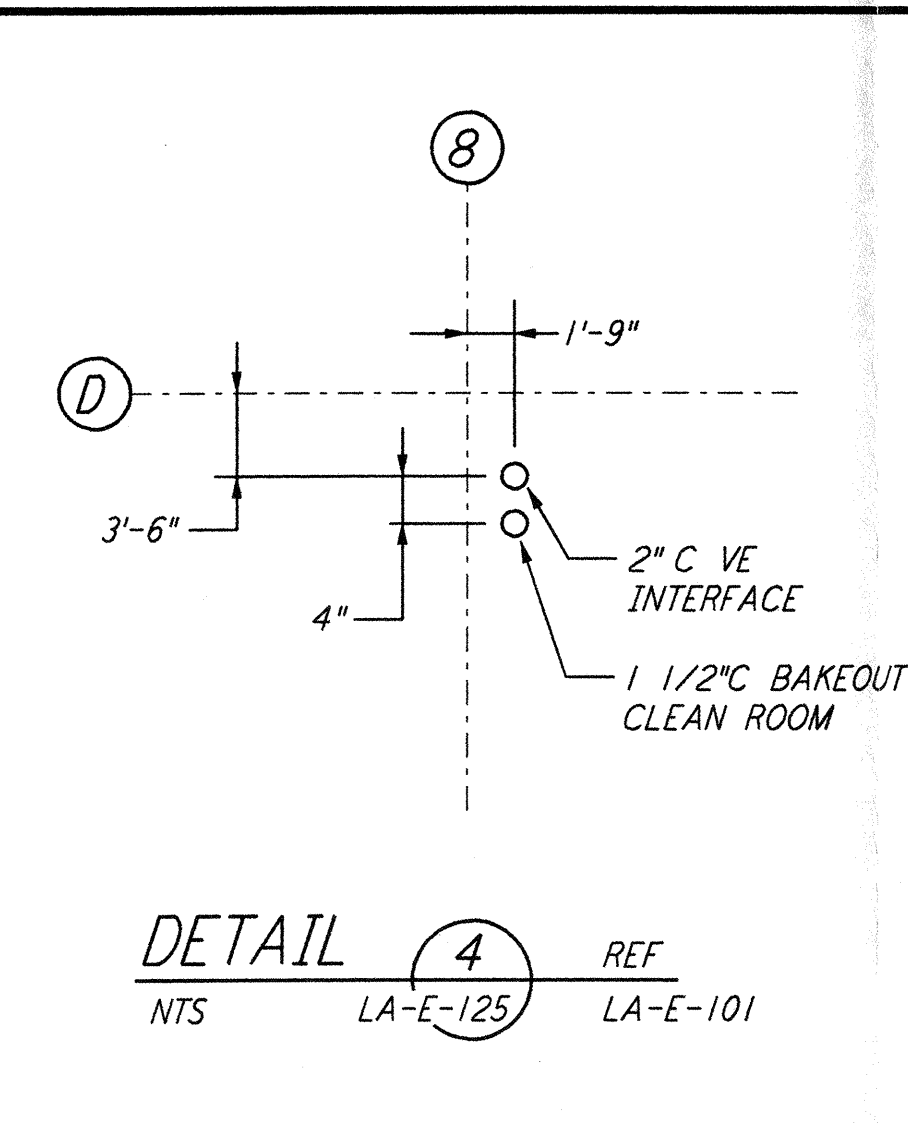


DETAIL 4 REF  
 NTS LA-E-125 LA-E-101

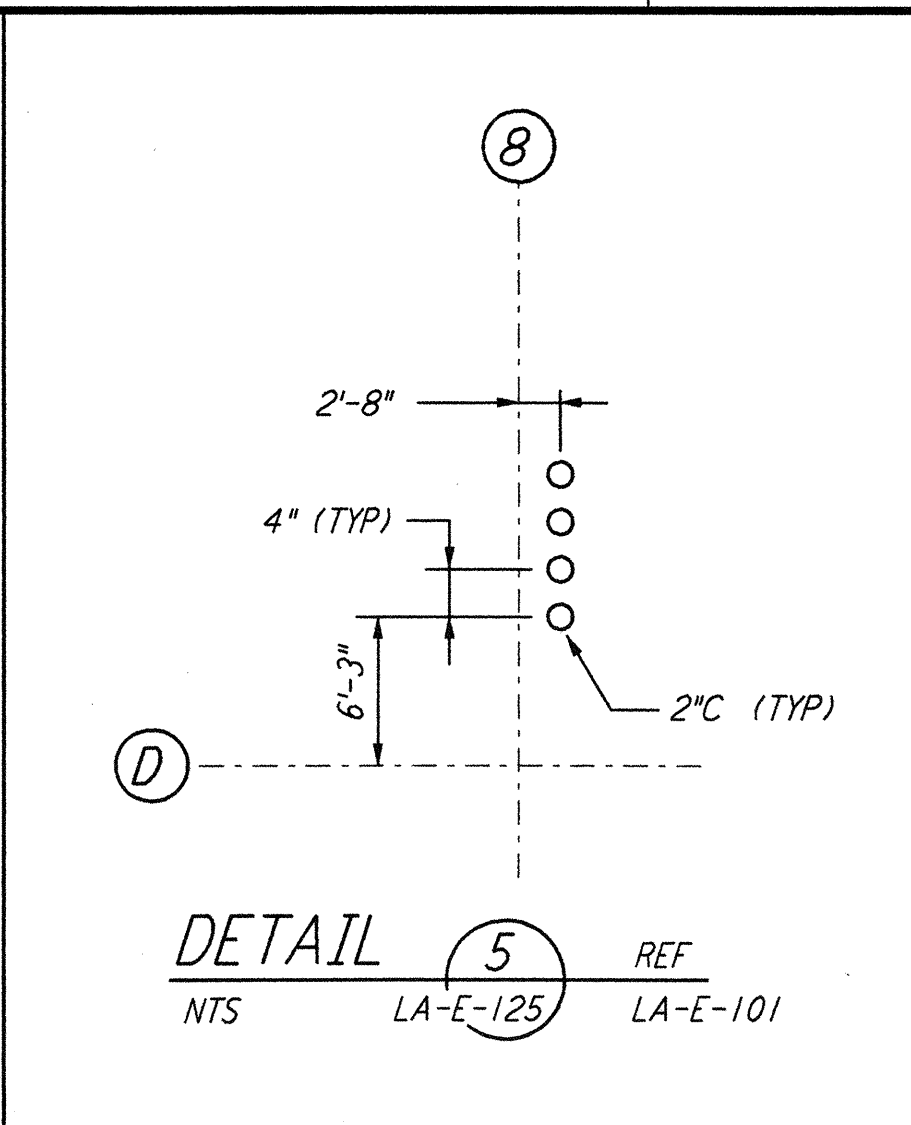


DETAIL 5 REF  
 NTS LA-E-125 LA-E-101

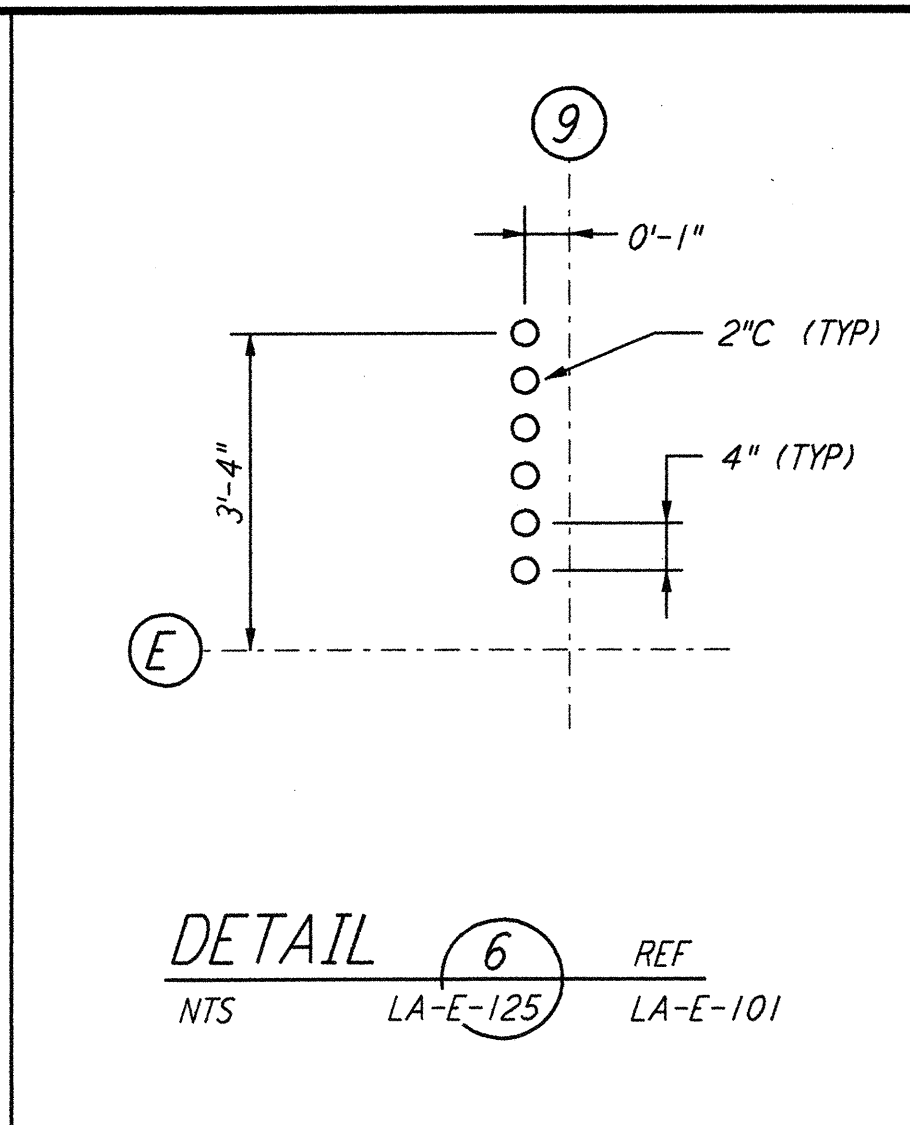


DETAIL 6 REF  
 NTS LA-E-125 LA-E-101

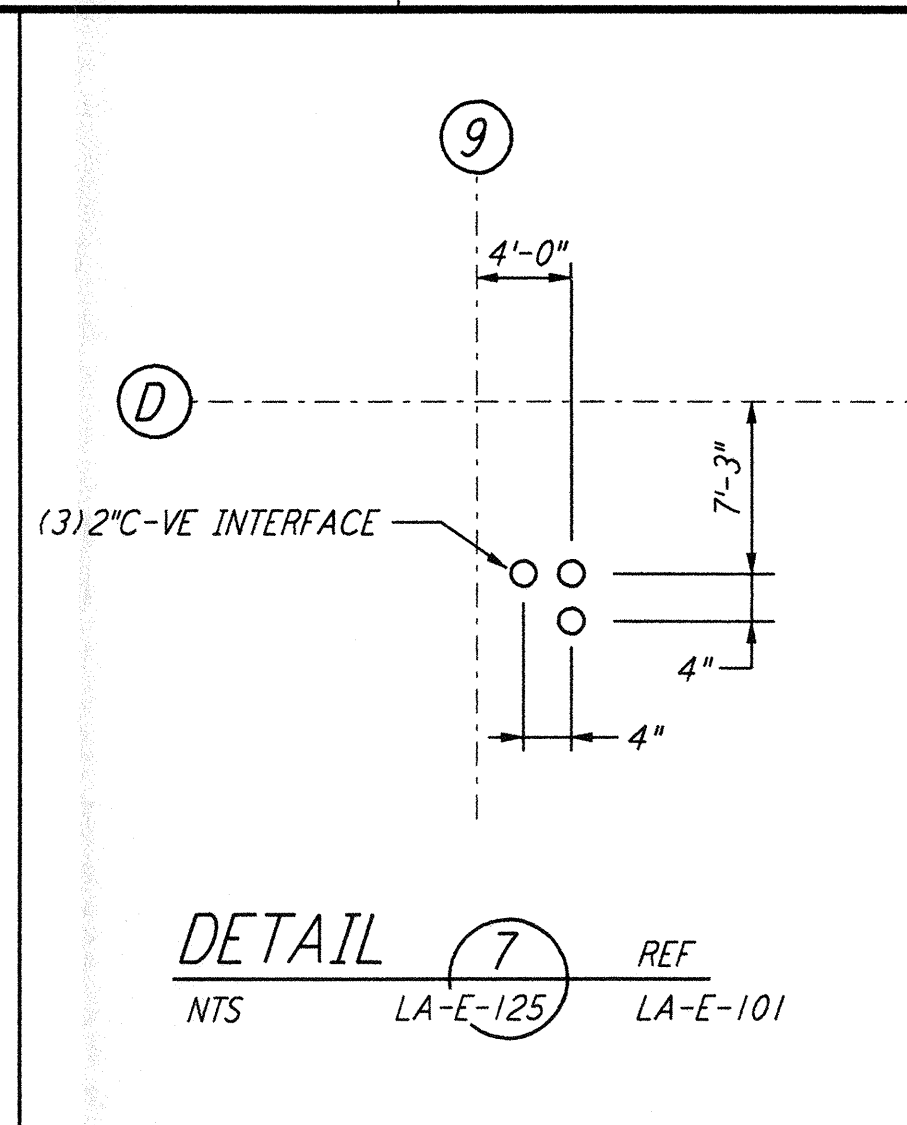


DETAIL 7 REF  
 NTS LA-E-125 LA-E-101

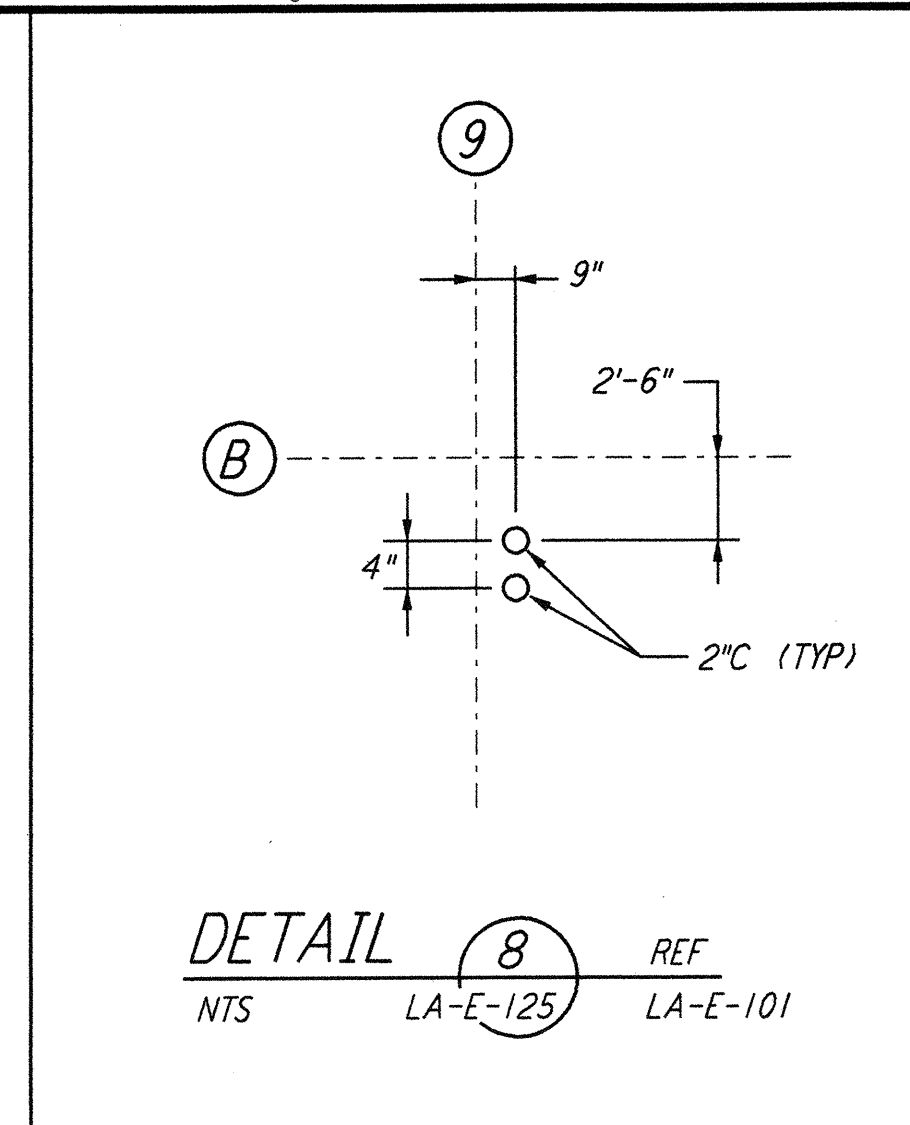


DETAIL 8 REF  
 NTS LA-E-125 LA-E-101

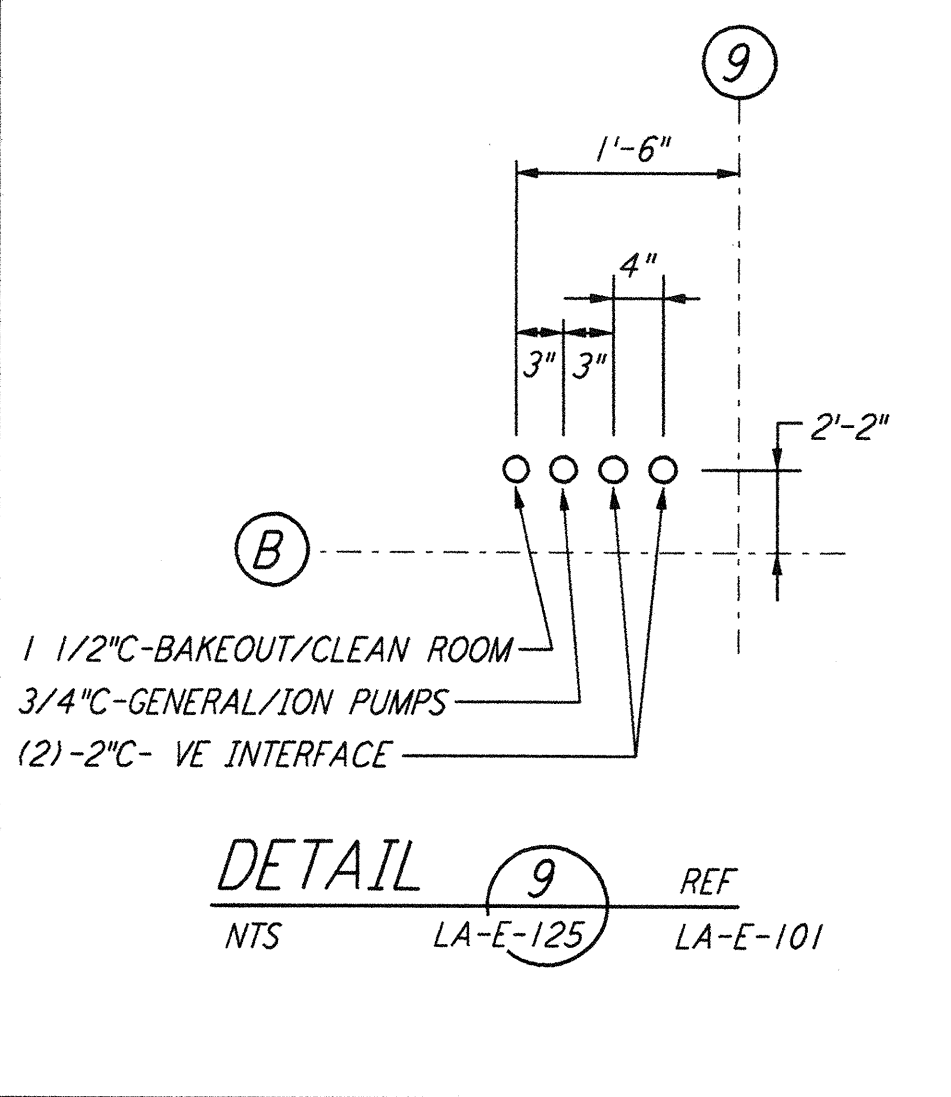


DETAIL 9 REF  
 NTS LA-E-125 LA-E-101

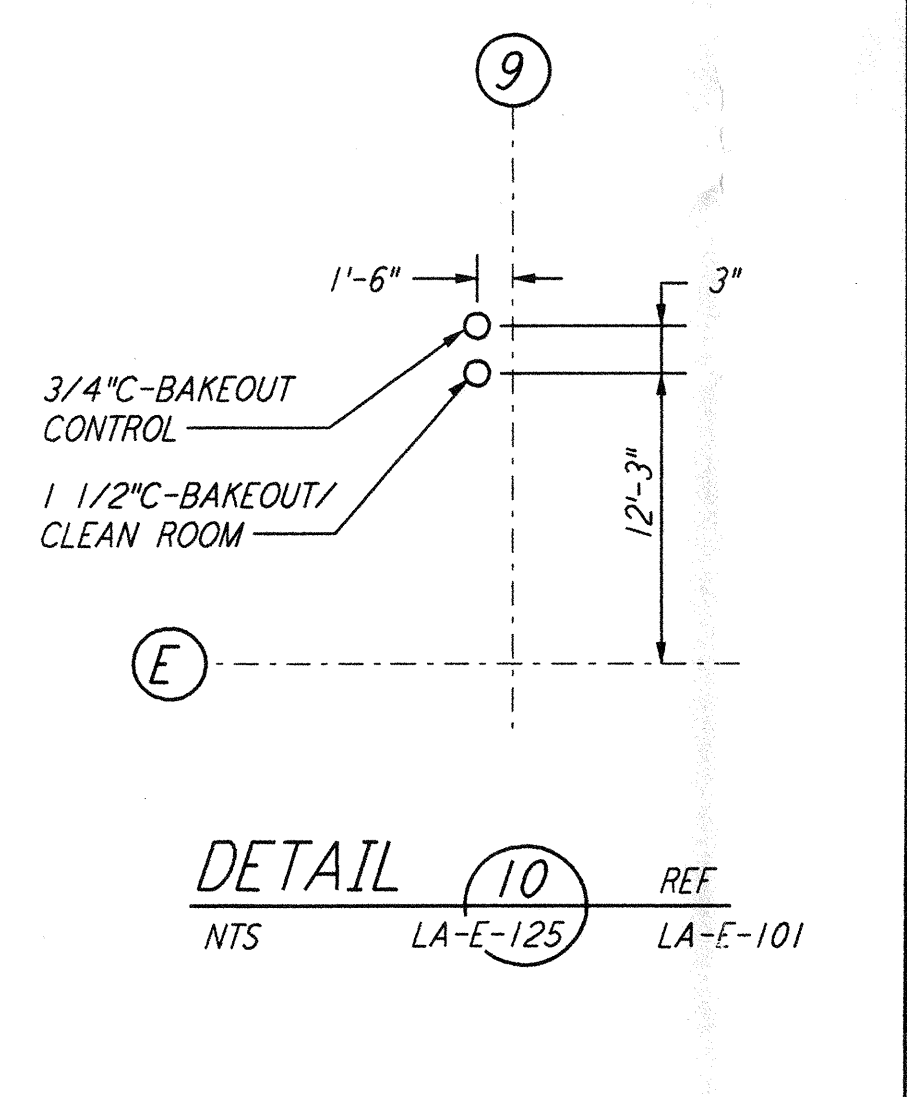


DETAIL 10 REF  
 NTS LA-E-125 LA-E-101

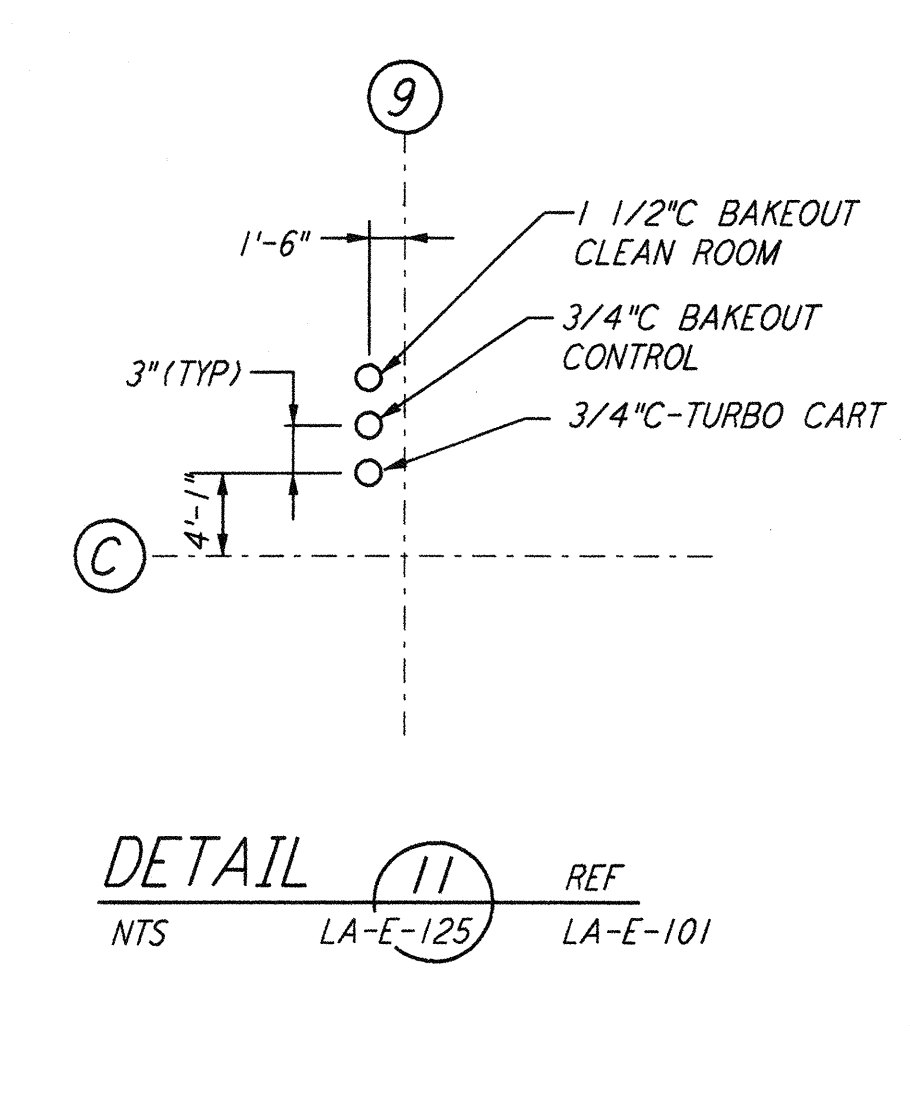


DETAIL 11 REF  
 NTS LA-E-125 LA-E-101

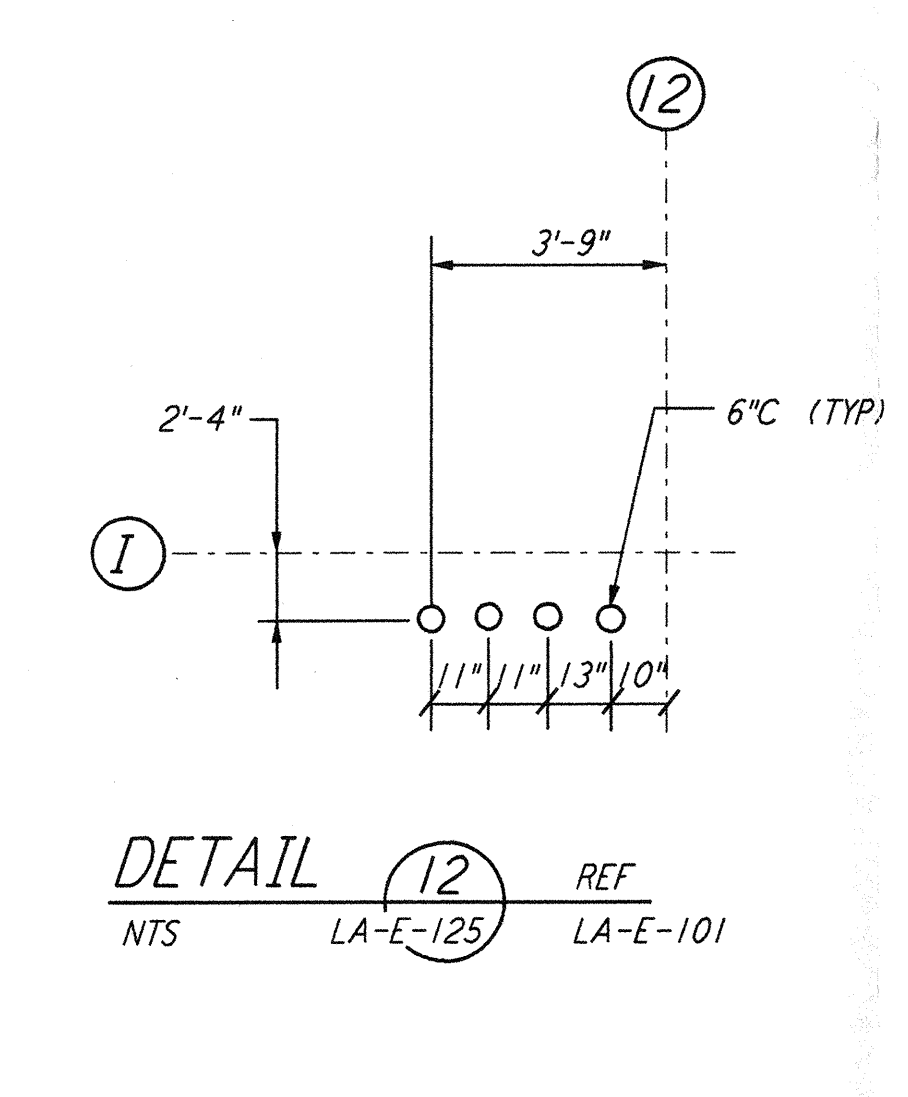


DETAIL 12 REF  
 NTS LA-E-125 LA-E-101

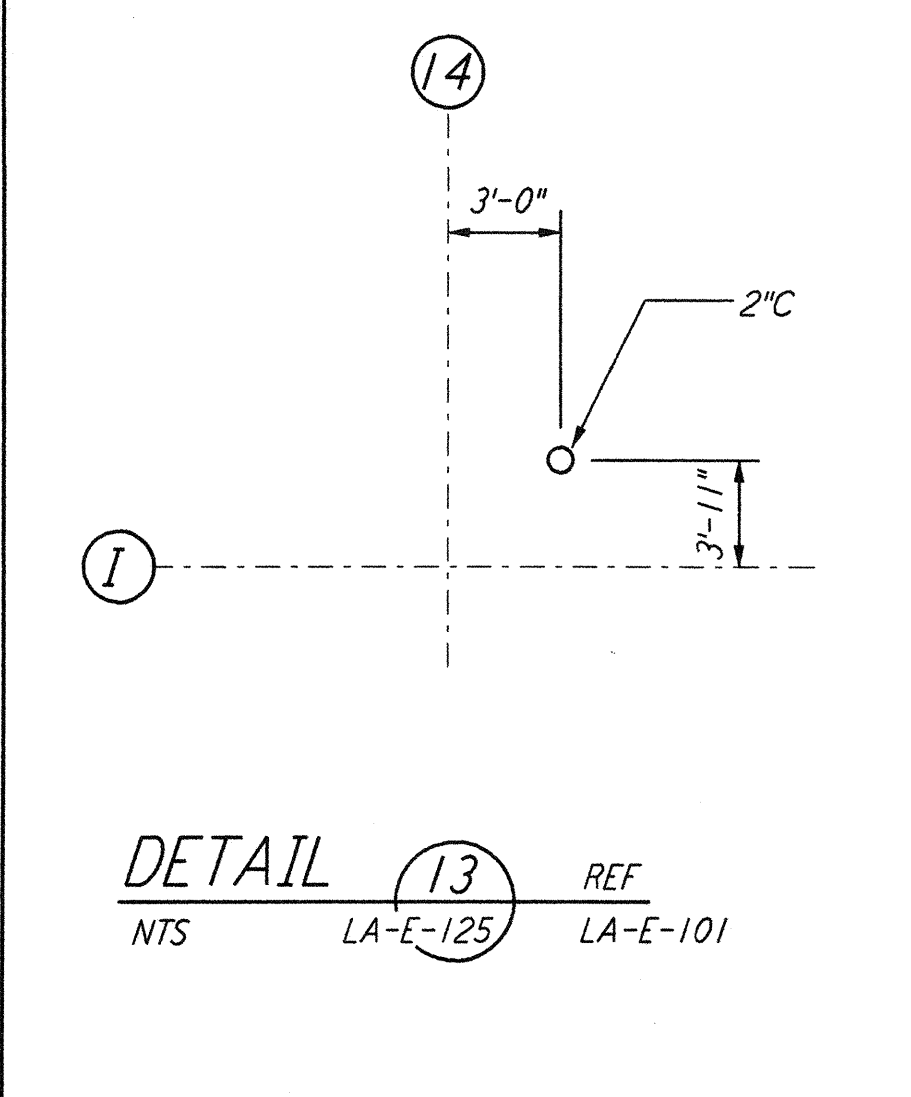


DETAIL 13 REF  
 NTS LA-E-125 LA-E-101

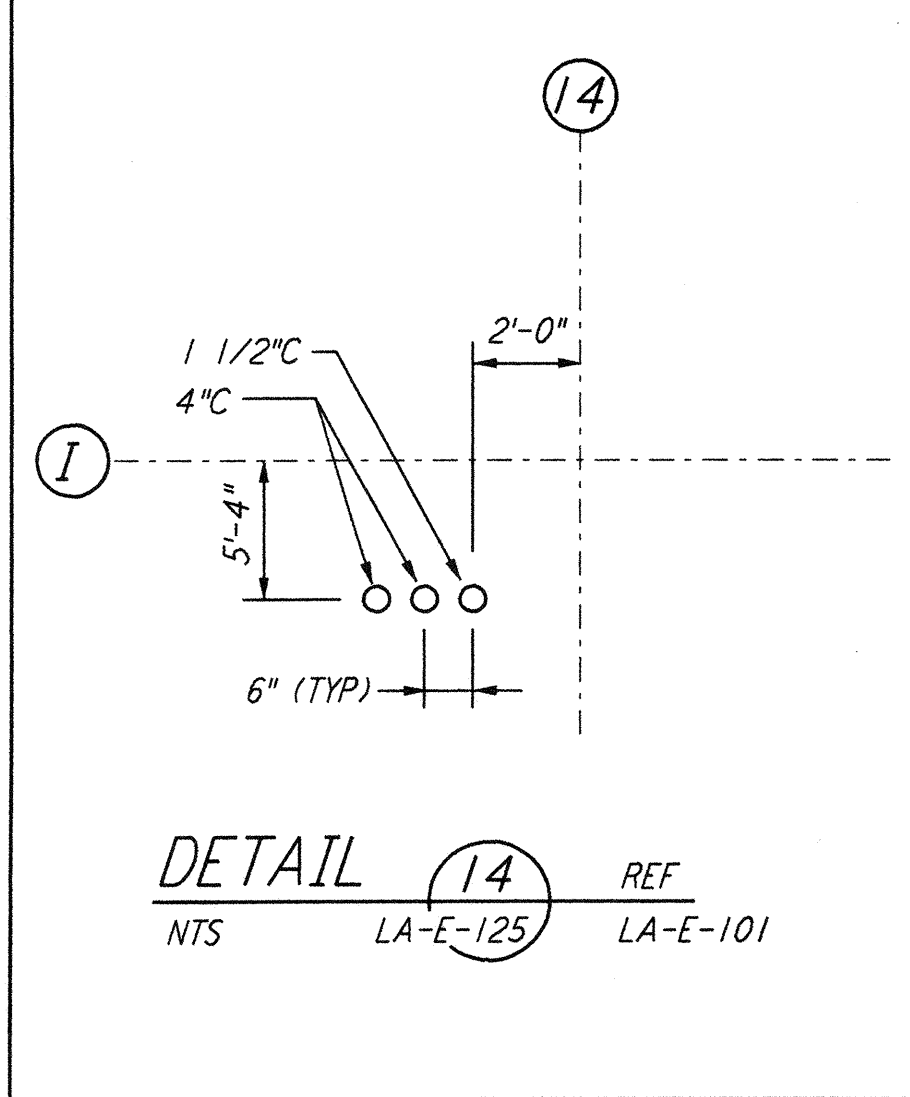


DETAIL 14 REF  
 NTS LA-E-125 LA-E-101

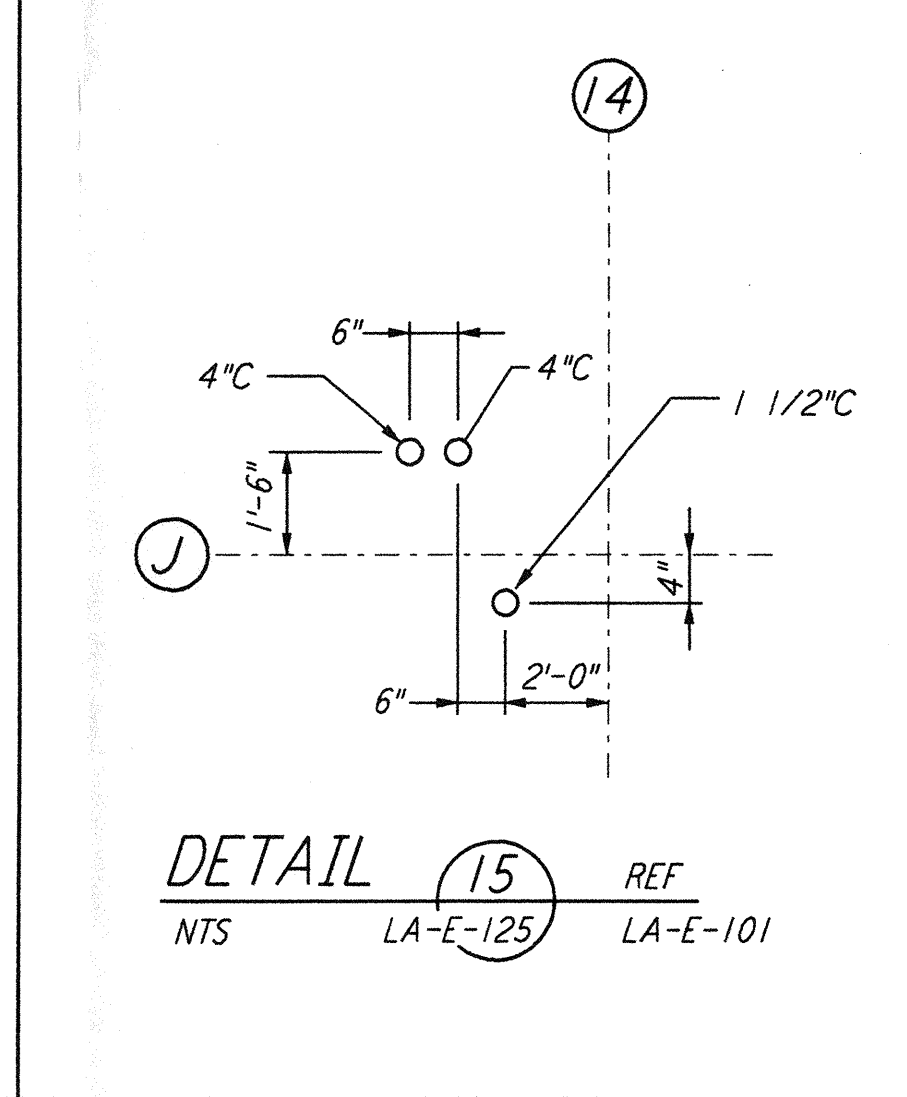


DETAIL 15 REF  
 NTS LA-E-125 LA-E-101

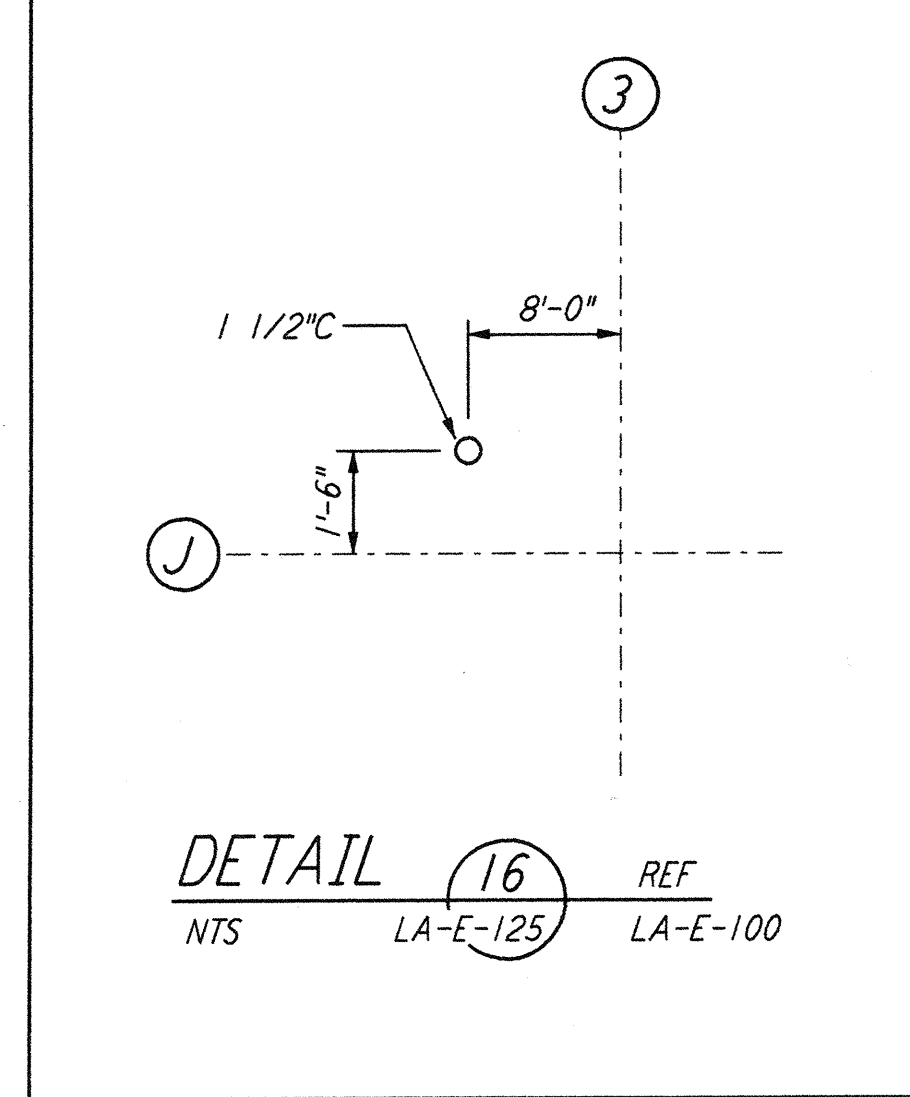


DETAIL 16 REF  
 NTS LA-E-125 LA-E-100

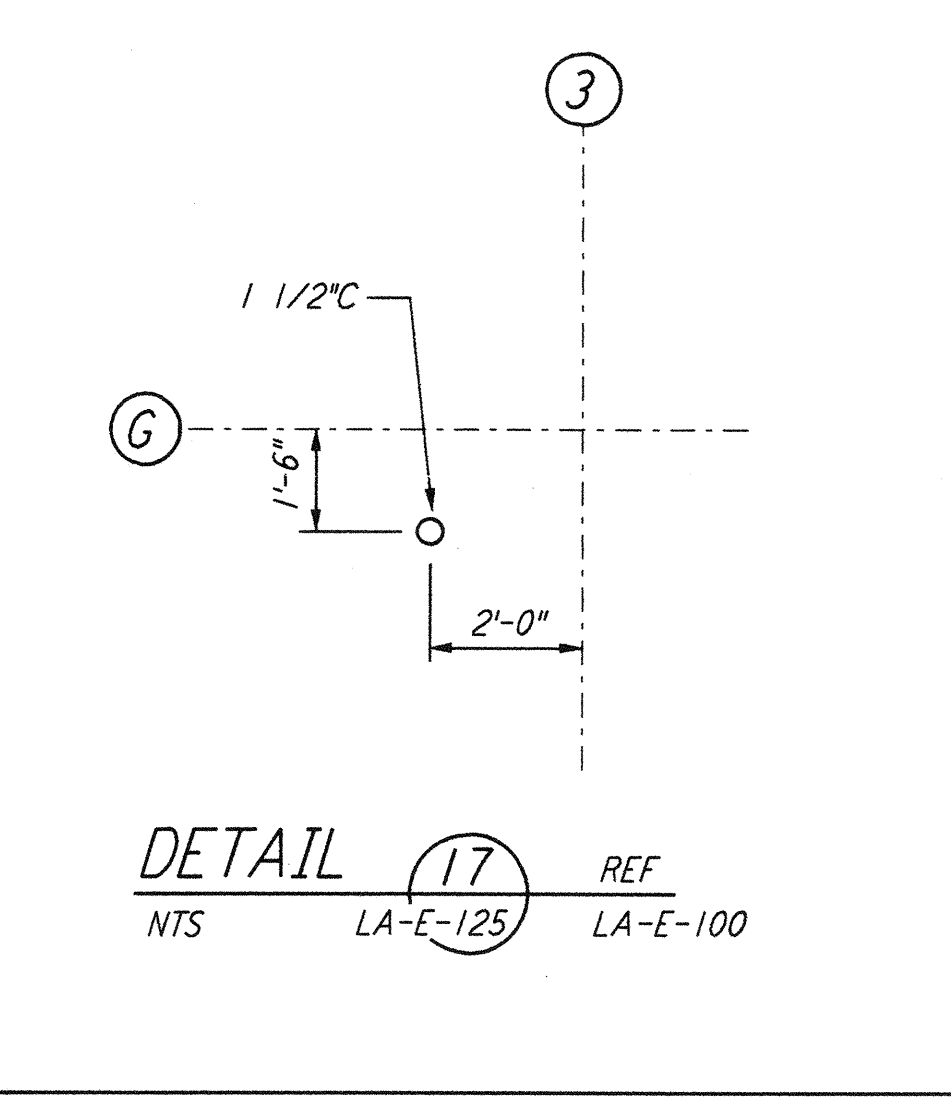


DETAIL 17 REF  
 NTS LA-E-125 LA-E-100

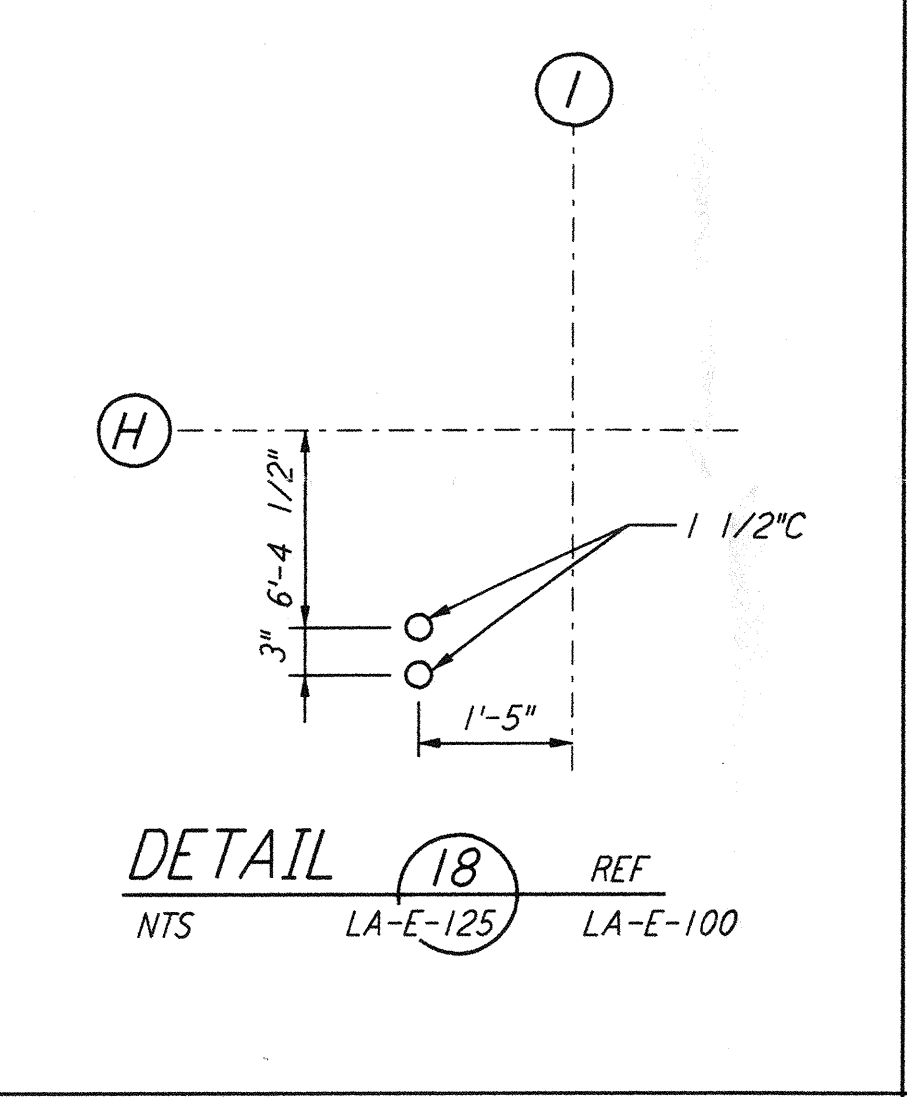


DETAIL 18 REF  
 NTS LA-E-125 LA-E-100

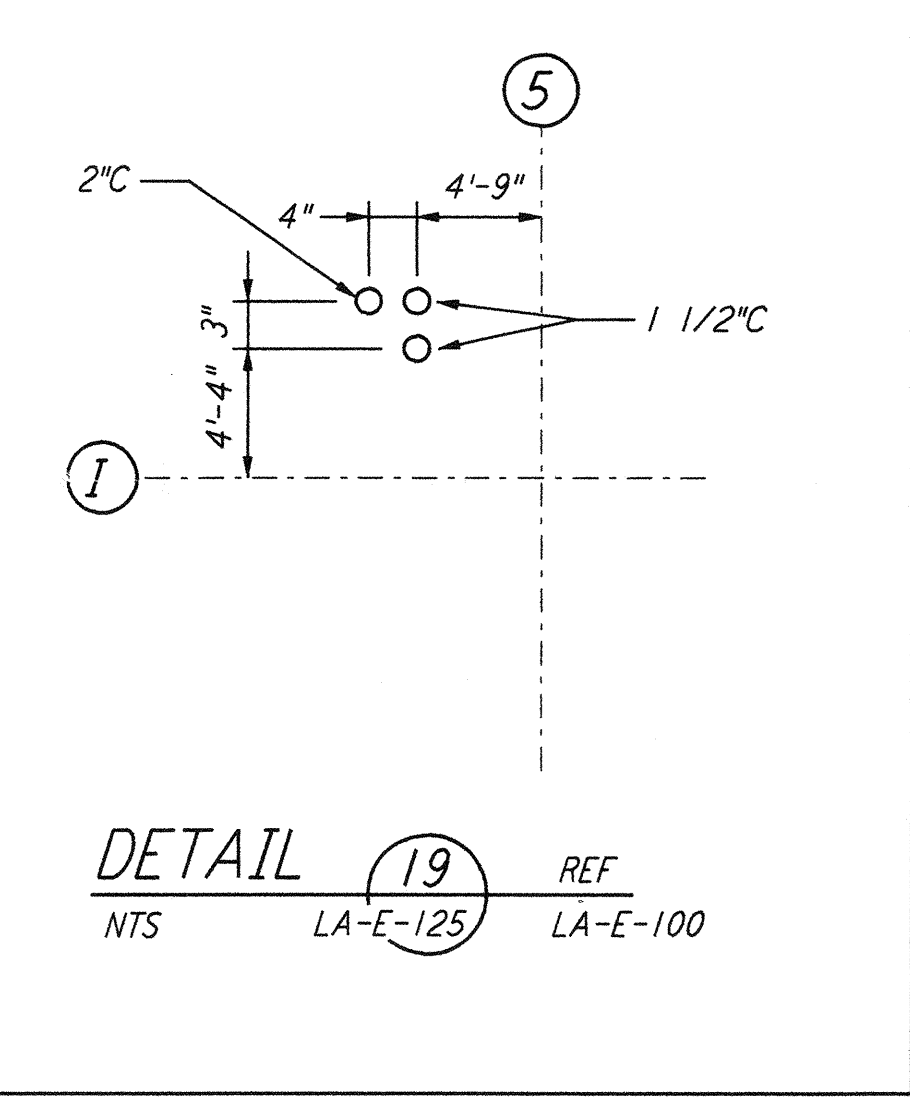


DETAIL 19 REF  
 NTS LA-E-125 LA-E-100

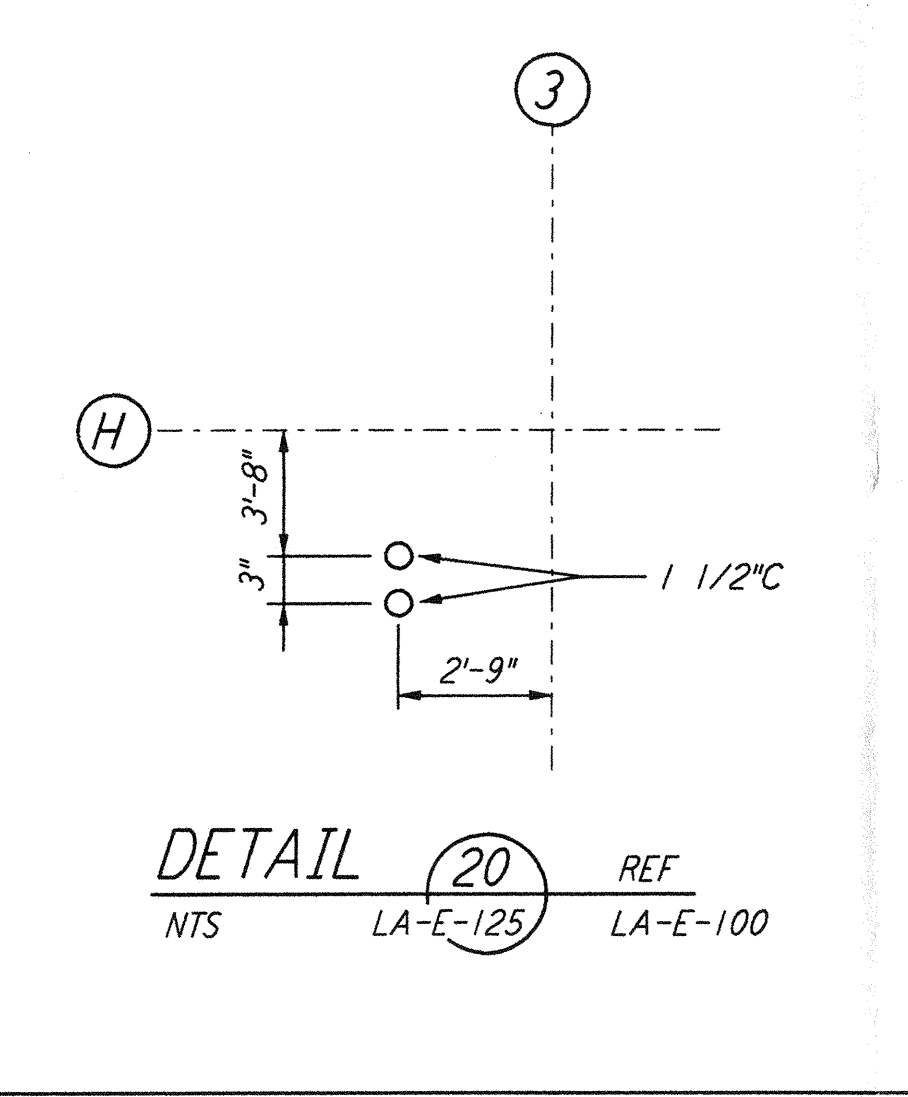


DETAIL 20 REF  
 NTS LA-E-125 LA-E-100

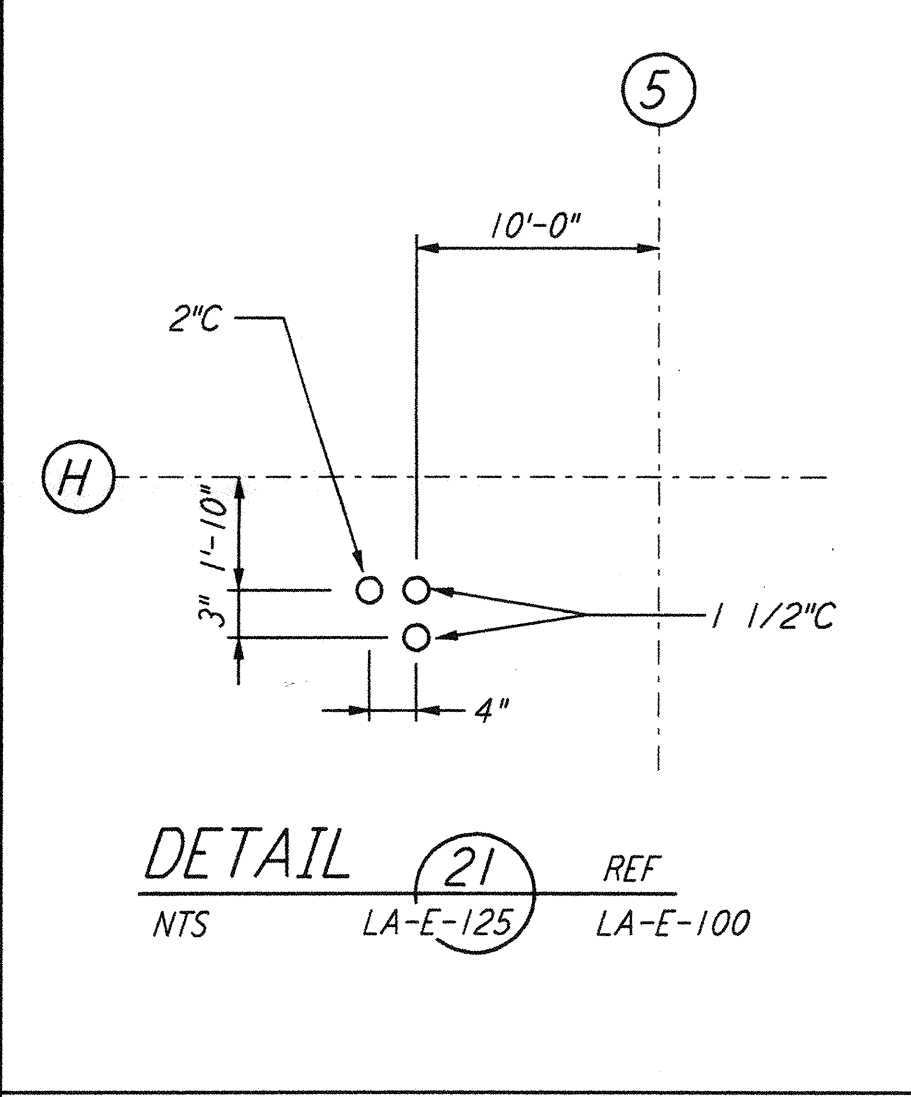


DETAIL 21 REF  
 NTS LA-E-125 LA-E-100

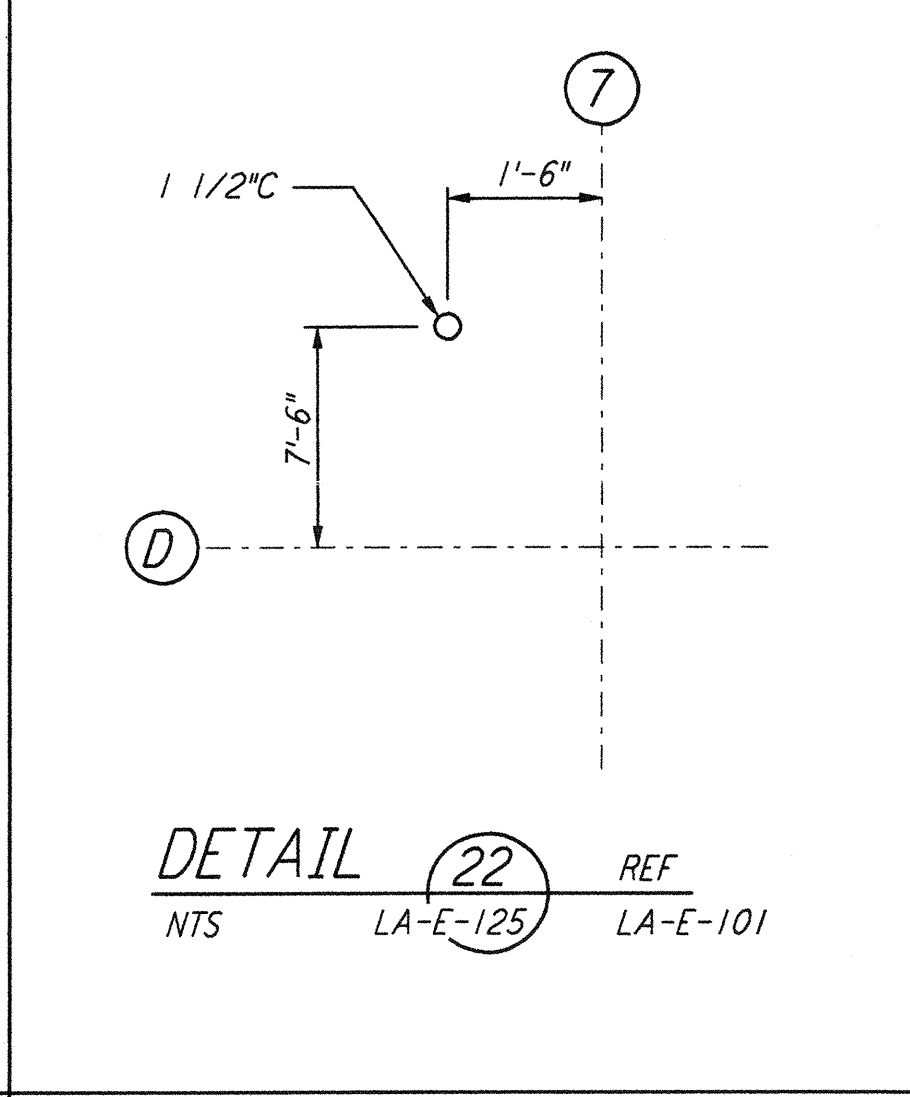


DETAIL 22 REF  
 NTS LA-E-125 LA-E-101

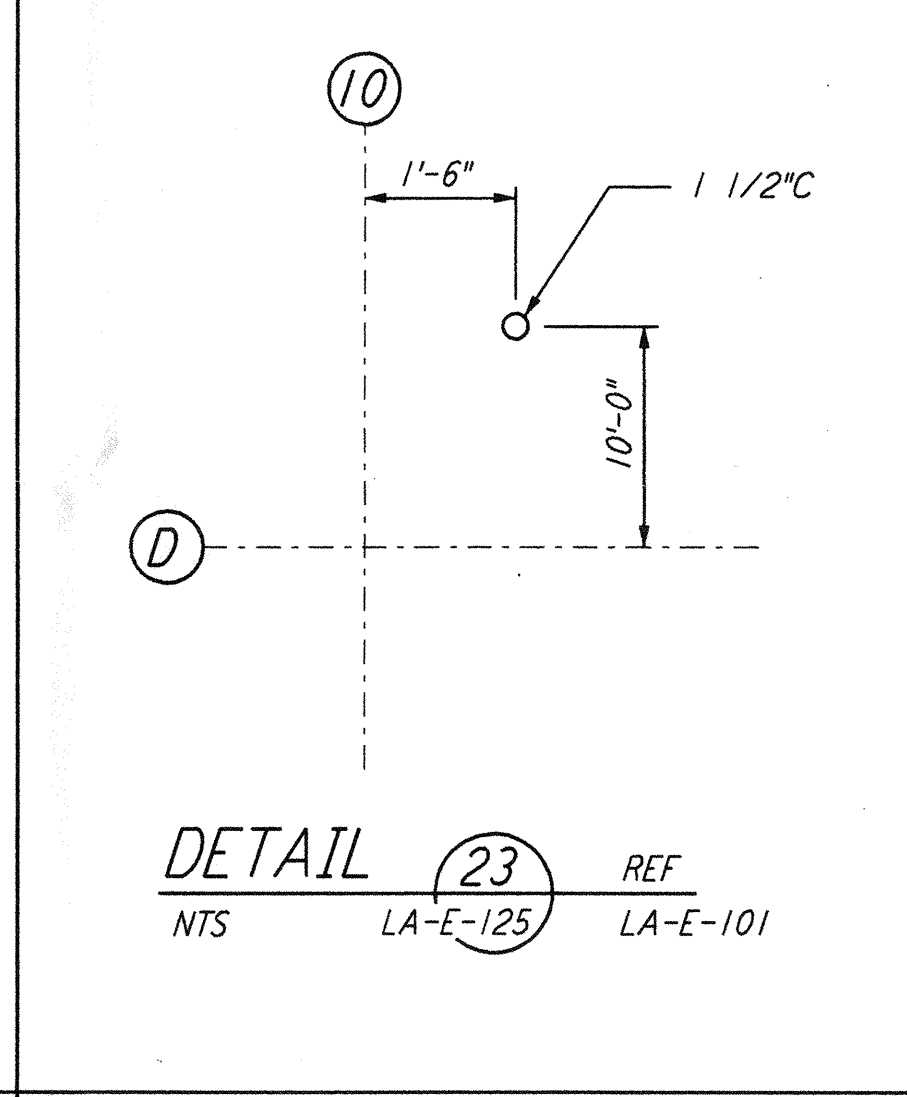


DETAIL 23 REF  
 NTS LA-E-125 LA-E-101

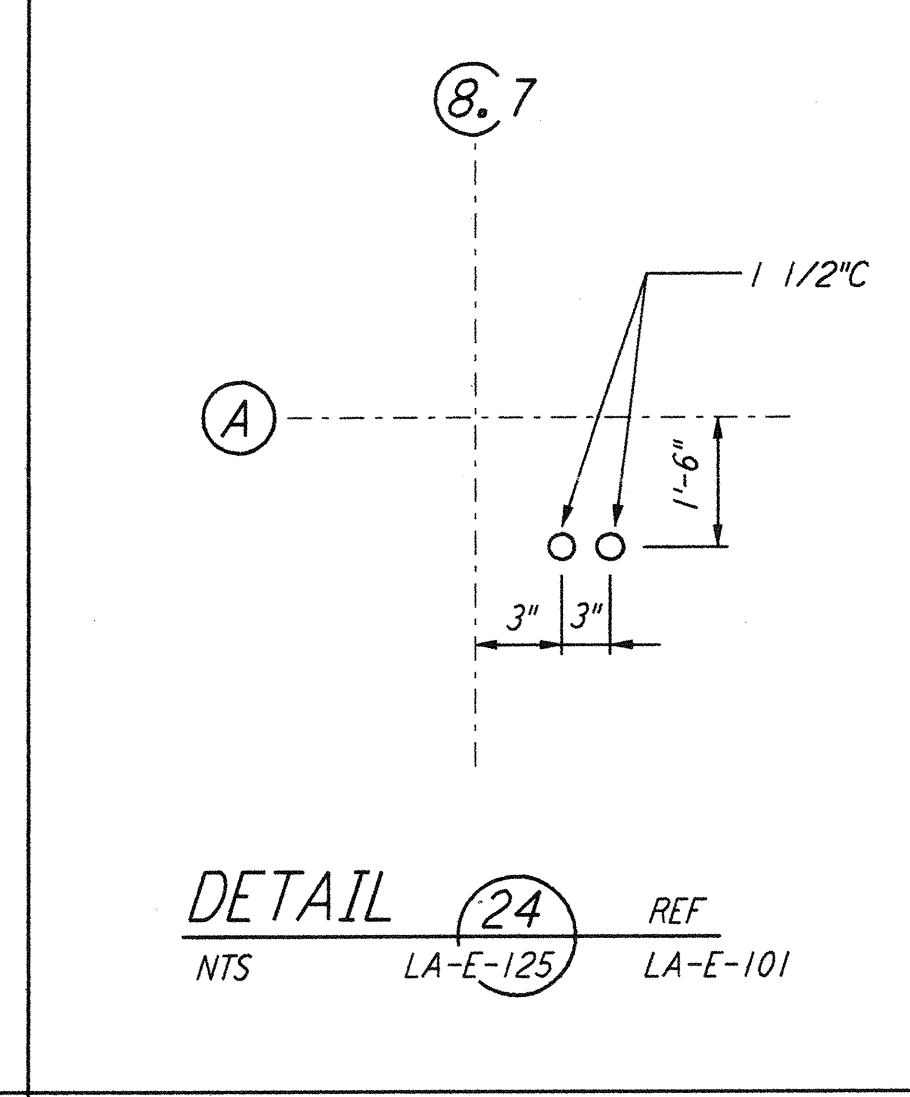


DETAIL 24 REF  
 NTS LA-E-125 LA-E-101

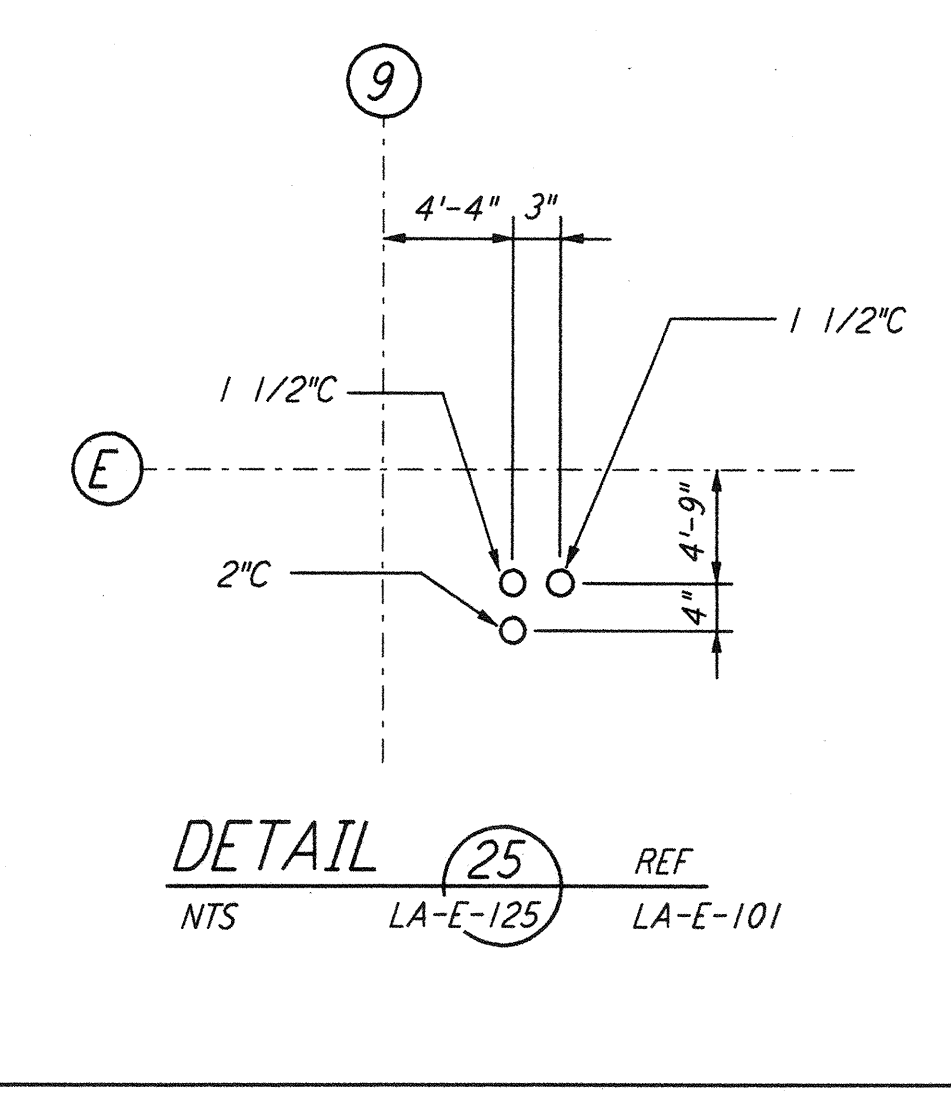

DETAIL 25 REF  
 NTS LA-E-125 LA-E-101

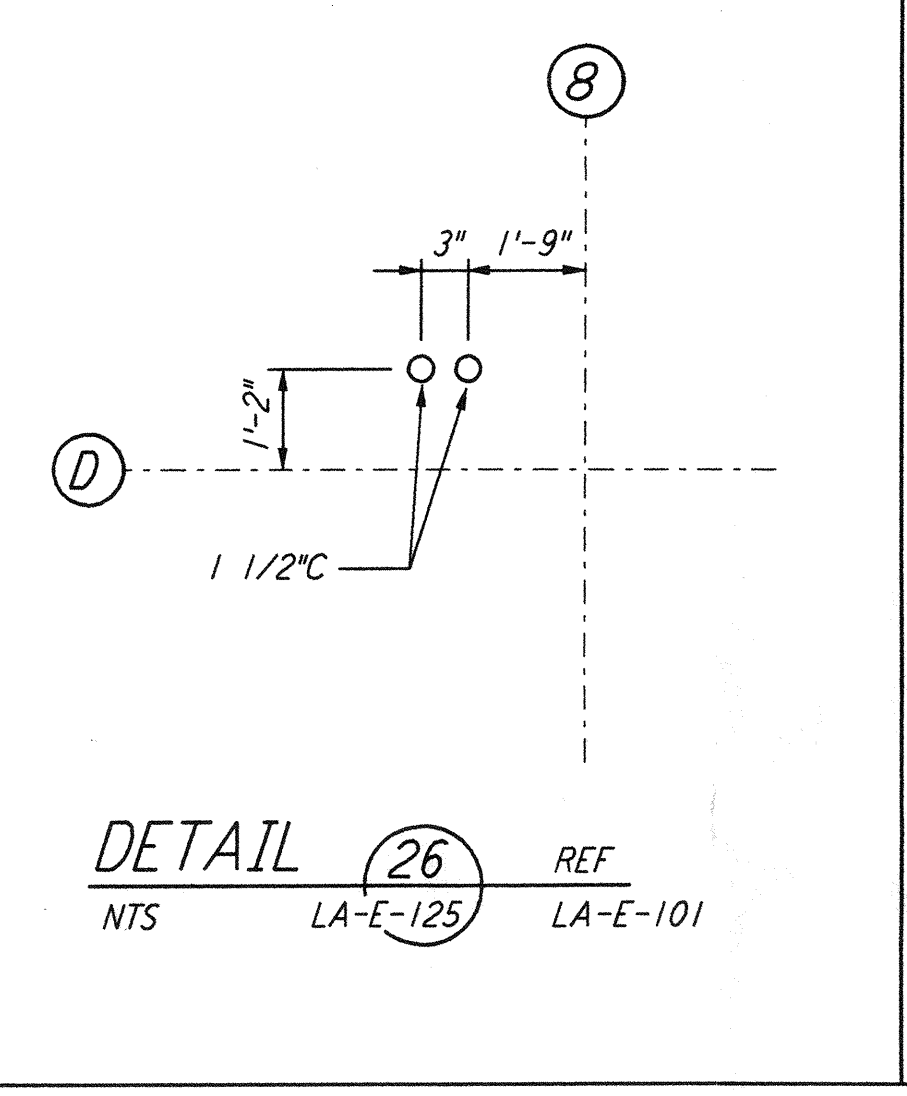

DETAIL 26 REF  
 NTS LA-E-125 LA-E-101

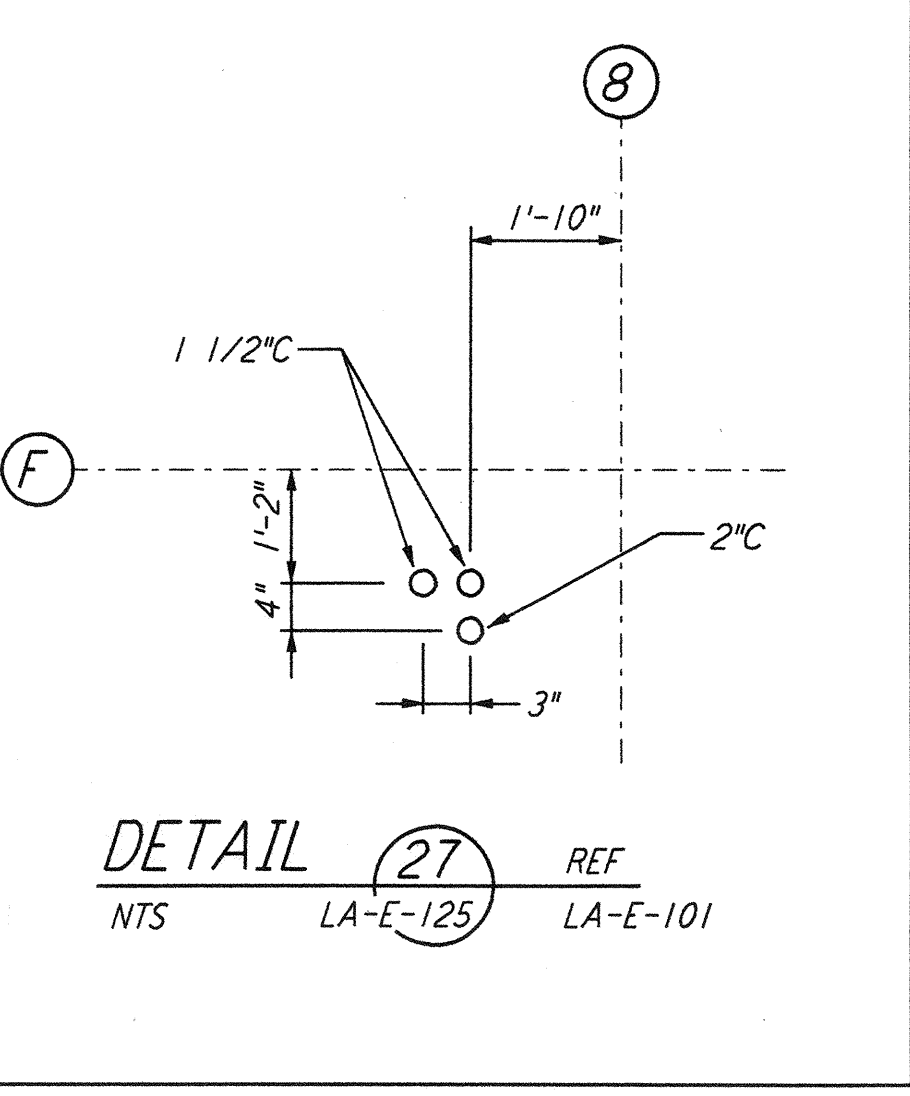

DETAIL 27 REF  
 NTS LA-E-125 LA-E-101

NOTE: THE DETAILS ON SHEETS LA-E-123, LA-E-124 AND LA-E-125 SUPERSEDE, ENTIRELY THE DETAILS ON SHEET LA-E-114

NO.	DATE	BY	CHKD	ENGR	PROJ	DESCRIPTION
3	8-7-98	JE	AK	MS	WLD	ISSUED FOR AS-BUILT
2	4-21-97	J.G.	KR	KR	T.D.M.	REVISED FOR CDS AND VAC. EQUIP.
1	4-4-97	J.G.	KR	KR	TDM	GENERAL REVISIONS

ISSUED FOR CONSTRUCTION  
 DRAWN J.G. 3-21-97  
 CHECKED B.K. 3-21-97  
 ENGINEER K.C.R. 3-21-97  
 PROJ T.D.M. 3-21-97

**AS-BUILT DRAWINGS**



LIGO-D961481-03-0		
LASER INTERFEROMETER GRAVITATIONAL-WAVE OBSERVATORY SITE NO. 2 - LIVINGSTON, LOUISIANA		
TITLE	SCALE	CONTRACT NUMBER
ELECTRICAL CORNER STATION LVEA AREAS 101, 102, 103, 104 DETAILS	NONE	PP150969
SHEET NUMBER	PROJECT NUMBER	REVISIONS
LA-E-125	8094	3

Plot Date: 12/14/1998 14:11:52 1998 CAPTION: BIEAS-V-9802.DWG 52085 K:\V9802\m125.dwg