
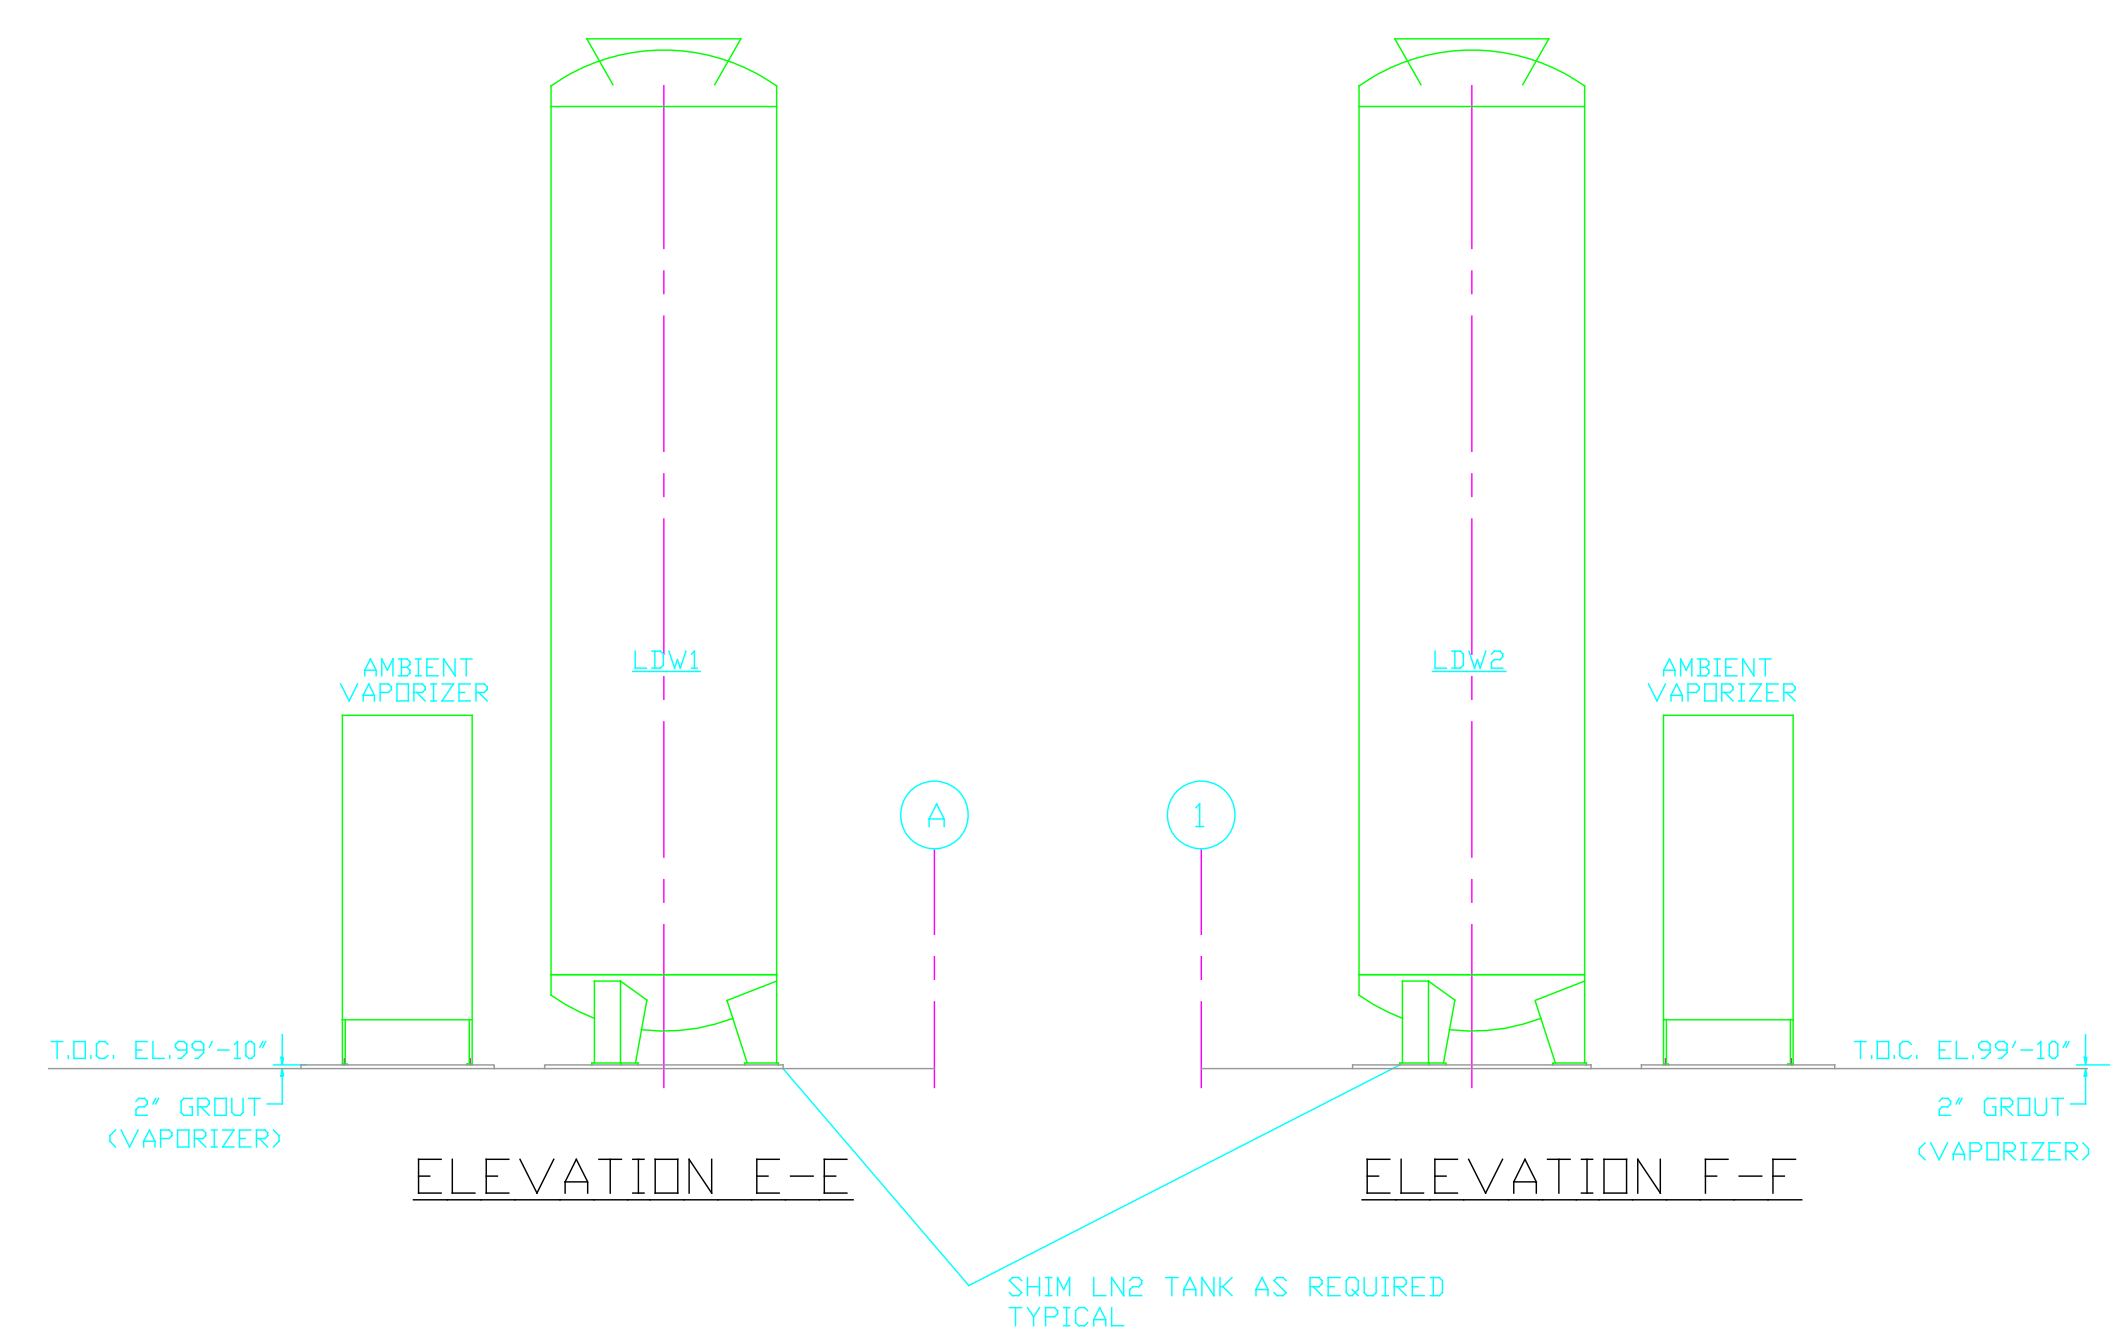
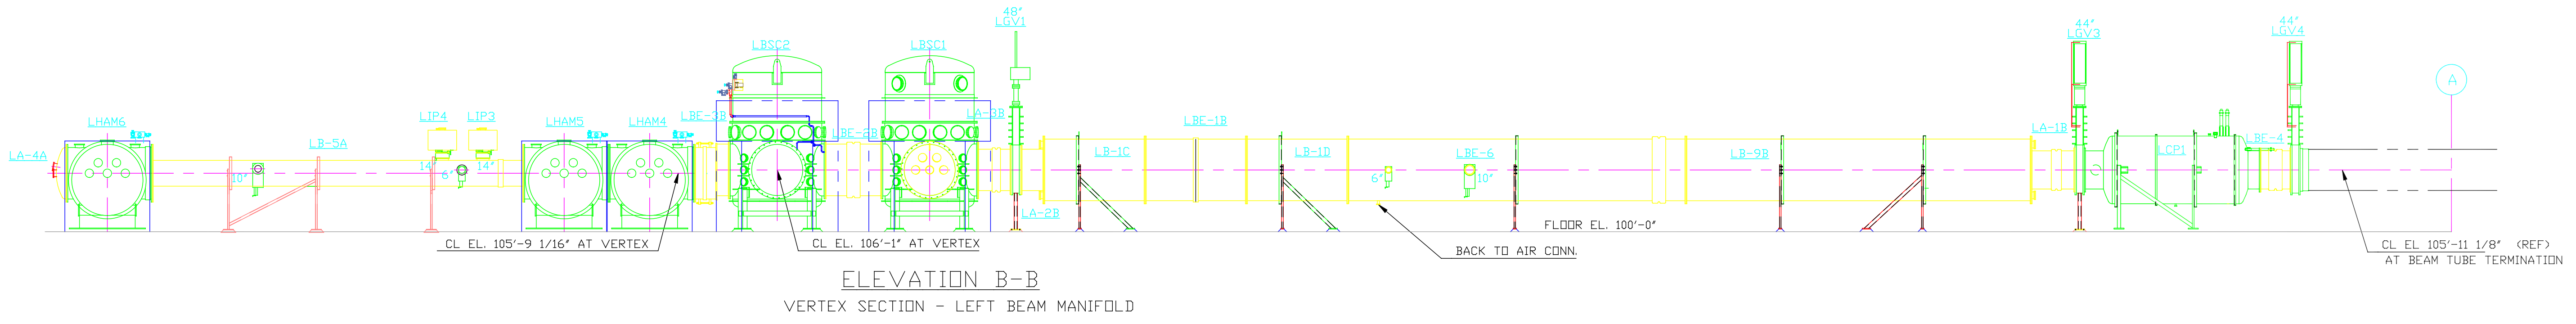



DWG. NO.	DESCRIPTION	DWG. NO.	DESCRIPTION
V049-0-004	INSTALLATION DOCUMENT LIST	V049-0-004	INSTALLATION DOCUMENT LIST
V049-5-040	PIPING ARRANGEMENT PLAN - CORNER STATION	V049-5-040	PIPING ARRANGEMENT PLAN - CORNER STATION
V049-2-025	SPEC. FOR INSTALLATION & COMMISSIONING	V049-2-025	SPEC. FOR INSTALLATION & COMMISSIONING
V049-0-001	P & ID LIGD VACUUM EQUIPMENT	V049-0-001	P & ID LIGD VACUUM EQUIPMENT
LA-A-101	PARSONS ARCHITECTURAL CORNER STATION LVEA FLOOR PLAN	LA-A-101	PARSONS ARCHITECTURAL CORNER STATION LVEA FLOOR PLAN
V049-5-034	OVERALL FLANGE ARRANGEMENT - CORNER STATION	1101100	LIGD VACUUM EQUIPMENT CORNER STATION

REV	DESCRIPTION	DATE	BY	CHKD	DRWN	DATE	DED#
4	AS BUILT	01/08/99	CS			0640	
3	REISSUED FOR CONSTRUCTION AS NOTED	05/27/98	RDC	REC	LD	0616	
2	ISSUED FOR CONSTRUCTION	1/26/98	RDC	REC	RM	0592	
1	ISSUED FOR FDR UPDATE/CONSTRUCTION	12/02/97	RDC	REC	LD	0498	
0	ISSUED FOR FDR	11.9.97	SM	DMW	RDC	REC	RM
P1	PRELIMINARY DESIGN UPDATE	9.21.95			RM		

SCALE	SIZE	DWG. NO.	SHEET
1"=10'	J	V049-5-003	1 OF 2

Feb 04, 1999 - 151440

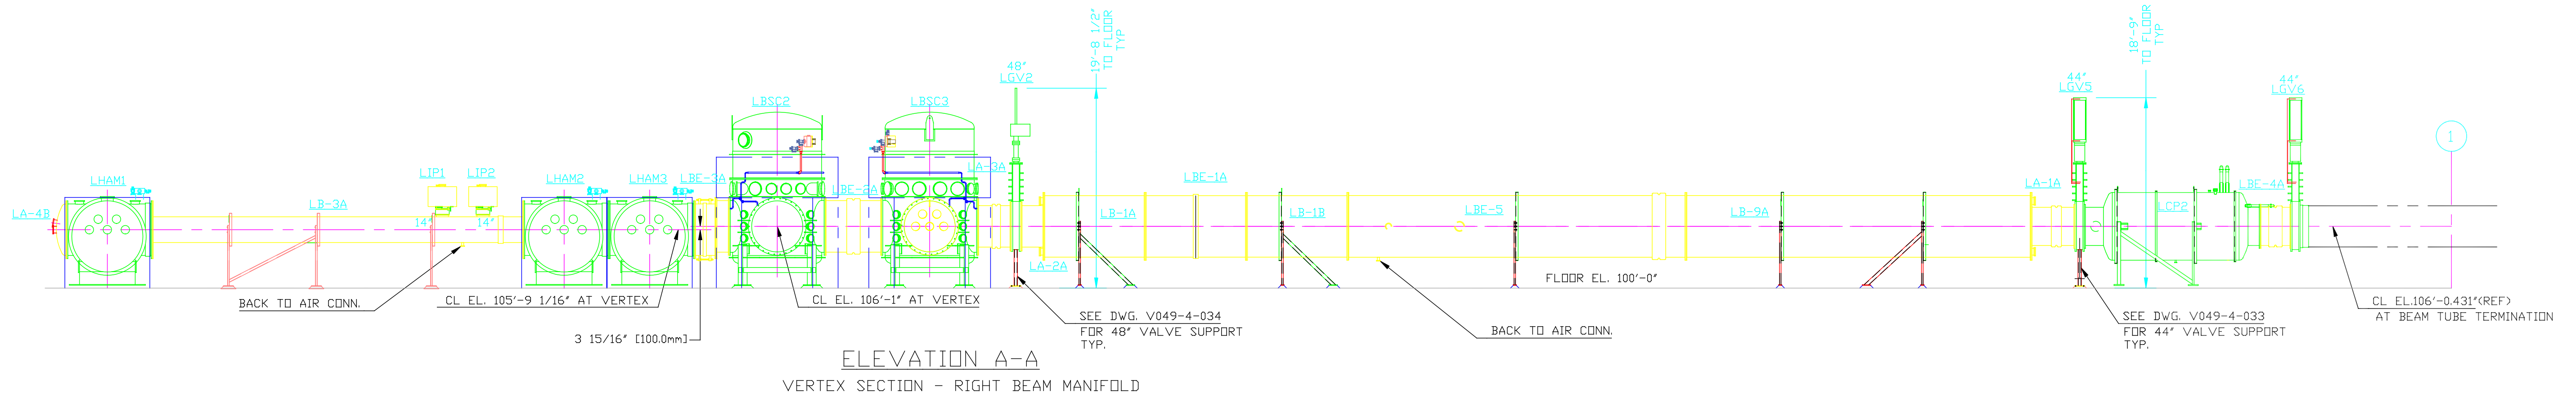

 <b>PROCESS SYSTEMS INTERNATIONAL INC.</b> 20 WALKUP DR. WESTBOROUGH, MASSACHUSETTS 01581 USA			
<b>EQUIPMENT ARRANGEMENT</b> ELEVATION AREA 600 CORNER STATION LOUISIANA LIGO VACUUM EQUIPMENT			
CAD FILE V0495003/5003S2	SIZE D	DWG. NO. V049-5-003	REV. 4
SCALE 1/8" = 1'-0"	SHEET 2 OF 2		

8      7      6      5      4      3      2      1

May 27, 1998 - 10:20:51