

INITIATOR E.P.

DATE July 7, 98

L190-E980633-00-D

ENGINEERING CHANGE REQUEST (ECR)

NEXT ASSEMBLY NO. 972501

CUSTOMER DRAWING NO. 972701

DRAWING TITLE ~~972~~ HAM stack Assy.

REVISION: FROM ~~Rev a~~ TO ~~Rev b~~
Rev a Rev b



HYTEC
INCORPORATED

DESCRIPTION OF CHANGE (Simple Phrase. Identify Dimensions if Possible):

item (3) change from D972715-1 to D972715-3
Leg screw #2

REASONS FOR CHANGE:

incorrect callout


IDENTIFY OTHER PARTS/GROUPS THAT INTERFACE WITH THE ABOVE (Required):

INTERFACE	RESPONSIBLE PARTY	INITIAL
leg elements	E. Ponslet	
optical table	E. Ponslet / T. Thompson	TE
spring	E. Ponslet	

NOTIFY COGNIZANT DESIGNER: R. SMITH

NOTIFY COGNIZANT ENGINEER: E. PONSLET

APPROVED:

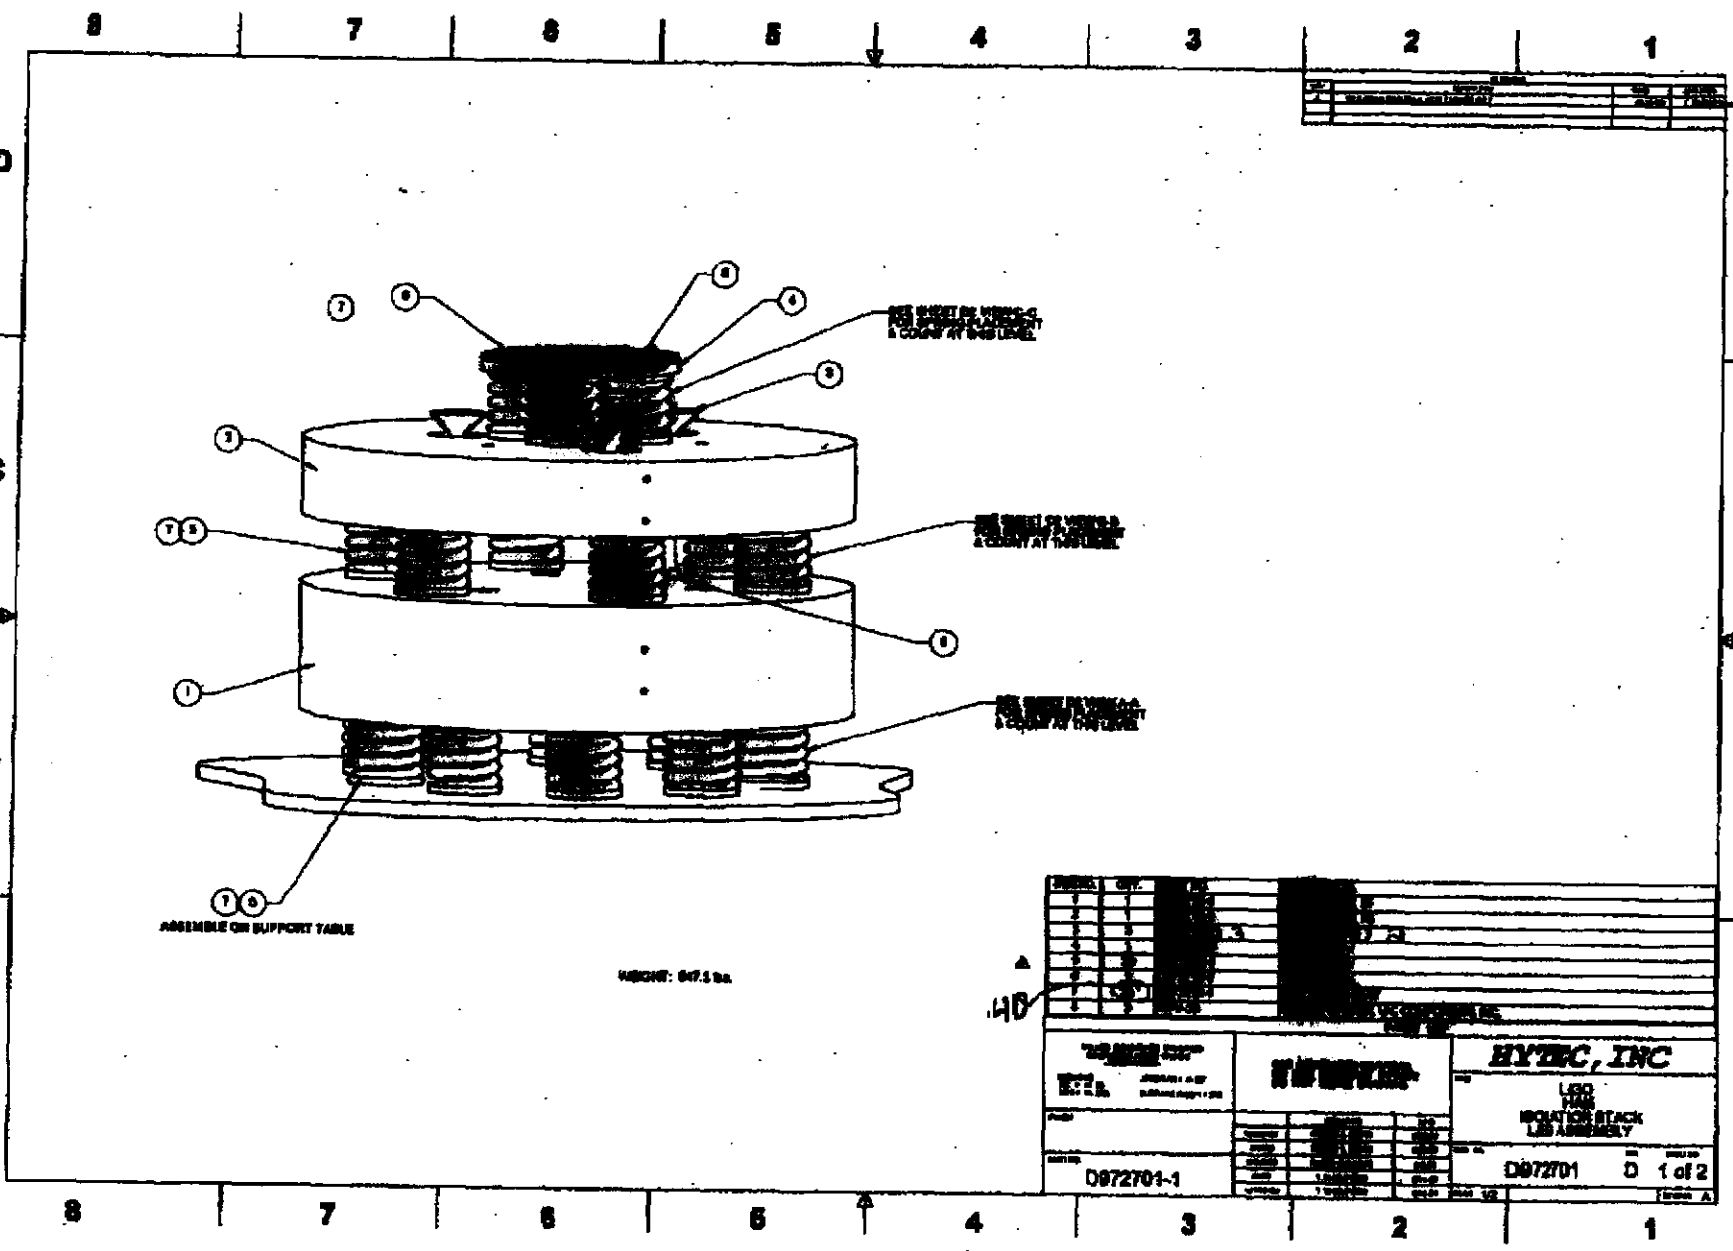

REV	DATE	BY	APP

PART NO. 0972701-1 QTY 1 UNIT PRICE \$ 100.00 TOTAL \$ 100.00		HYTEC, INC 100 ISOLATION STACK LAB ASSEMBLY	
DATE 08/27/01 BY [Signature]		D 1 of 2 FROM A	