



## WBSC8 As Built

AUTHOR(S)	DATE	Document Change Notice, Release or Approval
Jason Oberling, Doug Cook, Dennis Coyne, Eric James	11 June 2014	see LIGO DCC record Status

Instructions on the use of this document:

- 1) Use, and complete, this document on a computer while the work is proceeding. When operating in a cleanroom, use a cleanroom compatible computer. This procedure must be available at all times during the alignment process. In addition, all of the applicable documents must also be available for reference during the procedure from the laptop computer.
- 2) Use this alignment procedure as a check list for preparation and during the alignment; As each step is completed, enter the name of the person completing the work (or approving or checking the step), as well as the date and any comments or notes. In particular, note any discrepancies or deviations and augment with any missing definition. **ALL NOTES MUST BE RECORDED IN THE COMPLETED VERSION OF THIS DOCUMENT (NOT IN OTHER NOTEBOOKS OR FILES)**. If the additional notes are too cumbersome to include within the body of this completed procedure, then electronically attach them to the completed procedure.
- 3) Once completed, file the document in the LIGO Document Control Center (DCC) as the next highest version of the procedure and add a note that this is a completed/finished procedure.
- 4) File any significant notes or data from the completed procedure in the electronic logbook (such as any deviations); as a minimum note in the electronic logbook that the alignment was completed in accordance with this procedure (cite document number and revision).



## WBSC8 As Built

### Contents

1	SCOPE .....	4
2	APPLICABLE DOCUMENTS.....	4
3	COORDINATE SYSTEMS/REFERENCES .....	5
3.1	BSC Chamber .....	5
3.2	Mechanical Test Stand .....	5
4	PREREQUISITES FOR CARTRIDGE ALIGNMENT .....	5
5	REQUIRED EQUIPMENT LIST .....	6
6	PROCEDURE FOR CARTRIDGE ASSEMBLY ALIGNMENT.....	6
6.1	Cartridge set-up.....	12
6.1.1	Check optics table level on the BSC mechanical test stand .....	12
6.1.2	Approximately align the Cartridge Assembly elements with the templates.....	12
6.2	H2 ITMy .....	12
6.2.1	Setup the ITM Retro-reflector Assembly .....	12
6.2.2	Setup Total Station and Laser Autocollimator .....	15
6.2.3	Set the ITM longitudinal position.....	15
6.2.4	Set the ITM horizontal position.....	15
6.2.5	Coarse Align the ITM Yaw .....	16
6.2.6	Iterate/re-Check .....	16
6.2.7	Check the ITM vertical position .....	17
6.2.8	Fine Align the ITM Yaw .....	17
6.2.9	Align the ITM pitch.....	18
6.2.10	Check the CP to ITMy Gap .....	18
6.3	FM.....	19
6.3.1	Setup the FM Retro-reflector Assembly.....	19
6.3.2	Set the Optical Square.....	19
6.3.3	Setup Total Station and Laser Autocollimator .....	19
6.3.4	Set the FM longitudinal position .....	20
6.3.5	Set the FM horizontal position.....	20
6.3.6	Coarse Align the FM Yaw .....	20
6.3.7	Iterate/re-Check .....	21
6.3.8	Check the FM vertical position.....	21
6.3.9	Fine Align the FM Yaw .....	22
6.3.10	Align the FM pitch.....	22
7	ALIGN THE CARTRIDGE ASSEMBLY IN THE BSC CHAMBER .....	23
7.1	Notes .....	23
7.2	Level the Optics Table .....	23
7.3	Setup the Total Station and Laser Autocollimator.....	23
7.4	Measure Axial Position Error of ITMy.....	24
7.5	Measure Lateral Position Error of ITMy .....	25
7.6	Measure Vertical Position Error of ITMy.....	26
7.7	Measure Pitch & Yaw Errors .....	26
7.8	Translate Cartridge with HEPI to Correct Axial, Lateral, Vertical and Yaw Errors .....	26
7.9	Correct Pitch Error .....	27



**WBSC8 As Built**

7.10	Fine Pitch & Yaw Error Correction .....	27
8	Align Arm Cavity Baffle (ACB) Assembly.....	28



## WBSC8 As Built

### 1 SCOPE

The scope of this procedure is alignment of the optical elements of the WBSC8 chamber, which includes alignment of the following optical elements:

- 1) H2 ITMy (part of the quad suspension assembly, [D0901346-v6](#))
- 2) FMy (part of the triple suspension assembly, [D1000392-v4](#))
- 3) Arm Cavity Baffle (ACB; [D0901376](#))
- 4) Elliptical Baffle ([D1000429](#))
- 5) Two FM Beam Dumps ([D0901058](#))

N.B.: For the initial WBSC8 installation the FMy optic will not be installed into the FM suspension; A dummy metal mass will be installed instead. As a consequence it is not necessary to align the elliptical baffle for this first installation. In addition the initial WBSC8 installation will be missing the ACB and FM Beam Dumps.

This procedure starts with the preliminary alignment of the optical payload elements of the WBSC8 chamber in the “cartridge assembly” and then proceeds to the alignment of these same optical payload elements within the WBSC8 chamber. The “cartridge assembly” is comprised of the BSC ISI system with all of the payload elements (which are capable of fitting onto the test stand) integrated onto the optics table and the stage 0 structure of the BSC-ISI. The cartridge assembly is integrated and aligned while on the BSC mechanical test stand. The cartridge is then lifted, flown to the chamber and lowered into position onto the BSC support tubes.

This procedure does not cover the procedures for installing assemblies onto the BSC-ISI platform or for balancing and leveling the BSC-ISI optics table; these procedures are defined in separate documentation.

### 2 APPLICABLE DOCUMENTS

Listed below are all of the applicable and referenced documents for the initial alignment procedures. This list gives the latest revisions of the documents; within the alignment steps, only the document number (and not the revision) is quoted.

Document No.	Document Title
<a href="#">E0900047</a>	LIGO Contamination Control Plan
<a href="#">T1000230</a>	AOS Initial Alignment Requirements Final Design Document
<a href="#">T080307</a>	Initial Alignment System Design Requirements Document
<a href="#">T1000445</a>	Flow Chart AOS/IAS H1 & L1 ITMy Alignment
<a href="#">D1002651</a>	IAS Layout for H2 FMy, ITMy
<a href="#">D1101259</a>	Rough Alignment Tool Layout, WBSC8
<a href="#">D1101050</a>	Template, Alignment, WBSC8
<a href="#">D1100291</a>	aLIGO IAS Monuments
<a href="#">T1100318</a>	Total Station modifications for stabilizing unit when Laser Autocollimator is Attached
<a href="#">D1100408</a>	Test Stand Layout for LHO LVEA



## WBSC8 As Built

<a href="#">D1101596</a>	Alignment Monument Layout, LHO Corner Station, BSC Mechanical Test Stands
<a href="#">T080230</a>	Quad Pendulum Structure Pushers
<a href="#">E0900357</a>	aLIGO BSC-ISI, General Assembly Procedure

### 3 COORDINATE SYSTEMS/REFERENCES

#### 3.1 BSC Chamber

The local BSC chamber coordinate system origin is the point where the horizontal, cylindrical axes of the main access portals meet. The local BSC chamber coordinate system axes are aligned to the local gravity vector. Z is vertical (+Z is up). X and Y are both horizontal and approximately aligned to the global coordinate axes (as defined in [T980044](#)). The local BSC chamber coordinate system origin is nominally located 65.421 in [1661.7 mm] below the BSC-ISI optics table surface.


#### 3.2 Mechanical Test Stand

The local mechanical test stand coordinate system origin is located 65.421 in [1661.7 mm] below the BSC-ISI optics table surface and centered between the row of mounting holes which interface to the BSC-ISI stage-0 structure (and represent the support tubes installed into the BSC chambers). The local mechanical test stand coordinate system axes are aligned to the local gravity vector. Z is vertical (+Z is up). X and Y are both horizontal and approximately aligned to the global coordinate axes.

### 4 PREREQUISITES FOR CARTRIDGE ALIGNMENT

- The BSC mechanical test stand must be set so that the interface plane with the BSC-ISI stage 0 is horizontal.
- The features of the BSC mechanical test stand which interface to the BSC-ISI platform shall be used to establish a centerline and two offset lines with alignment monuments/references in the floor, as depicted in the D1101596 (see also Figure 1).
- An appropriate clean room should be installed over the test stand. For this procedure we are using BSC Test Stand #2 (see figure)

## WBSC8 As Built

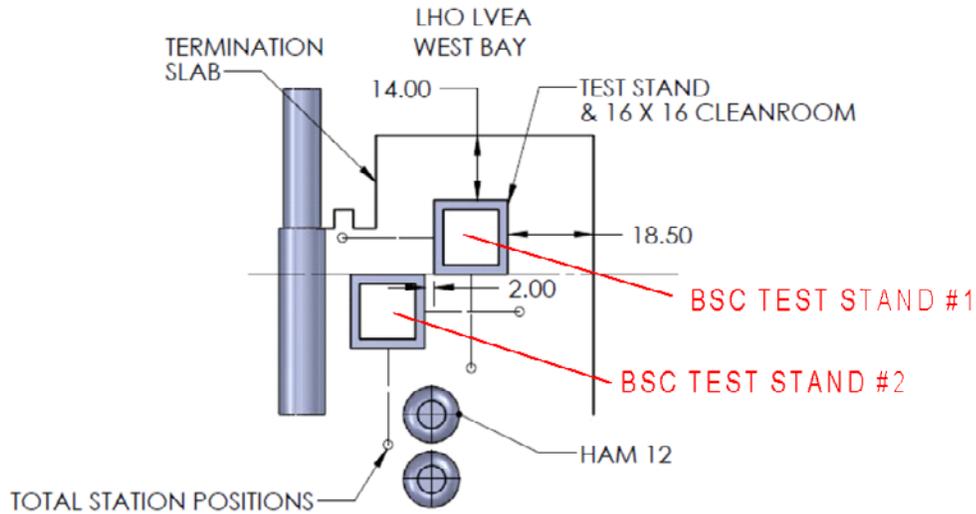

- All payload assemblies must be acceptance tested (to the extent possible and planned) prior to integration into the cartridge assembly.
- The ITMy and FMy suspensions must be capable of being electronically damped while on the test stand and later when in the chamber.
- All IAS operations on the cartridge assembly are to be made with the BSC ISI in its locked mode. Verify that the ISI is locked.

### 5 REQUIRED EQUIPMENT LIST

- Total station (either a Sokkia Set2BII or a Sokkia SetX1 modified per [T1100318](#)) with tripod stand
- Laser autocollimator (Newport LDS Vector and LDS1000 controller)
- Optical level (Sokkia B2o AutoLevel with micrometer option, or equivalent) with tripod stand
- Precision bubble level
- Optical Transit Square (Brunson model 75-H) with stand
- Mechanical locating templates for ITM and FMY suspensions ([D1101050](#) -1 through -4, cleaned to Class B per [E0900047](#) and E960022)
- Precision pushers ([D060052](#), cleaned to Class B per [E0900047](#) and [E960022](#))
- Retro reflector assembly ([D1101340](#), cleaned to Class B per [E0900047](#) and [E960022](#))
- Coordinate Measuring Machine (CMM, Romer model Infinite 2.0).
- BSC table height target (D1101611).
- Various optical or tripod stands

### 6 PROCEDURE FOR CARTRIDGE ASSEMBLY ALIGNMENT

The reference monuments for the cartridge assembly on test stand 2 are given in D1101596, and in Figure 1, for convenience.



## WBSC8 As Built

The WBSC8 cartridge assembly is depicted in Figure 2. The major optics assemblies integrated into the WBSC8 cartridge are the Y Folding Mirror (FMy) suspension assembly (D0900364) and the Y Input Test Mass (ITMy) and Compensation Plate (CPy), both parts of the suspension assembly (D0900363). Of the Stray Light Control (SLC) baffles which are destined for the WBSC8 chamber, only the elliptical baffle is part of the cartridge assembly; the other SLC baffles interfere with the test stand.

There is no need (other than practice) to perform these initial alignment steps on the metal-mass versions of the suspensions as installed on the BSC-ISI optics table on the mechanical test stand. These procedure starts when all optics have been installed into the suspensions on the BSC-ISI platform on the mechanical test stand.

*N.B.: For the initial installation into WBSC8 in support of the H2 One Arm Test (H2OAT), the FMy optic will be a small mirror placed in the center of a metal mass matching the mass properties of the final FMy optic (the FMy optic will not be ready in time for the H2OAT). As a consequence it is not essential to install the elliptical baffle at this time. Moreover the elliptical baffle may not be available in time. The Arm Cavity Baffle (ACB) should be available for the initial WBSC8 installation. However, the ACB is not installed as part of the cartridge assembly. In this document we address the alignment of all elements of a complete WBSC8 installation for completeness. In the event that some of these elements are missing for the initial installation, this should be noted in the completed installation notes/comments fields in this document.*

The positions and Lines Of Sight (LOS) for the WBSC8 cartridge assembly alignment are depicted in Figure 3. The dimensional information associated with this alignment is depicted in Figure 4.



WBSC8 As Built

NOTES:

1) ALL DIMENSIONS ARE IN MM, UNLESS OTHERWISE NOTED


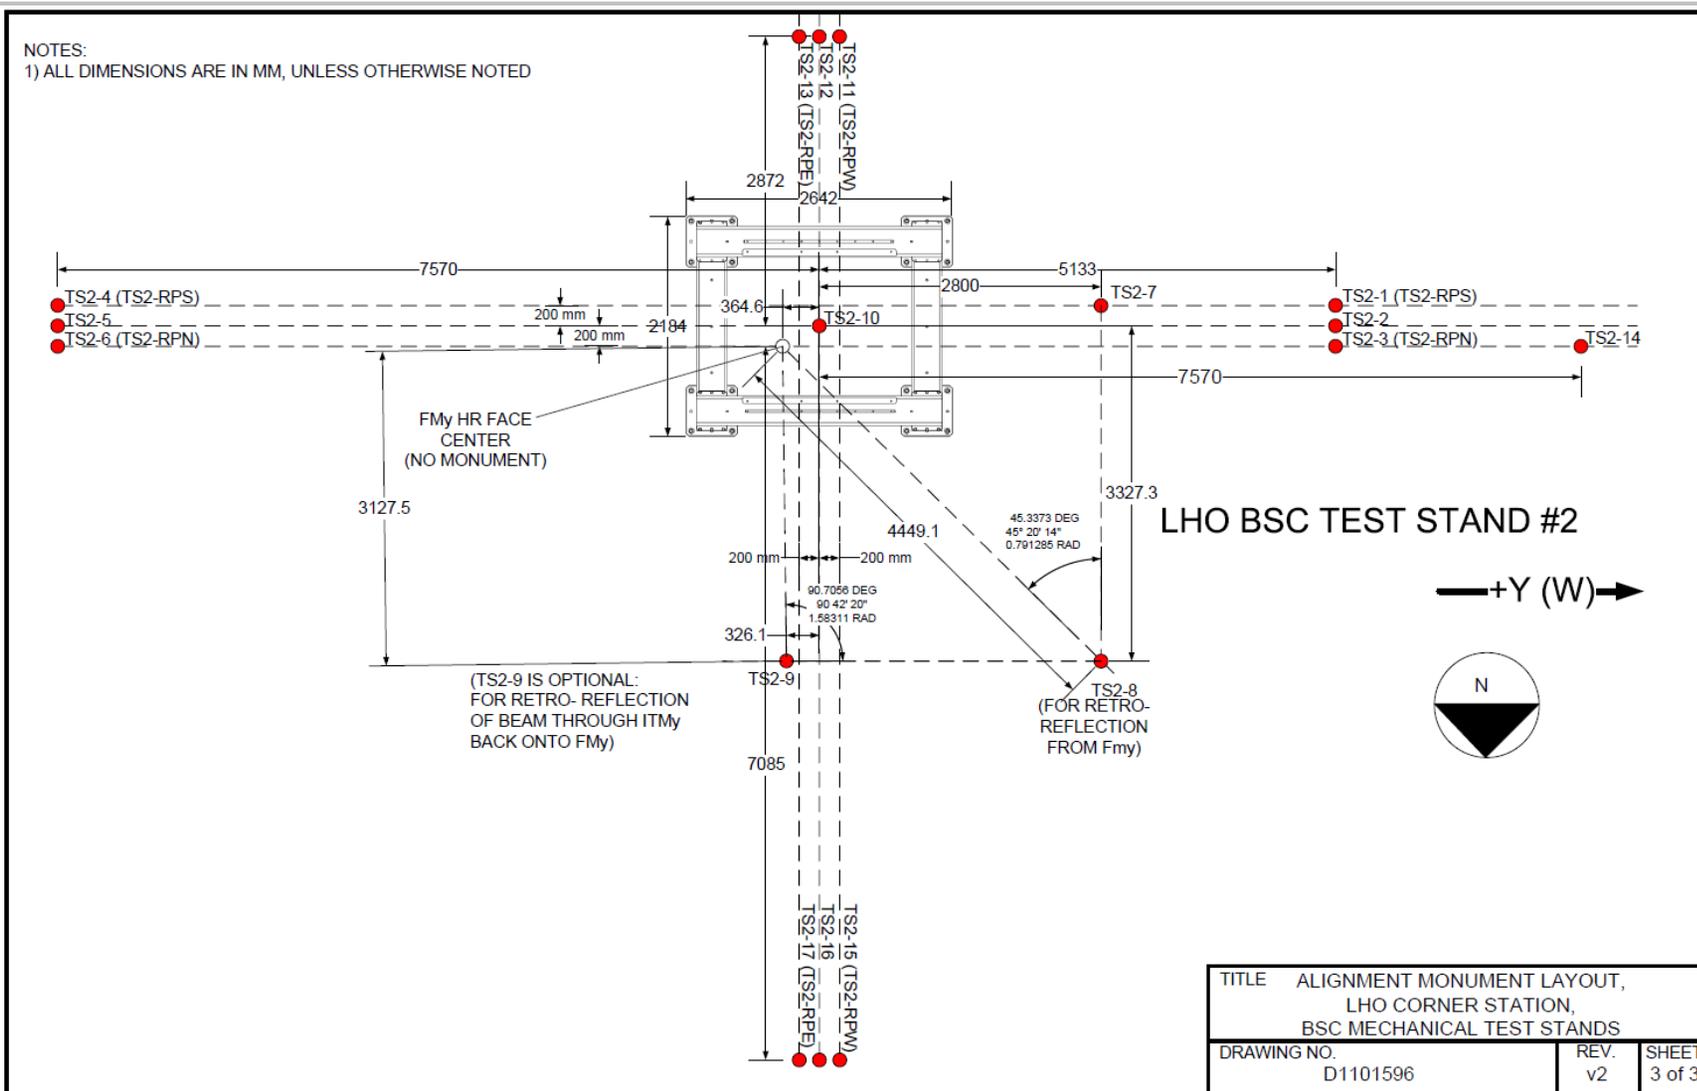


Figure 1: Monument Layout for Test Stand #2 (from D1101596)



## WBSC8 As Built

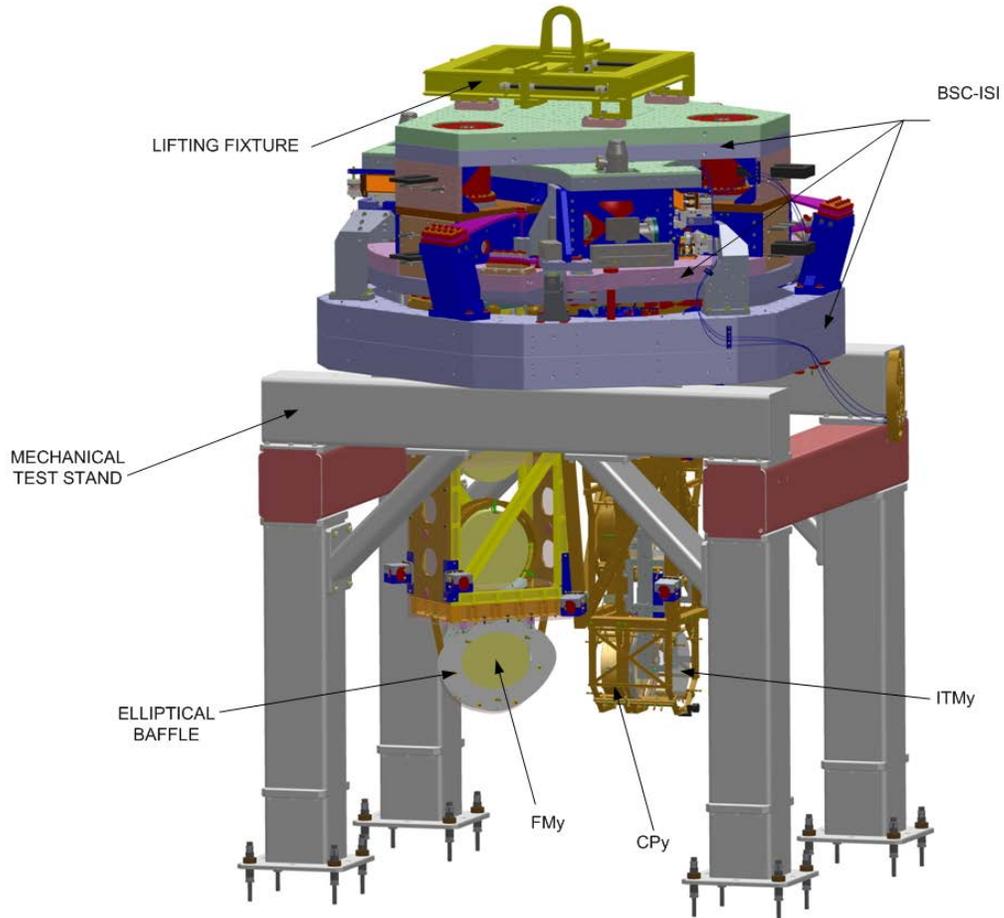

**Figure 2: The WBSC8 cartridge assembly on the BSC Mechanical Test Stand (D1002124)**

*N.B.: The configuration "full cartridge" of D0900360, SolidWorks PDMW vault version X-106 is shown, modified to not include the Arm Cavity Baffle (ACB, D0901376) since it interferes with the test stand. Note that the electrical feedthrough CF flanges are shown in this image, but are in fact installed on the chamber and are not part of the assembly while it is on the mechanical test stand.*



### WBSC8 As Built

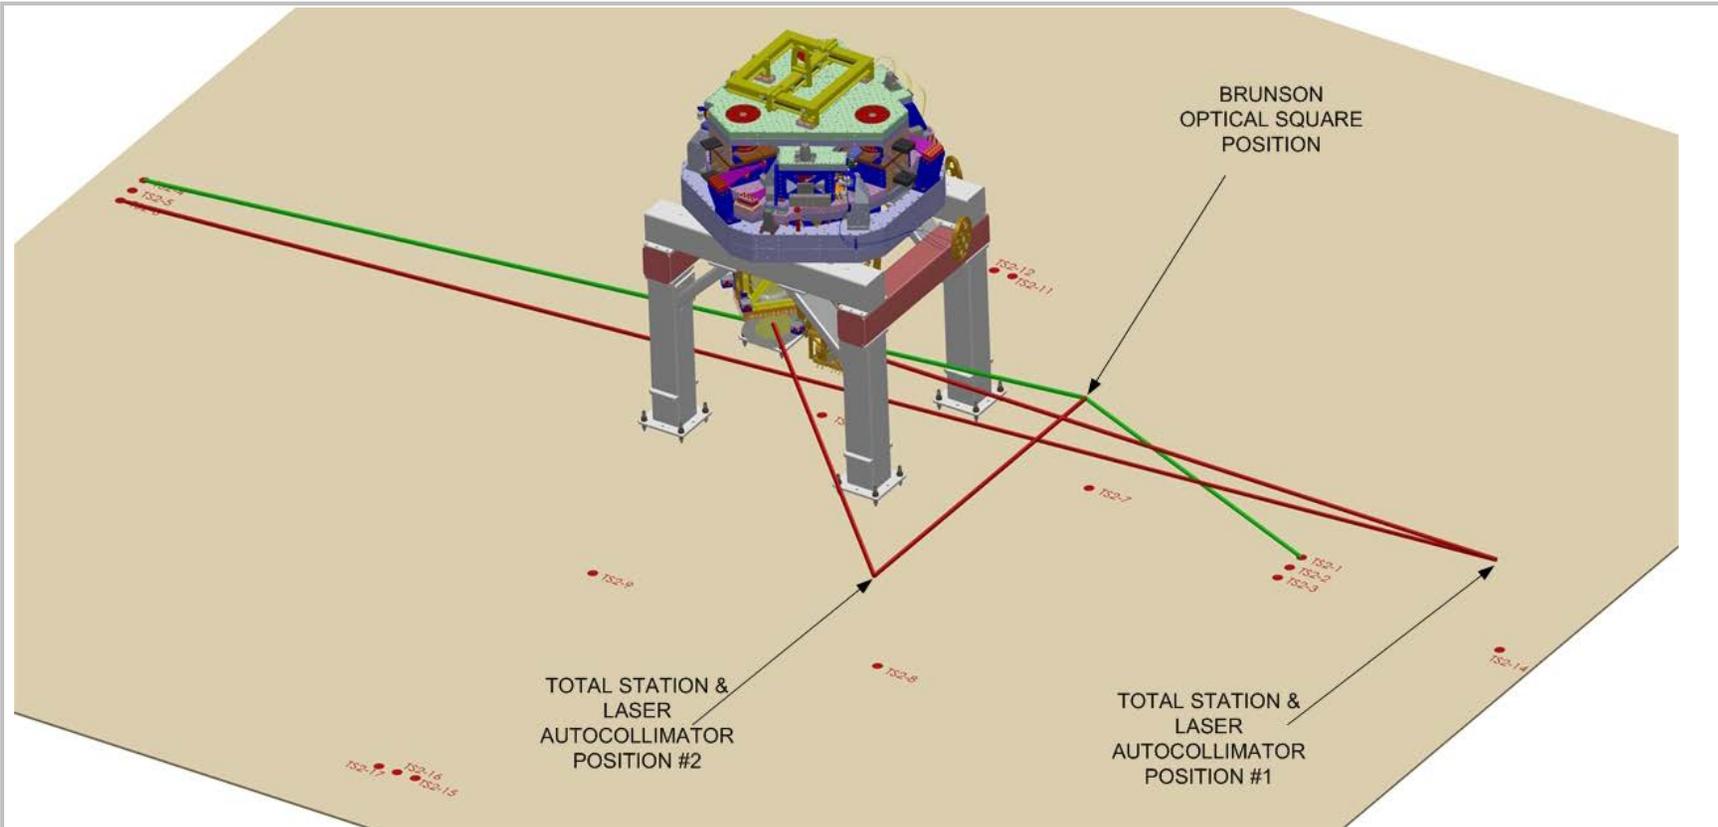


Figure 3: IAS Instrument Positions and Lines Of Sight (LOS) for the WBSC8 Cartridge Assembly Alignment



WBSC8 As Built

B

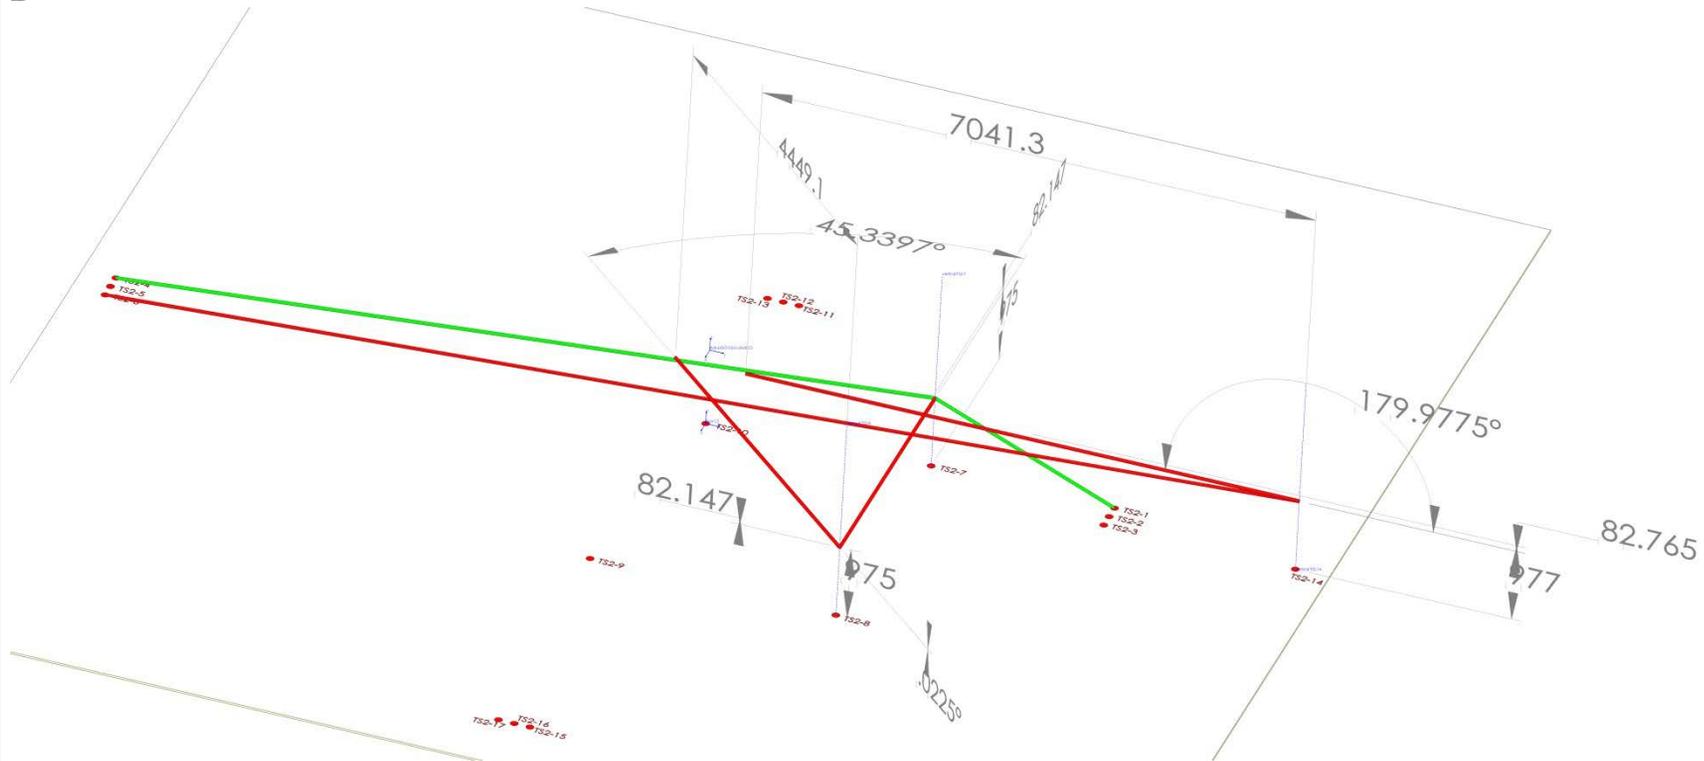


Figure 4: IAS Instrument Positions and LOS



**WARNING! USE THE NUMERICAL VALUES OF DISTANCES AND ANGLES IN THE TEXT OF THE PROCEDURE AND NOT THOSE SHOWN IN THIS FIGURE (SOME OF THESE VALUES ARE IN ERROR – FIGURE TO BE UPDATED)**



## WBSC8 As Built

### 6.1 Cartridge set-up

#### 6.1.1 Check optics table level on the BSC mechanical test stand

Datum: Local gravity

Equipment: Optical level on tall tripod and targets on invar rods suspended from the optics table

Accuracy:  $\pm 100$  microrad (0.1 mm differential height)

Procedure:

- Attach 3 invar rods with targets to the table (equal lengths sufficient to be seen by optical level on tripod). Position the rods so that all 3 can be observed from a single optical level position.
- Place optical level on a tall tripod and sight the relative difference in target heights to determine tip and tilt of optics table.
- Adjust ISI trim/balance mass per E0900357 (v20, section 1.84)
- Record table levelness:

Level	mm
-------	----

#### 6.1.2 Approximately align the Cartridge Assembly elements with the templates.

Datum: Bolt holes in optical table per [D1101259-v2](#)

Equipment: Alignment templates (D1101050). Each suspension has two sets of templates. Either set may be used but not both.

ITMy Suspension: Use either D1001050-3 or D1001050-4.

FMy Suspension: Use either D1001050-1 or D1001050-2.

Accuracy: Clearance in bolt holes

Procedure:

- Install D1101050-3 or D11050-4 template per [D1101259-v2](#).
- Install D1101050-1 or D11050-2 template per [D1101259-v2](#).
- If needed, install precision pushers ([D060052](#)) per [T080230](#) adjacent to FM and ITM structures opposite of the templates.
- Push FM and ITM structures to contact the templates per [T080230](#).
- Lock down suspension structures.
- Remove all templates.

### 6.2 H2 ITMy

#### 6.2.1 Setup the ITM Retro-reflector Assembly

Datum: Optical axis of the test mass.

Equipment: Retro-reflector assembly (D1101340), CMM

Accuracy:  $\pm 0.2$  mm




## WBSC8 As Built

### Procedure:

- Attach the retro-reflector assembly to the quad structure in front of the ITM HR face.
- Lock the rotation stage so that the retroreflector is not free to move.  
*Note: It is not necessary to center the retroreflector target to the optic centerline.*
- Use a CMM to measure the Y distance (offset) between the reflecting plane reference on the retro-reflector to the test mass HR face (see Figure 6). The CMM probe is not to contact the HR face of the optic except along the outer perimeter
- Record the Offset (Y-distance).

Offset: distance from the ITM HR face to the Reflecting Plane of the Retro-reflector	54.1 mm
--	---------

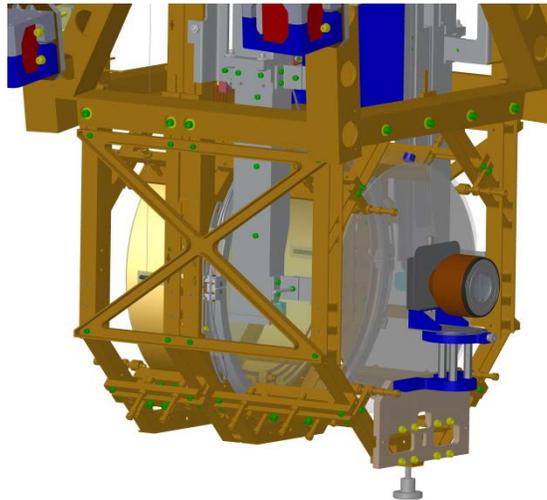

**Figure 5: Retro-reflector Assembly attached to Quad Suspension Structure**



WBSC8 As Built

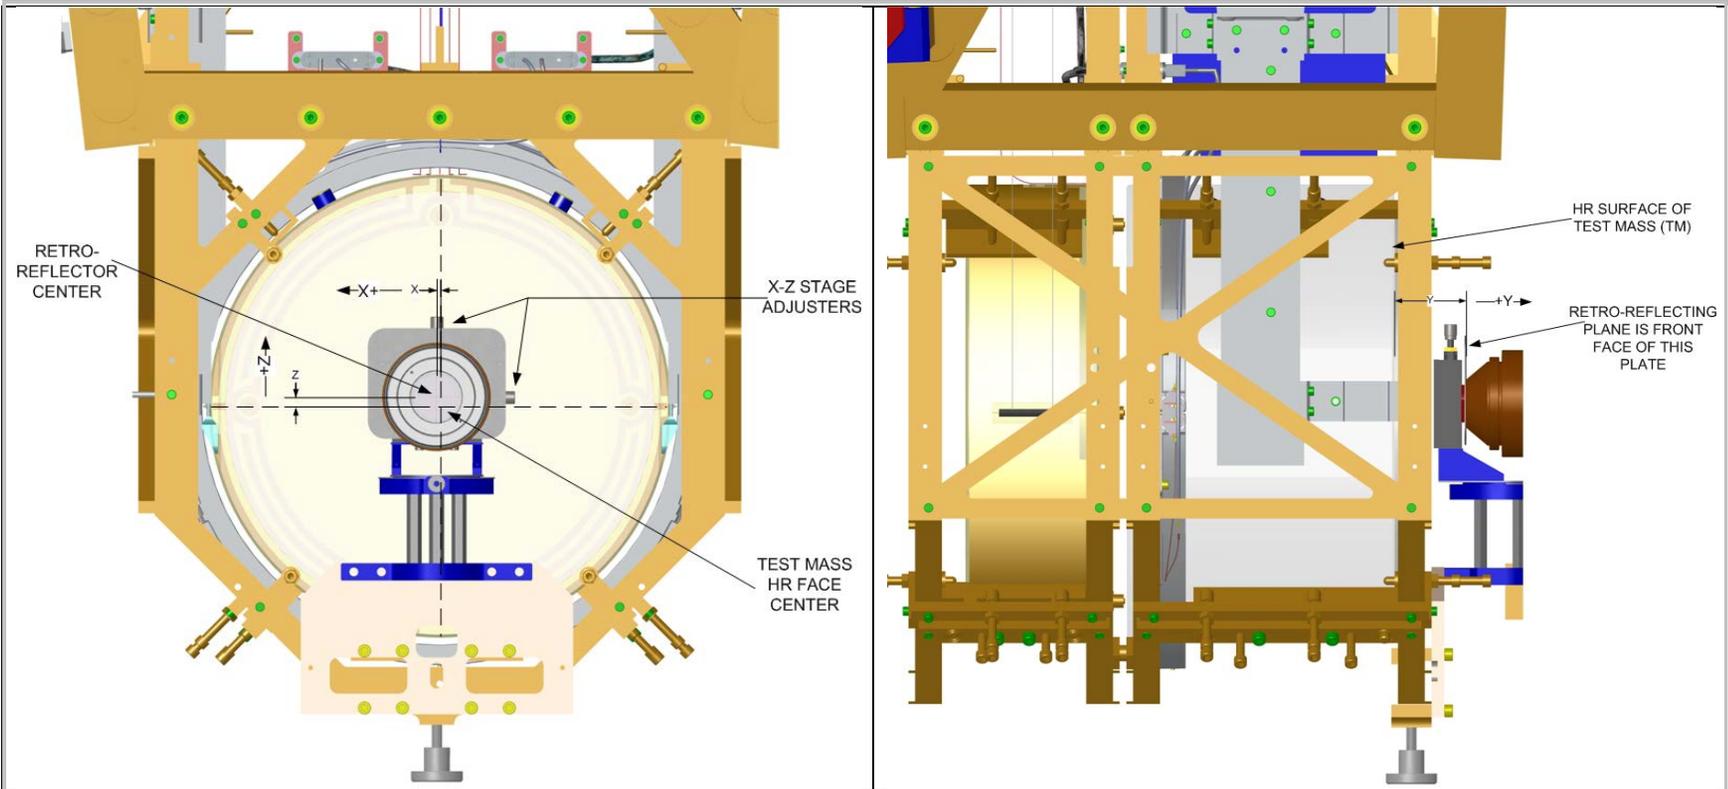


Figure 6: X, Y and Z offsets between the HR face center and the Retro-Reflector Center



## WBSC8 As Built

### 6.2.2 Setup Total Station and Laser Autocollimator

Datum: Monuments TS2-14, TS2-3, TS2-6 – axis 200 mm shifted from the centerline; height target is placed on the precision length rod (D1101611) to set target to optic height below the optics table.

Equipment: Total station, Newport Laser Autocollimator (mounted on top of Total Station), height target (D1101611)

Accuracy:  $\pm 1$  mm,  $\pm 40$  microradians rss, alignment reference transfer (see [T1000230-v6](#), section 17)

Procedure:

- Set the total station to approximately 977 mm above the floor
- Set the total station on TS2-14 and sight TS2-3 and TS2-6. See Figure 4
- Attach the height target to the optics table on a centerline hole near the table edge toward the total station.
- Yaw the total station to sight the height target and adjust total station height to match height target. The total station is now at the height of the test mass (i.e. -80 mm Z)

### 6.2.3 Set the ITM longitudinal position

Datum: Total station EDM, Retro-reflector and offsets to the HR face (determined in section 6.2.1)

Equipment: Total station, retro-reflector

Accuracy:  $\pm 3$  mm

Procedure:

- Use total station EDM to set position to 7041.3 mm (remember to account for the offset distance from the retro-reflector to the optic HR face)
- Record position.

	Trial 1	Trial 2	Trial 3
Retroreflector to HR face offset	54.1 mm	mm	mm
Retroreflector inherent offset	N/A mm	mm	mm
EDM Distance	6991 mm	mm	mm
Sum = ITM HR longitudinal distance	7045.1 mm	mm	mm

### 6.2.4 Set the ITM horizontal position

Datum: Optical axis as established by the total station.

Equipment: Total Station, Pusher Assemblies ([D060052](#)), Slider/Mover Assemblies ([D1100018](#))

Accuracy:  $\pm 1$  mm



## WBSC8 As Built

### Procedure:

- Lock-down the optics and masses, of both suspension chains, with the earthquake stops according to the SUS procedure
- With the Total Station at zero elevation angle, sight the left edge of the optic. Record the yaw angle.
- Sight the right edge of the optic. Record the yaw angle.

	Trial 1	Trial 2	Trial 3
Left optic edge (A)	23.09 mrad	23.12 mrad	mrad
Right optic edge (B)	23.22 mrad	23.22 mrad	mrad
Center error angle (A-B)/2	65 microrad	50 microrad	microrad
Center error distance $7045.1 * (A+B)/2$	0.46 mm	0.35 mm	mm

**Note: There was a yaw adjustment between trial 1 and trial 2, no horizontal adjustment.**

- Use the “slider/supports” and “pusher assemblies” ([D060052](#)) to shift the lateral position of the quad structure as needed, so that the retro-reflector center is centered in the theodolite (Total Station)

### 6.2.5 Coarse Align the ITM Yaw

Datum: Optical axis as established by the total station.

Equipment: Laser autocollimator

Accuracy:  $\pm 1$  milliradians goal (limited by the repeatability in the pusher and clamping method)

### Procedure:

- Peel back the First Contact™ at 12 o'clock.
- Insure that the optics and masses, of the main suspension chain, are free (not clamped or on the mechanical or earthquake stops)
- Use the laser autocollimator to measure the TM optic yaw angle.
- Use the pusher assemblies to reduce the yaw angle to as close to zero as possible ( $< 1$  mrad), using the SUS procedures. Note that the optics and masses should be clamped before attempting to move the Suspension frame/assembly on the optics table.
- Record residual yaw error.

	Trial 1	Trial 2	Trial 3
ITM yaw error	2.61 millirad CCW	0.4 millirad CCW	0.34 millirad CCW

### 6.2.6 Iterate/re-Check

Datum: Local gravity, optical axis as established by the total station.



**WBSC8 As Built**

Equipment: Optical level on tall tripod and targets on invar rods suspended from the optics table, total station

Accuracy:

levelness:  $\pm 100$  microrad (0.1 mm differential height)

lateral position:  $\pm 1$  mm

longitudinal position:  $\pm 3$  mm

yaw:  $\pm 160$  microradians

Procedure:

- Re-check table level
- Re-check the lateral & longitudinal position and yaw and iterate until all are within required accuracy (coarse accuracy for the yaw).
- Remove the retroreflector and mount assembly from the ITM

Once this step has been completed, the ITM “frame” has been set; all further adjustments to the ITM are on the suspension chains.

**6.2.7 Check the ITM vertical position**

Datum: Optical axis as established by the total station.

Equipment: Total Station

Accuracy:  $\pm 1$  mm

Procedure:

- With the Total Station at zero yaw angle, sight the bottom edge of the optic. Record the pitch angle.
- Sight the top edge of the optic. Record the pitch angle.

	Trial 1	Trial 2	Trial 3
Bottom optic edge (A)	24.26 mrad	mrad	mrad
Top optic edge (B)	23.99 mrad	mrad	mrad
Center error angle (B-A)/2	-135 microrad	microrad	microrad
Center error distance $7045.1 * (A+B)/2$	-0.95 mm	mm	mm

- The optic height was set during the SUS assembly and should be correct. However, if it is out of tolerance use the SUS procedures to adjust the test mass height until it is within the required accuracy

**6.2.8 Fine Align the ITM Yaw**

Datum: Optical axis as established by the total station.



## WBSC8 As Built

Equipment: Laser autocollimator

Accuracy:  $\pm 100$  microradians (limited by air buffeting in the test stand/cleanroom environment)

Procedure:

- Insure that the optics and masses, of the main suspension chain, is free (not clamped or on mechanical or earthquake stops)
- Then use the top blade adjusters to reduce the residual error further, using SUS procedures
- Record the yaw error

	Trial 1	Trial 2	Trial 3
ITM yaw error	0.34 millirad CCW	millirad	millirad

**Note: No yaw adjustment was performed.**

### 6.2.9 Align the ITM pitch

Datum: Optical axis as established by the total station.

Equipment: Total station

Accuracy:  $\pm 100$  microradians (limited by air buffeting in the test stand/cleanroom environment)

Procedure:

- Set the total station pitch to 12.5 microradians (2.58 arcsec) down. Using the LAC, measure the pitch error.

Initial ITM pitch error	804 microradians up
-------------------------	---------------------

- If the pitch error is  $< 100$  microradians, record and re-adhere First Contact™
- If  $> 100$  microradians, then adjust the upper intermediate mass pitch balance per SUS procedures

Final ITM pitch error	22.5 microradians up
-----------------------	----------------------

### 6.2.10 Check the CP to ITMy Gap

Datum: The ITMy AR face and the opposing face of the CP.

Equipment: Keyance System and Laser Autocollimator

Accuracy:  $\pm 0.5$  mm average/center distance, and  $\pm 1.47$  milliradians parallelism (corresponding to  $\pm 0.25$  mm over the diameter of the optic)

Procedure:

- Measure & record the gap distance between the ITMy AR face and the opposing face of the CP with the Keyance System.
- If the gap is not within the allowed tolerance of the nominal 20 mm, then adjust per SUS procedures



## WBSC8 As Built

- Measure the parallelism between the surfaces and if not within the allowed tolerance, then adjust per SUS procedures
- Record the final gap parameters

Gap Distance	19.96 mm	
Gap Parallelism	Pitch	0.36 milliradians up
	Yaw	2.04 milliradians CCW

**NOTE: These numbers were set before the in-chamber fiber break. This was not re-measured after the ITMy suspension was changed from glass fibers to a wire loop after the break; therefore these numbers are not valid for the gap distance/parallelism during the H2OAT.**

### 6.3 FM

#### 6.3.1 Setup the FM Retro-reflector Assembly

Datum: Optical axis as established by the total station.

Equipment: Retro-reflector assembly (D1101340), CMM,

Accuracy:  $\pm 0.2$  mm

Procedure:

- Attach the retro-reflector assembly to the FM structure in front of the FM HR face.
- Use a CMM to measure and the x-y stage to adjust the center of the retro-reflector cross-hairs to be on the optical axis of the test mass.
- Write down x,y,z coordinates of retro center to optic center.

FM X, Y, Z coordinates	mm
------------------------	----

#### 6.3.2 Set the Optical Square

Datum: Monument TS2-7, TS2-1, and TS2-4

Equipment: Brunson optical square

Accuracy:  $\pm 1$  mm,  $\pm 10$  microradians

Procedure:

- Set the Brunson optical square to approximately 975 mm above the floor over TS2-7.
- Use the optical square to sight TS2-3 and TS2-6.

#### 6.3.3 Setup Total Station and Laser Autocollimator

Datums: Monument TS2-8, optical square, ISI table surface as referenced by height target.

Equipment: Total station, retro-reflector, height target

Accuracy:  $\pm 1$  mm,  $\pm 10$  microradians

Procedure:

- Set the total station to approximately 975 mm above the floor over TS2-8.



**WBSC8 As Built**

- Use the total station to retro-reflect off the optical square to set the “zero” yaw position.
- Attach the height target to the optics table near the table edge toward the total station.
- Yaw the total station to sight the height target and adjust total station height to match height target. The total station is now at the height of the FM.

**6.3.4 Set the FM longitudinal position**

Datum: Optical axis established with the Total Station

Equipment: Total station

Accuracy: ±3 mm

Procedure:

- Use total station EDM to set position to 4449.1 mm (remember to account for the offset distance from the retro-reflector to the optic HR face)
- Record position.

	Trial 1	Trial 2	Trial 3
Retroreflector to HR face offset	82.5 mm	mm	mm
Retroreflector inherent offset	N/A mm	mm	mm
EDM Distance	4364 mm	mm	mm
Sum = ITM HR longitudinal distance	4446.5 mm	mm	mm

**6.3.5 Set the FM horizontal position**

Datum: Optical axis as established by the total station.

Equipment: total station, pusher assembly ([D060052](#)).

Accuracy: ±1 mm

Procedure:

- Sight the retroreflector target with the total station and use the “slider/supports” and “pusher assemblies” ([D060052](#)) to shift the FM structure so that the retro-reflector center is centered in the theodolite.
- Measure & record the yaw angle to null the difference in theodolite and retro-reflector cross-hairs.

yaw angle to retro-reflector center	microrad
-------------------------------------	----------

**Note: This was done as instructed for the ITM above (step 6.2.4). Center error distance was 1.23 mm.**

**6.3.6 Coarse Align the FM Yaw**

Datum: Optical axis as established by the total station.

Equipment: Laser autocollimator



## WBSC8 As Built

Accuracy:  $\pm 1$  milliradians goal

Procedure:

- Peel back the First Contact™ at 12 o'clock.
- Use the laser autocollimator to measure the FM optic yaw angle. Use the pusher assemblies to reduce the yaw angle to as close to 0.791285 radians (45.3373 degrees, or 45° 20' 14") as possible ( $< 1$  mrad).
- Then use the top blade adjusters to reduce the residual error further, using SUS procedures
- Record residual yaw error.

FM yaw error	1467 microrad
--------------	---------------

**Note: No yaw adjustment performed.**

### 6.3.7 Iterate/re-Check

Datum: Local gravity, optical axis as established by the total station.

Equipment: Optical level on tall tripod and targets on invar rods suspended from the optics table, total station

Accuracy:

levelness:  $\pm 100$  microrad (0.1 mm differential height)

lateral position:  $\pm 1$  mm

longitudinal position:  $\pm 3$  mm

yaw:  $\pm 380$  microradians

Procedure:

- Re-check table level
- Re-check the lateral & longitudinal position and yaw and iterate until all are within required accuracy.

### 6.3.8 Check the FM vertical position

Datum: Optical axis as established by the total station.

Equipment: Total station

Accuracy:  $\pm 1$  mm

Procedure:

- Sight the retro-reflector target with the total station.
- Measure the vertical positional error by recording the pitch angle to null the difference between the theodolite and retro-reflector cross-hairs (A)

A = pitch angle corresponding to ITM horizontal error	microrad
--	----------

- Measure the pitch angle to sight the top center edge of the FM optic (B)



### WBSC8 As Built

B = initial pitch angle to top center edge of the optic	microrad
---	----------

- Set the total station to sight the proper position of the top center edge of the FM optic (A+B)

A+B = correct pitch angle to top center edge of the optic	microrad
---	----------

- Adjust the FM height by adjusting trim masses per SUS procedures until the top center edge of the FM optic is at the correct pitch angle (A+B)
- Measure & record the pitch angle to null the difference in theodolite and retro-reflector cross-hairs.

pitch angle to retro-reflector center	microrad
---------------------------------------	----------

**Note: Step not done on dummy mass.**

#### 6.3.9 Fine Align the FM Yaw

Datum: Optical axis as established by the total station.

Equipment: Total station

Accuracy: ±380 microradians goal

Procedure:

- Peel back the First Contact™ at 12 o'clock.
- Use the laser autocollimator to measure the FM optic yaw angle. Use SUS procedures to adjust the top blades to reduce the yaw angle to as close to 0.791285 radians (45.3373 degrees, or 45° 20' 14") as possible.
- Record residual yaw error.

FM yaw error	microrad
--------------	----------

**Note: Step not done on dummy mass.**

#### 6.3.10 Align the FM pitch

Datum: Optical axis as established by the total station.

Equipment: Total station

Accuracy: ±110 microradians

Procedure:

- Set the total station pitch to 820 microradians (2' 49") up. Using the LAC, measure the pitch error.

Initial FM pitch error	microradians
------------------------	--------------

- If the pitch error is < 110 microradians, record and re-adhere First Contact™
- If > 10 microradians, then adjust the FM pitch balance per SUS procedures



## WBSC8 As Built

Final FM pitch error

microradians

**Note: Step not done on dummy mass.**

## 7 ALIGN THE CARTRIDGE ASSEMBLY IN THE BSC CHAMBER

### 7.1 Notes

The FM Beam Dump Assemblies do not need to be aligned; mechanical assembly tolerances are sufficient to assure adequate alignment.

The FM Elliptical Baffle Assembly (mounted on the FM Suspension Assembly) does not need to be aligned; mechanical assembly tolerances are sufficient to assure adequate alignment.

*N.B.: For the initial installation of the Cartridge Assembly into WBSC8, the FM Beam Dump Assemblies are not available. In addition, the FM Elliptical Baffle has no aperture (so as to block the beam transmitted through the ITM and CP from glinting from the BS metal mass).*

**NOTE: The following steps were performed in April 2012 after the in-chamber fiber break. The ITMy was suspended with a wire loop for the H2OAT, not the original glass fibers. The ITMy/CPy gap was not measured or set after this change.**

### 7.2 Level the Optics Table

Datum: Local gravity, BSC-ISI capacitive position sensors

Equipment: Optical Level, 3 metering rods, BSC-ISI capacitive position sensors.

Accuracy:  $\pm 100$  microradians (0.1 mm differential height)

Procedure:

- Make sure all payload and balance/ballast weight is on the BSC-ISI Assembly
- Attach 3 metering rods onto the Optics Table so that all 3 can be viewed from a single Optical Level position, on a tall tripod, through the open BSC door.
- Check the Optics Table levelness optically before unlocking BSC-ISI.
- If needed, adjust the table to be level using HEPI static adjustment per procedure [E040011](#), "HEPI Assembly and Installation Procedures"
- Unlock the BSC-ISI and compare the capacitive position sensors offset values to the offsets measured on the cartridge test stand. If necessary, adjust the balance mass to get the same capacitive position sensor offsets as achieved on the test stand.
- Confirm the Optics Table levelness (again) with the Optical Level

### 7.3 Setup the Total Station and Laser Autocollimator

Datum:

- a) Monuments LV2, LV3, LV17 (as defined in D1100291) – axis 200 mm shifted in the +X direction from the Y centerline
- b) Elevation mark 504 or 202 (as defined in T1100187)



## WBSC8 As Built

**Equipment:** Total Station; Newport Electronic Visible Laser Autocollimator (LAC); Initial Alignment Tooling Stand (D980429 through D980434); Brunson Optical Square; Metering Rods/Targets; 8" diameter Flat Mirror on a Newport Gimbal Mount and Tripod.

**Accuracy:**  $\pm 1$  mm,  $\pm 40$  microradians rss, alignment reference transfer (see [T1000230-v6](#), section 17)

**Procedure:**

- Remove the WA-1F Spool (on the Y-manifold adjacent to the WGV5 Gate Valve) per procedure [M1000357](#), "Spool Manifold Removal Procedure"
- Set the Initial Alignment Tooling Stand in the space vacated by the Spool, over monument LV17
- Mount the LAC to the top of the Total Station
- Setup the Total Station/LAC on the Initial Alignment Tooling Stand at approximately 1810 mm above the floor directly over LV17
- Adjust the Total Station height to be -79.6 mm (global coordinate system) using either elevation mark 504 or 202 (see T1100187)
- Setup the large Flat Mirror with gimbal mount/tripod with an unobstructed view of, and a few meters from, the Total Station/LAC
- Co-boresight the Total Station and LAC with the Flat Mirror
- Setup the Brunson Optical Square directly over monument LV3, at the same height as the Total Station, and sight LV2 to get alignment parallel to the Y global axis
- Set the Total Station to be square to the Brunson Optical Square.
- Yaw the Total Station precisely 90 degrees and set this yaw angle reference to zero. Pitch the Total Station 12.5 microradians (2.58 arcsec) down. (The Total Station is now pointing to the center of the ITMy HR face.)

### 7.4 Measure Axial Position Error of ITMy

**Datum:** Monument LV17

**Equipment:** Retro-Reflector Assembly (D1101340), Total Station, Microscribe Coordinate Measuring Machine (CMM) arm

**Accuracy:**  $\pm 3$  mm

**Procedure:**

**⚠ N.B.:** Ideally the measurement of the distance from the Retro-Reflector to the ITM HR face would be done once while the Cartridge Assembly is on the test stand. However, the repeatability in the distance from the Retro-Reflector Assembly (D1101340-v1) to the HR face is quite poor; this mount is being redesigned. In the interim, the CMM measurement must be made in the chamber. The alternative of making the CMM measurement at the test stand and then keeping the Retro-Reflector on the Cartridge Assembly during the flight to, and insertion into, the chamber is not feasible because it blocks the "lens cap".

Another alternative is to use a depth gauge with a soft tip or cap (or a soft rule) to measure the distance from the Retro-Reflector mounting plane to the First Contact™ layer.

- Mount the Retro-Reflector Assembly to the ITMy Suspension Assembly structure



### WBSC8 As Built

- Measure the distance from the Retro-Reflector reference plane to the ITM HR face using either the CMM, a depth gauge with soft tip/cap or a soft rule.
  - Take care to clean the measurement tool, especially the contact feature, (b) contact the optic either on the outer perimeter of the HR face where there is no First Contact™ film or in the interior but only on the First Contact™ film and (c) contact very gently.
- Record the CMM measurement as well as the Retro-Reflector (corner cube) offset constant:

Retro-Reflector-to-HR face distance	44.6 mm
Retro-Reflector (corner cube) offset constant	30 mm

- Do not remove or adjust the Retro-Reflector or the mount until after the last Electronic Distance Measurement (EDM) has been completed with the Total Station.
- Use Total Station EDM to measure the axial or longitudinal (Y) position of the ITMy HR face (remember to account for the offset distance from the retro-reflector to the optic HR face). Record the distance:

	Trial 1	Trial 2	Trial 3
Retroreflector to HR face distance	46.4 mm	mm	mm
Retroreflector inherent offset	N/A mm	mm	mm
EDM distance	28214 mm	mm	mm
Sum = ITM HR longitudinal distance to Total Station	28260.4 mm	mm	mm

### 7.5 Measure Lateral Position Error of ITMy

Datum: Y-Arm Axis derived from LV2, LV3 and LV17

Equipment: Total Station

Accuracy: ±1 mm

Procedure:

- With the Total Station, sight the left edge of the optic. Record the yaw angle.
- Sight the right edge of the optic. Record the yaw angle.
- Calculate the lateral position error:

	Trial 1	Trial 2	Trial 3
Left optic edge (A)	5.769 mrad	mrad	mrad
Right optic edge (B)	5.781 mrad	mrad	mrad
Center error angle (A-B)/2	6 microrad	microrad	microrad
Center error distance Axial dist * (A-B)/2	0.2 mm	mm	mm



**WBSC8 As Built**

**7.6 Measure Vertical Position Error of ITMy**

Datum: Y-Arm Axis derived from LV2, LV3 and LV17

Equipment: Total Station

Accuracy: ±1 mm

Procedure:

- With the Total Station, sight the top and bottom edges of the optic. Record the pitch angles.
- Calculate the vertical position error.

	Trial 1	Trial 2	Trial 3
Bottom optic edge (A)	-5.968 mrad	mrad	mrad
Top optic edge (B)	6.004 mrad	mrad	mrad
Center optic error (B-A)/2	18 microrad	microrad	microrad
Center vertical position error Axial dist * (B-A)/2	0.5 mm	mm	mm

**7.7 Measure Pitch & Yaw Errors**

Datum: Optical axis as established by the total station.

Equipment: Newport Electronic, Visible Laser Autocollimator (LAC)

Accuracy: ±10 microradians goal

Procedure:

- Peel back the First Contact™ at 12 o'clock.
- Insure that the optics and masses, of the main suspension chain, are free (not 'clamped' or on the mechanical stops or earthquake stops)
- Use the Laser Autocollimator to measure the TM optic yaw angle. All personnel should exit the chamber. Purge air flow should be off or minimized. Electronic damping should be active for the suspension. If necessary, use a low pass filtering amplifier and display the pitch and yaw on an oscilloscope with trace persistence and cursors to get the average angles
- Record the pitch and yaw errors:

	Trial 1	Trial 2	Trial 3	Trial 4
Yaw error	-1290 microrad	microrad	microrad	microrad
Pitch error	461 microrad	microrad	microrad	microrad

**7.8 Translate Cartridge with HEPI to Correct Axial, Lateral, Vertical and Yaw Errors**

Datum: Optical axis as established by the total station.



**WBSC8 As Built**

Equipment: HEPI static adjusters, Total Station, Retro-Reflector Assembly, Newport Electronic Visible Laser Autocollimator

Accuracy: ±160 microradians yaw goal with HEPI, ±1 mm transverse, ±1 mm vertical, ±3 mm axial

Procedure:

- Use the HEPI static adjustment procedure (per procedure [E040011](#), “HEPI Assembly and Installation Procedures”) to correct the axial, lateral, vertical and yaw errors until the residual errors are within the allowed tolerance.
- After, or during, HEPI adjustments measure the axial, lateral, vertical and yaw errors to guide the HEPI adjustment.
- Record residual errors:

Axial Position	28260.9 mm
Lateral Position	0.2 mm
Vertical Position	0.5 mm
Yaw	87 microrad

**7.9 Correct Pitch Error**

Datum: Optical axis as established by the total station.

Equipment: ITM Suspension pitch adjuster, Newport Electronic Visible Laser Autocollimator

Accuracy: ±160 microradians pitch goal

Procedure:

- Use the Laser Autocollimator to measure the TM optic pitch angle. All personnel should exit the chamber. Purge air flow should be off or minimized. Electronic damping should be active for the suspension. If necessary, use a low pass filtering amplifier and display the pitch and yaw on an oscilloscope with trace persistence and cursors to get the average angles
- Use the TM Suspension static pitch adjustment procedure ([E1000006](#)-v20, section 5, “Quad Suspension Metal-Build Assembly Procedure”) to reduce the residual pitch errors to within the allowed tolerance
- Record the residual pitch error:

	Trial 1	Trial 2	Trial 3
Pitch error	155 microrad	152 microrad	microrad

**7.10 Fine Pitch & Yaw Error Correction**

Datum: Optical axis as established by the total station.

Equipment: ITM Suspension actuation (BOSEMs), Newport Electronic Visible Laser Autocollimator

Accuracy: ±10 microradians goal



## WBSC8 As Built

### Procedure:

- Use the Laser Autocollimator to measure the TM optic pitch and yaw angles. All personnel should exit the chamber. Purge air flow should be off or minimized. Electronic damping should be active for the suspension. If necessary, use a low pass filtering amplifier and display the pitch and yaw on an oscilloscope with trace persistence and cursors to get the average angles
- Use the TM Suspension controls interface to set pitch and yaw bias values to correct the residual errors
- Record the pitch and yaw bias values and residual error:

	Bias	Angle
Pitch	counts	-7.6 microrad
Yaw	counts	87 microrad

**NOTE:** We found with the ETMy alignment that the First Contact was affecting the ETMy pitch by approximately  $-250 \mu\text{rad}$ . This was not compensated for with this ITMy alignment, therefore we expect the ITMy pitch to be  $-257.6 \mu\text{rad}$ .

## 8 Align Arm Cavity Baffle (ACB) Assembly

Datums: Optical axis as established by the total station.

Equipment: Total station, pusher assembly ([D060052](#)).

Accuracy:  $\pm 2 \text{ mm}$

### Procedure:

- Install and suspend the ACB from stage-0 of the ISI using procedure [E1100810](#), "Arm Cavity Baffle Installation Procedure".
- Re-level table using HEPI (see section 7.1)
- Check horizontal alignment using the Total Station to sight on left & right edges of the baffle.
- Check vertical alignment using the Total Station to sight on top & bottom edges of the baffle
- If both vertical and horizontal positional errors are  $< 2\text{mm}$ , then proceed to next step. Otherwise, reposition using the pusher assemblies ([D060052](#)) per procedure [T080230](#) until the positional errors are within tolerance.