



<u>CAMERA 1</u>: FROM RATTLESNAKE MOUNTAIN

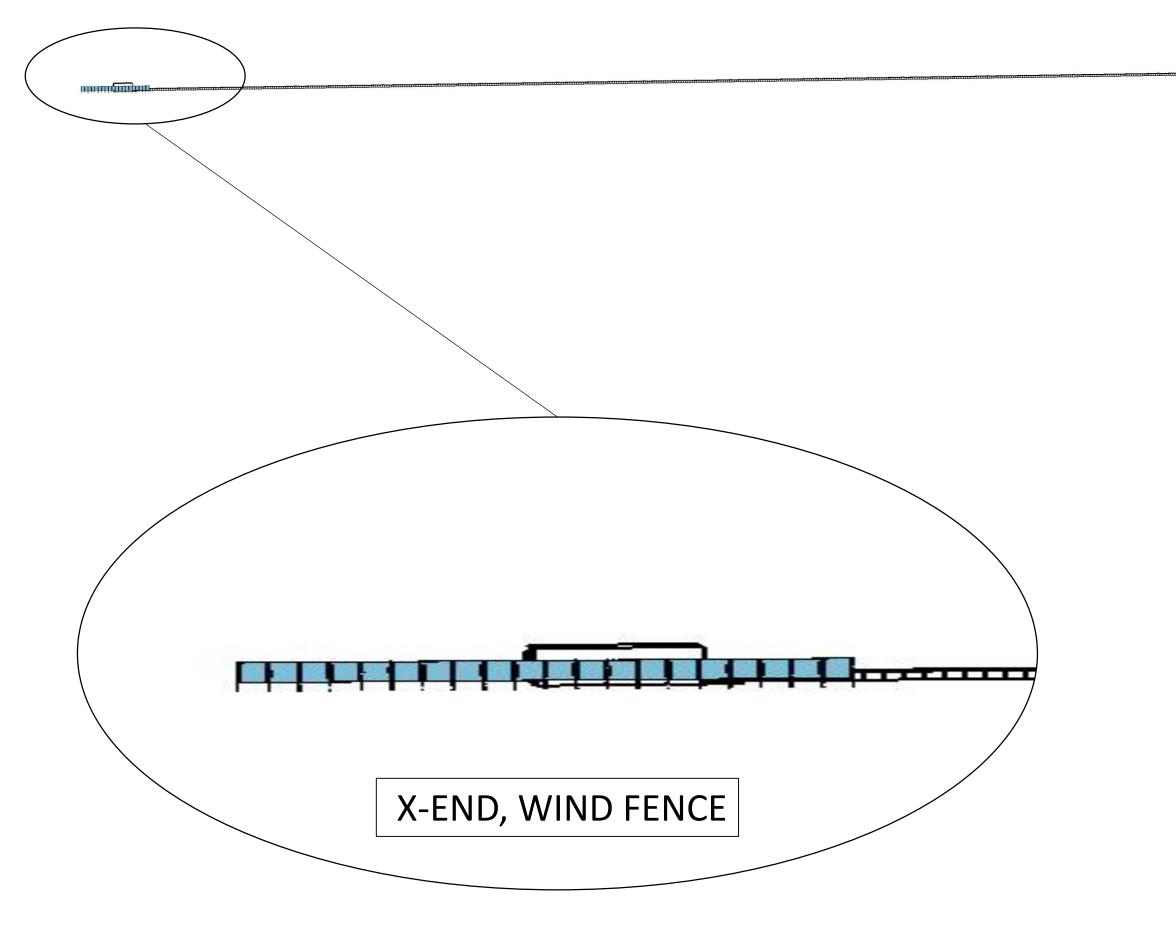


AS-BUILT


WITH PLANNED UPGRADES

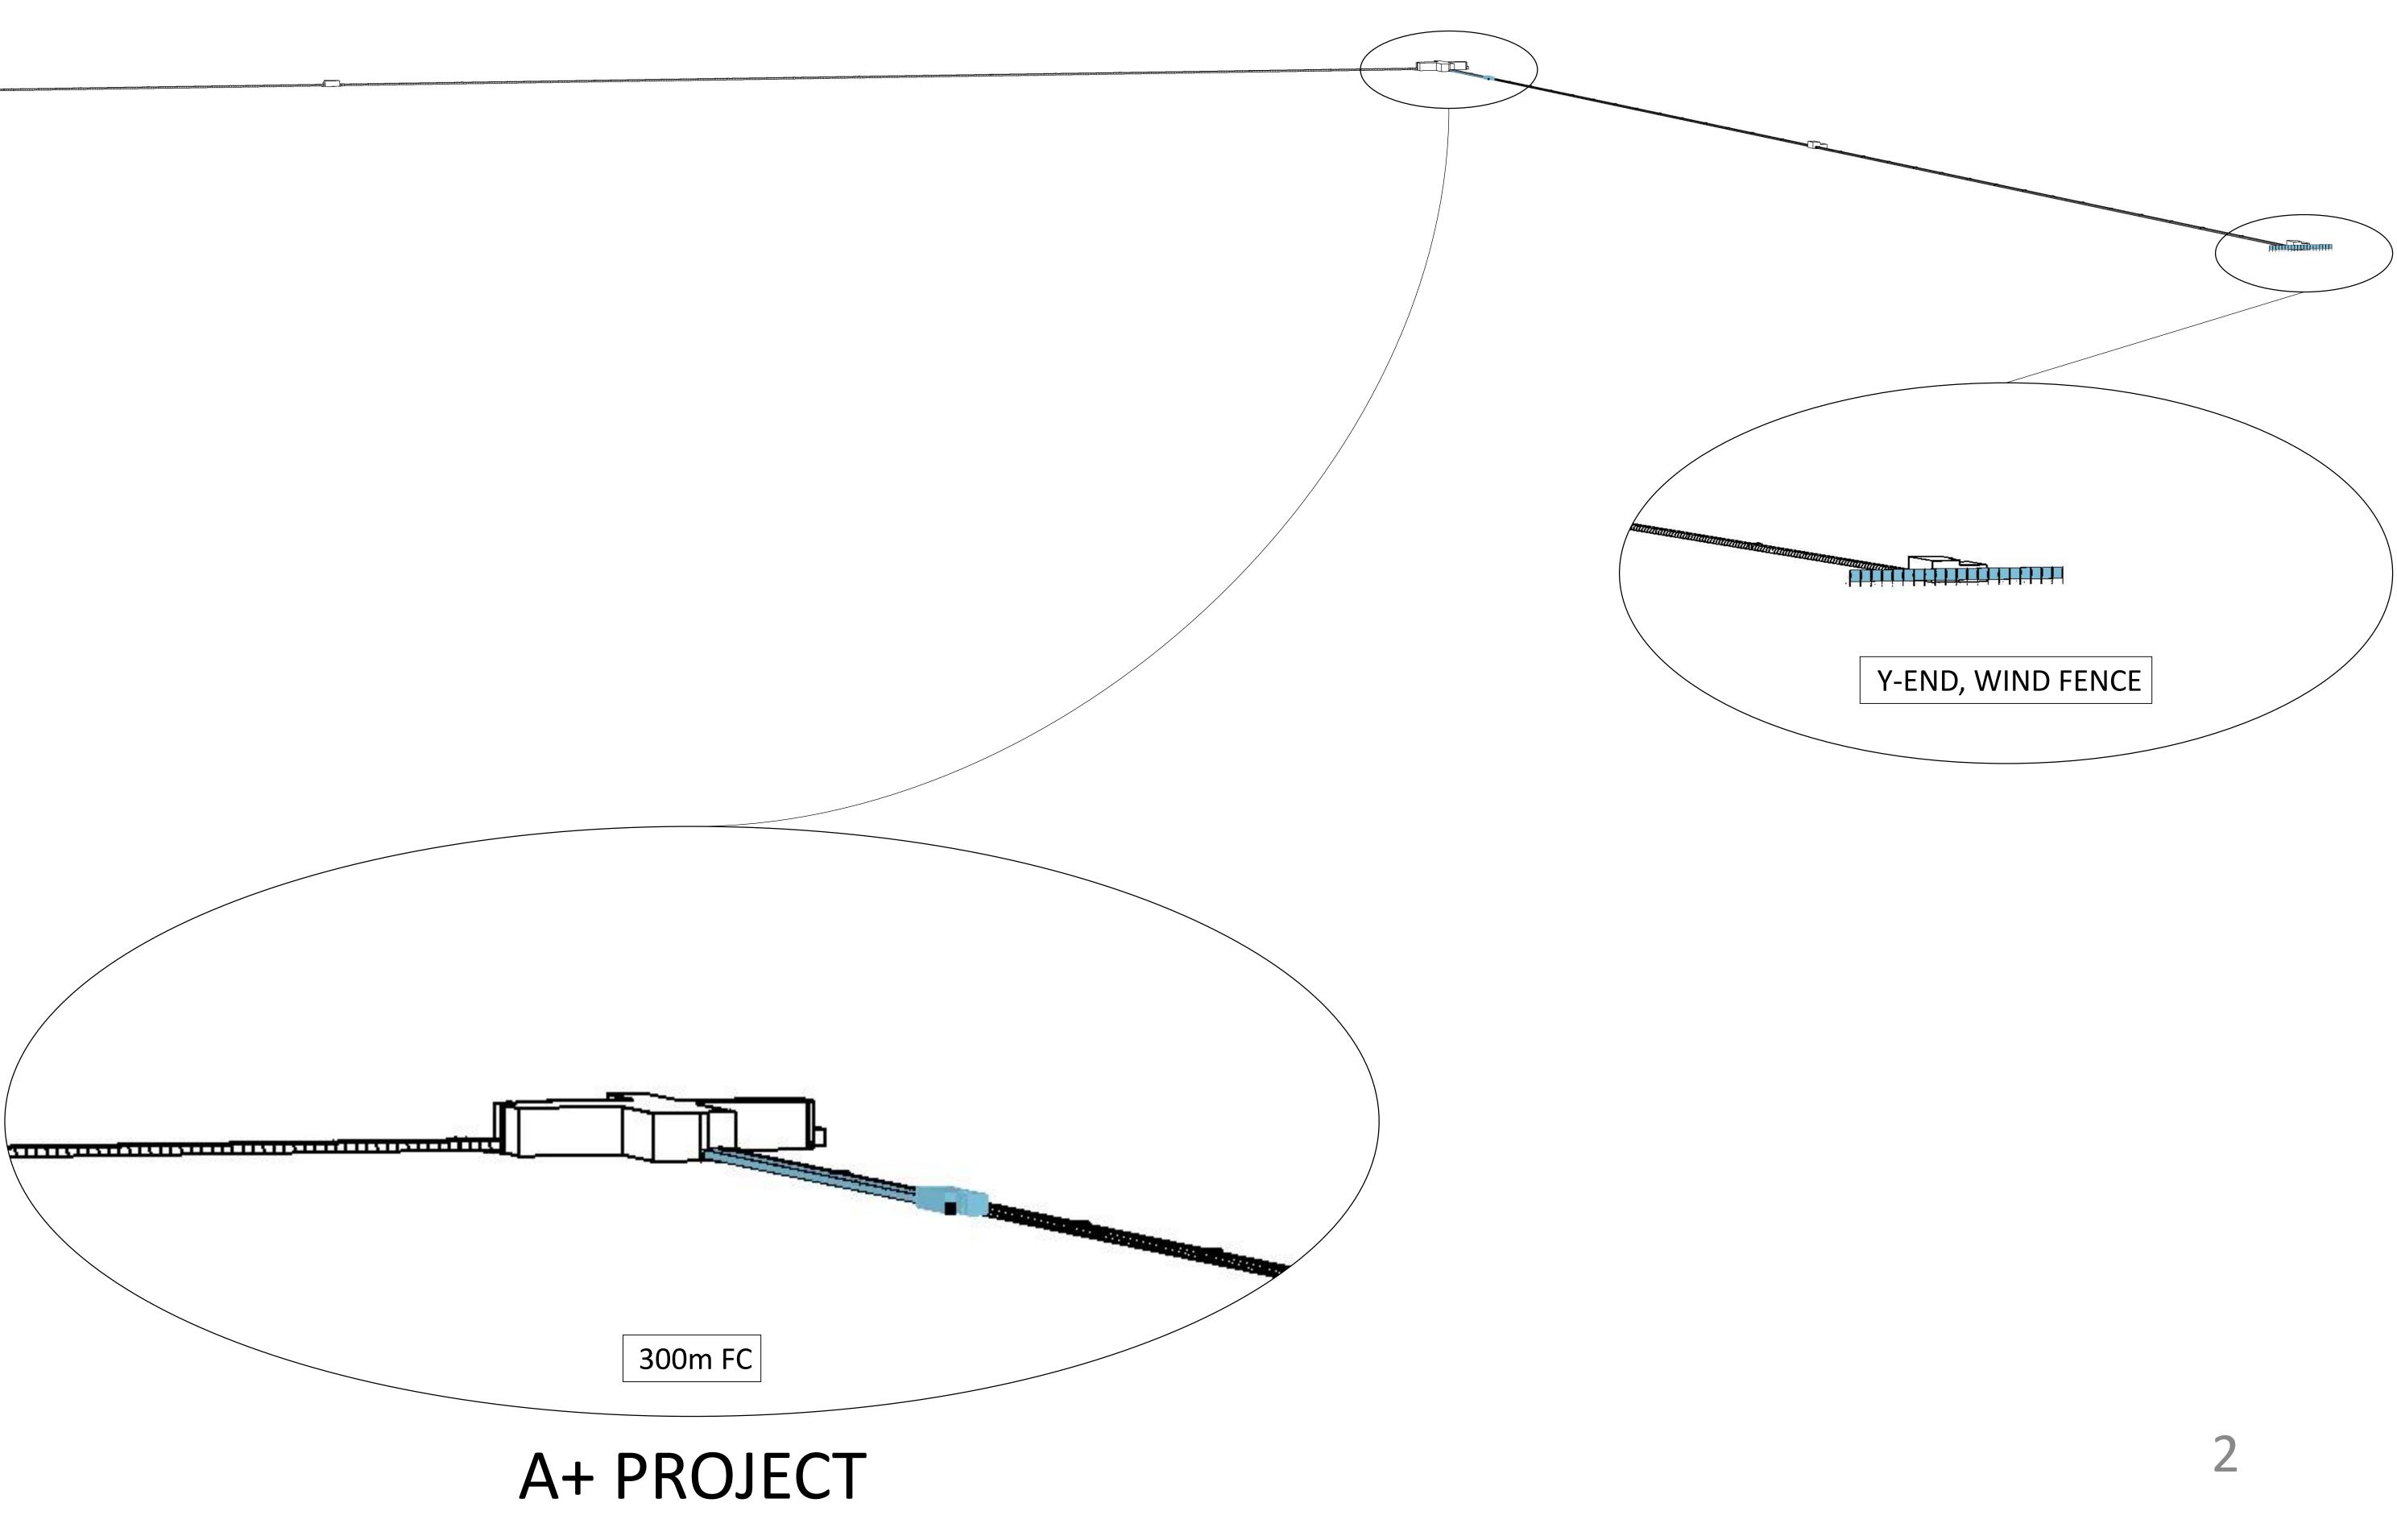

<u>Y-END, WIND FENCE PLAN VIEW</u>: EXTRACTED FROM <u>D1800258</u> LHO WIND FENCE

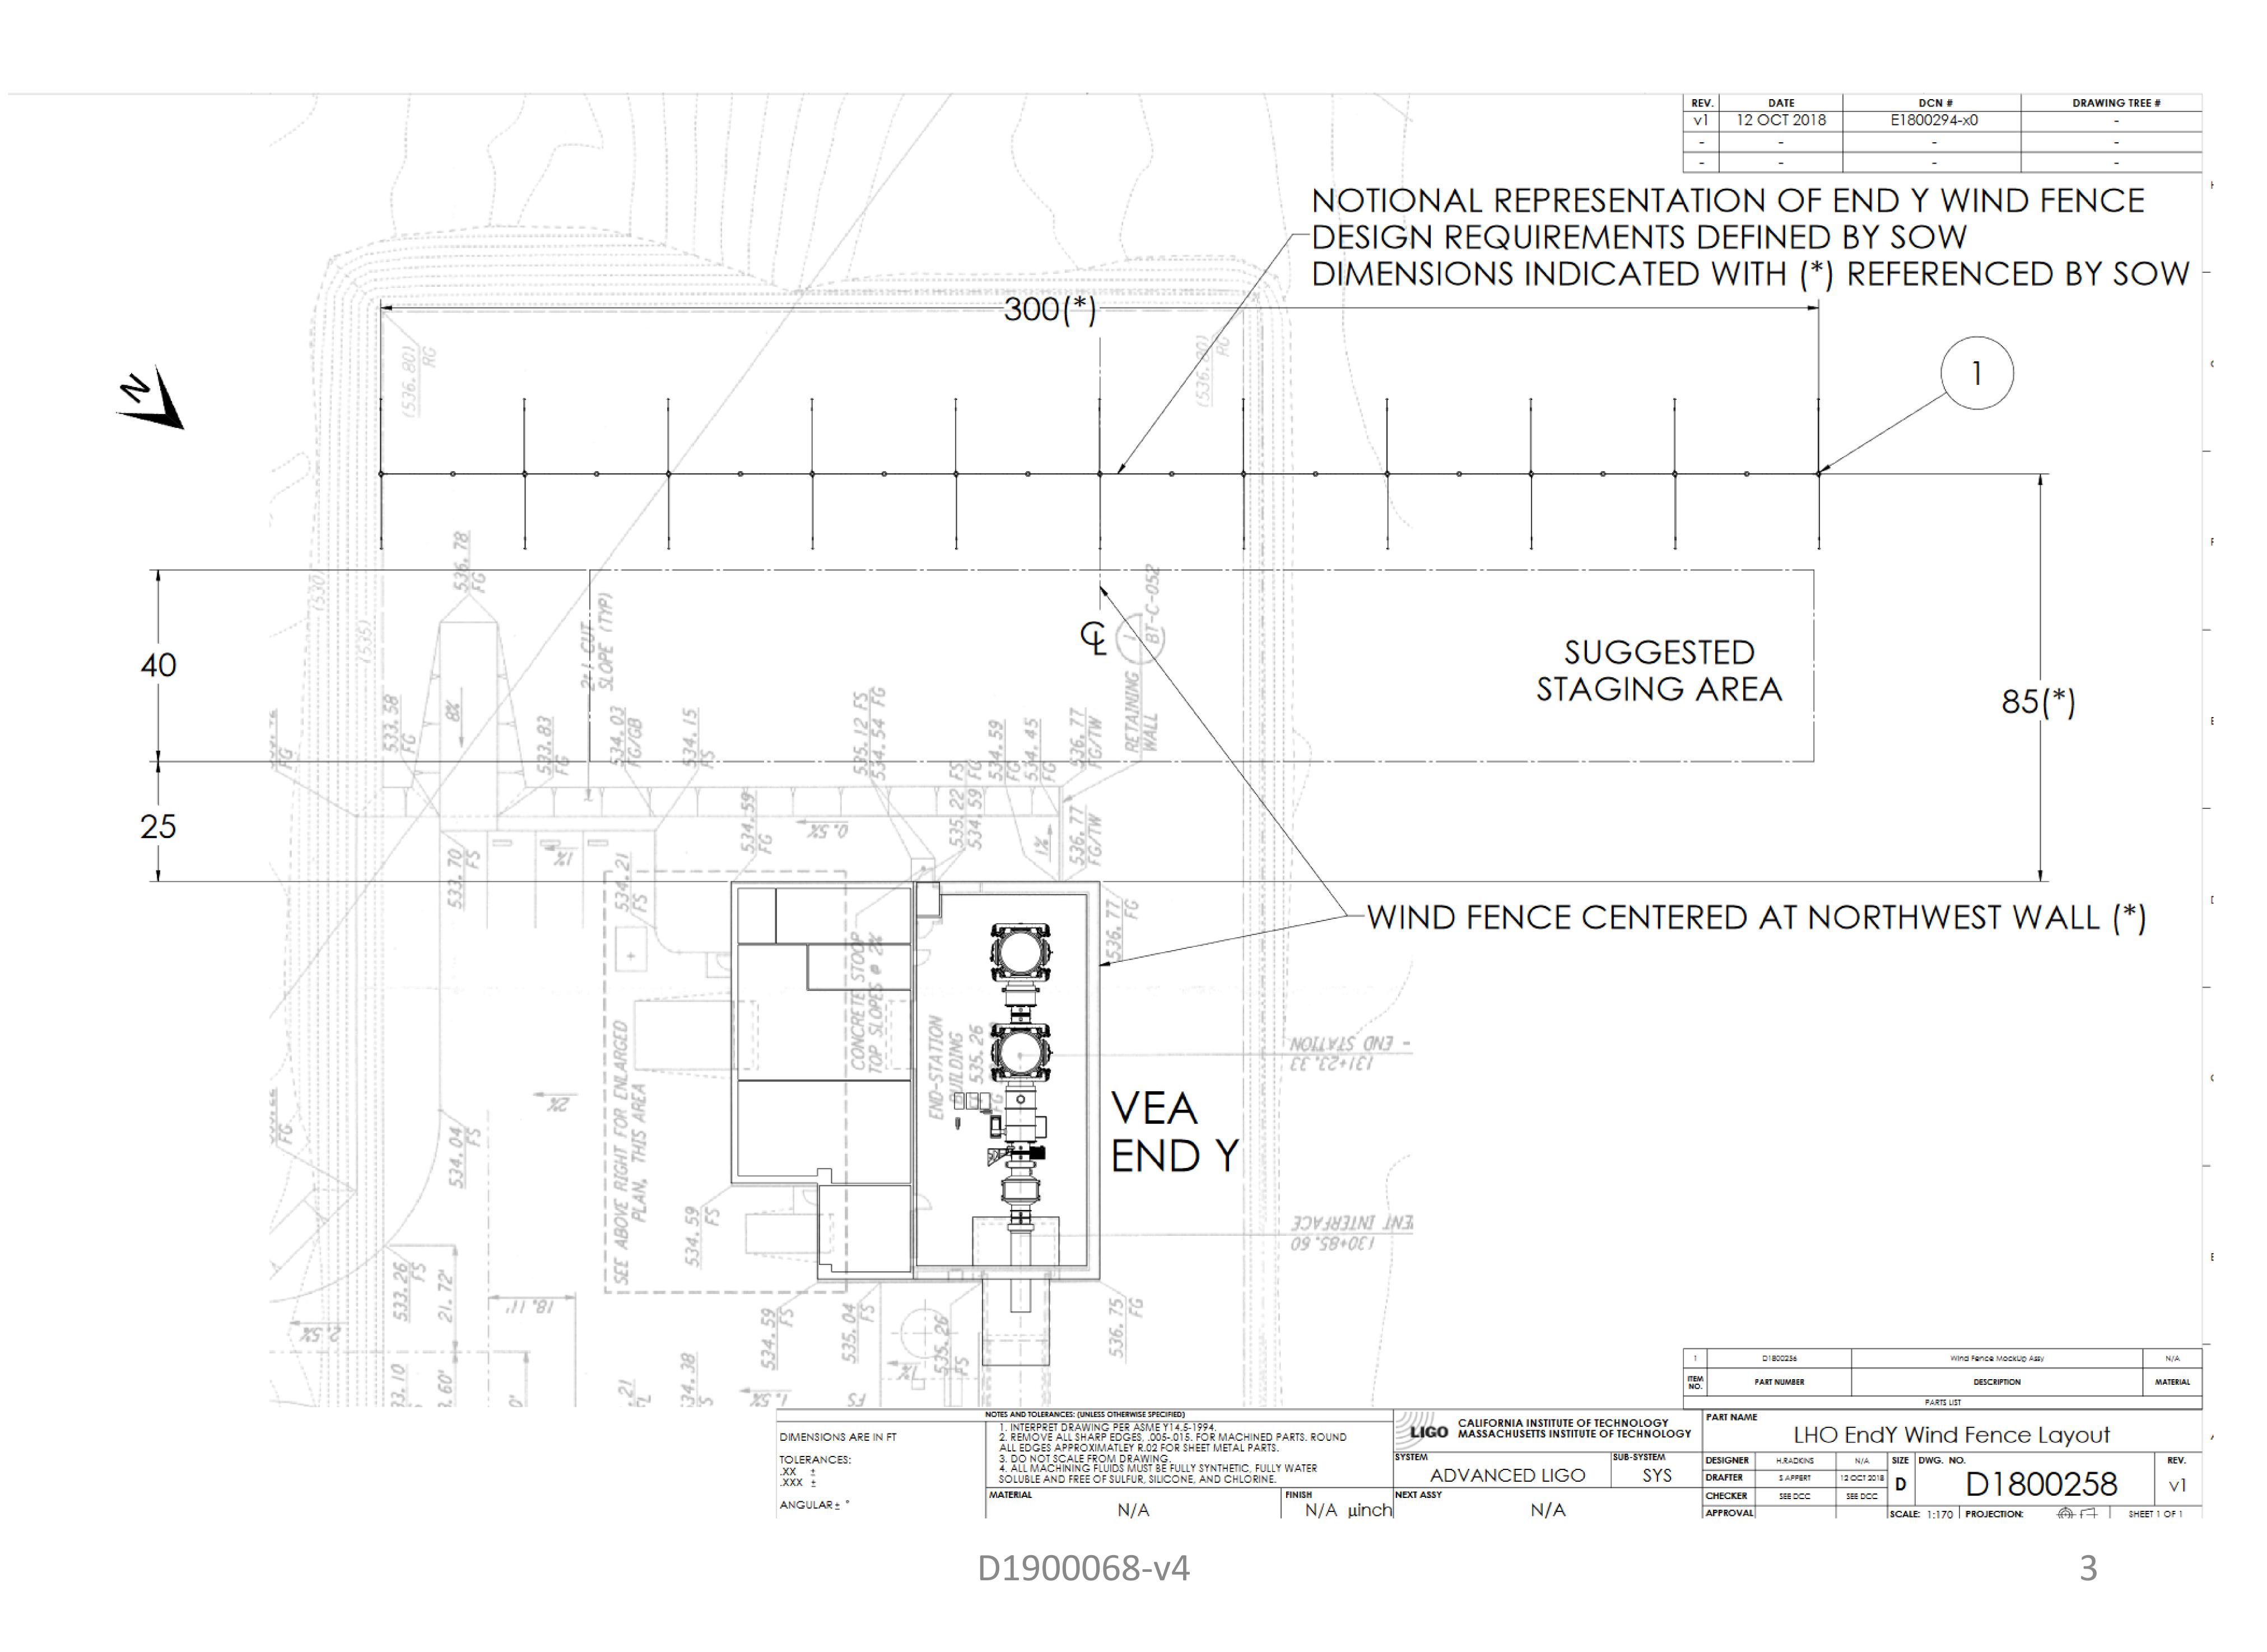


<u>CAMERA 2</u>: Y-END (AS-BUILT)

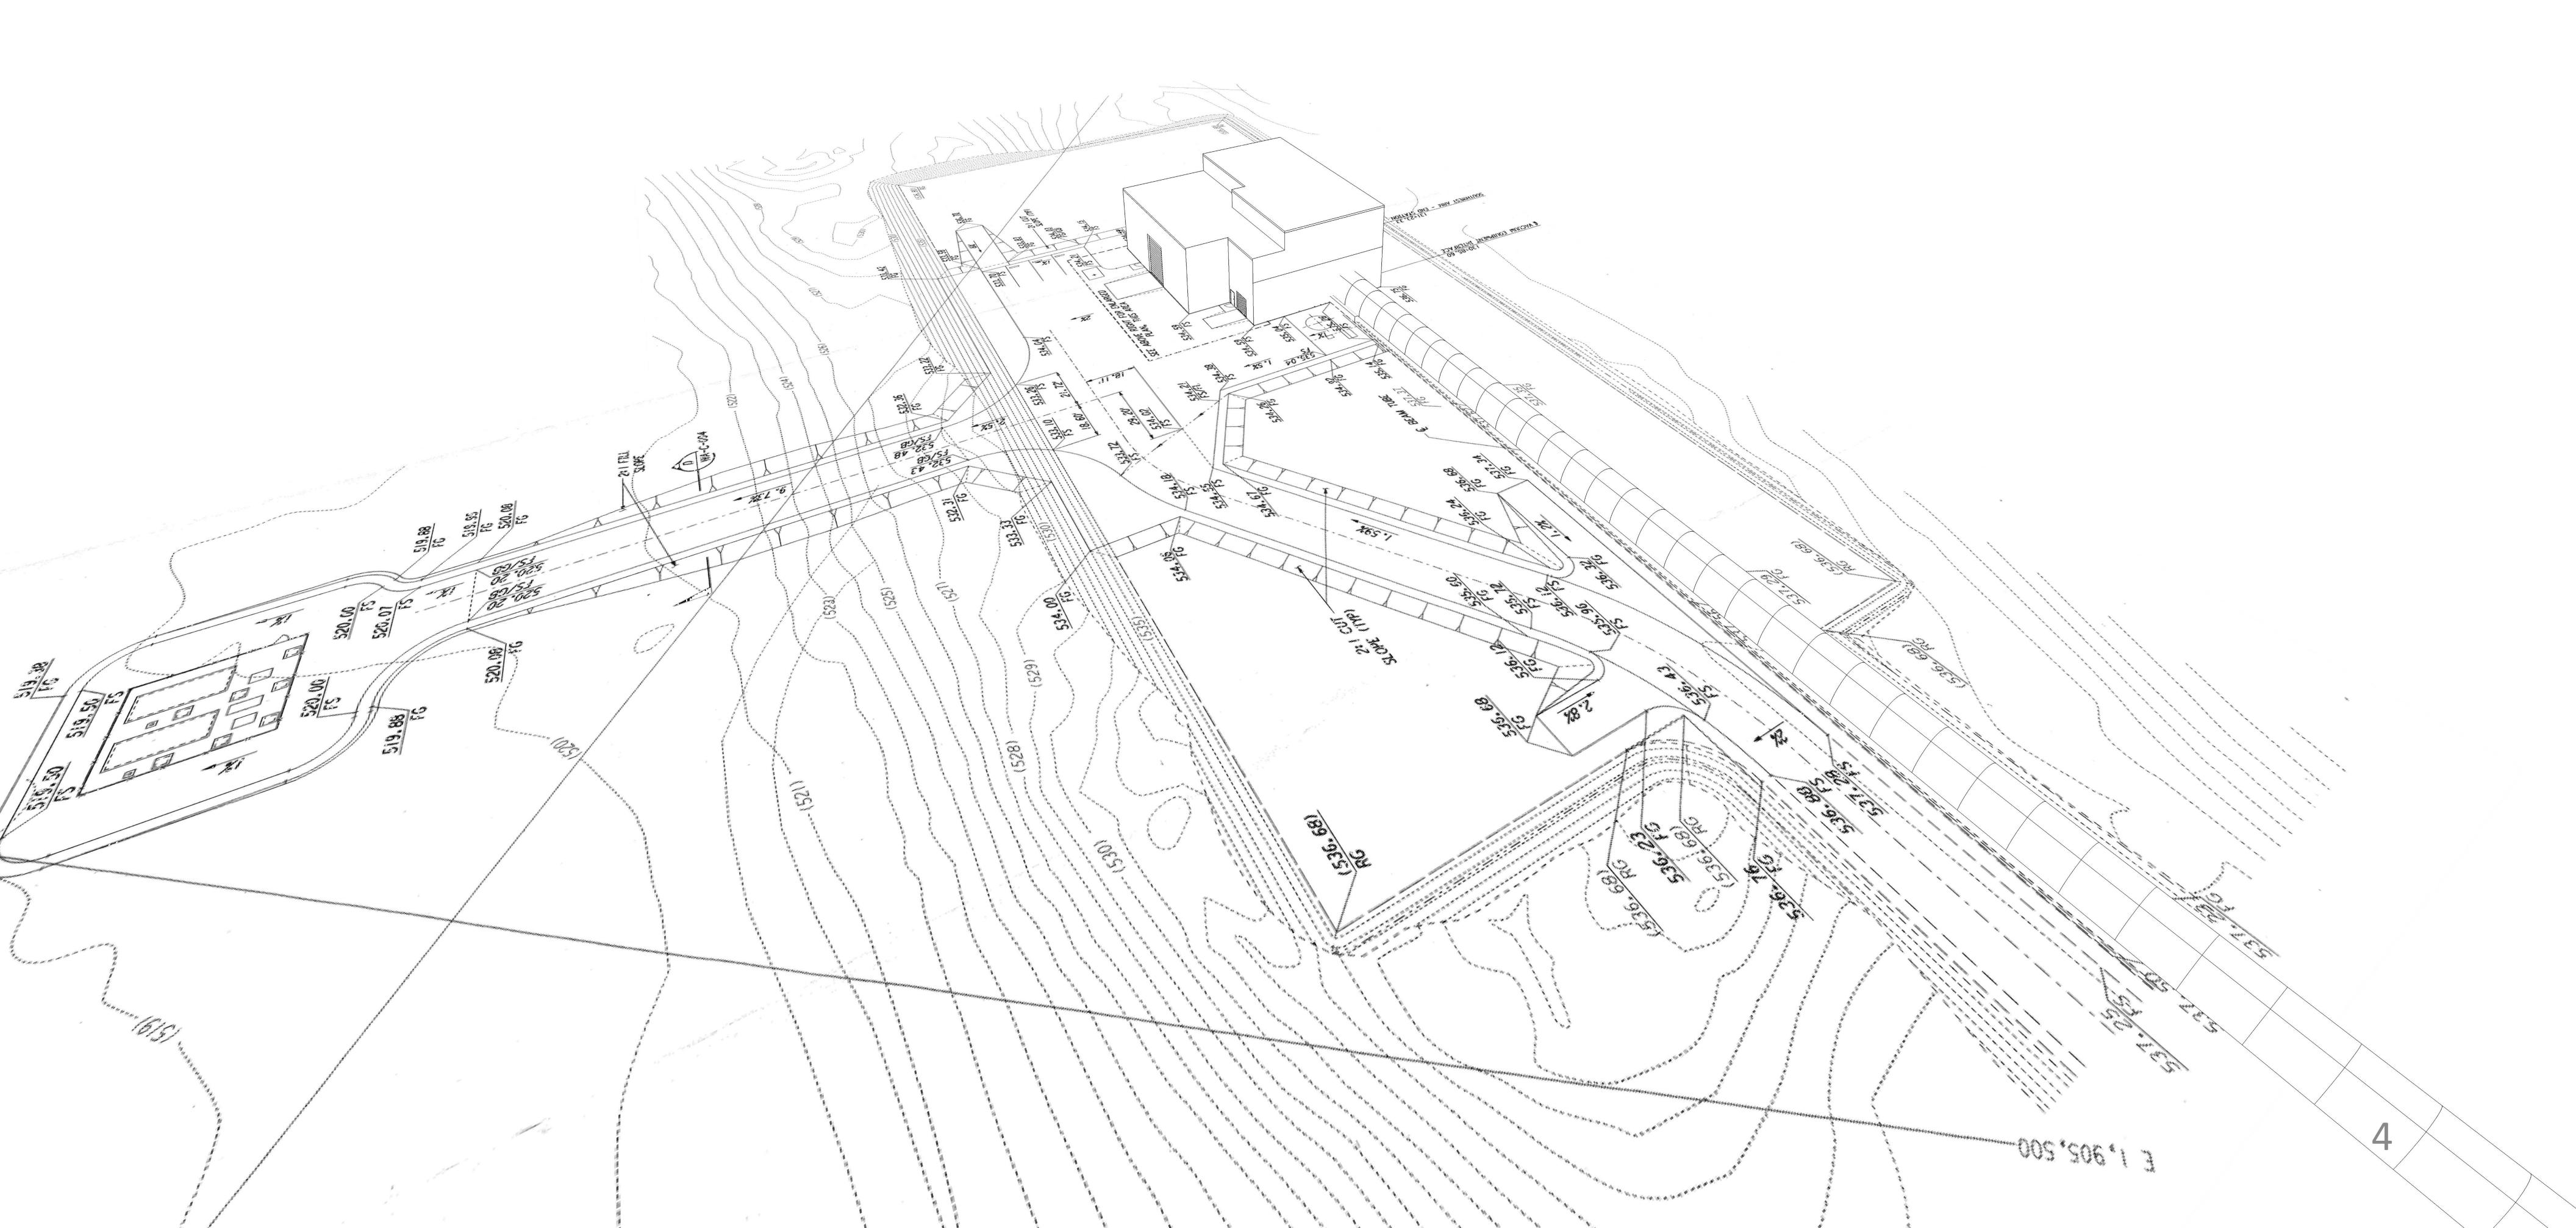


LHO WIND FENCE

<u>CAMERA 2</u>: Y-END (WITH PLANNED UPGRADE)

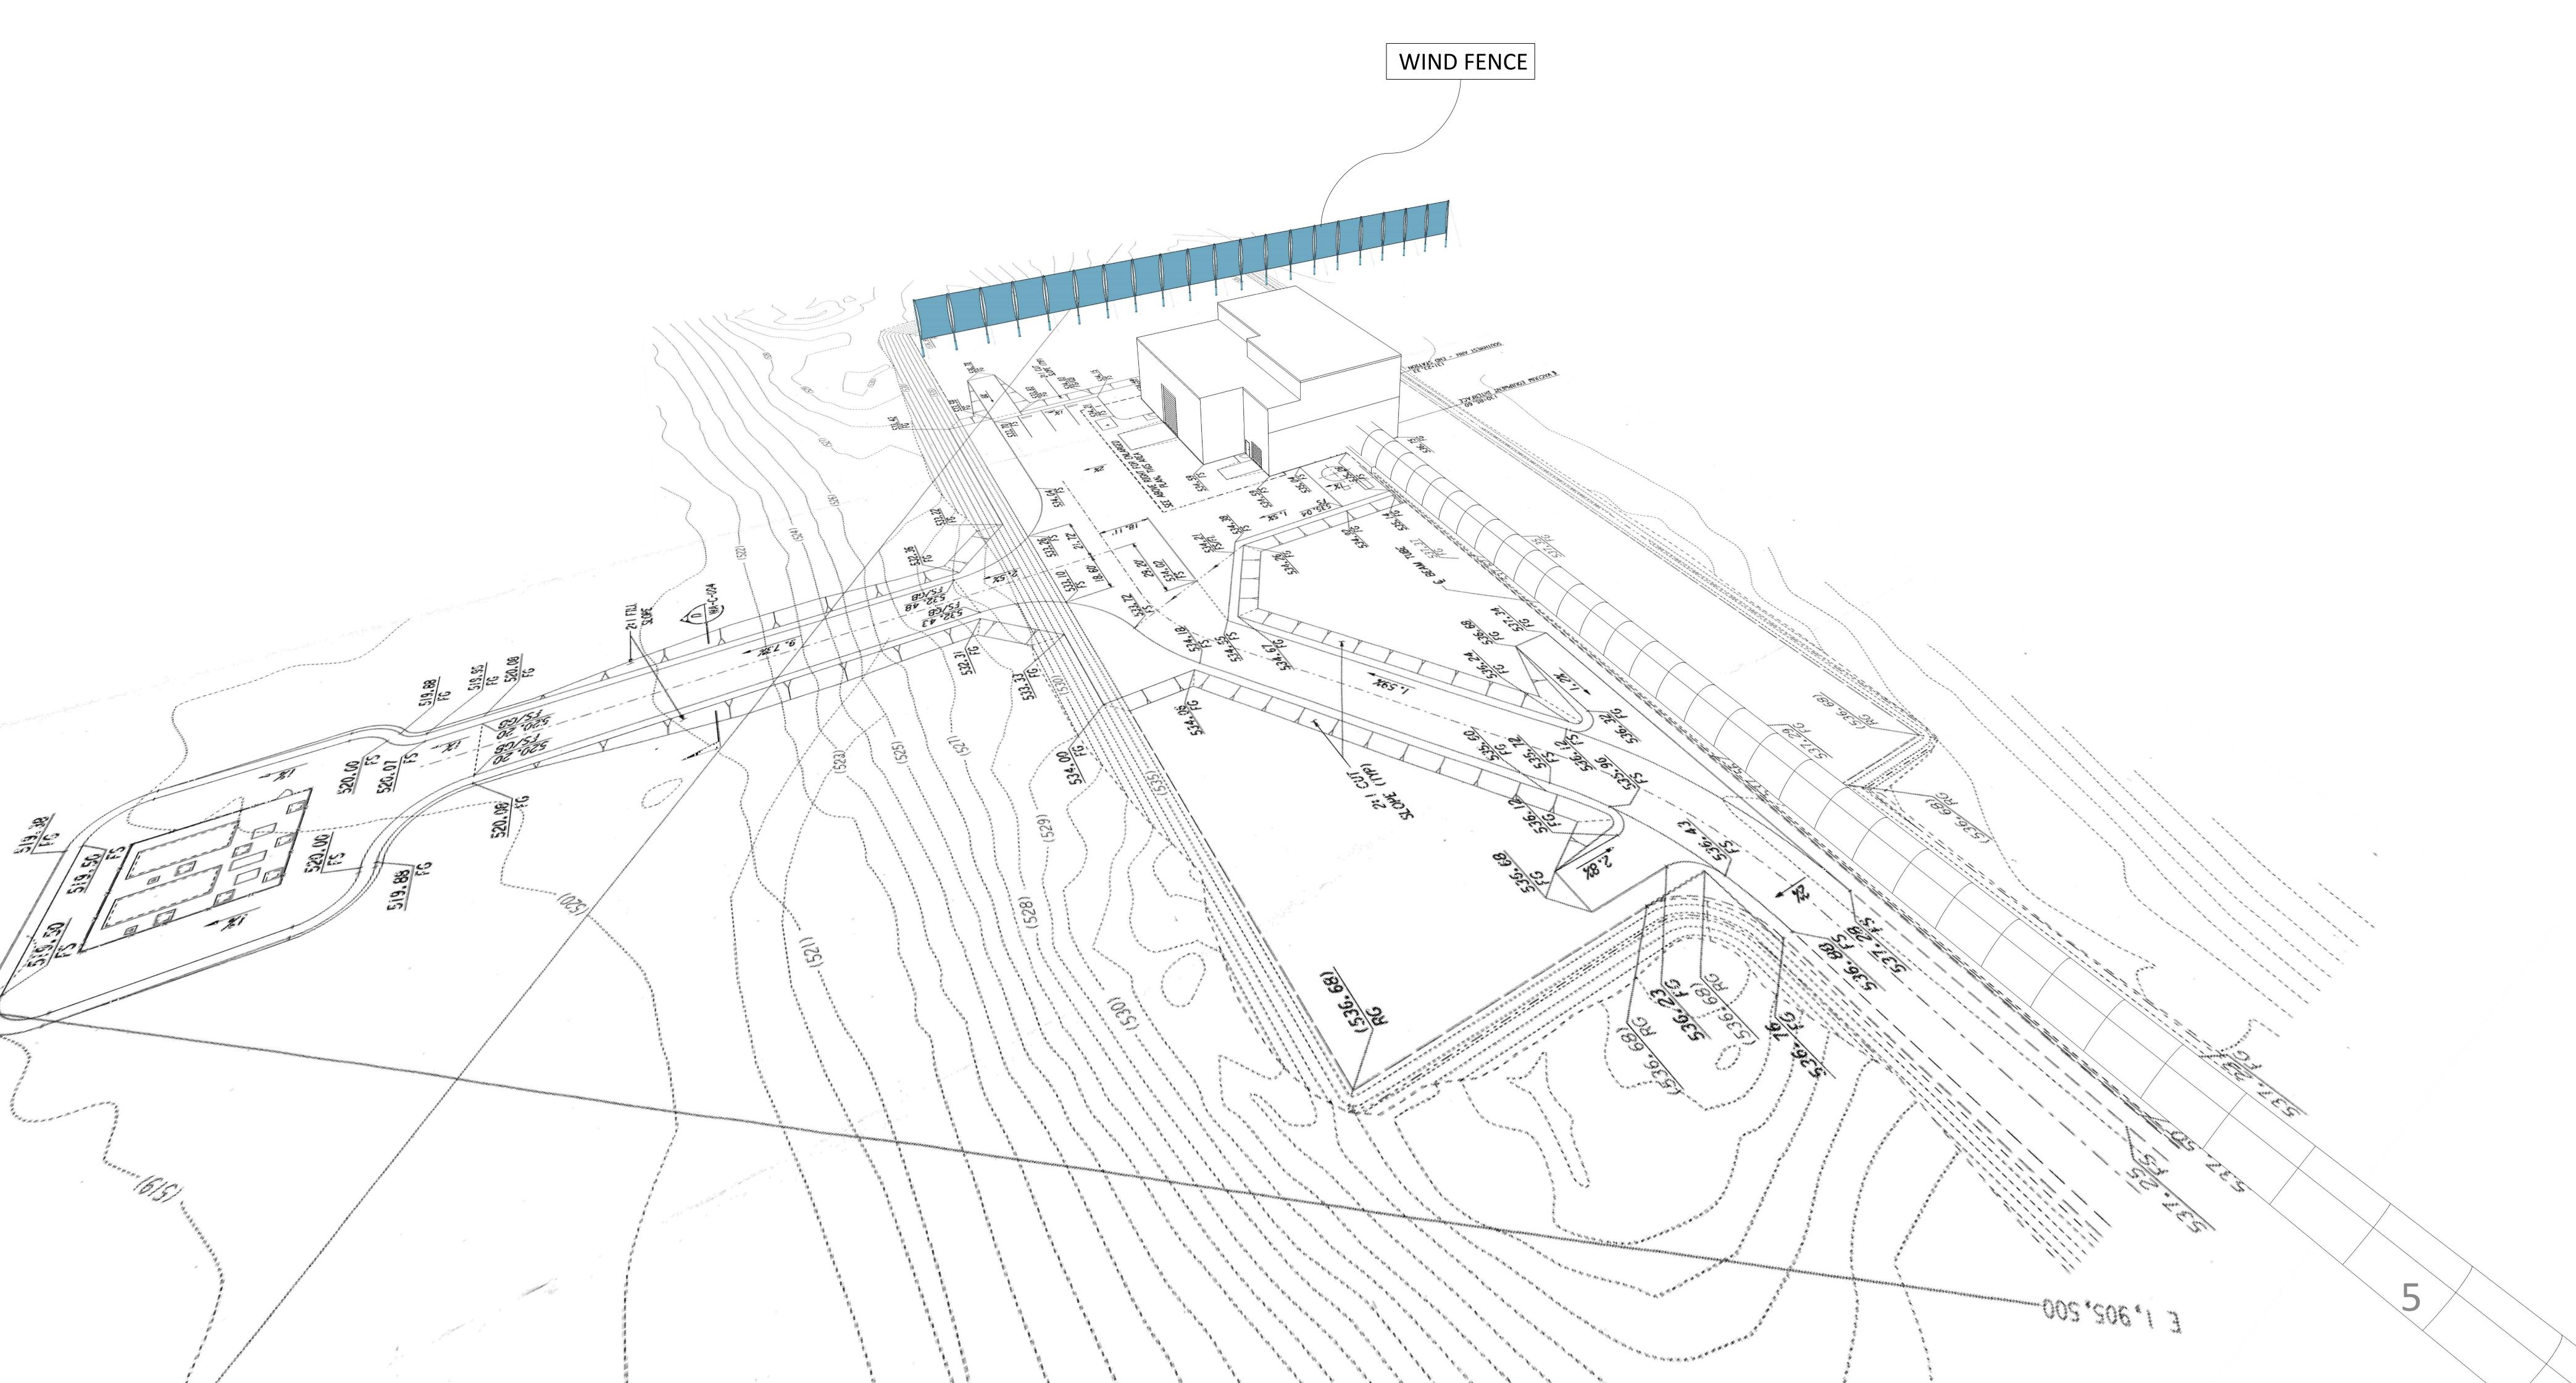


LHO WIND FENCE

<u>X-END, WIND FENCE PLAN VIEW</u>: EXTRACTED FROM <u>D1800180</u>

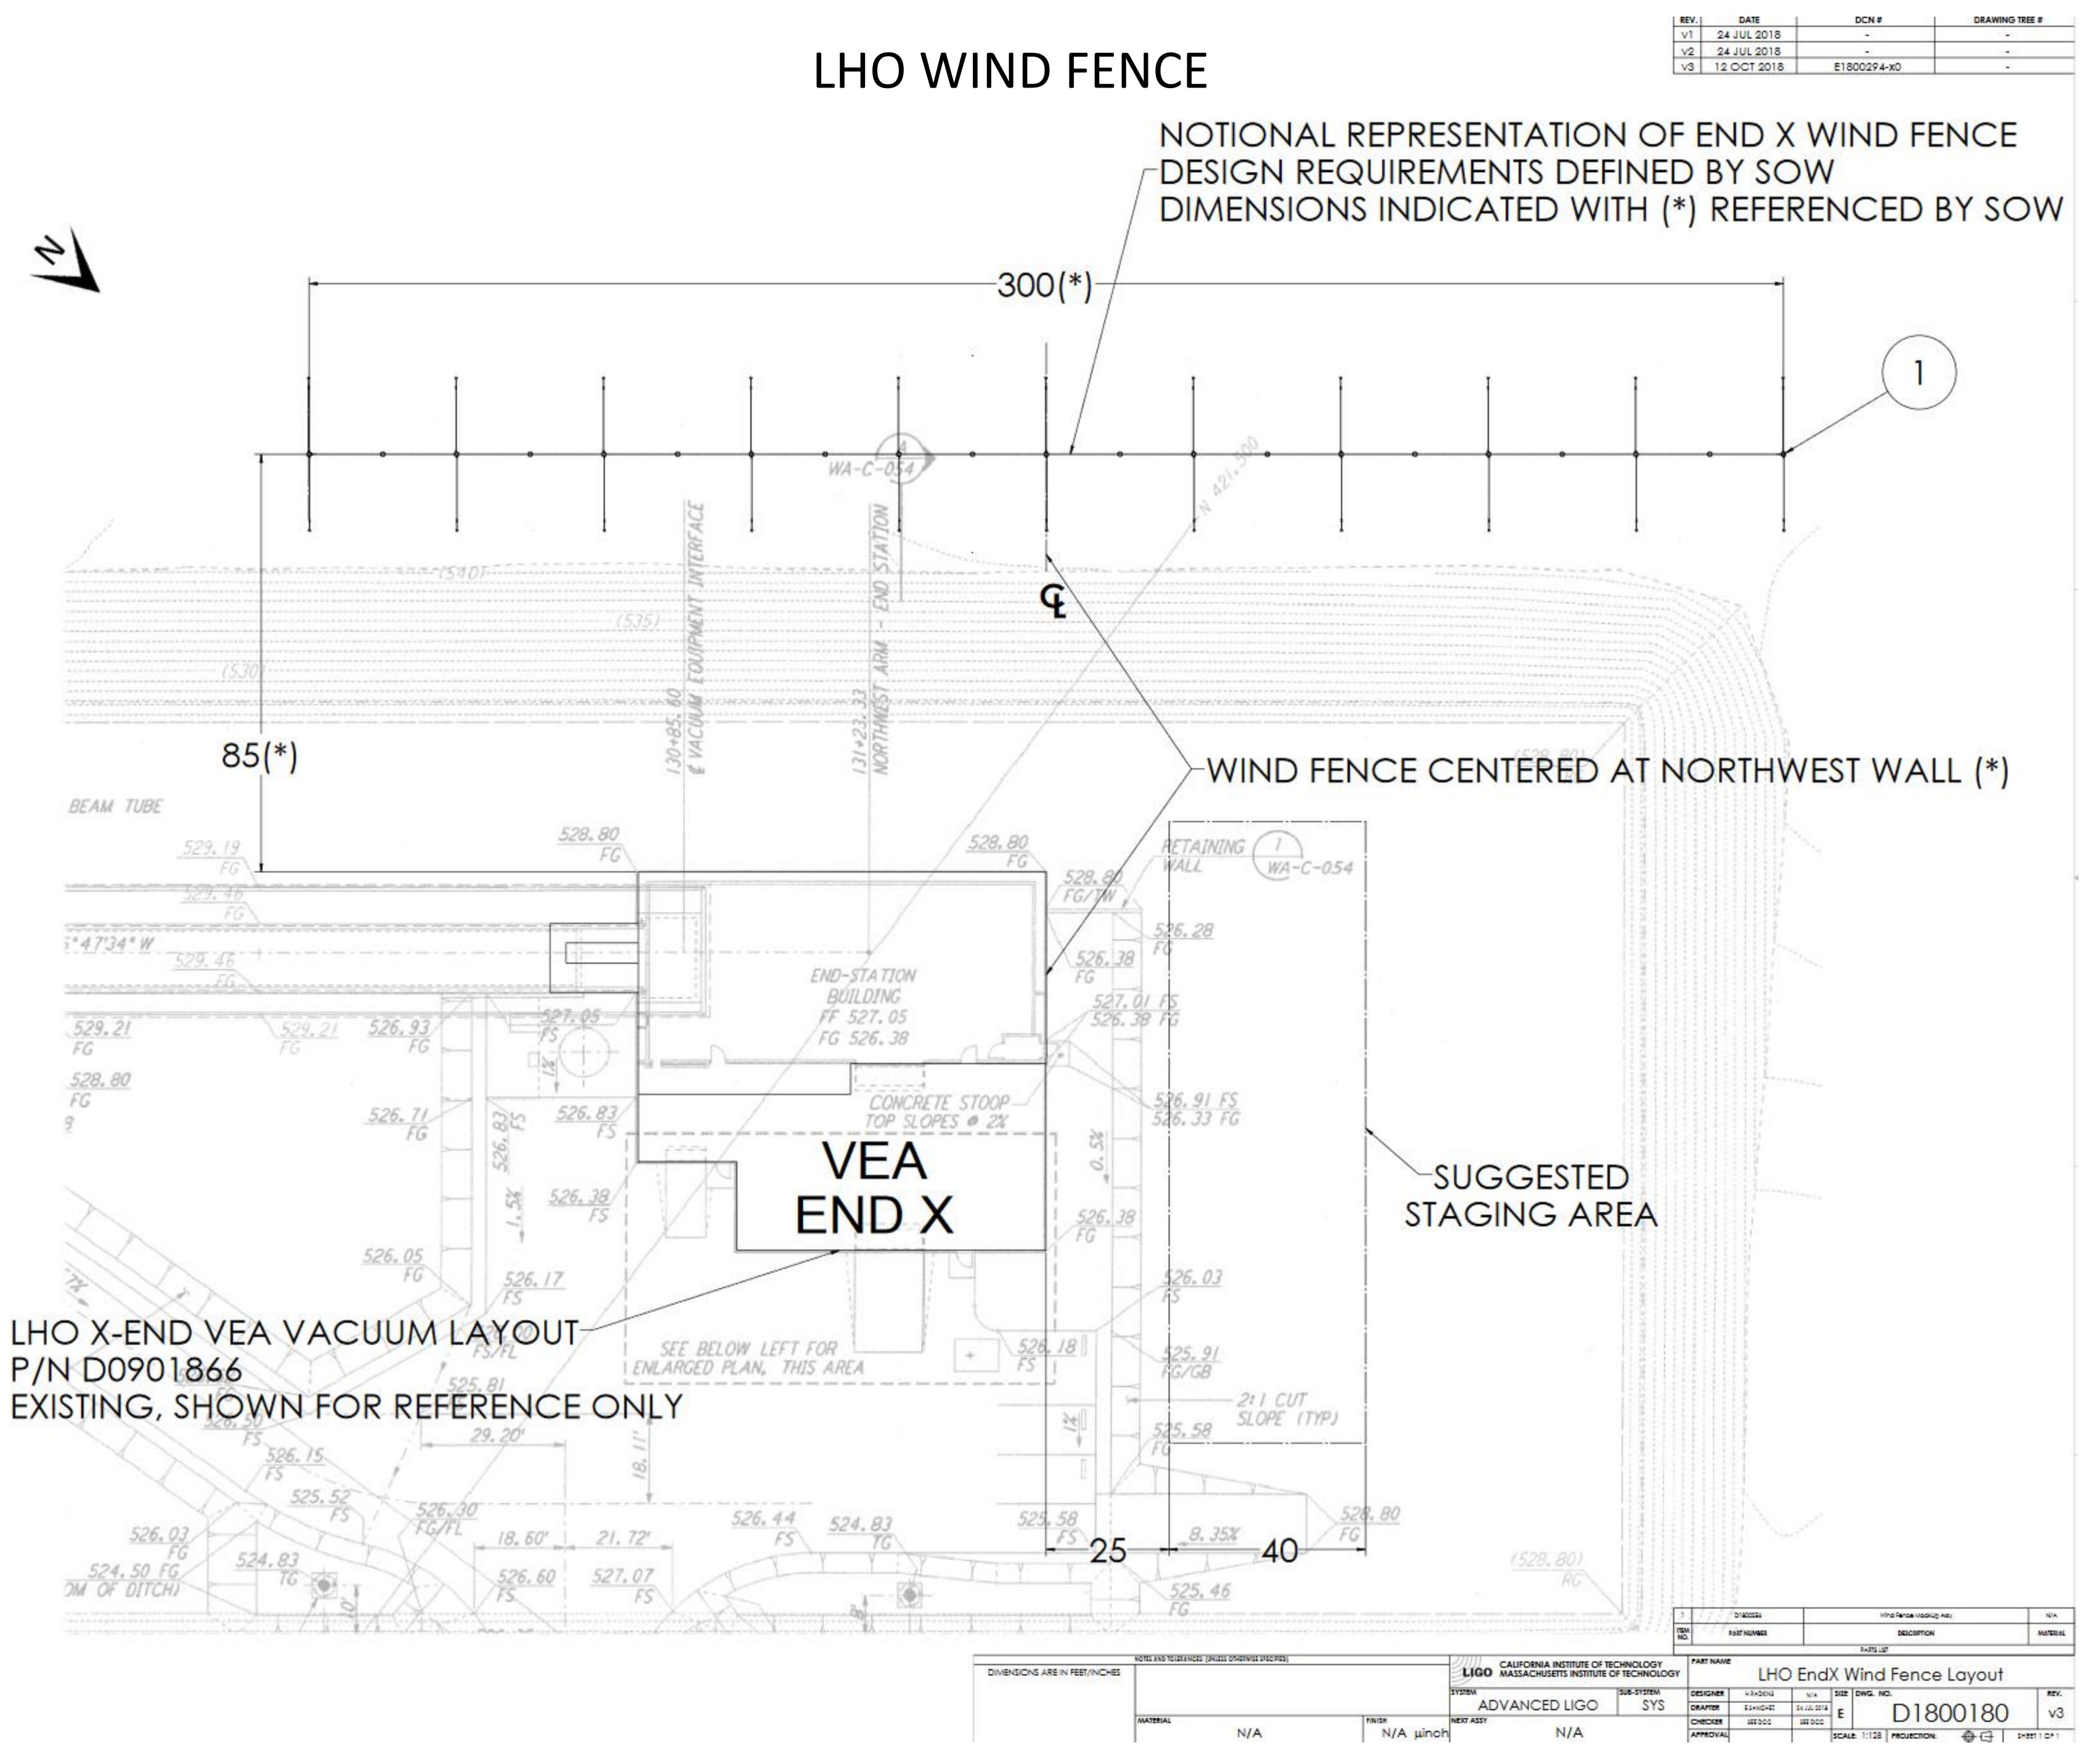


<u>CAMERA 3</u>: X-END (AS-BUILT)

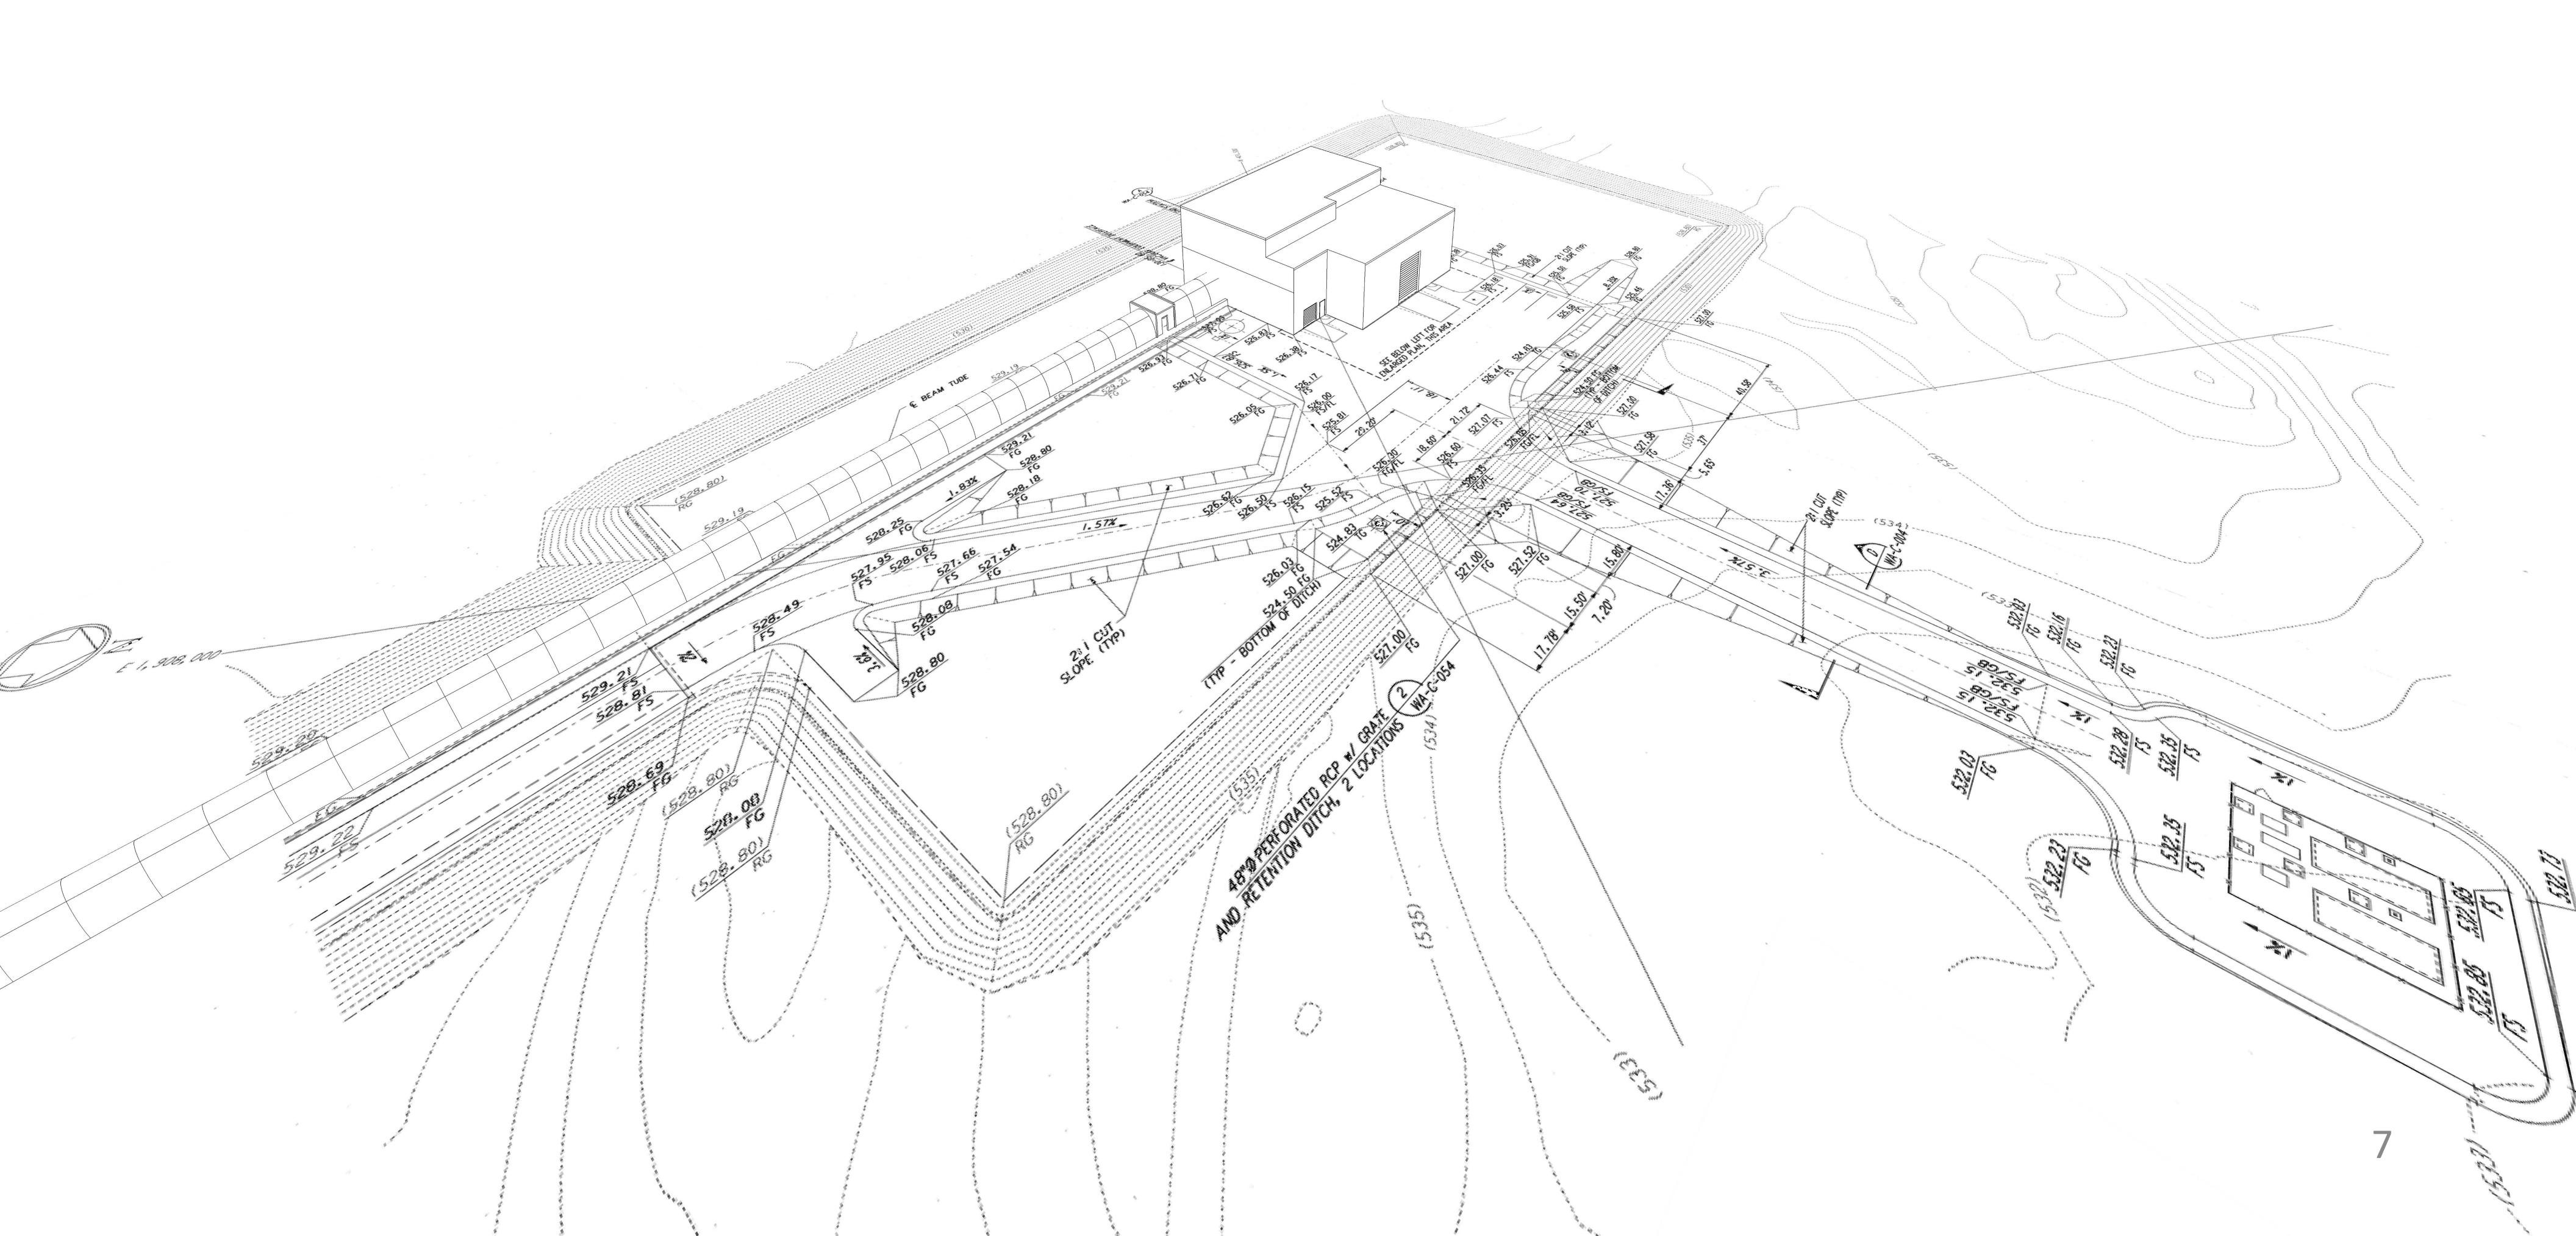


LHO WIND FENCE

<u>CAMERA 3</u>: X-END (WITH PLANNED UPGRADE)

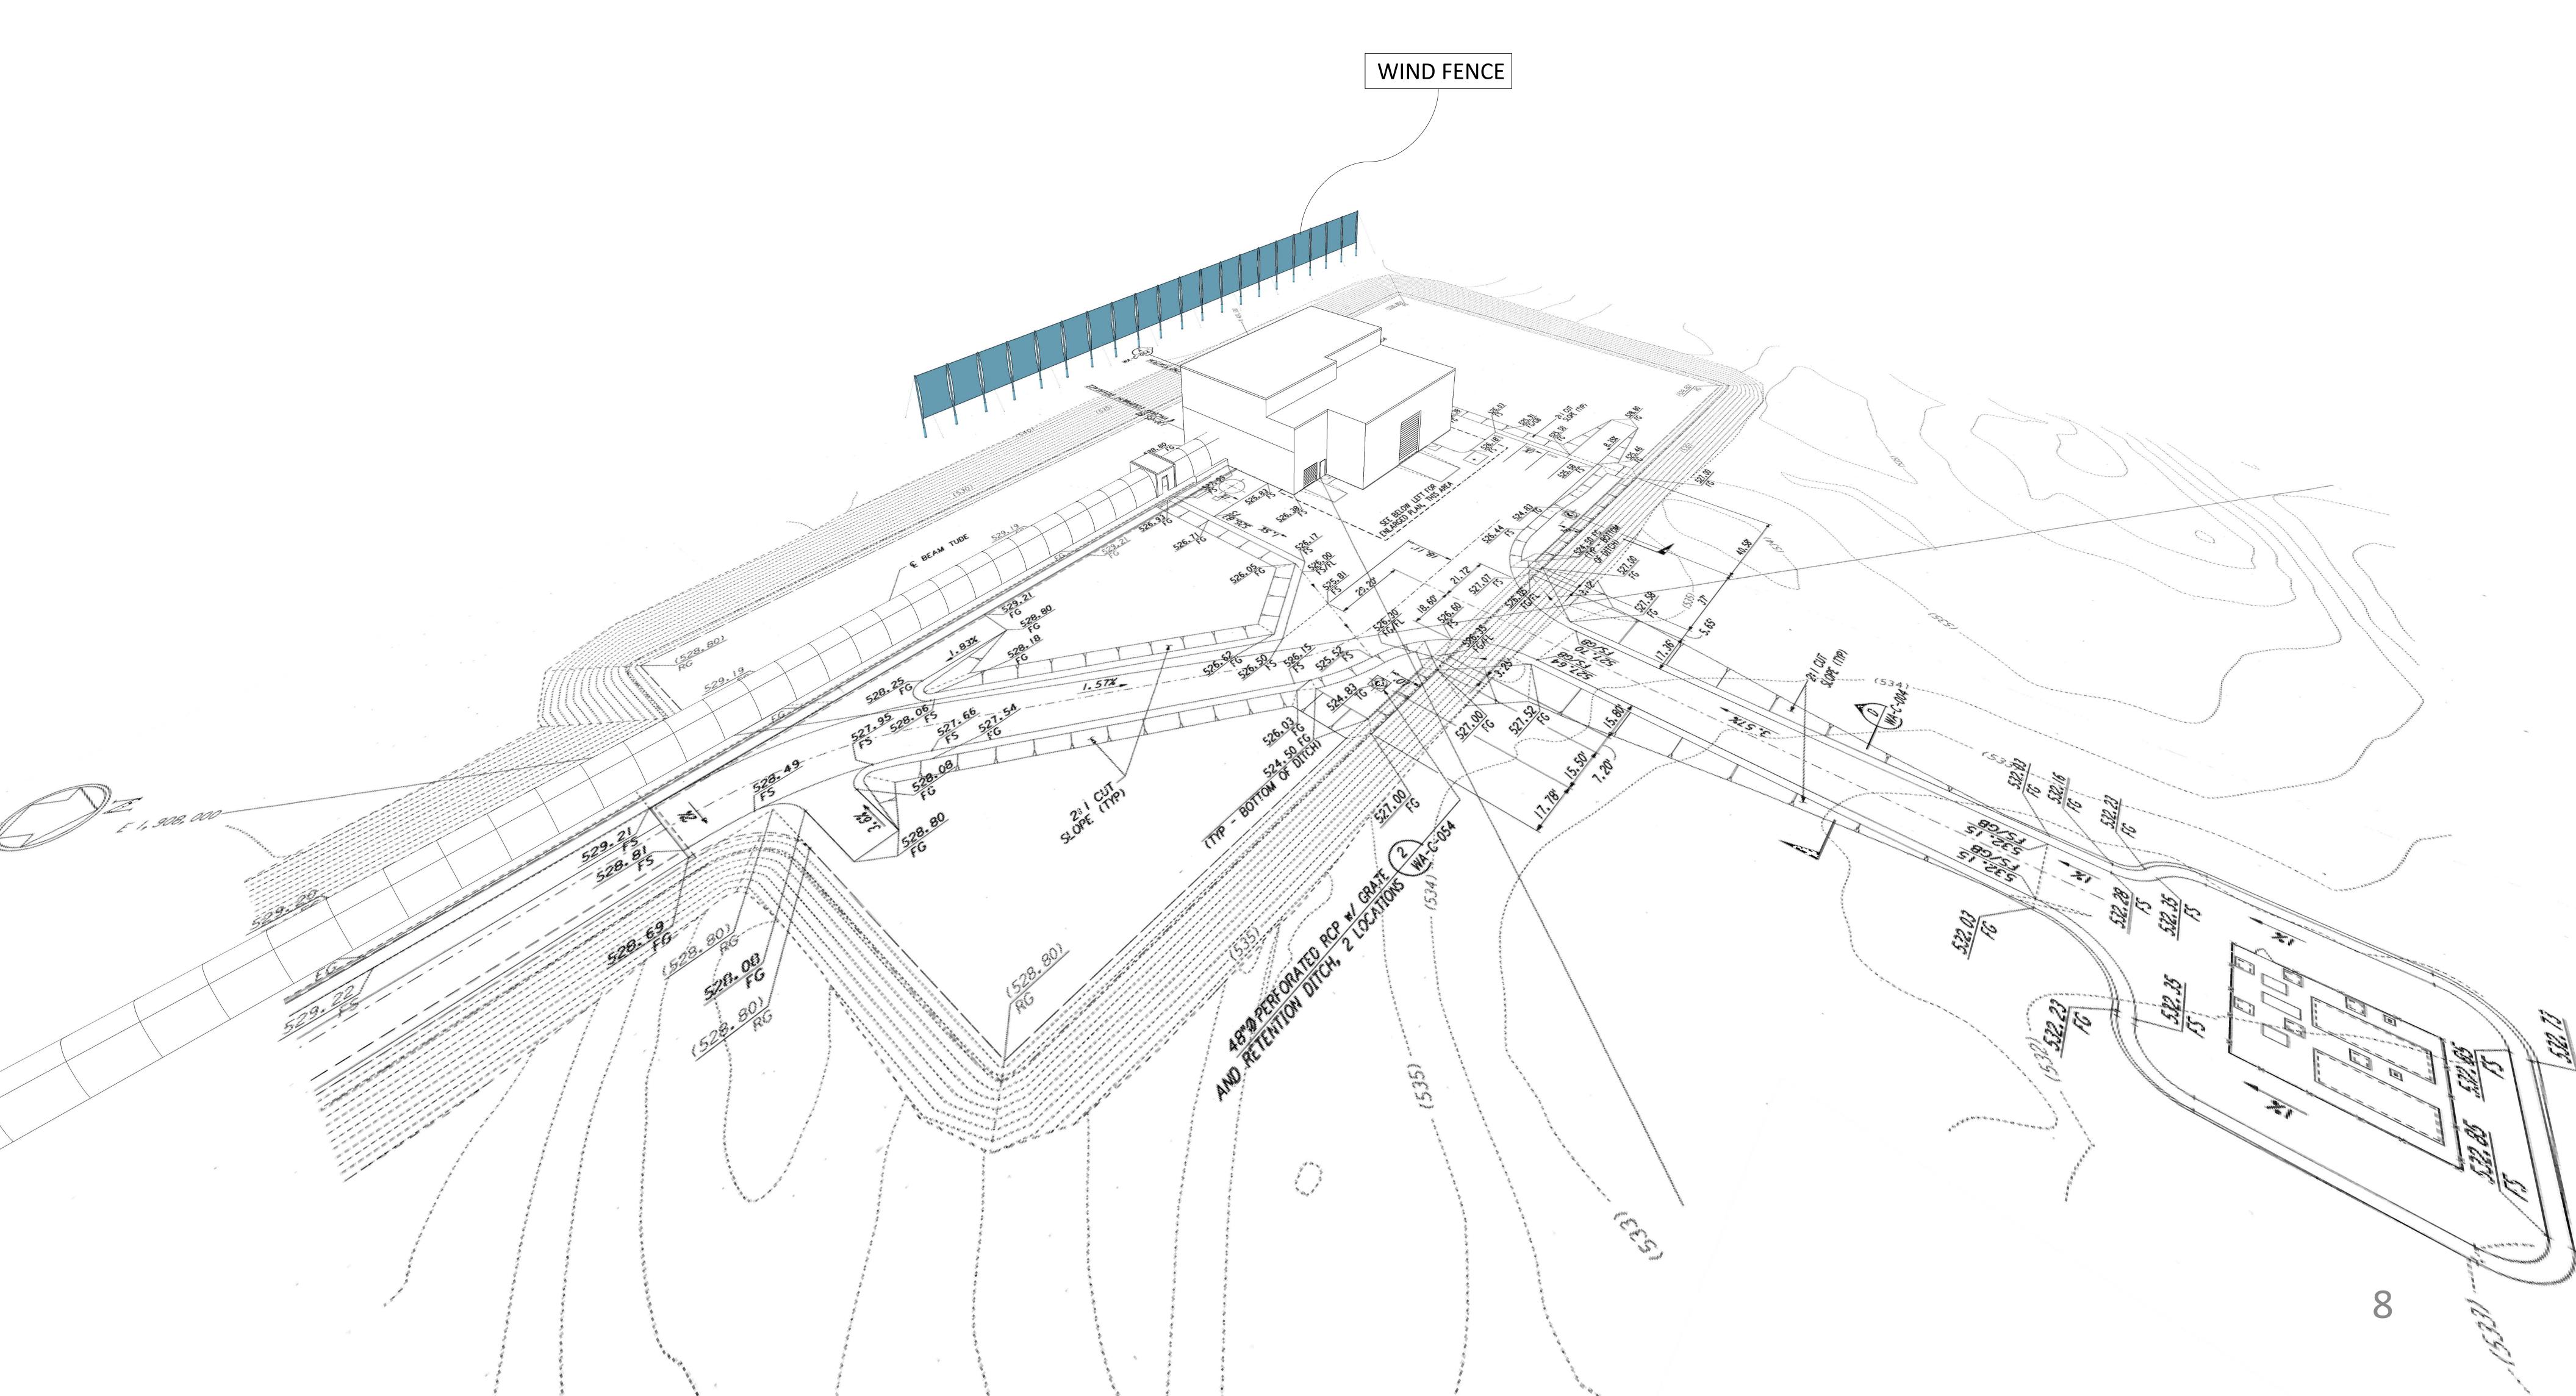

LHO WIND FENCE


LHO: 300m FC PLAN VIEW (EXTRACTED FROM D1800241)

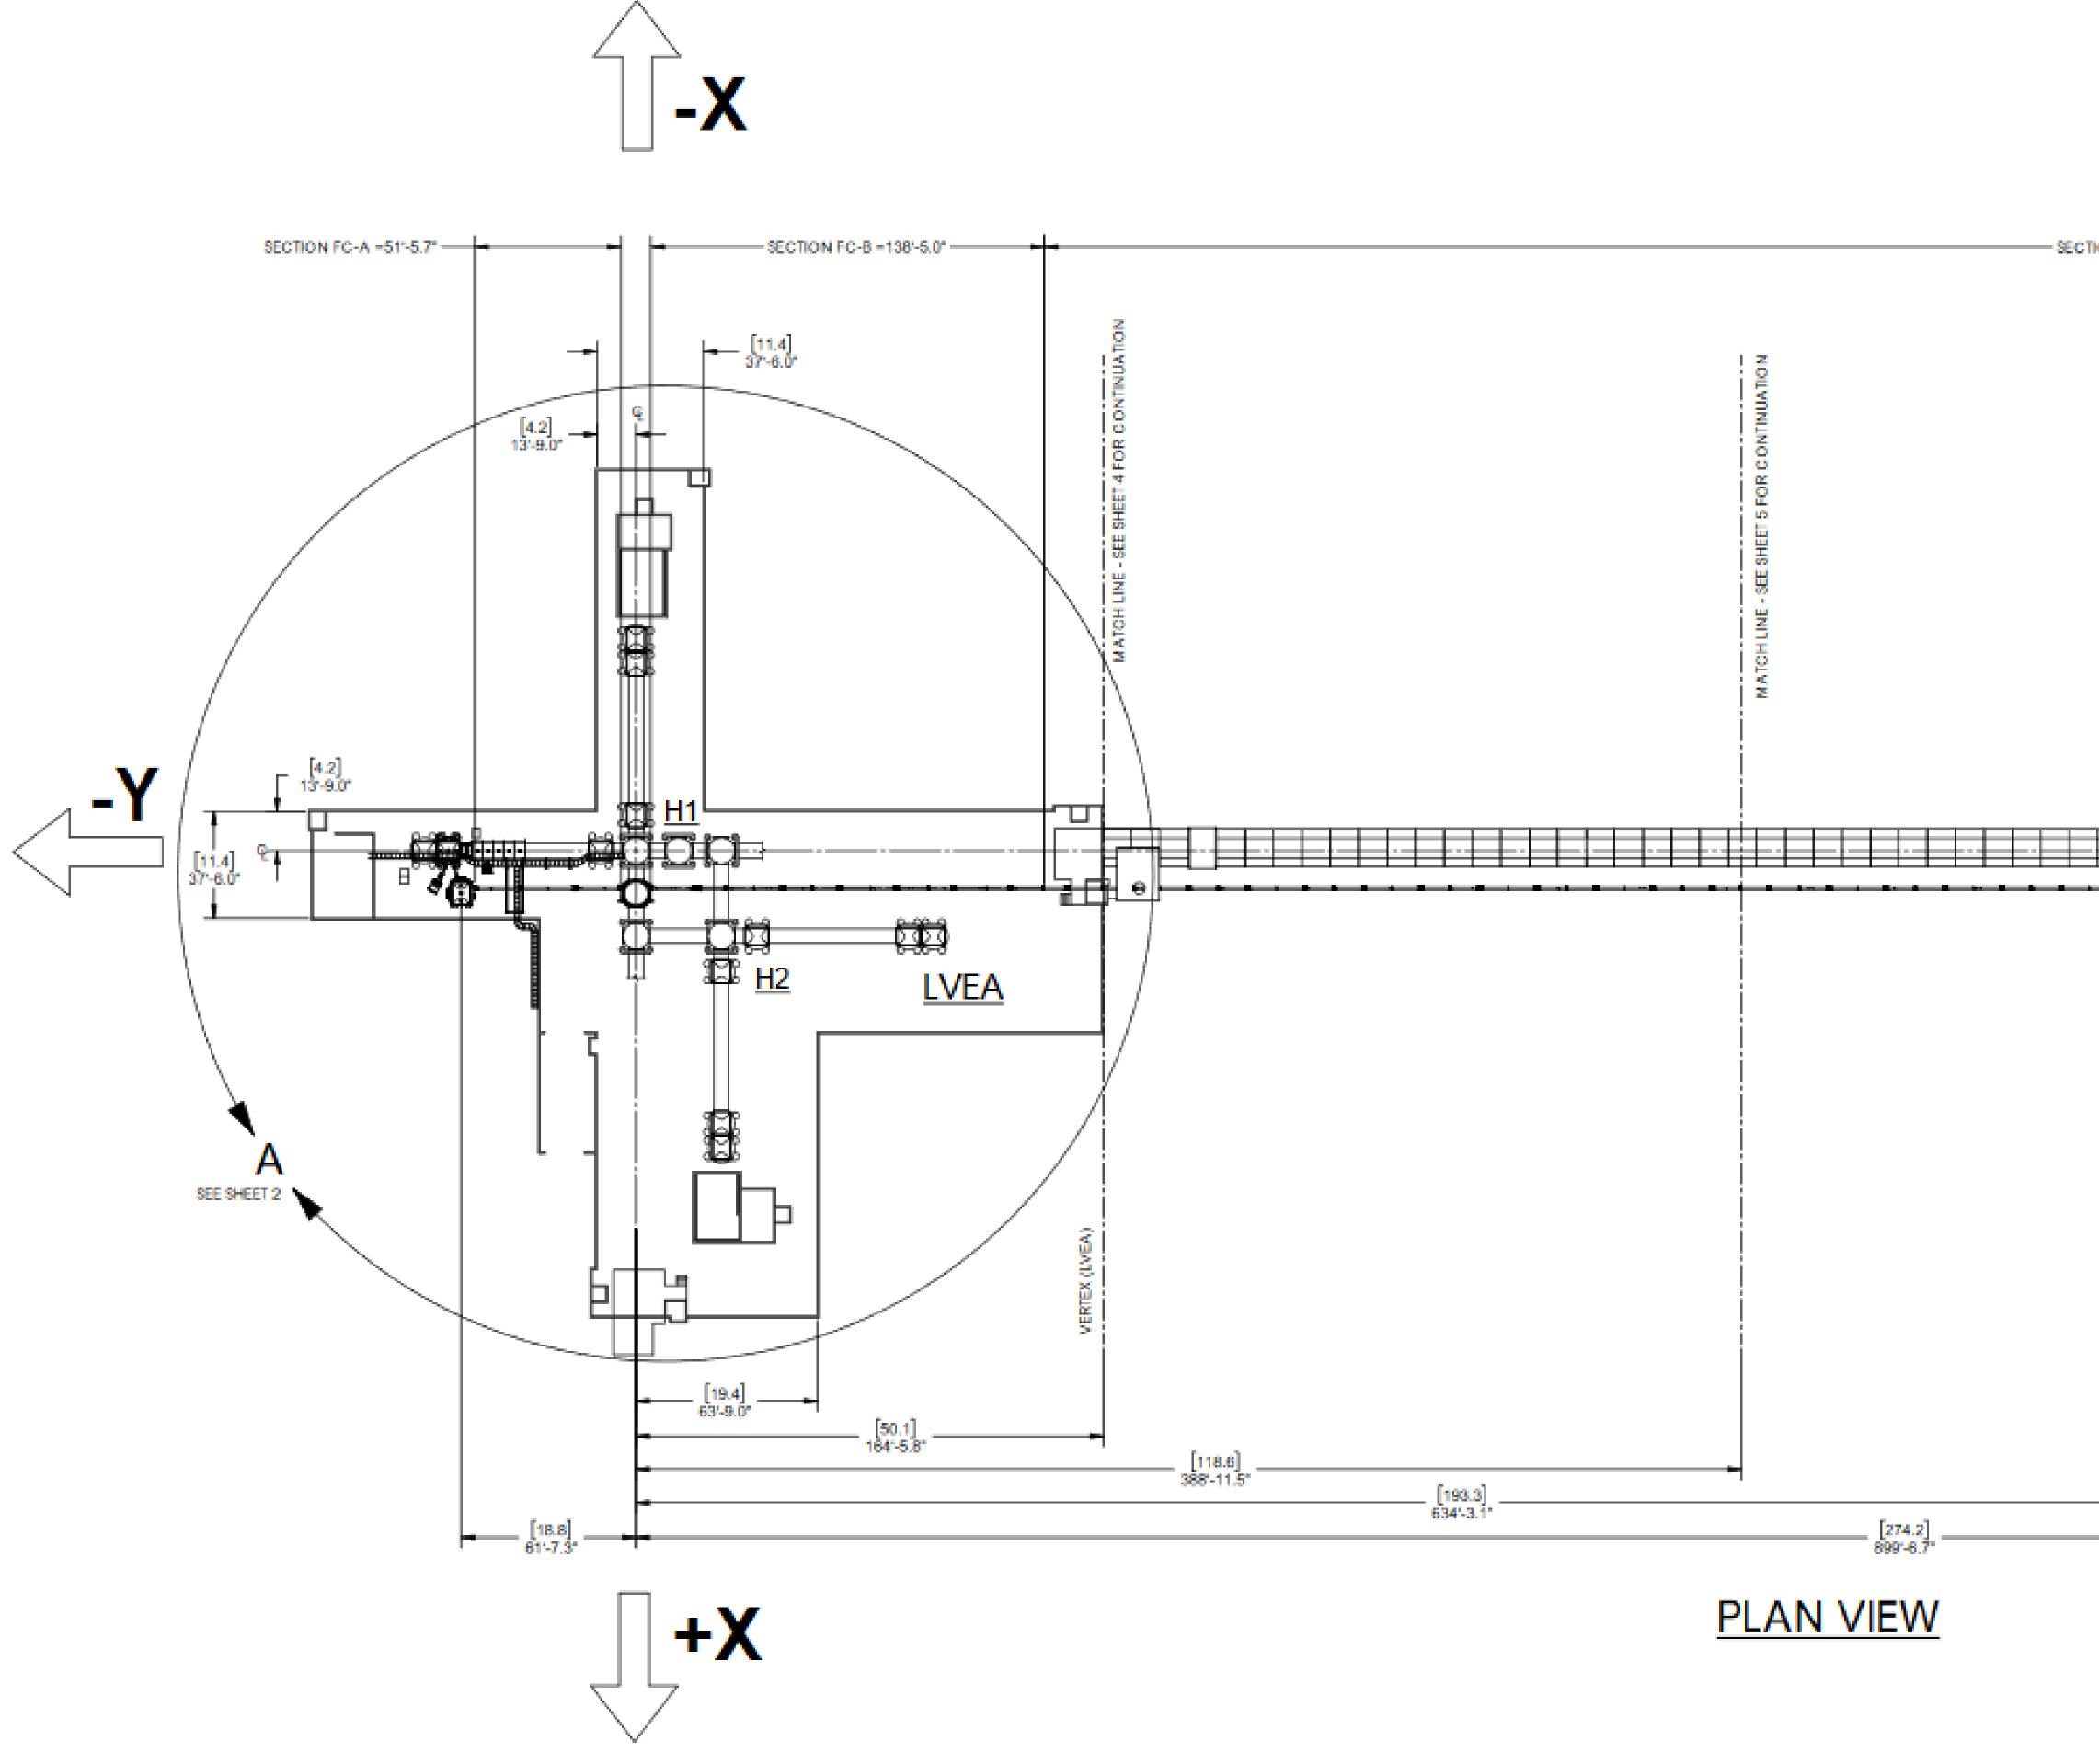


A+ PROJECT

I REAL	LIAIC	
v1	18 SEP 2018	
v4	21 DEC 2018	
v5	06 MAR 2019	

and the second secon	0 = 75	5'-10	(9 * -																															_
										MATCH LINE - SEE SHEET 6 FOR CONTINUATION																								
				F	F	F		-	-				F	-		F	Ŧ		Ŧ		F	Ŧ	+		F		F		-		+	=	7	
	Ľ			E		E		-		_	_		E	-	_	-	-	 _			⊨	_		_		-		÷				Ξ		1
_	_	_				_	-					-	-	_			_	_						_			_		 _	-			÷	
								•																										

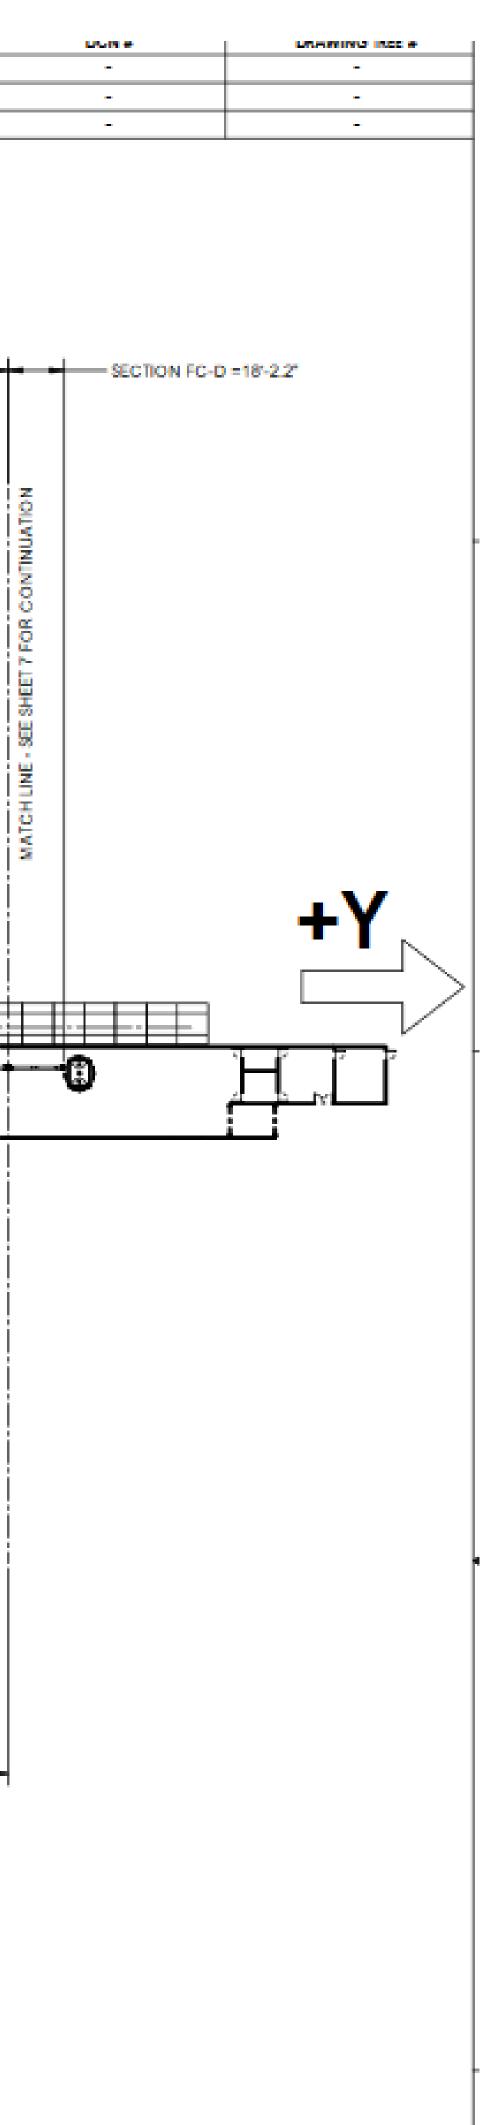


CAMERA 4: CORNER STATION (AS-BUILT)

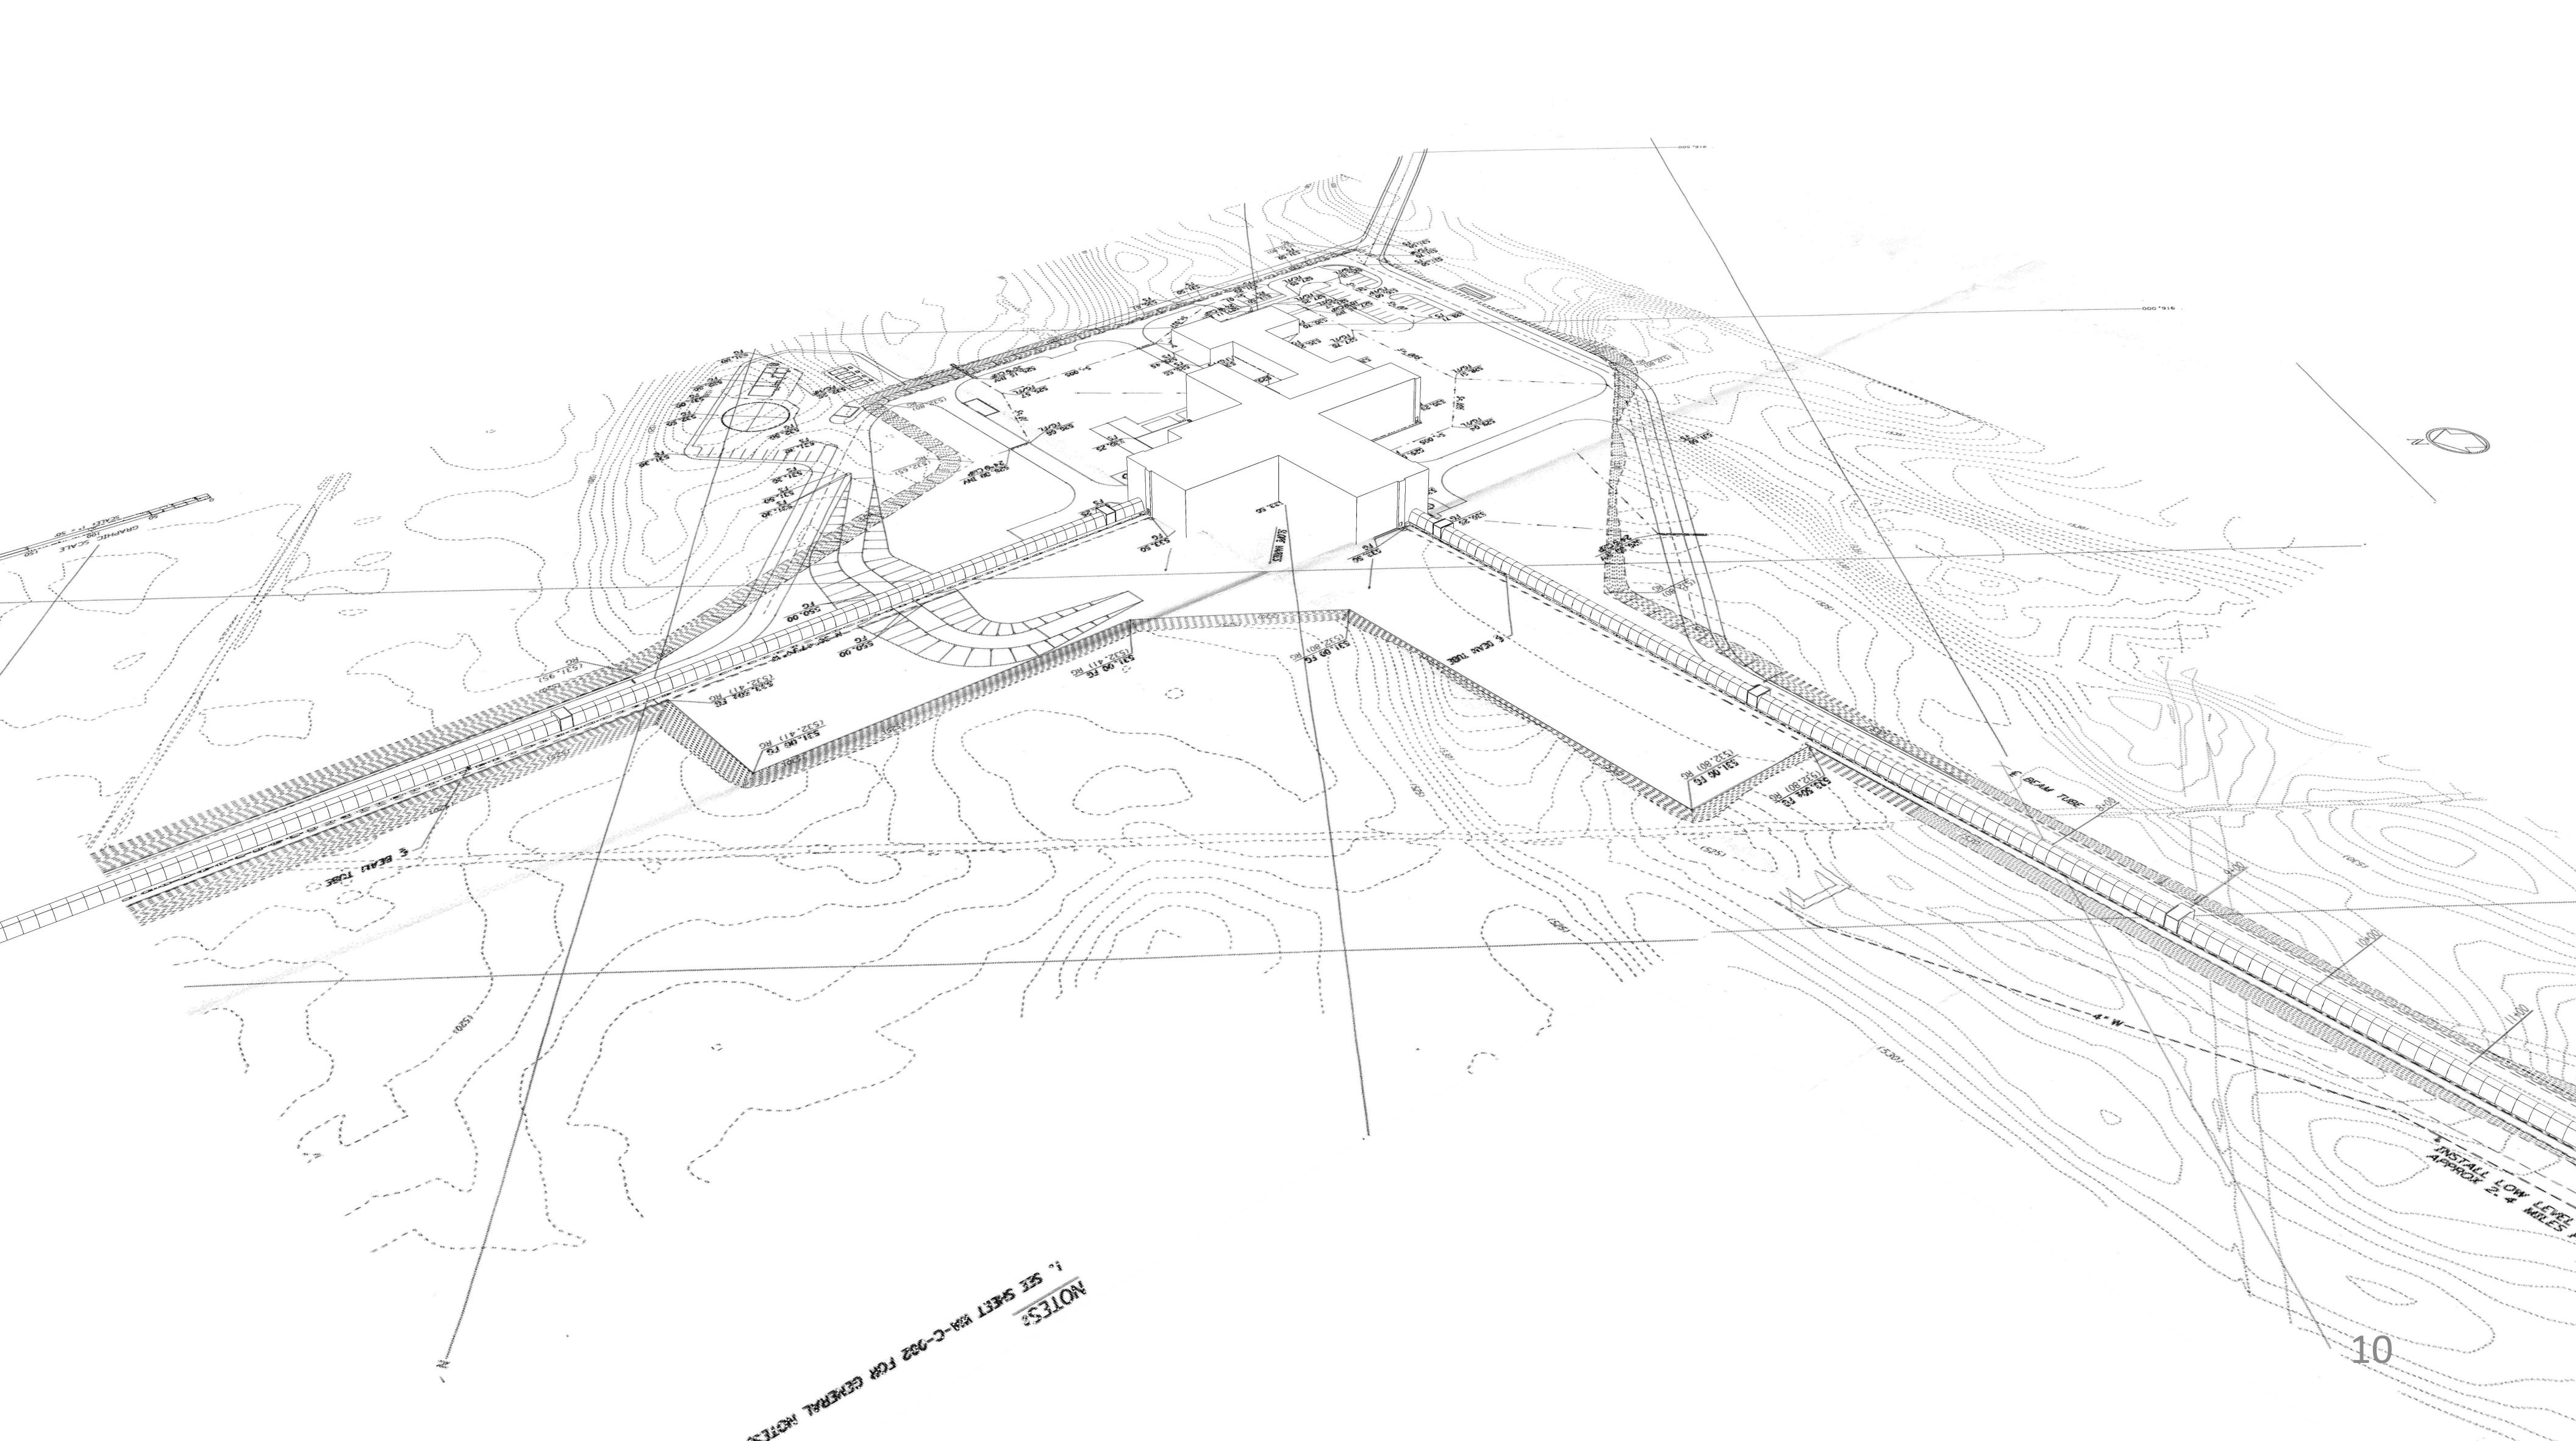


A+ PROJECT


<u>CAMERA 4</u>: CORNER STATION (WITH PLANNED UPGRADE)

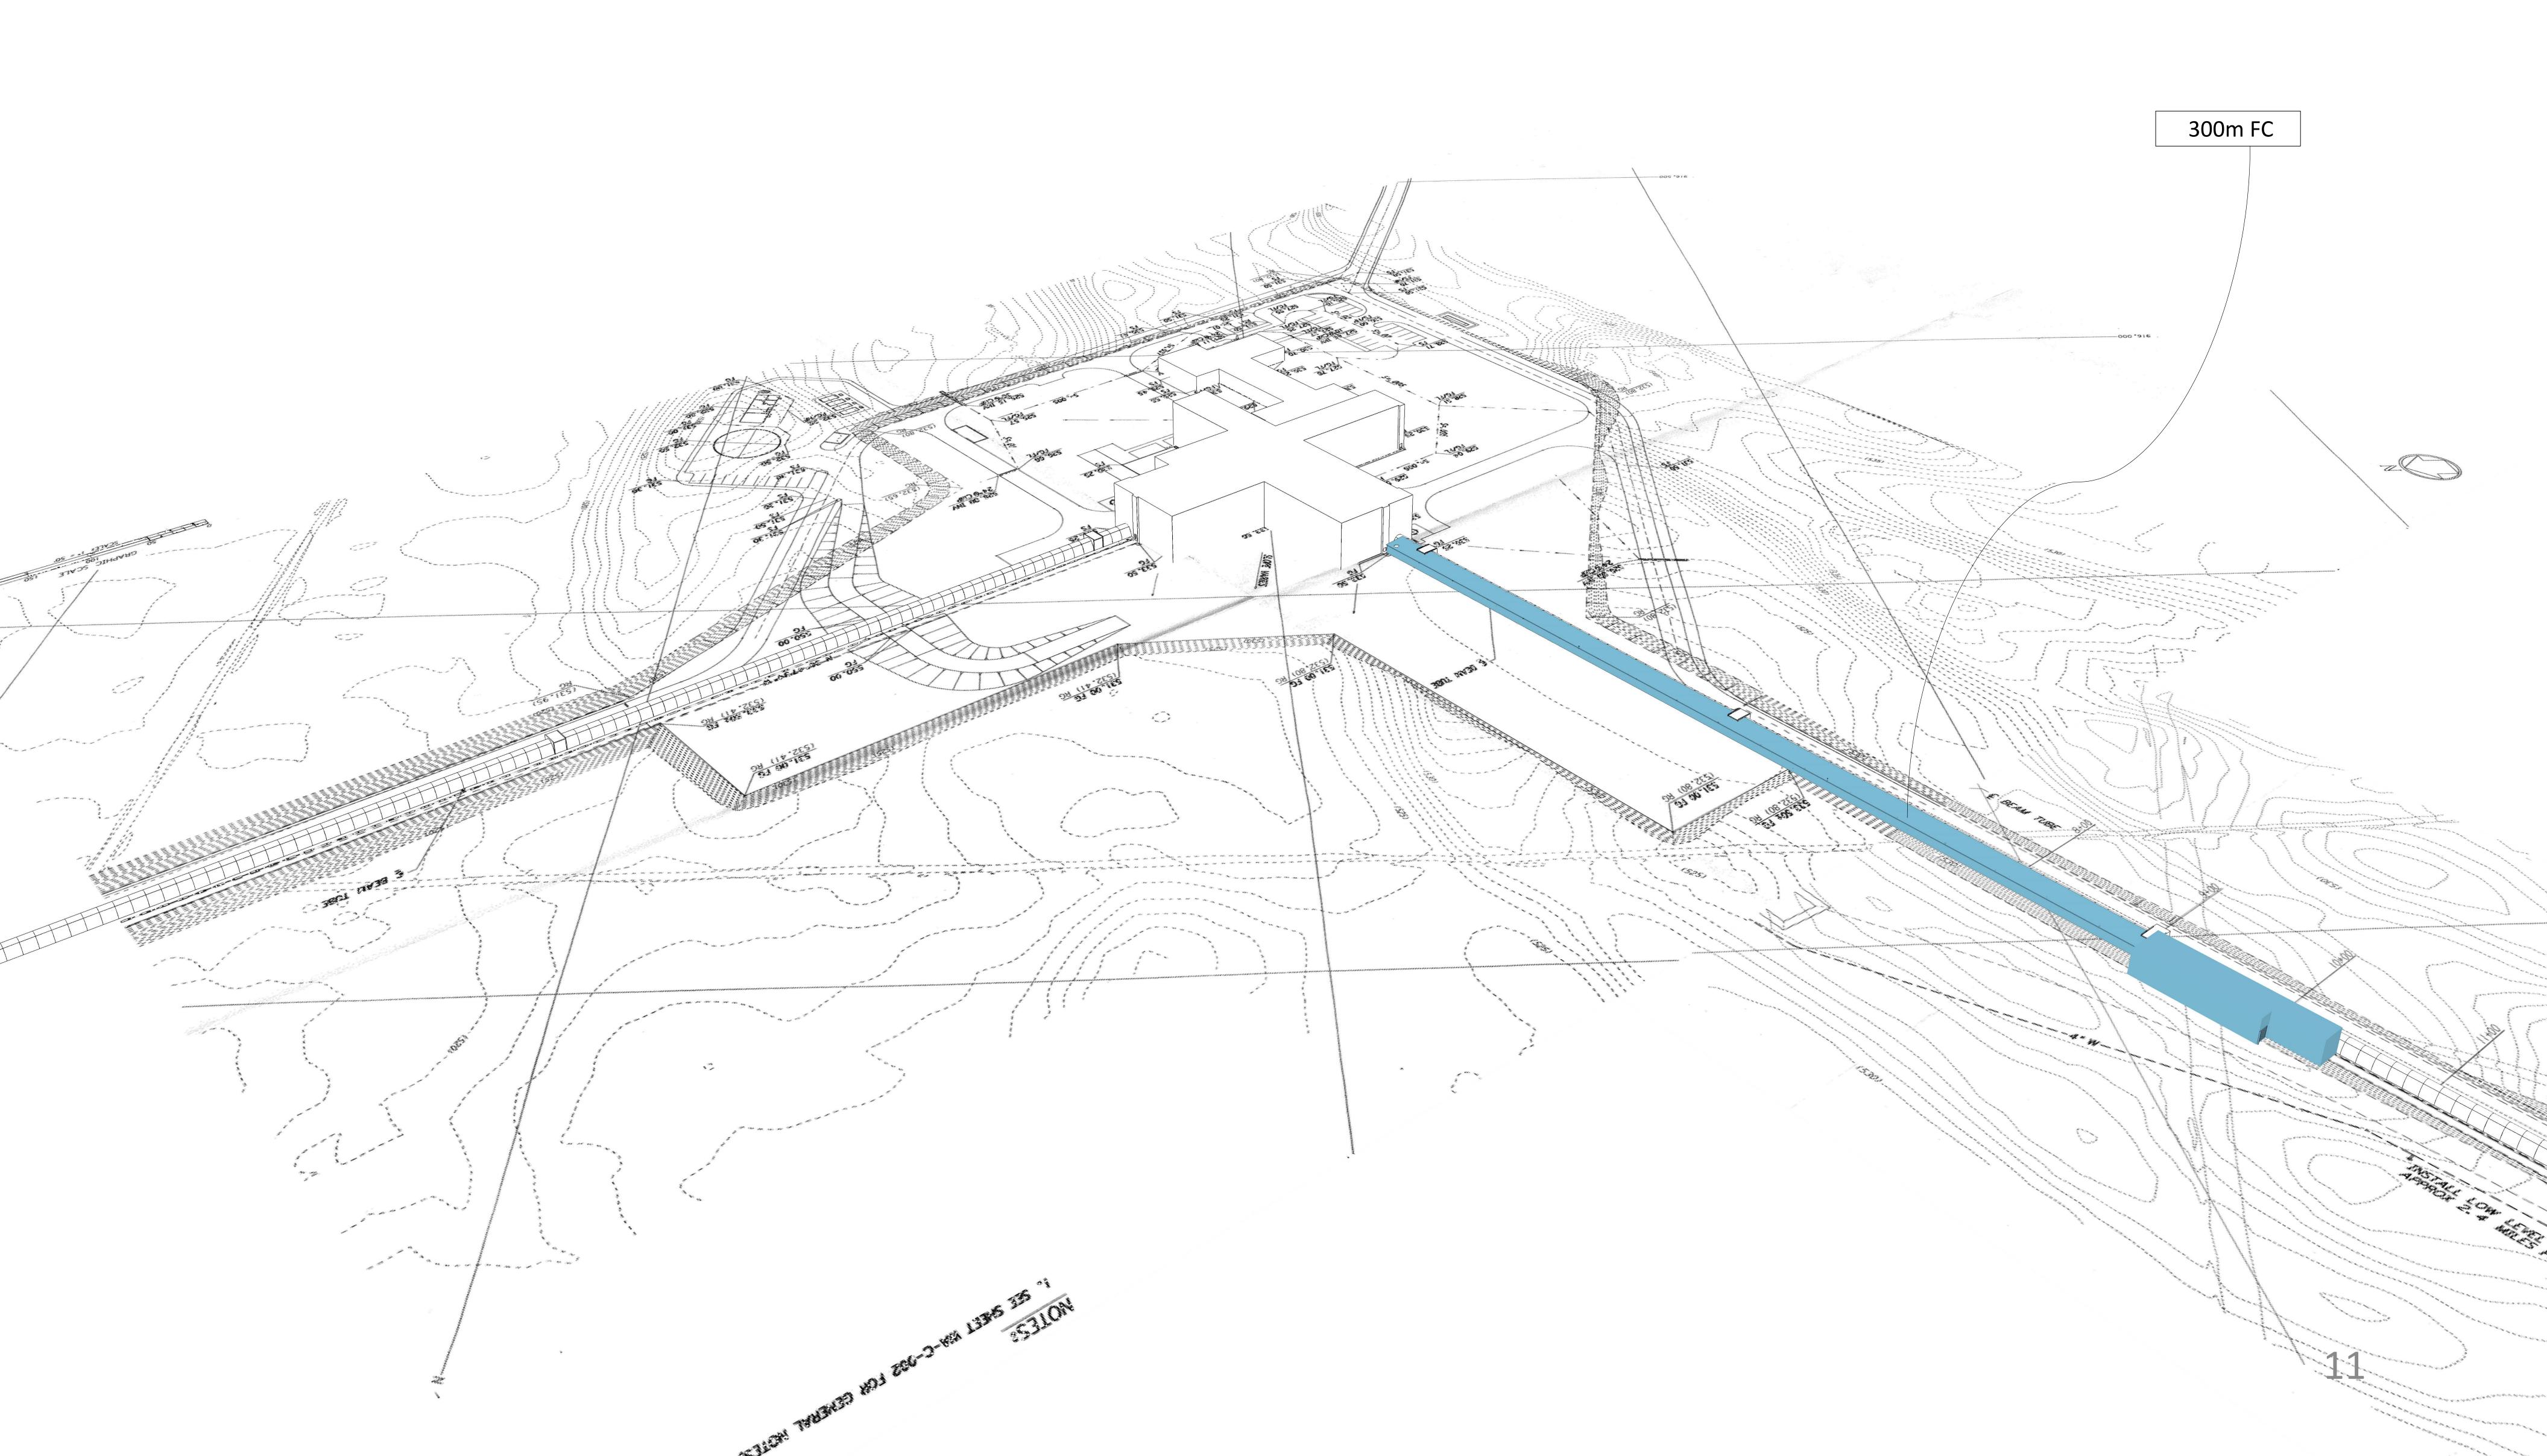

A+ PROJECT

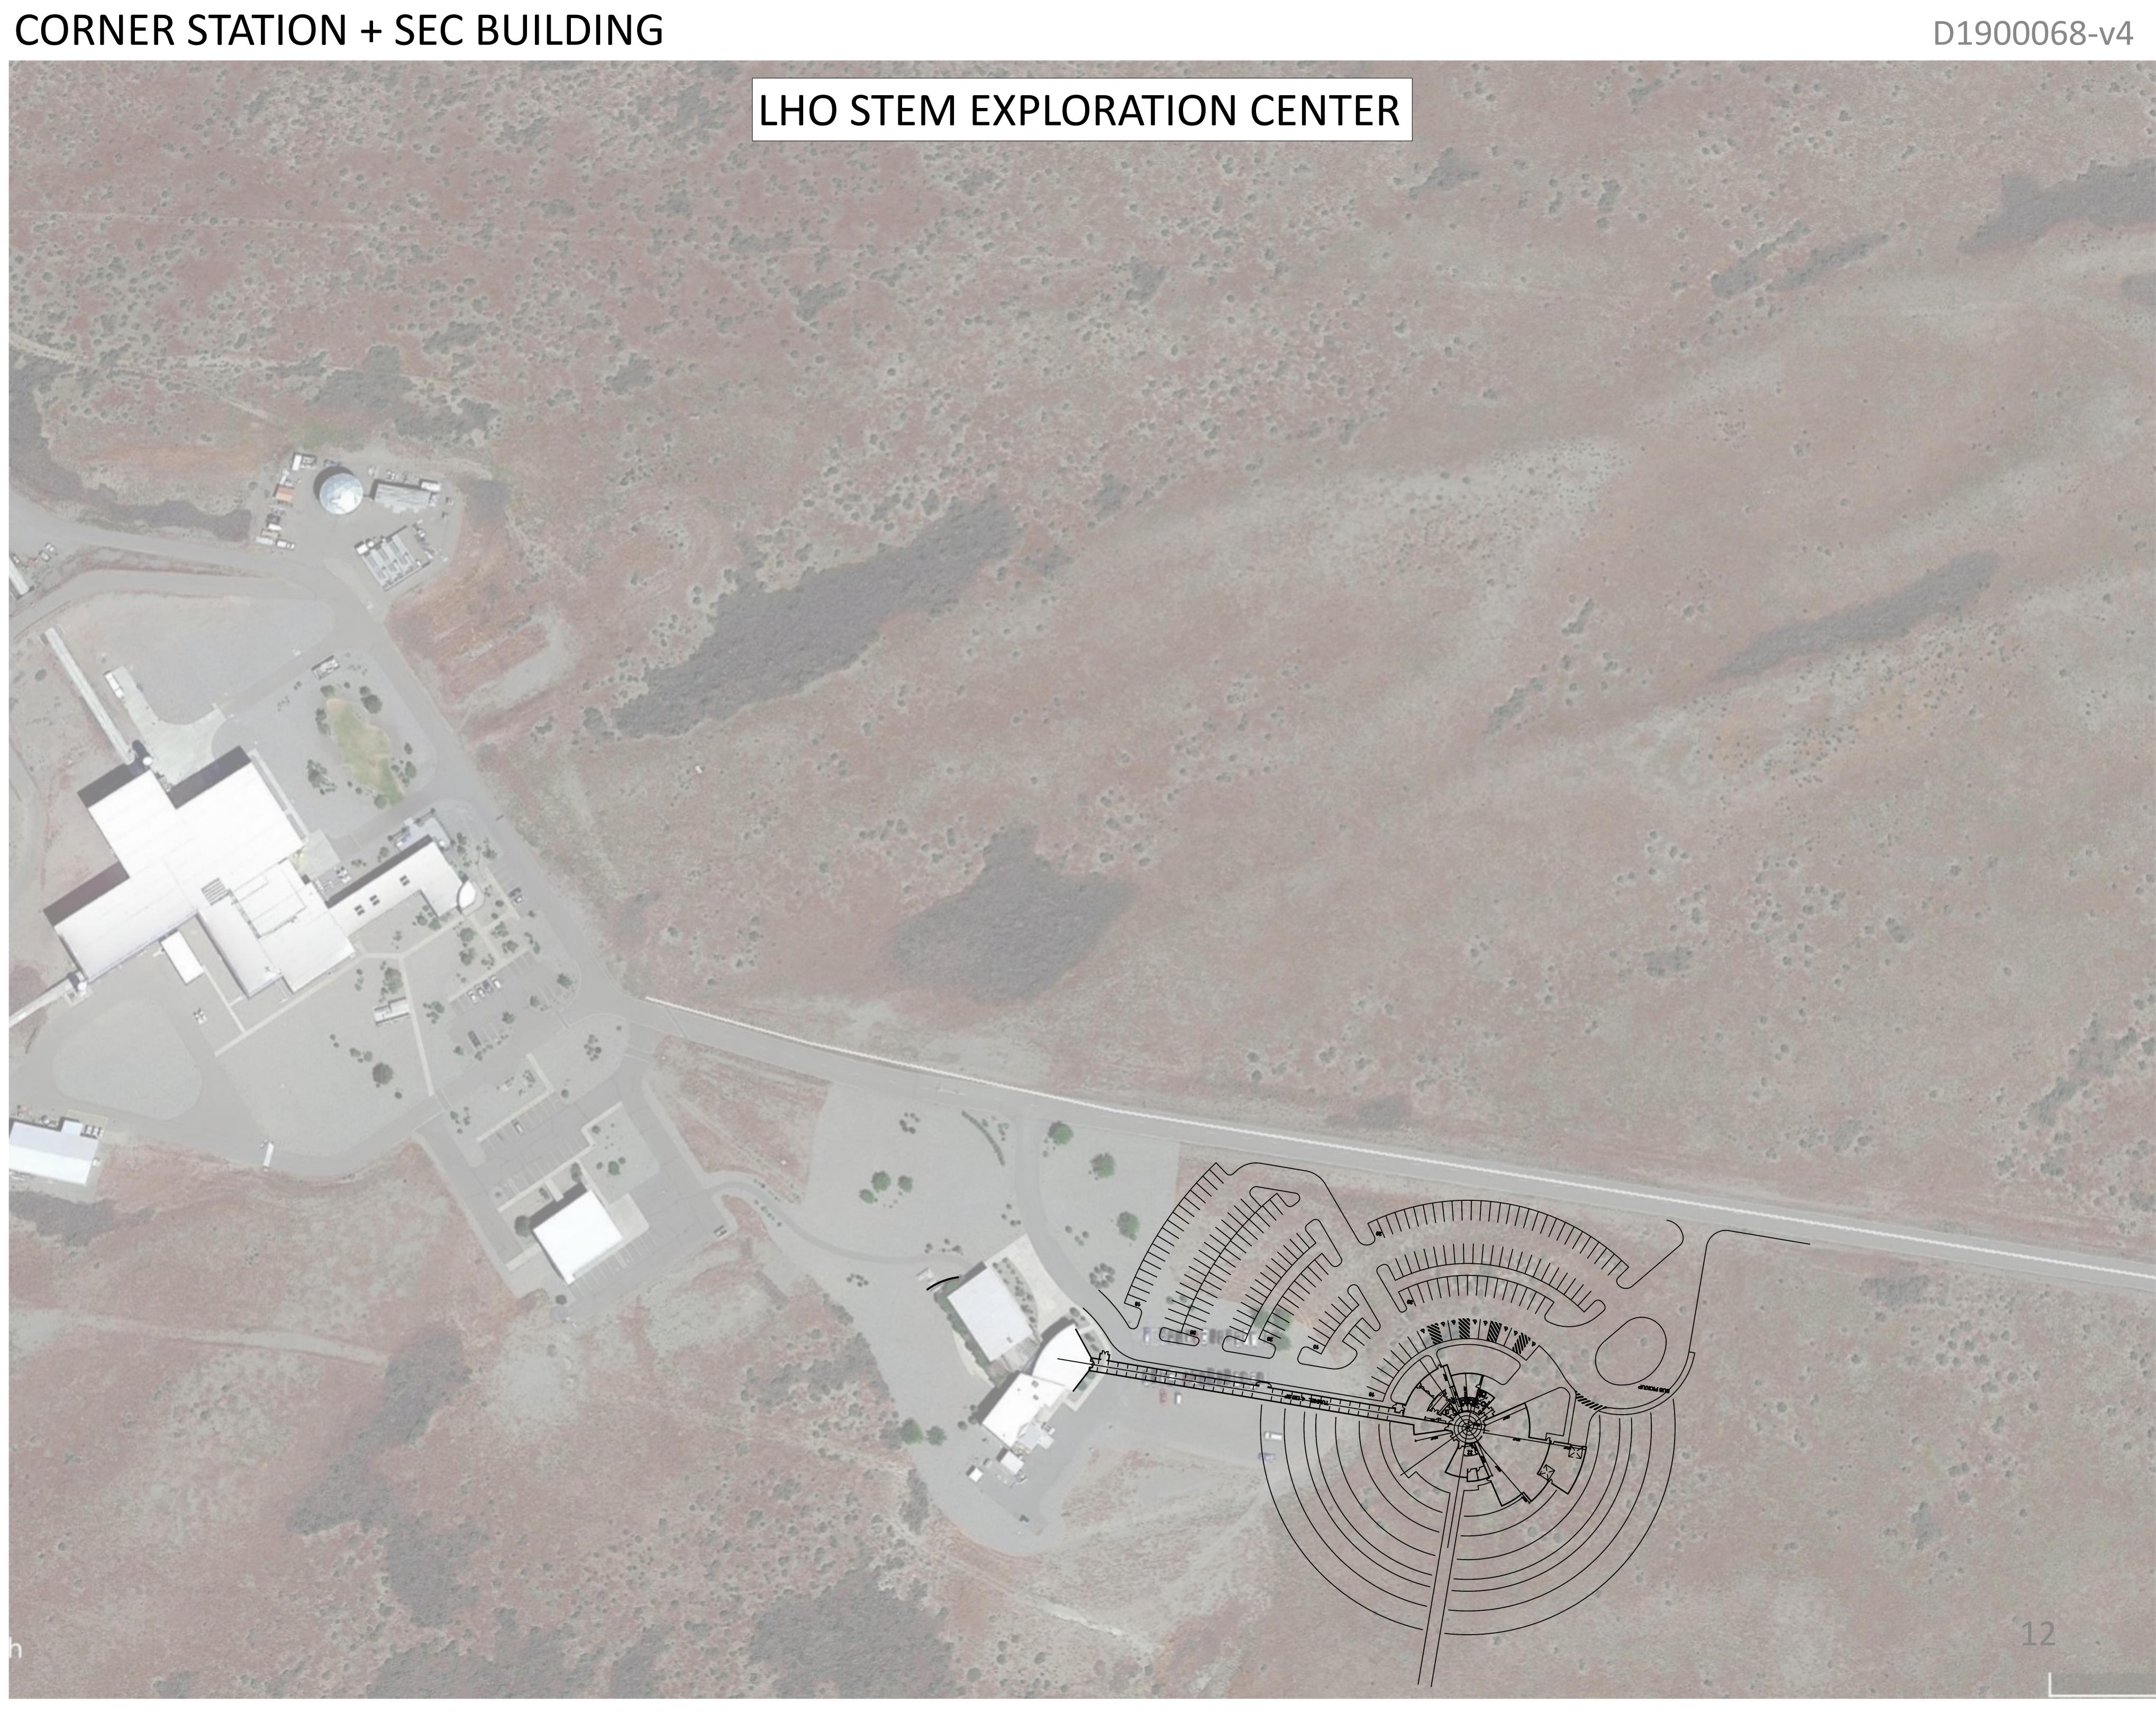

CORNER STATION + SEC BUILDING

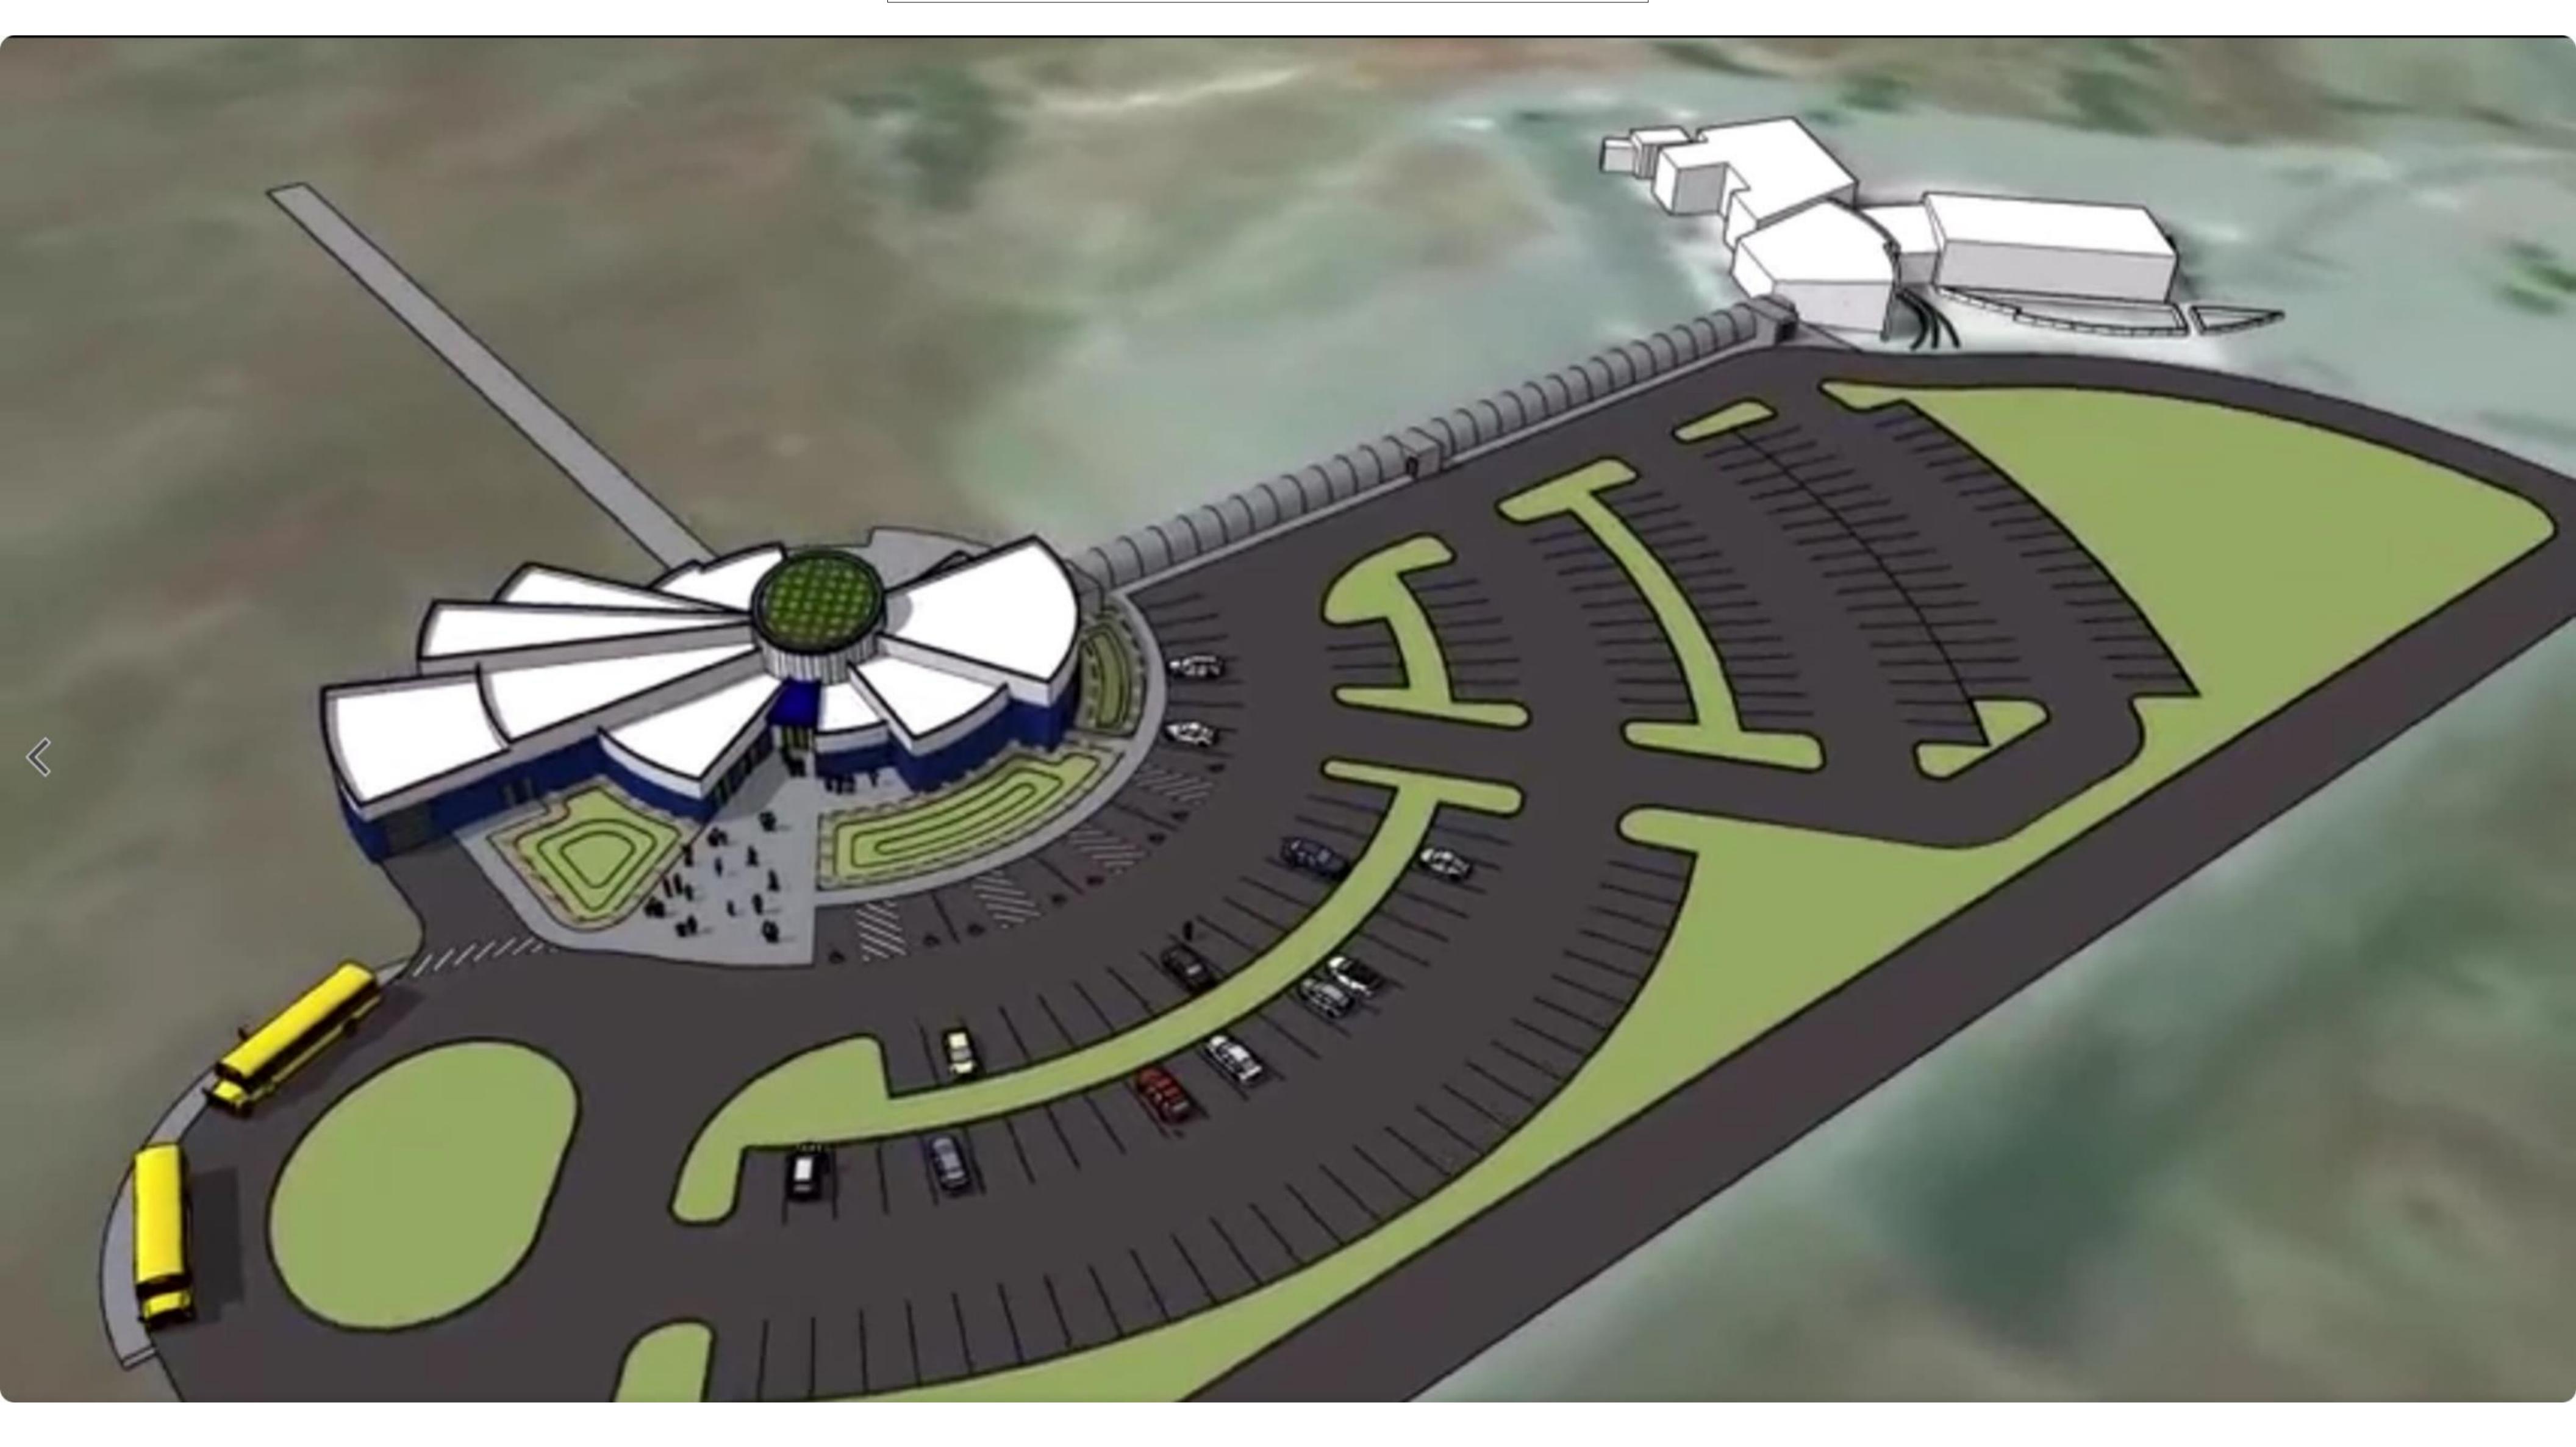

LHO STEM EXPLORATION CENTER

D1900068-v4

13

