

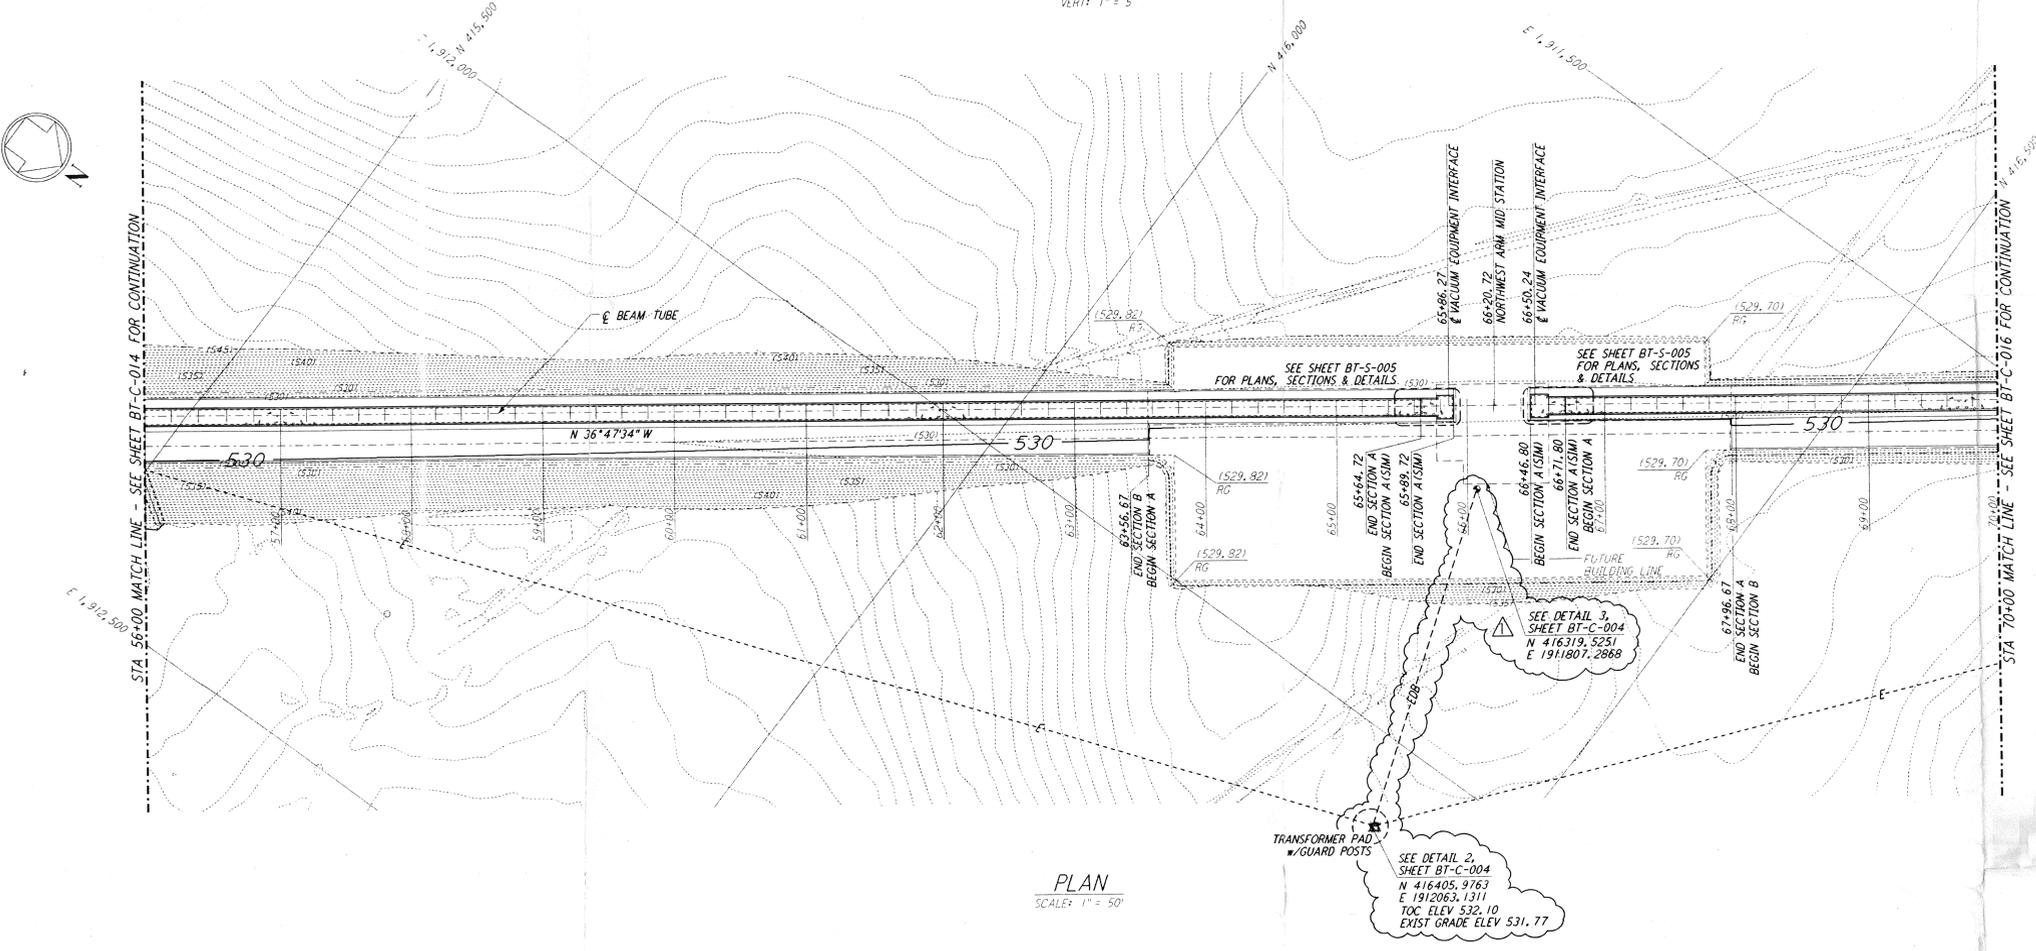


PROFILE
 SCALES: HORIZ: 1" = 50'
 VERT: 1" = 5'

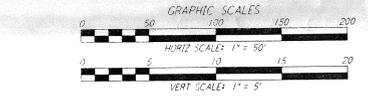

PLAN
 SCALE: 1" = 50'

- NOTES:**
- SEE SHEET BT-C-002 FOR GENERAL NOTES, LEGEND AND ABBREVIATIONS.
 - SEE SHEET BT-C-004 FOR TYPICAL SECTIONS AND DETAILS.

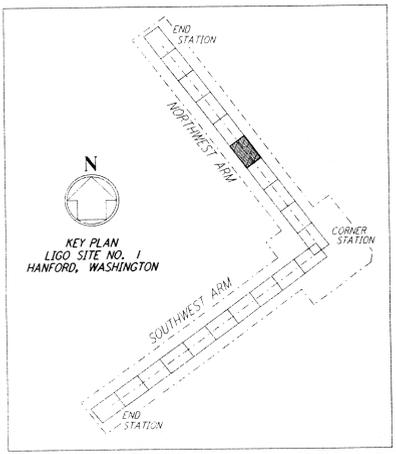

DRAWING NO.	DESCRIPTION	NO.	DATE	BY	CHKD	ENGR	PROJ	DESCRIPTION
1	2-29-96	WRB						CHANGE ORDER NO. 2

ISSUED FOR CONSTRUCTION			
DRAWN	WRB	1-19-96	
CHECKED	MP	1-19-96	
ENGINEER	JB	1-19-96	
PROJ	MDW	1-19-96	

John M. Howard
 12/96

PARSONS
 100 WEST WALNUT STREET
 PASADENA, CALIFORNIA

LIGO
 CALIFORNIA INSTITUTE OF TECHNOLOGY
 MASSACHUSETTS INSTITUTE OF TECHNOLOGY

LASER INTERFEROMETER
 GRAVITATIONAL-WAVE OBSERVATORY
 BTE SITWORK & FABRICATION - HANFORD, WA

TITLE: CIVIL NORTHWEST ARM PLAN AND PROFILE
 STA 56+00 TO STA 70+00

SCALE: AS NOTED
 CONTRACT NUMBER: PPI50969
 PROJECT NUMBER: 8094
 SHEET NUMBER: BT-C-015

Date Received: 3/25/96	LIGO-D960170-01-01	Contract # BT-C-015	Rev. 1
TW #	LIGO	Approved	
Date	/ /	Approved	
TOW #	LIGO	Approved	
Date	/ /	Approved	
Gen'l Transmittal	LIGO	Approved	
Date	/ /	Approved	

PARSONS
 They are loaned only with the
 borrower's expressed written agreement that they will
 not be used for any other project without the
 written consent of PARSONS.

PARSONS
 They are loaned only with the
 borrower's expressed written agreement that they will
 not be used for any other project without the
 written consent of PARSONS.

REFERENCES
 DRAWING NO. 5
 DESCRIPTION
 NO. DATE BY CHKC ENGR PROJ DESCRIPTION

E
 D
 C
 B
 A

I:\ligo\site\lce\bt-c-015.dwg