DATE: 03/19/97 TIME: 12:00:32
DESIGN FILE: I:\ligo\site\arc\wa0108.d3z

NOTE: SEE SPECIFICATIONS FOR ADDITIONAL INFORMATION AND SCHEDULES

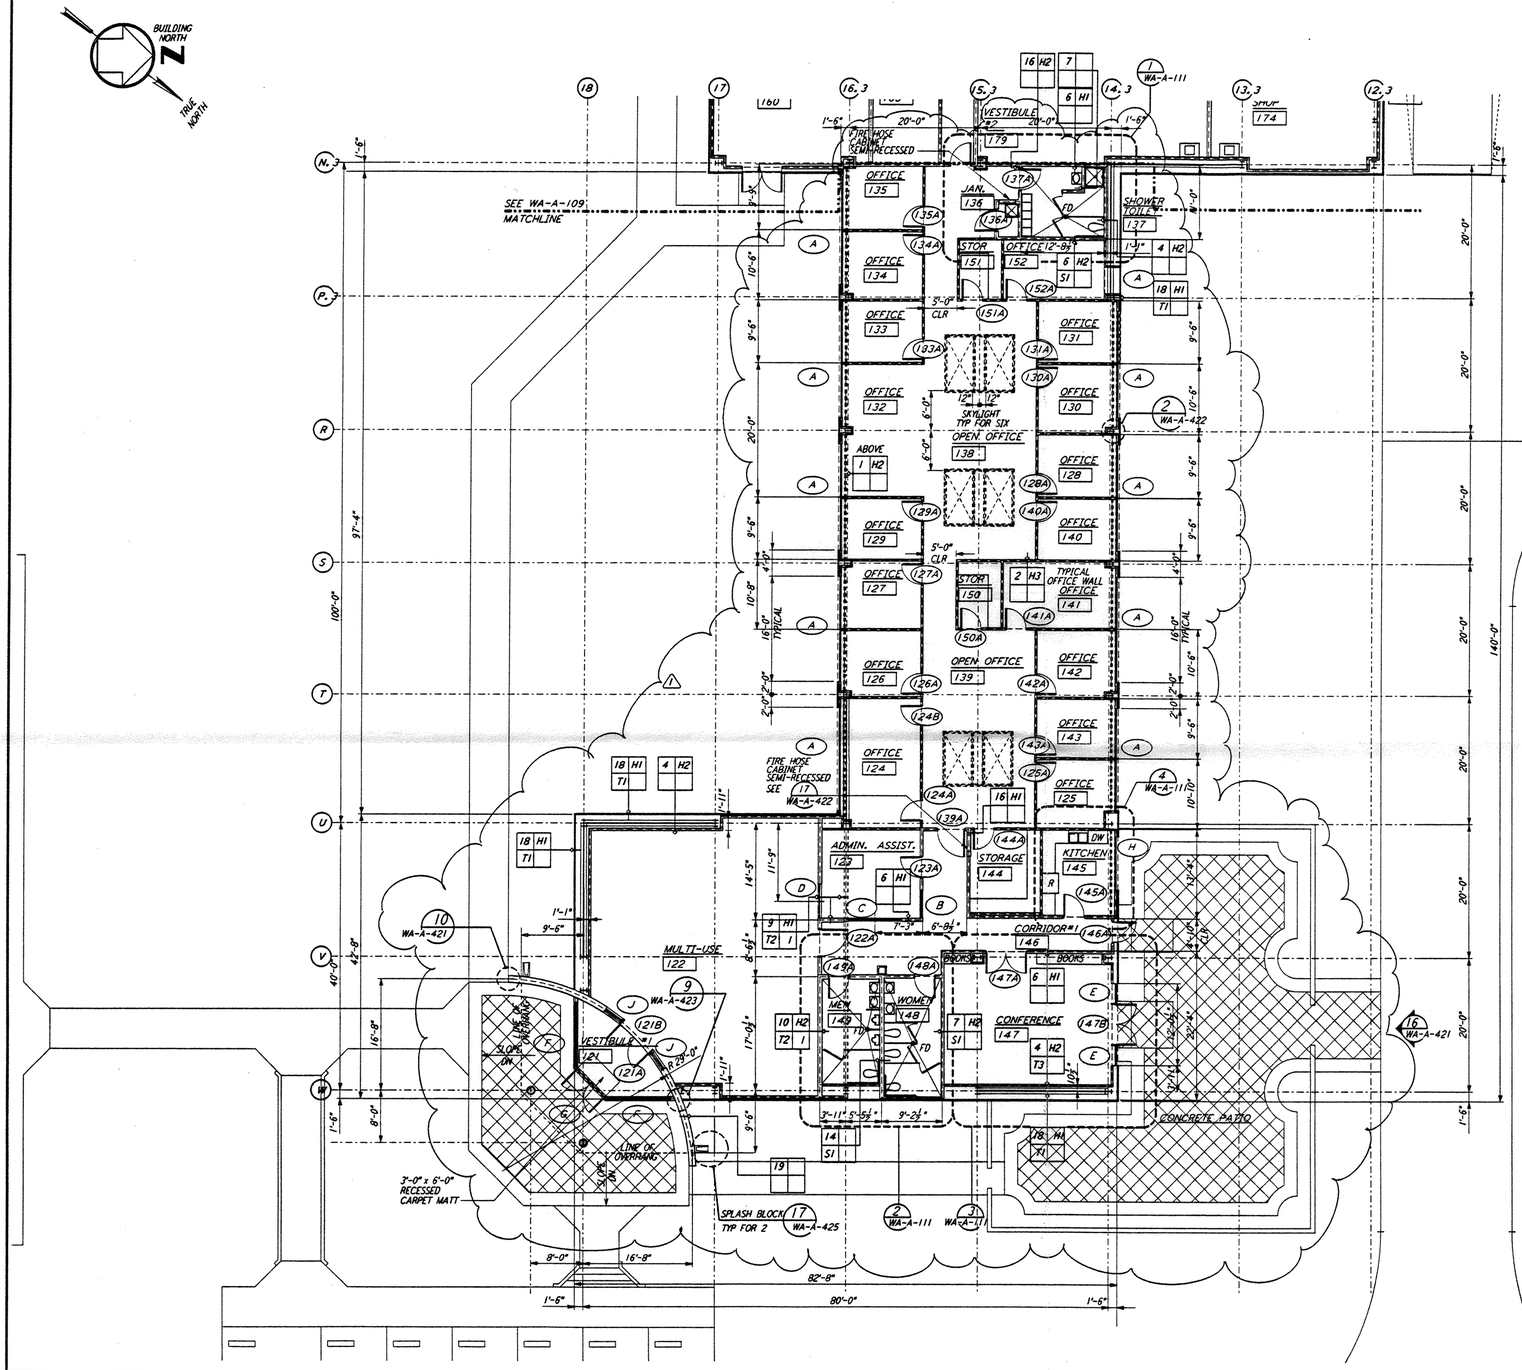

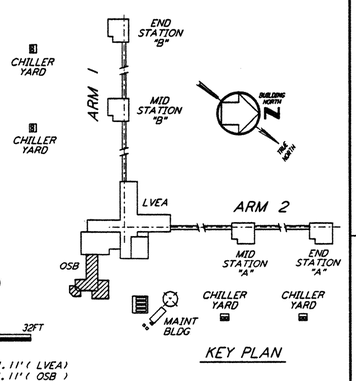

KEY PLAN

LIGO-D960248-01-O

DATUM POINT EL +100.00 = 531.11' (LVEA)
DATUM POINT EL +100.00 = 531.11' (OSB)

REFERENCES		REVISIONS							
DRAWING NO.	DESCRIPTION	NO.	DATE	BY	CHKD	ENGR	PROJ	OSB REVISION	DESCRIPTION
		1	2-28-97	CKT	TB	AK	TDM		

ISSUED FOR CONSTRUCTION		
DRAWN	SF/CKT	5-12-96
CHECKED	TB	5-26-96
ENGINEER	bkk	7-12-96
PROJ	MDW	7-12-96

5829 REGISTERED ARCHITECT ALEX ANDREW KRAUL STATE OF WASHINGTON 7/25/97

PARSONS
100 WEST WALNUT STREET
PASADENA, CALIFORNIA

LIGO
CALIFORNIA INSTITUTE OF TECHNOLOGY
MASSACHUSETTS INSTITUTE OF TECHNOLOGY

LASER INTERFEROMETER GRAVITATIONAL-WAVE OBSERVATORY
SITE NO. 1 - HANFORD, WASHINGTON

TITLE	SCALE	CONTRACT NUMBER	PROJECT NUMBER
ARCHITECTURAL CORNER STATION OSB PARTIAL FLOOR PLAN SHEET 1	AS NOTED	PP150969	8094
	SHEET NUMBER		REVISIONS
	WA-A-108		1

LIGOWAF3.BDR

This document and the design it covers are the property of PARSONS. They are loaned only with the borrower's expressed written agreement that they will not be reproduced, copied, loaned, exhibited, or used in any other way, except by written consent from PARSONS to the borrower.

Wed Mar 19 11:27:24 1997 S:\ACAD\LIGO\ARCHIVE\WA0108.DWG
Wed Mar 19 11:27:24 1997 S:\ACAD\LIGO\ARCHIVE\WA0108.PRF