DATE: 05/22/96 TIME: 15:06:06
DESIGN FILE: I:\ligo\site\arch\wa0109.d3z

This document and the design it covers are the property of **PARSONS**. They are loaned only with the borrower's expressed written agreement that they will not be reproduced, copied, loaned, exhibited, or used in any other way, except by written consent from **PARSONS** to the borrower.

NOTE: SEE SPECIFICATIONS FOR ADDITIONAL INFORMATION AND SCHEDULES

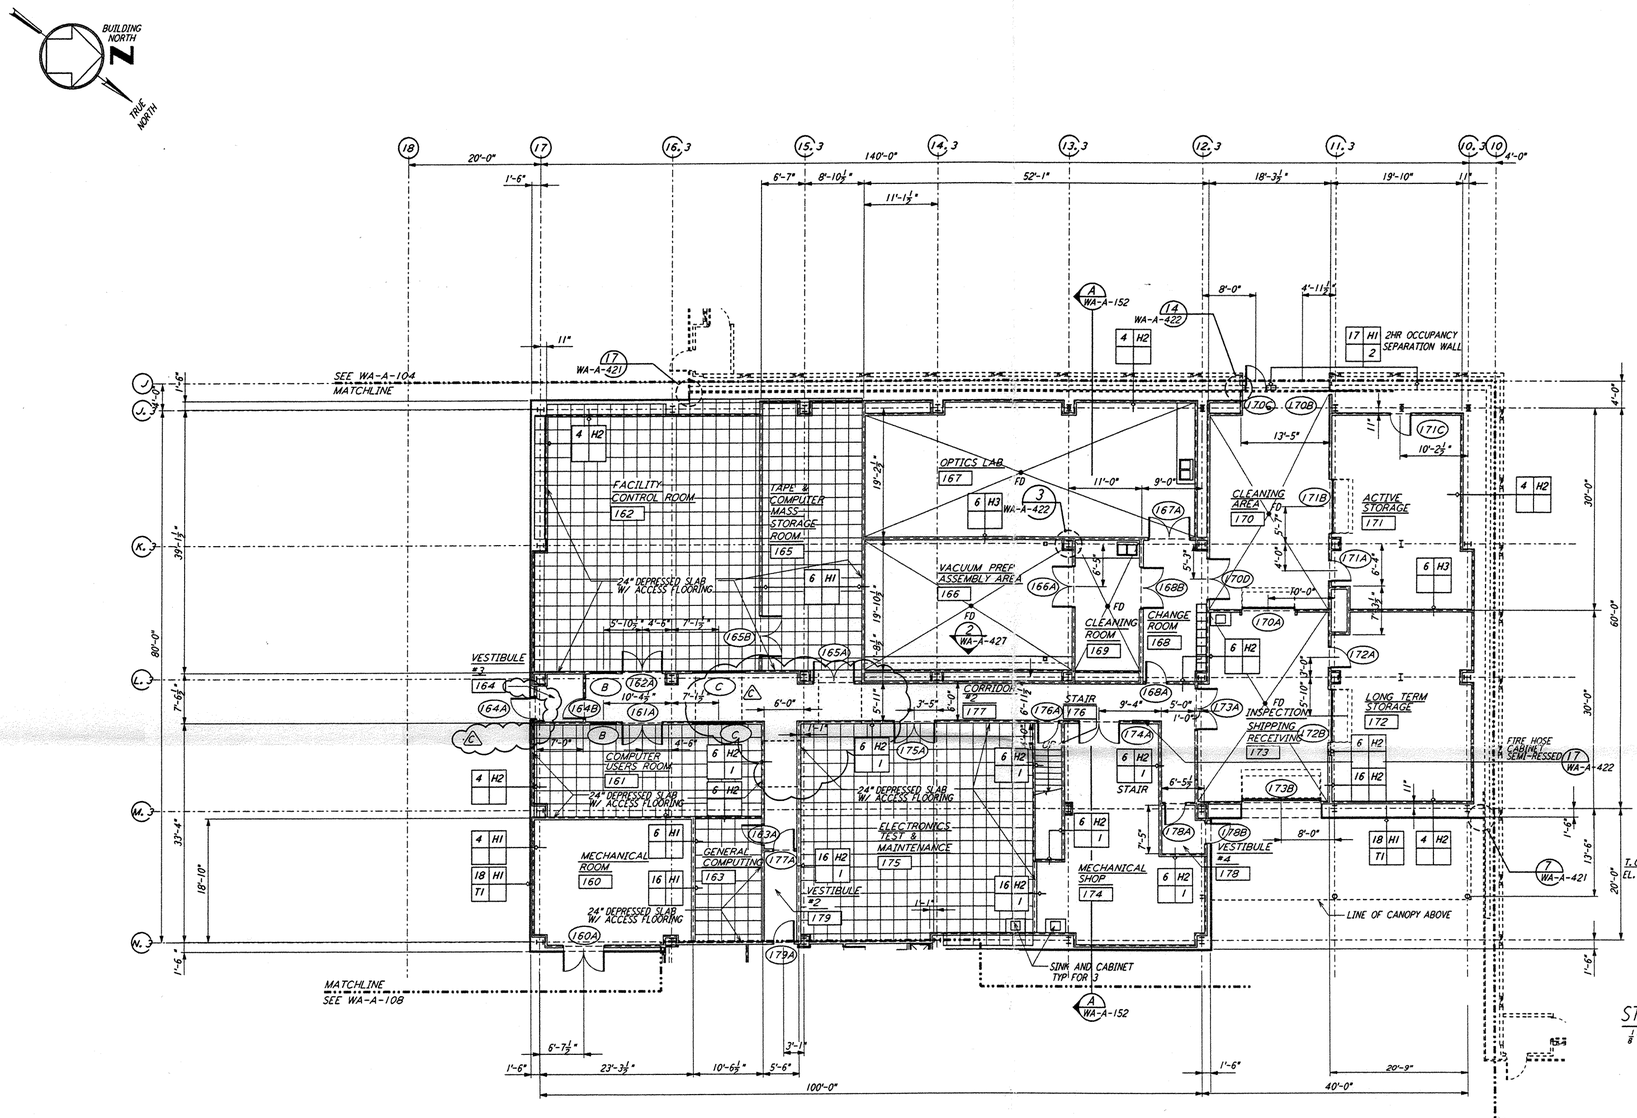

LIGO-D960249-C-O

REFERENCES		REVISIONS						
DRAWING NO.	DESCRIPTION	NO.	DATE	BY	CHKD	ENGR	PROJ	DESCRIPTION
		C	5-22-96	BK	BK	SF	TDM	BID ADDENDUM #2
		B	4-19-96		SF	SF	TDM	FINAL DESIGN REVIEW & BID
		A	01/17/96		SF	SF	TDM	PRELIMINARY DESIGN REVIEW

DRAWN	SF/CKT
CHECKED	
ENGINEER	
PROJ	

PARSONS
100 WEST WALNUT STREET
PASADENA, CALIFORNIA

LIGO
CALIFORNIA INSTITUTE OF TECHNOLOGY
MASSACHUSETTS INSTITUTE OF TECHNOLOGY

LASER INTERFEROMETER
GRAVITATIONAL-WAVE OBSERVATORY
SITE NO. 1 - HANFORD, WASHINGTON

TITLE: ARCHITECTURAL
CORNER STATION
OSB PARTIAL FLOOR PLAN
SHEET 2

SCALE	CONTRACT NUMBER	PROJECT NUMBER
AS NOTED	PP150969	8094

SHEET NUMBER: WA-A-109
REVISIONS: C

LIGOWAF3.BOR

Wed May 22 15:06:13 1996 J:\PLOTSTUF\ARCH\WA0109.S15 2282,1648,0,0,0