




NOTE: SEE SPECIFICATIONS FOR  
 ADDITIONAL INFORMATION  
 AND SCHEDULES

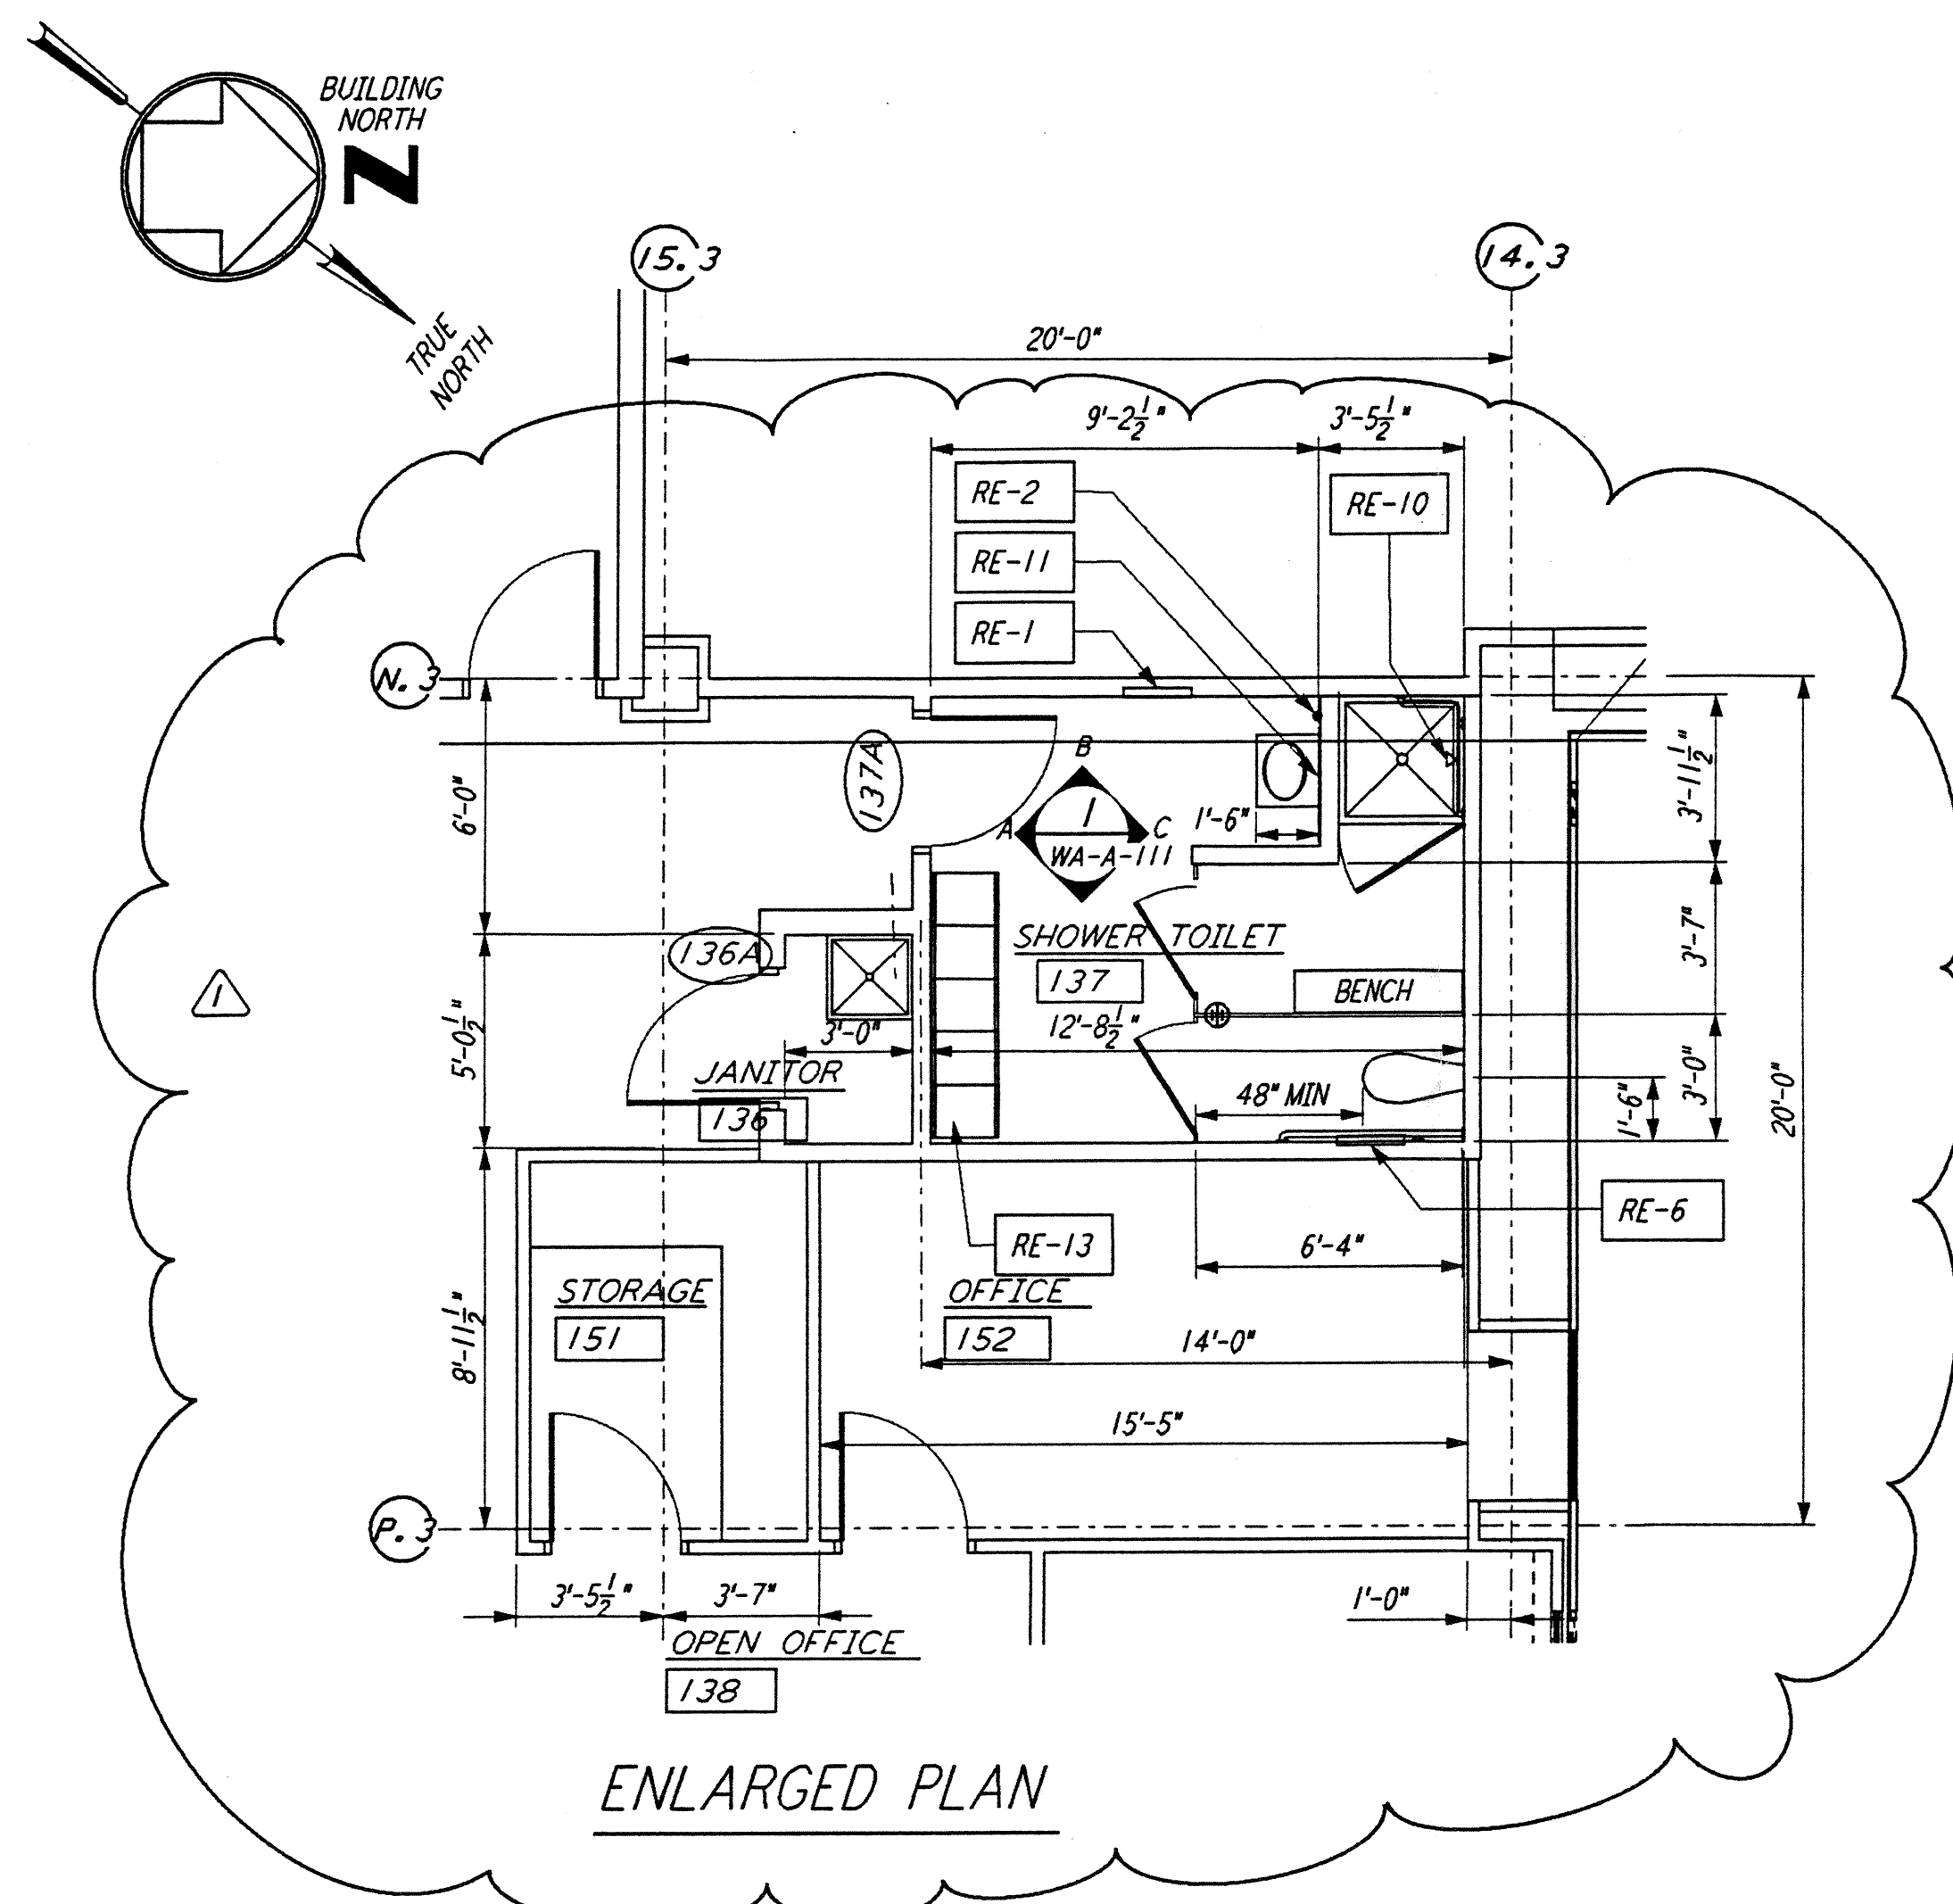


**JANITOR 136 / SHOWER TOILET 137**  
 1/4" = 1'-0"

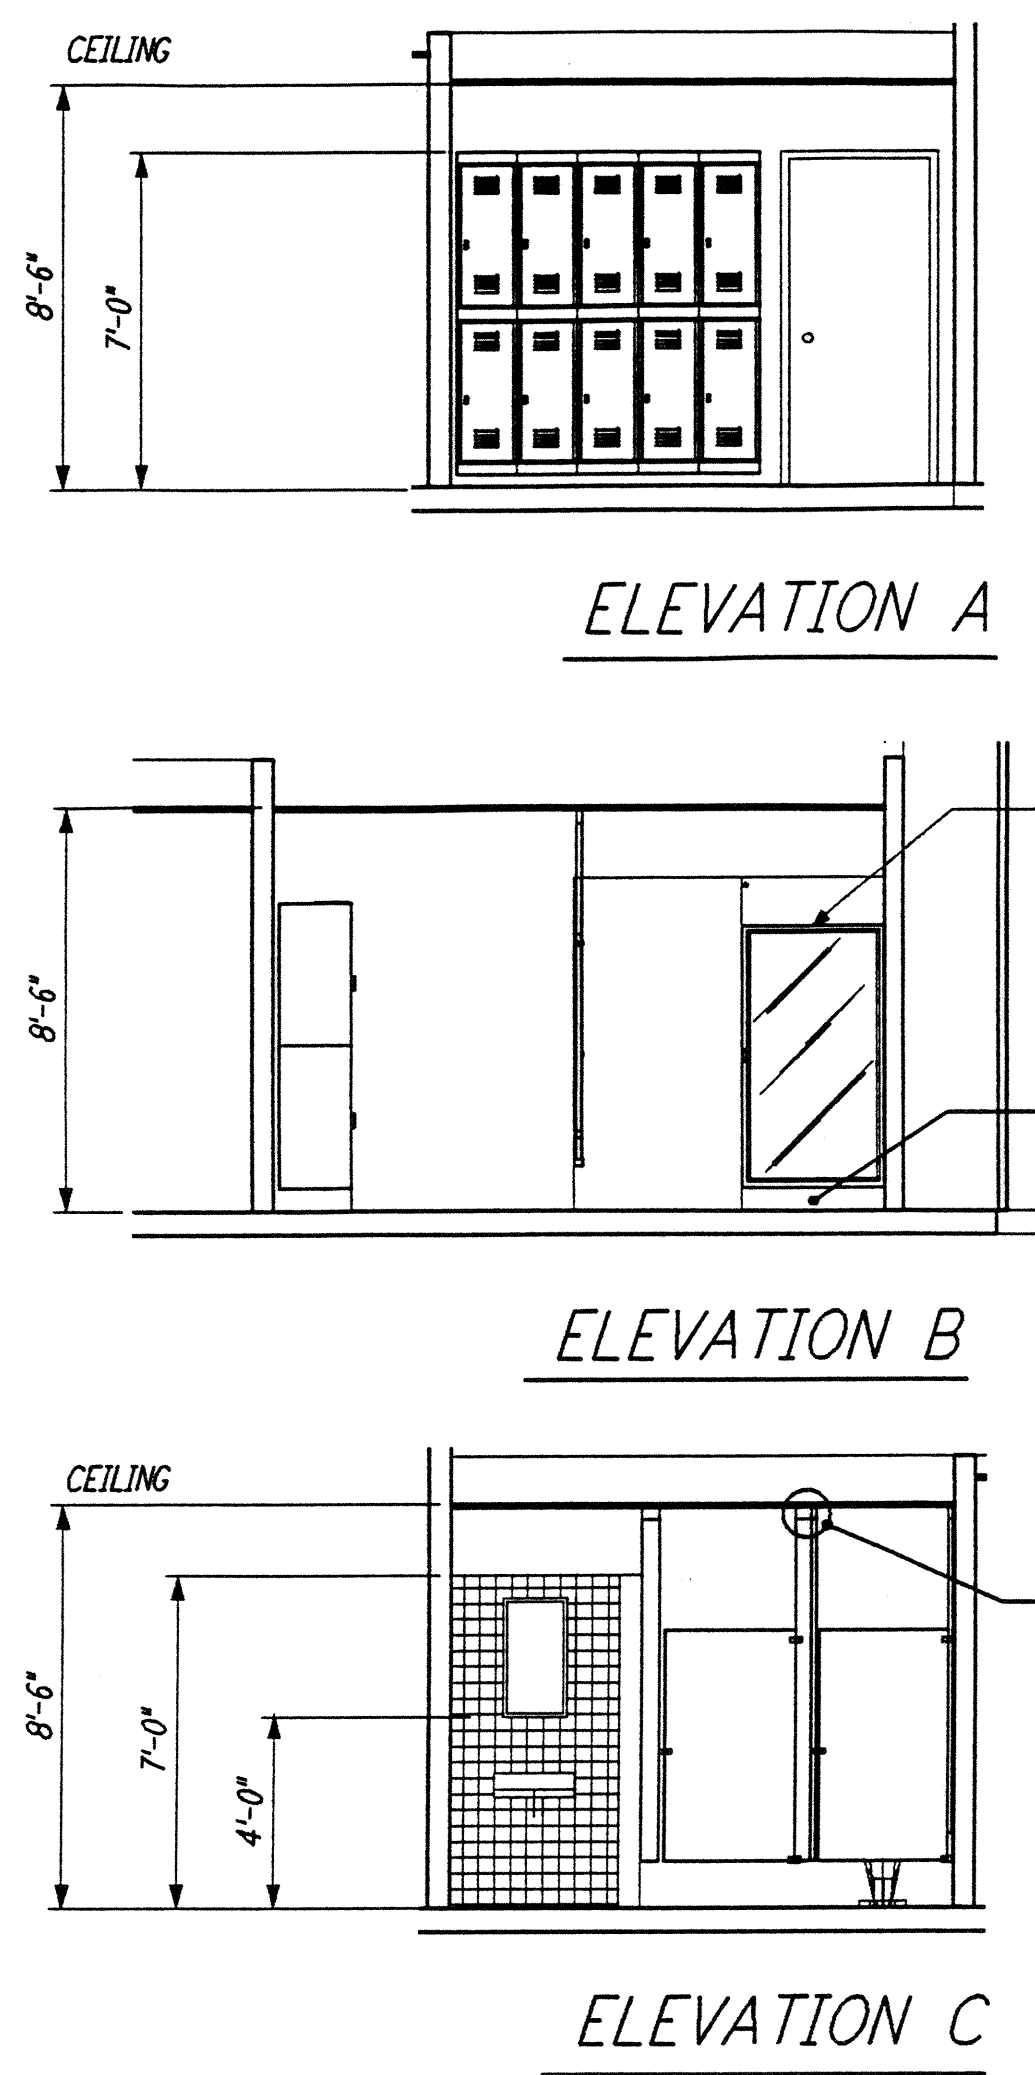


**ELEVATION A**  
**ELEVATION B**  
**ELEVATION C**  
 1 REF  
 WA-A-111 WA-A-108

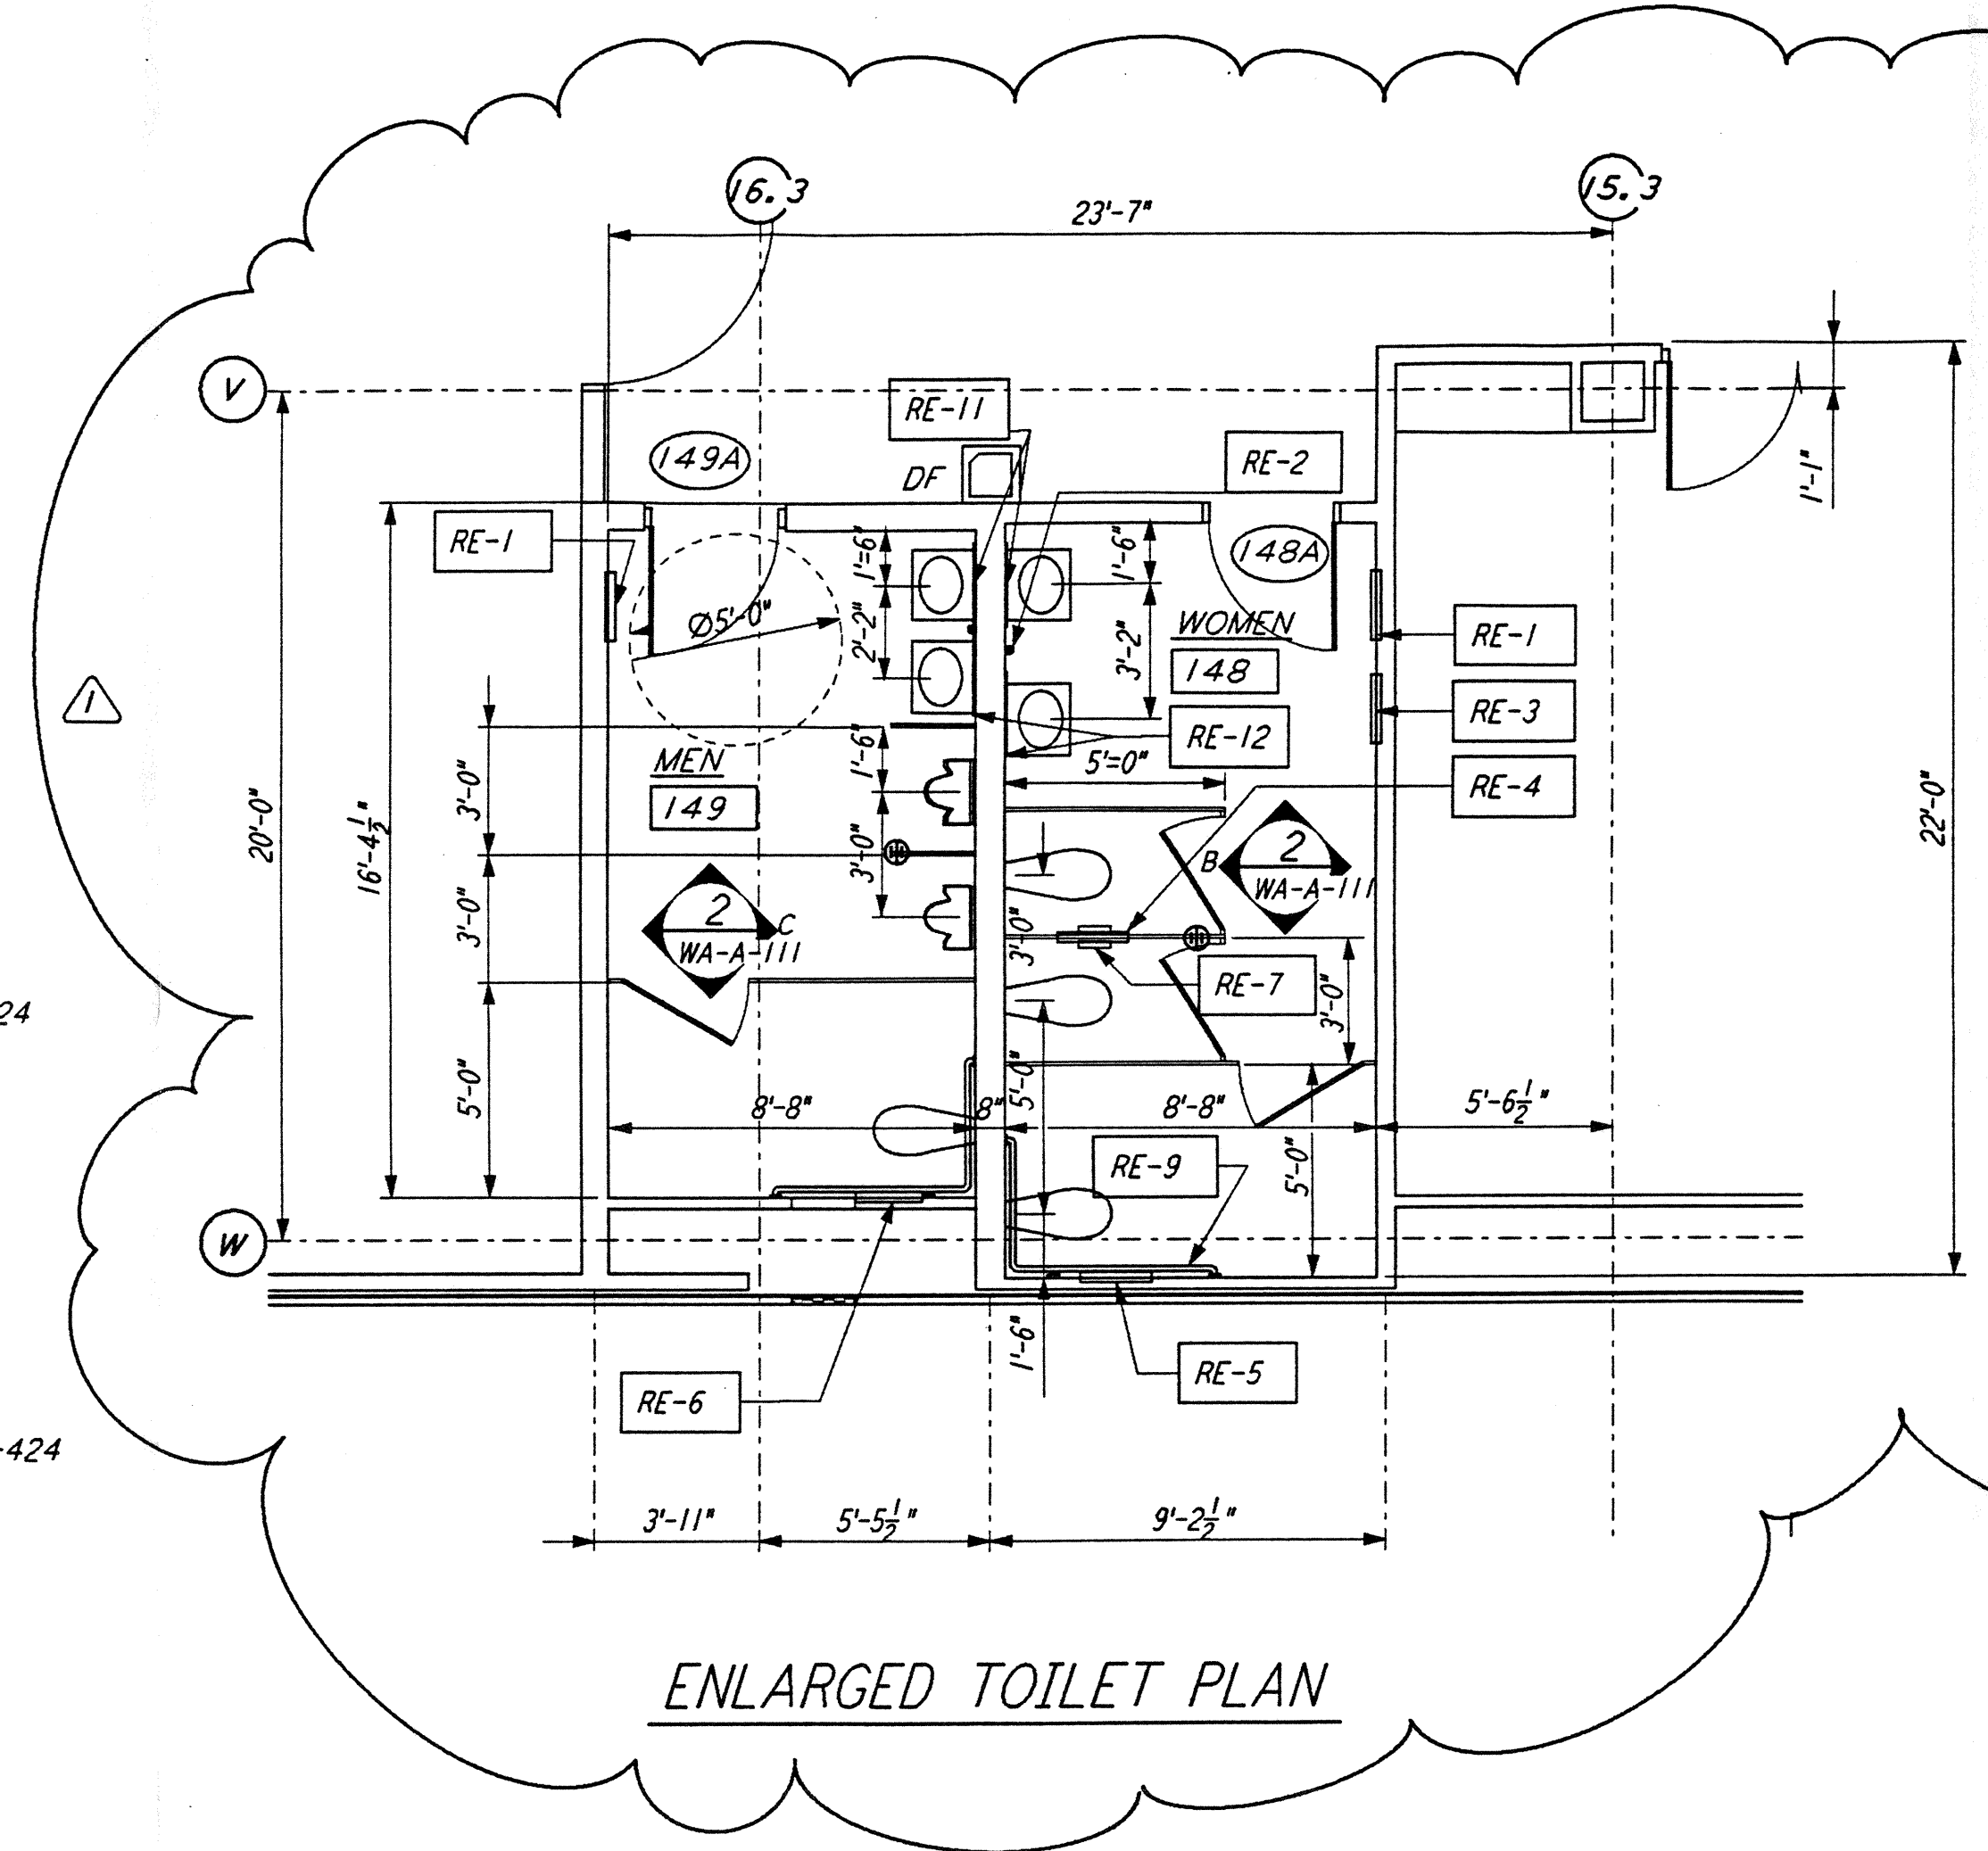


**MEN 149 / WOMEN 148**  
 1/4" = 1'-0"

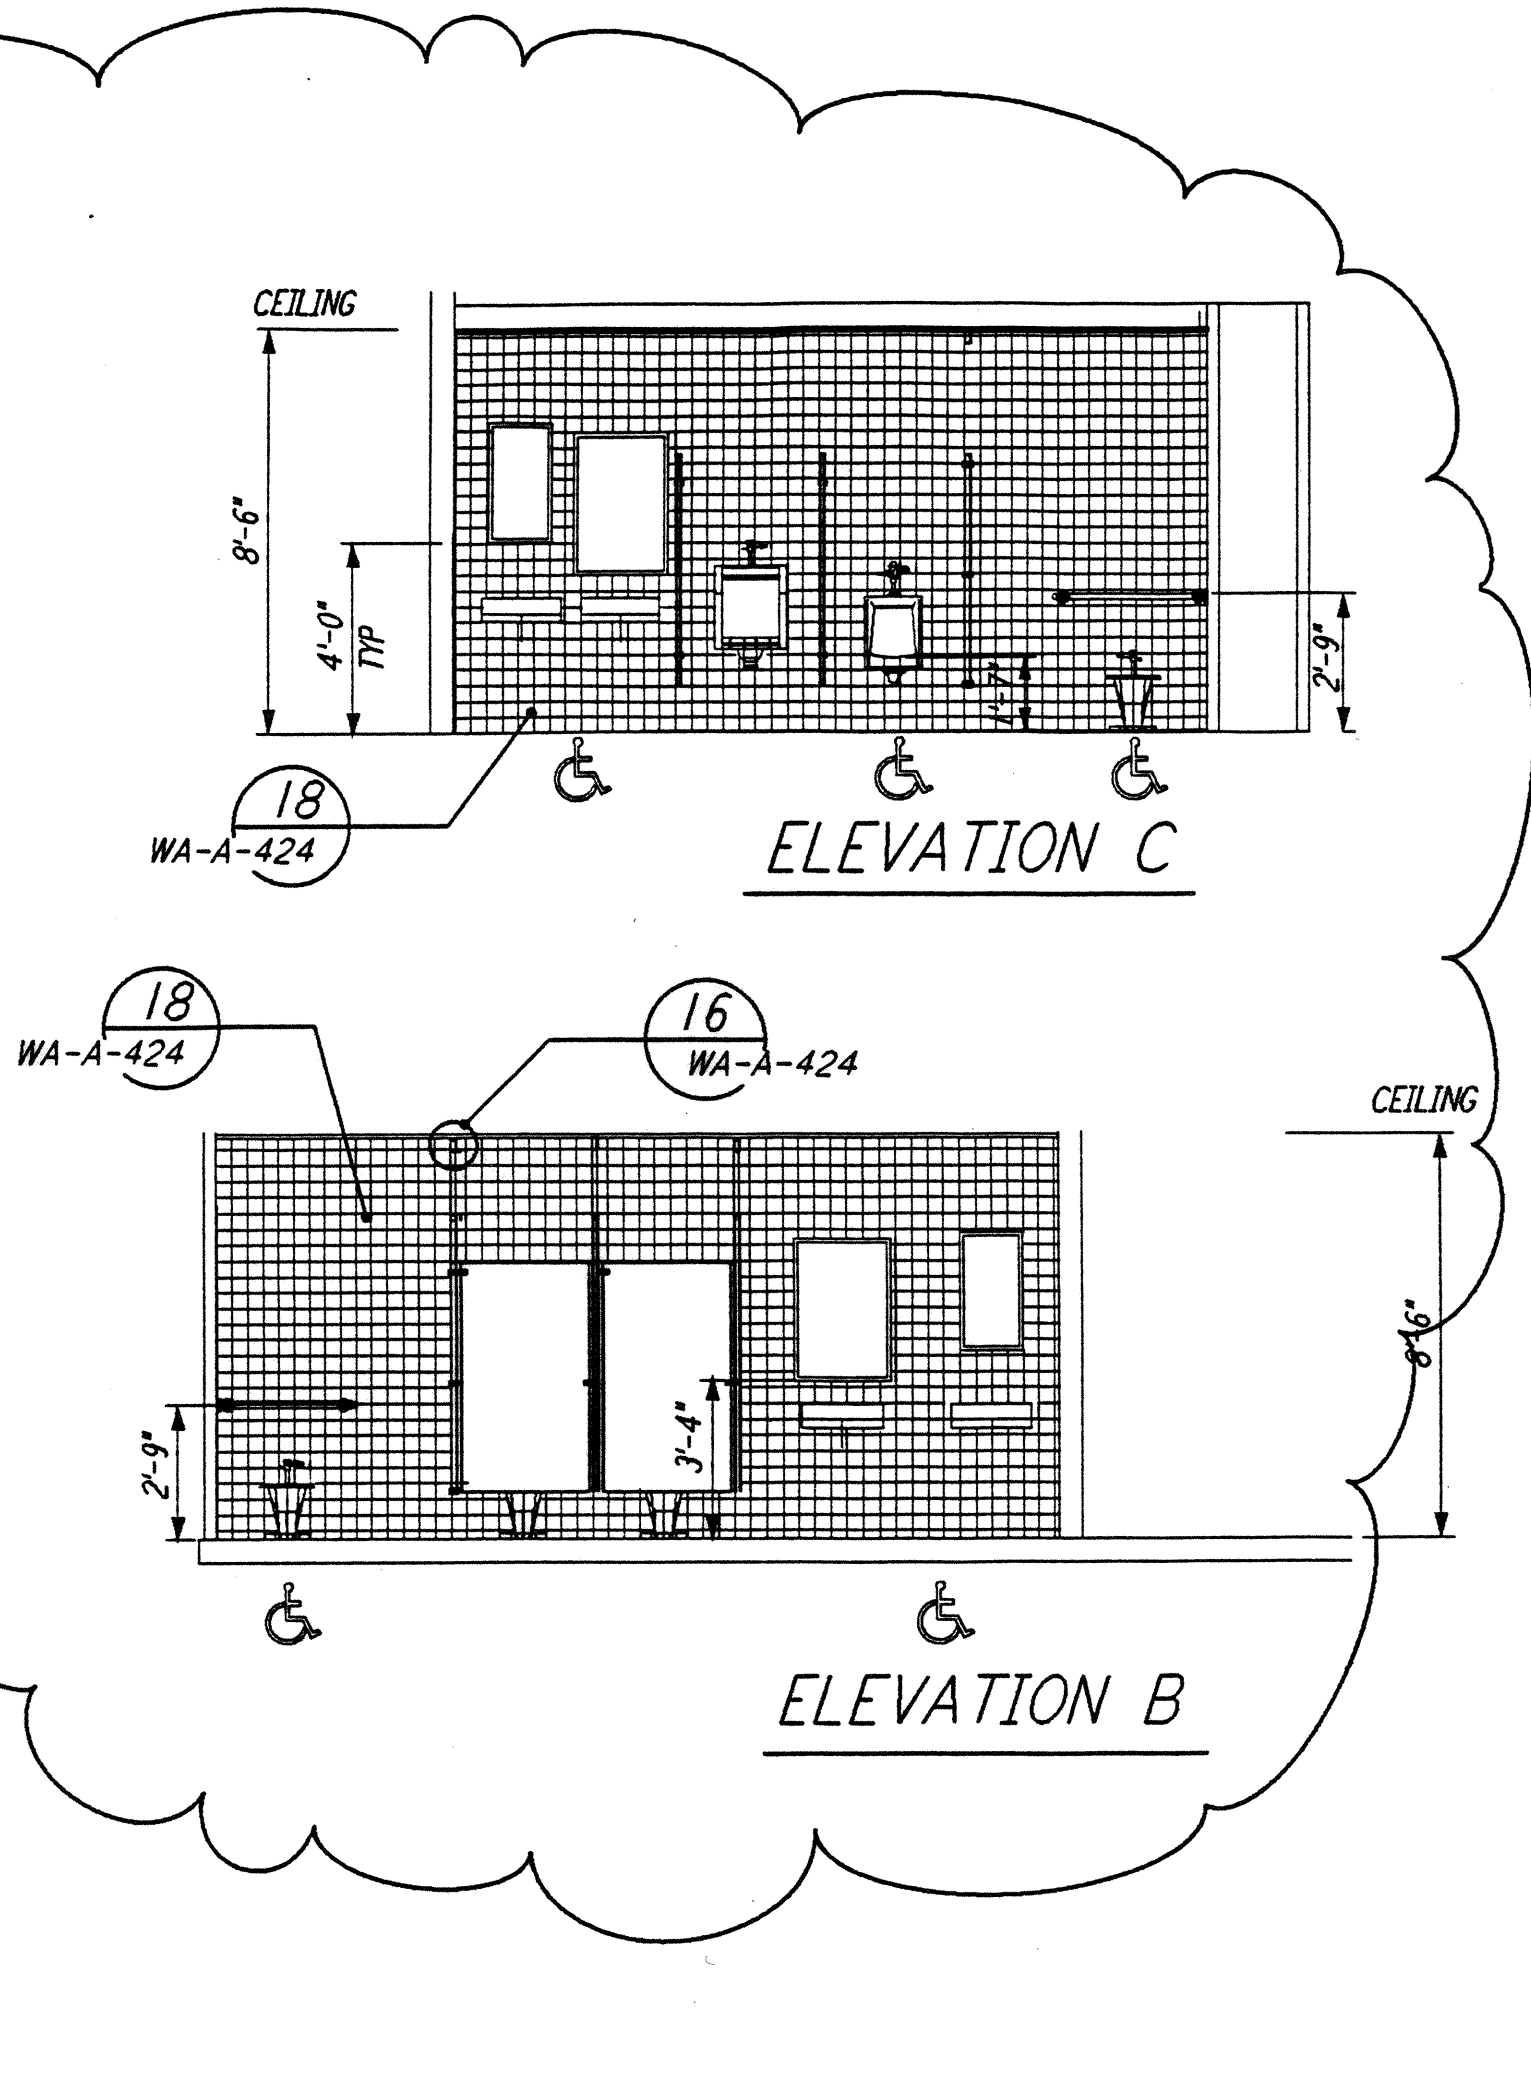


**ELEVATION A**  
**ELEVATION B**  
**ELEVATION C**  
 2 REF  
 WA-A-111 WA-A-108

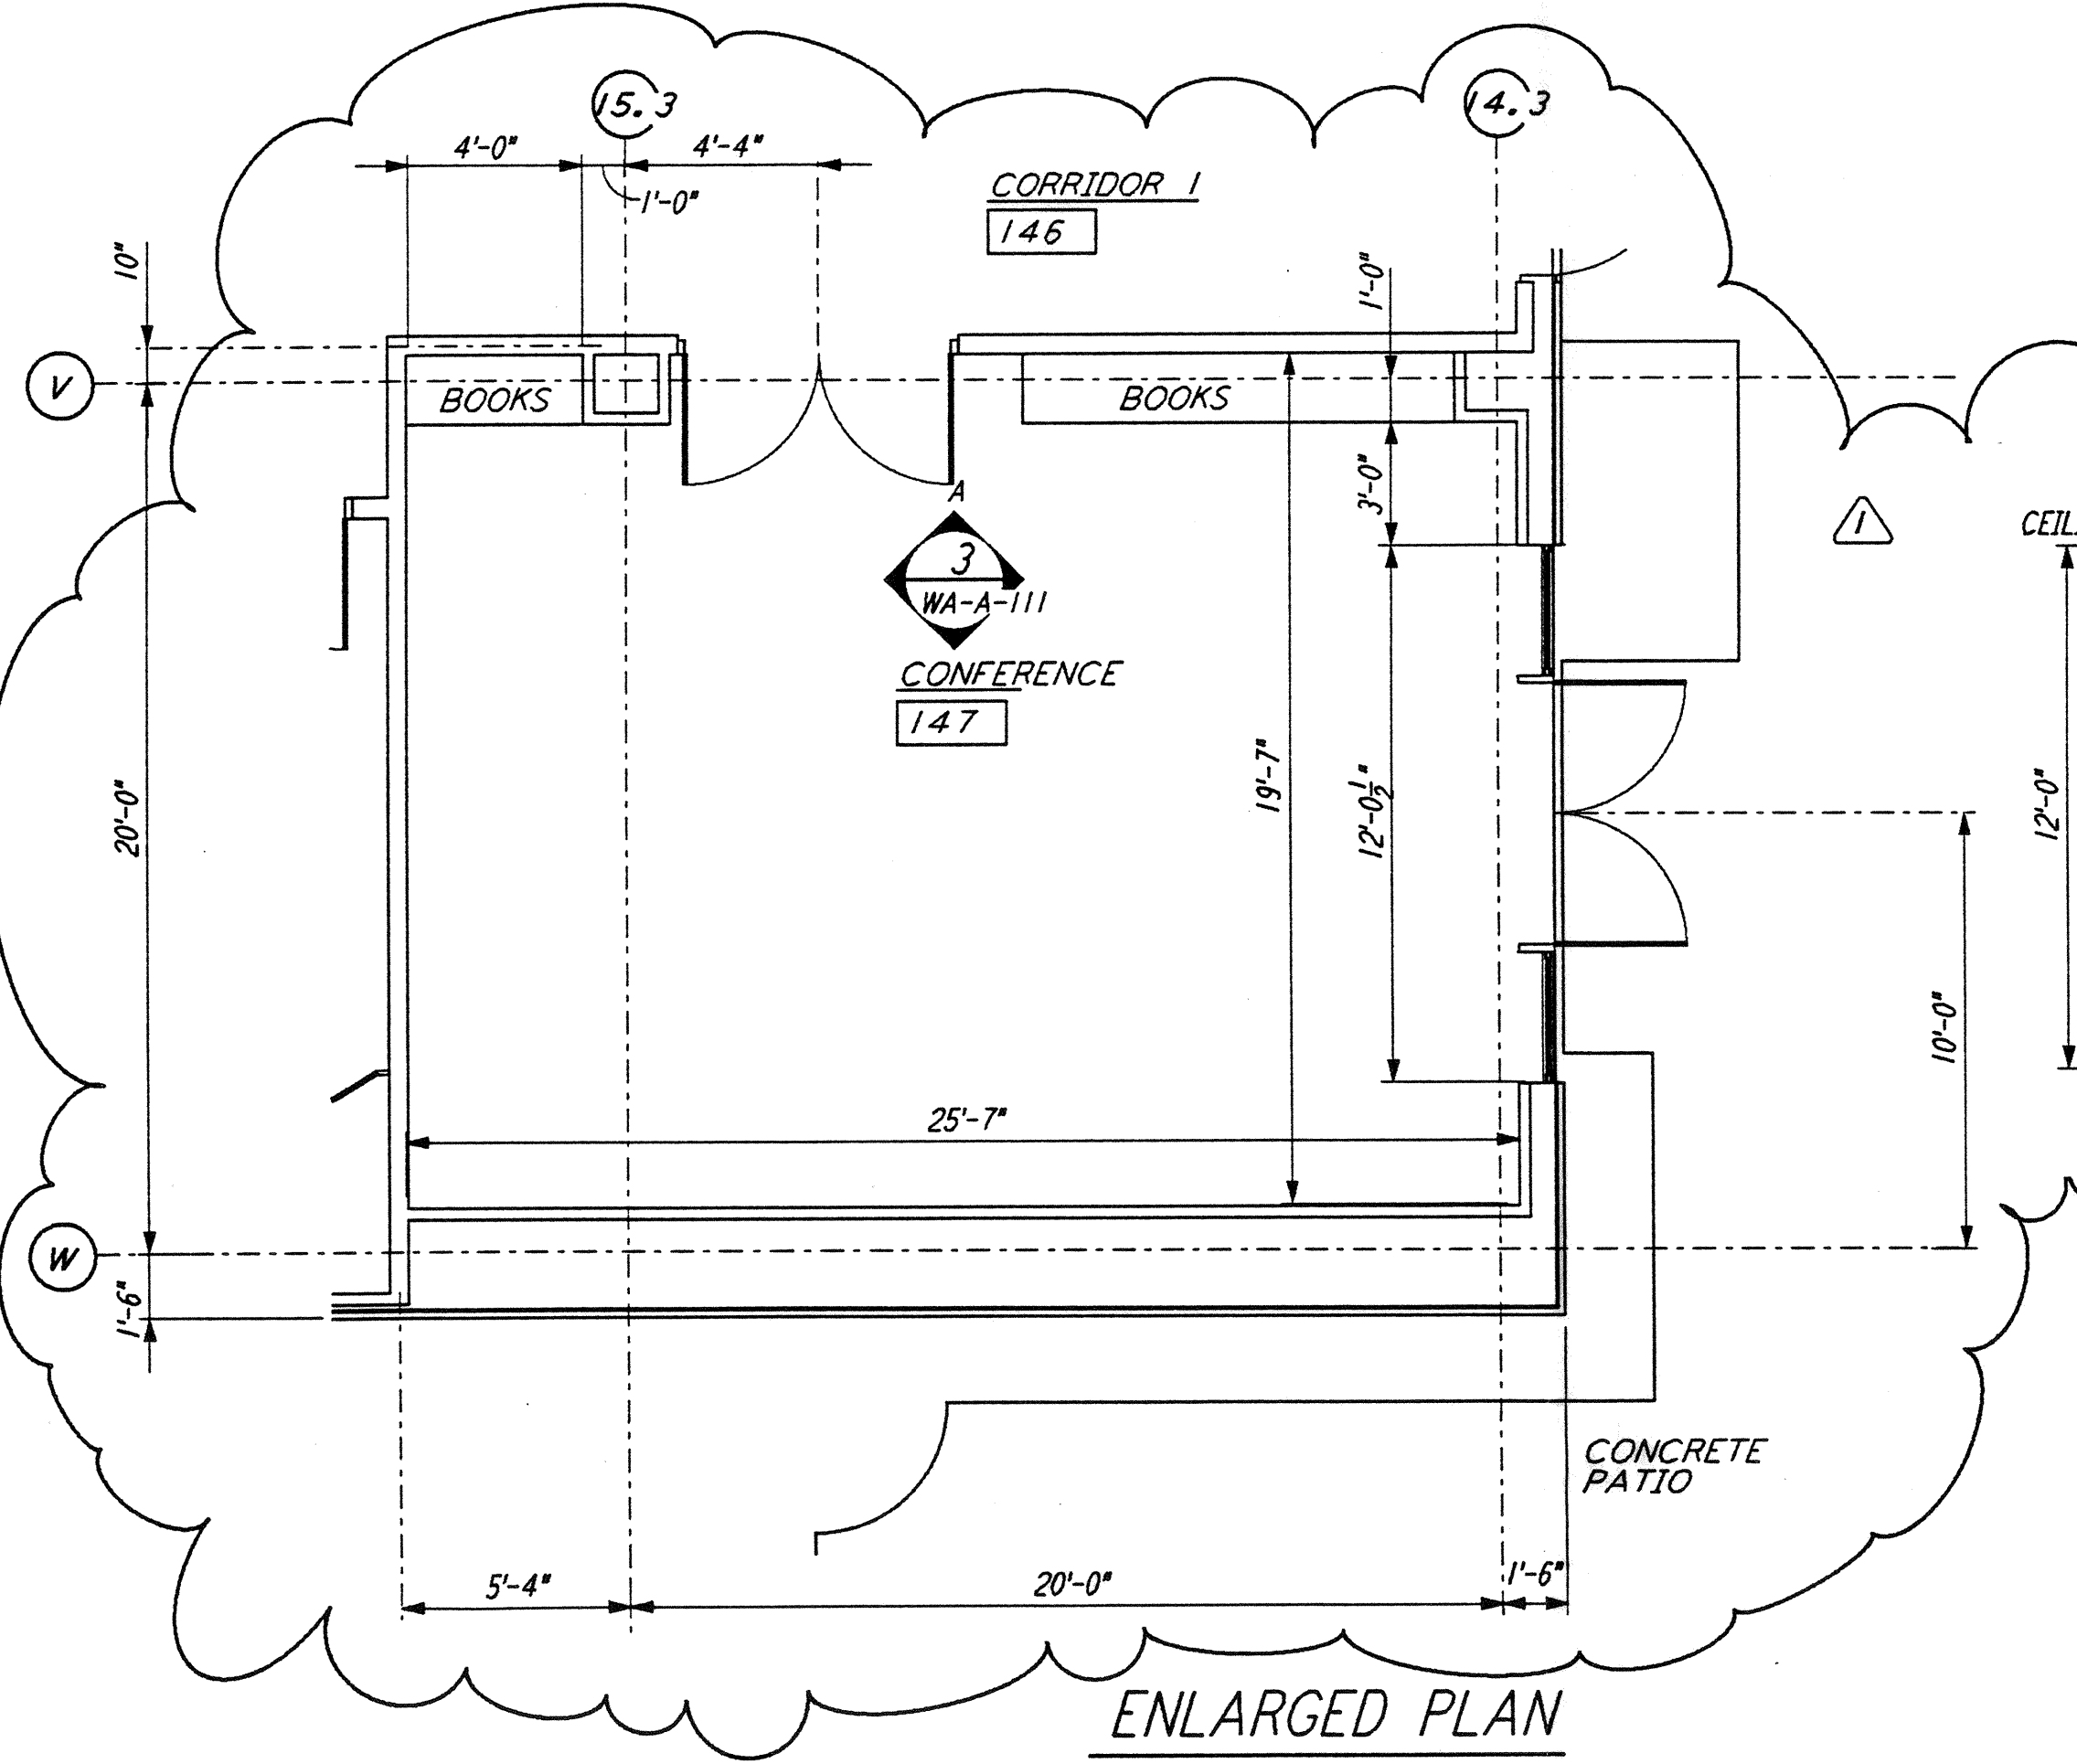


**CONFERENCE ROOM 147**  
 1/4" = 1'-0"

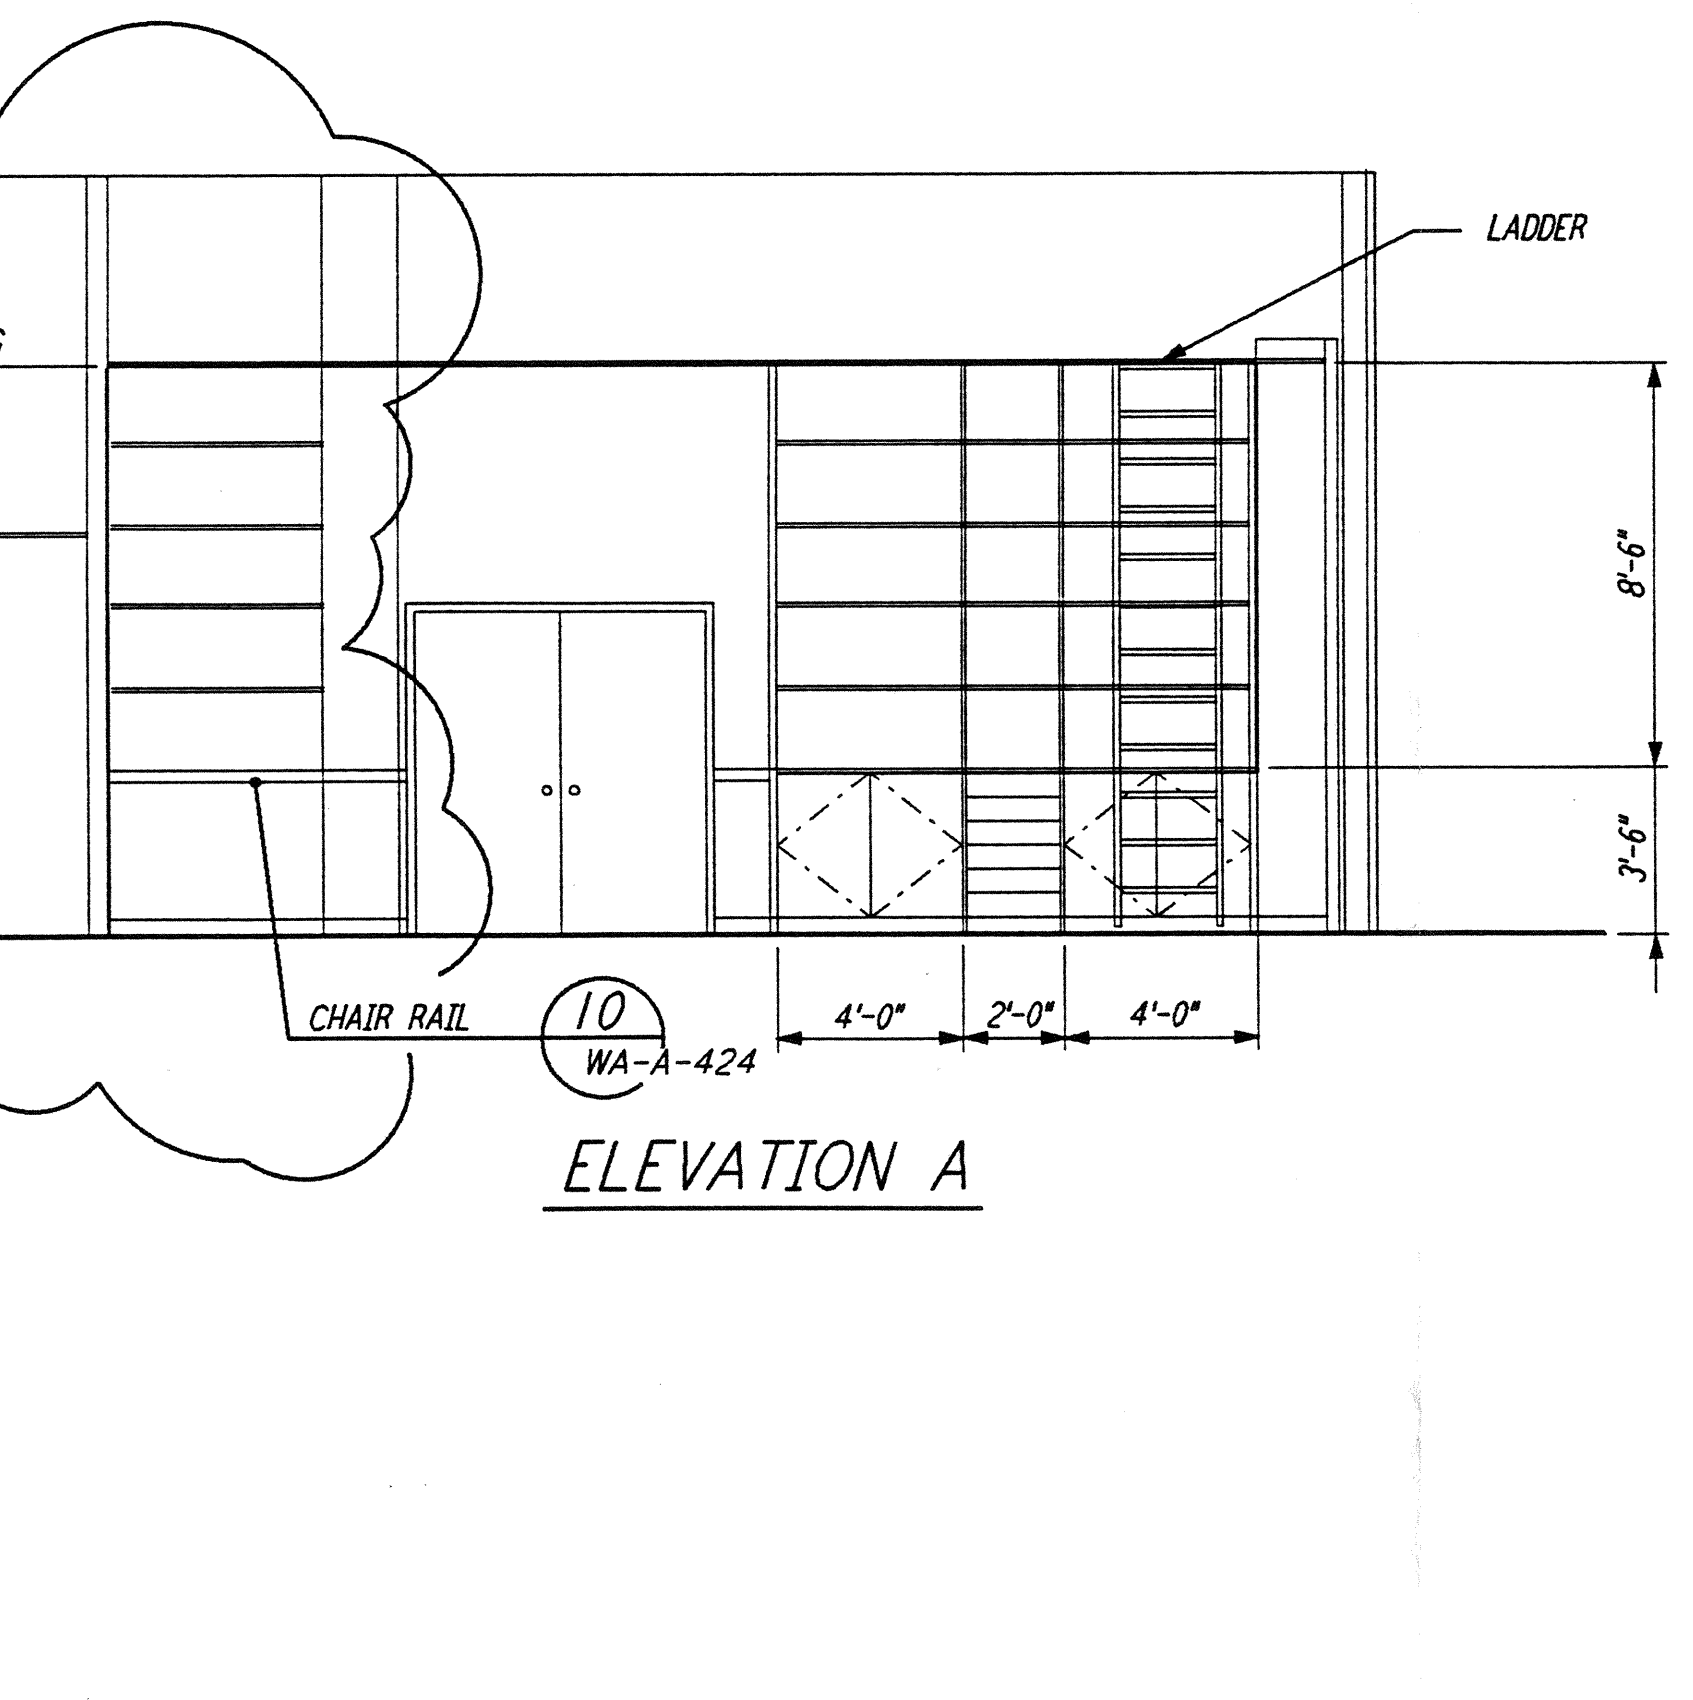


**ELEVATION A**  
 3 REF  
 WA-A-111 WA-A-108

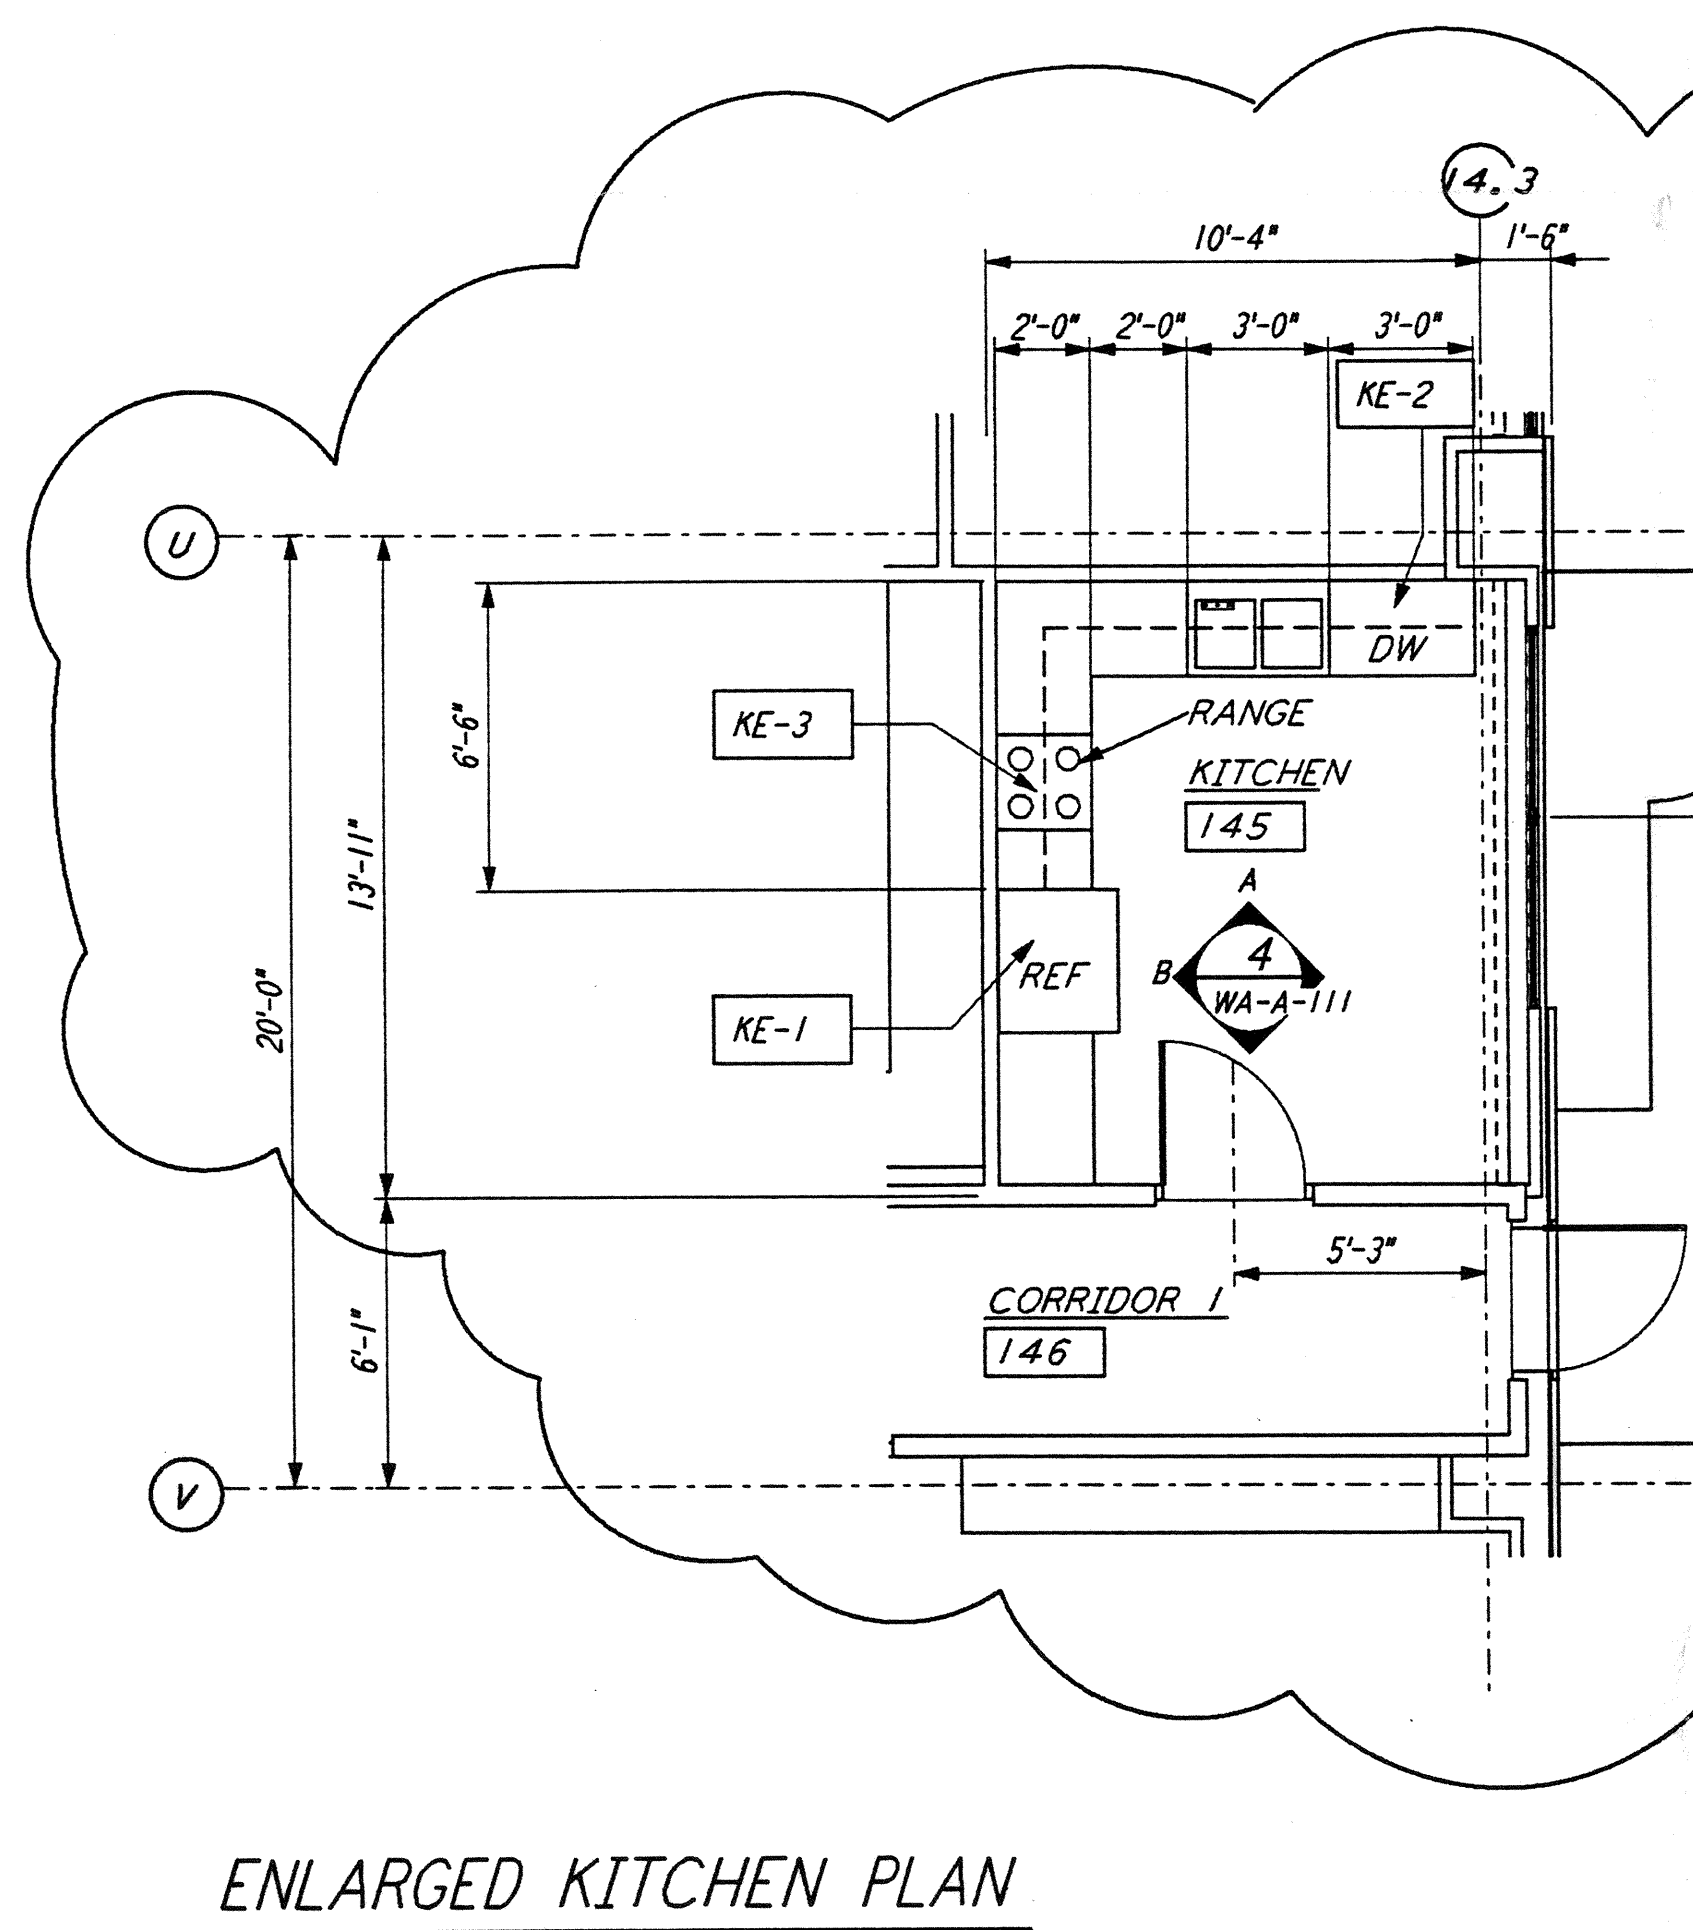

 1/4" = 1'-0"

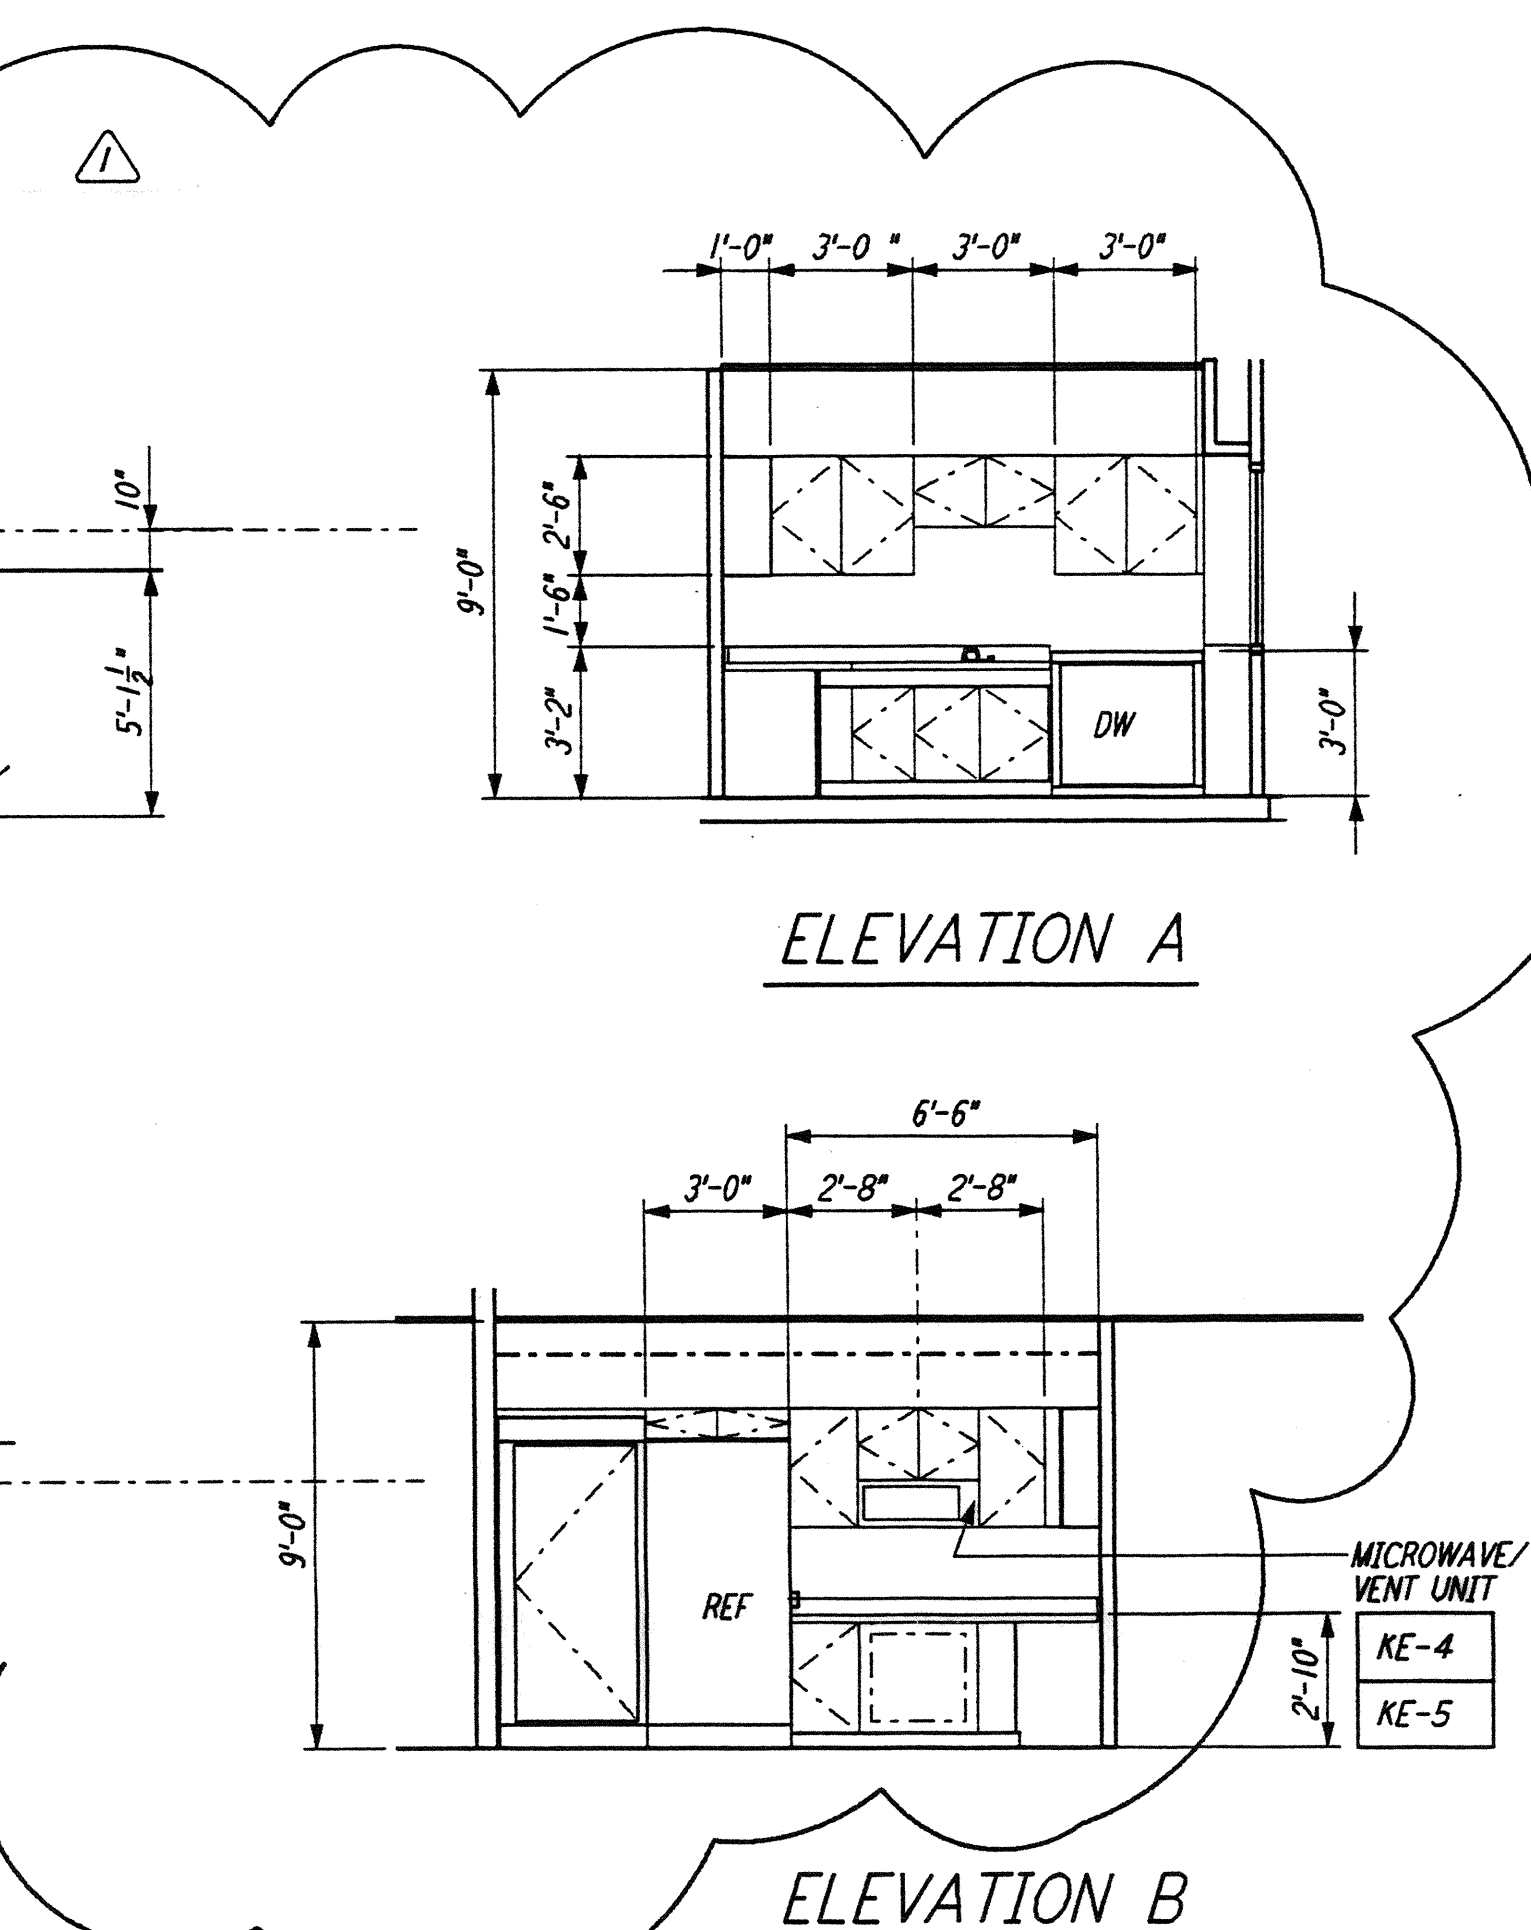

**ELEVATION A**  
**ELEVATION B**  
 4 REF  
 WA-A-111 WA-A-108

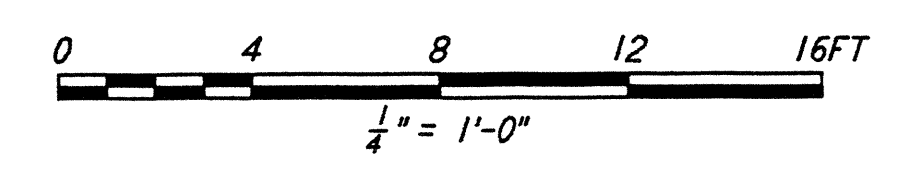

LIGO-D960250-01-0

This document and the design it covers are the property of PARSONS. They are loaned only with the borrower's expressed written agreement that they will not be reproduced, copied, loaned, exhibited, or used in any other way, except by written consent from PARSONS to the borrower.

This document and the design it covers are the property of PARSONS. They are loaned only with the borrower's expressed written agreement that they will not be reproduced, copied, loaned, exhibited, or used in any other way, except by written consent from PARSONS to the borrower.

ed: Mar 11 12:20:33.137 537X.BDDC K:\Y\LUIS\MAJUELA\3062\W00111.DWG

K:\P\US\NAMES\3062\W00111.DWG 537X.BDDC

NO.	DATE	BY	CHKD	ENGR	PROJ	OSB REVISION	DESCRIPTION
1	2-28-97	CKT	TB	AK	TDW	OSB	REVISION
ISSUED FOR CONSTRUCTION DRAWN CKT 5-12-96 CHECKED TB 5-26-96 ENGINEER bkr 7-12-96 PROJ MDW 7-12-96							

6609 REGISTERED ARCHITECT  
 ALEX ANDREW KRILL  
 STATE OF WASHINGTON  
 3/25/97

**PARSONS**  
 100 WEST WALNUT STREET  
 PASADENA, CALIFORNIA

**LIGO**  
 CALIFORNIA INSTITUTE OF TECHNOLOGY  
 MASSACHUSETTS INSTITUTE OF TECHNOLOGY

LASER INTERFEROMETER  
 GRAVITATIONAL-WAVE OBSERVATORY  
 SITE NO. 1 - HANFORD, WASHINGTON

ARCHITECTURAL CORNER STATION  
 OSB ENLARGED PLANS

SCALE: AS NOTED  
 CONTRACT NUMBER: PPI50969  
 PROJECT NUMBER: 8094  
**WA-A-111**