This document and the design it covers are the property of **PARSONS**. They are loaned only with the borrower's expressed written agreement that they will not be reproduced, copied, loaned, exhibited, or used in any other way, except by written consent from **PARSONS** to the borrower.

DATE: 05/22:96 TIME: 09:46:36
DESIGN FILE: I:\ligo\site\ar\waa132.d3z

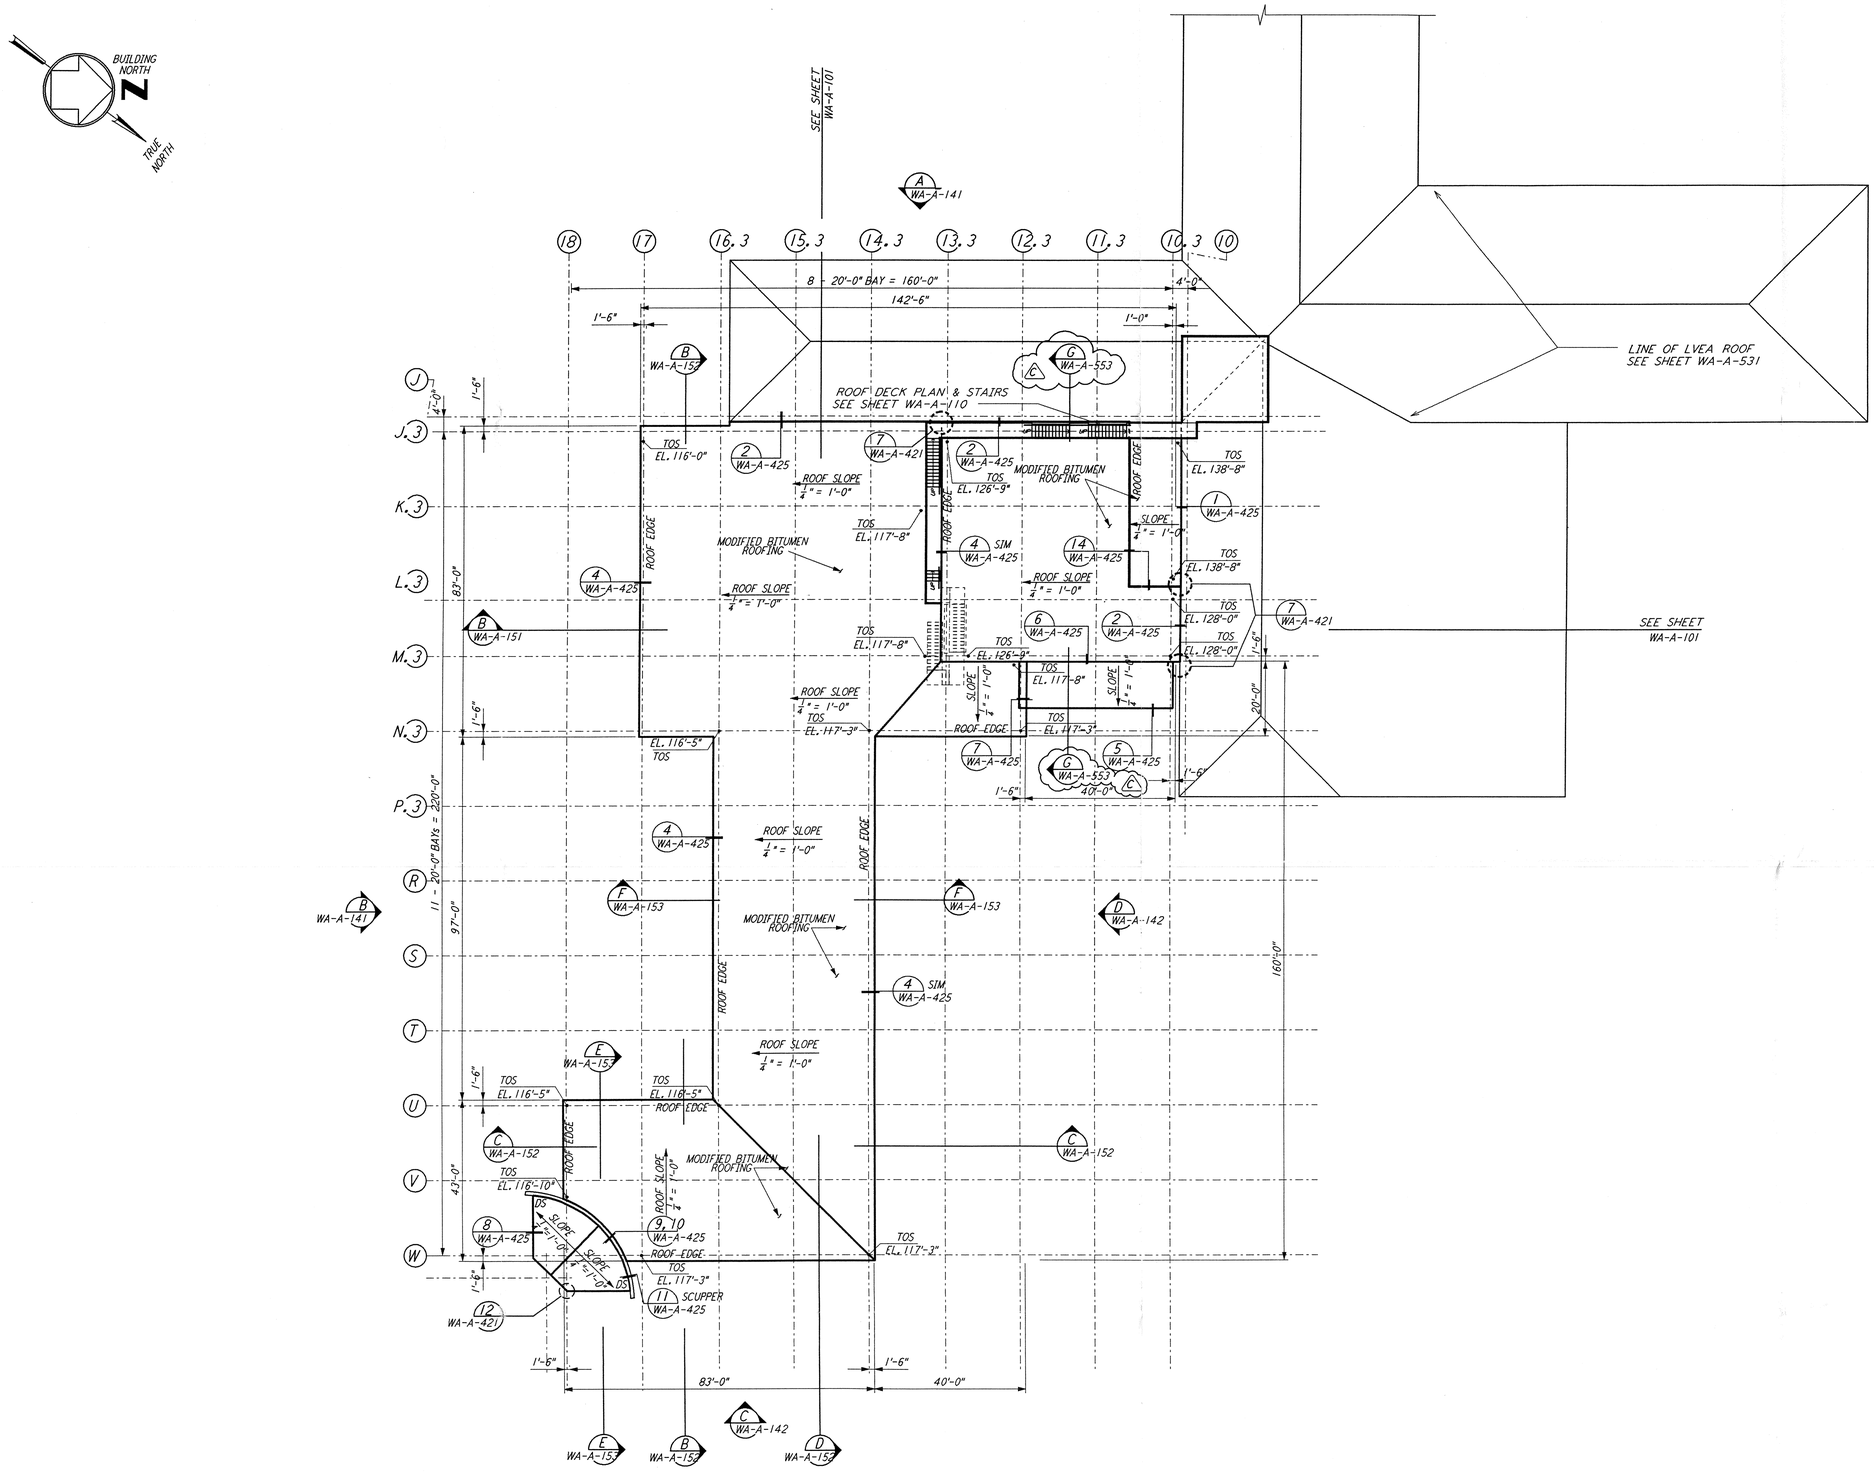

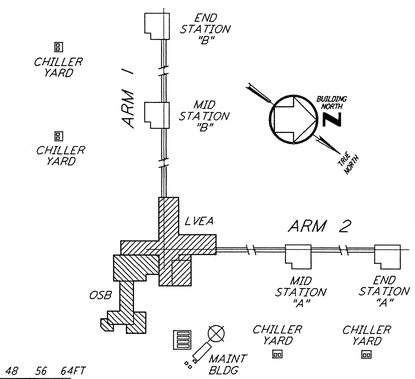

KEY PLAN

0 8 16 24 32 40 48 56 64FT
1/16" = 1'-0"

DATUM POINT EL +100.00 = 531.11' (LVEA)
DATUM POINT EL +100.00 = 531.11' (OSB)

LIGO-D960254-C-O

REFERENCES		REVISIONS						
DRAWING NO.	DESCRIPTION	NO.	DATE	BY	CHKD	ENGR	PROJ	DESCRIPTION
		C	5-22-96	BK	BK	SF	TDM	BID ADDENDUM #2
		B	4-19-96		SF	SF	TDM	FINAL DESIGN REVIEW & BID
		A	01/17/96		SF	SF	TDM	PRELIMINARY DESIGN REVIEW

DRAWN	CKT	
CHECKED		
ENGINEER		
PROJ		

PARSONS
100 WEST WALNUT STREET
PASADENA, CALIFORNIA

LIGO
CALIFORNIA INSTITUTE OF TECHNOLOGY
MASSACHUSETTS INSTITUTE OF TECHNOLOGY

LASER INTERFEROMETER GRAVITATIONAL-WAVE OBSERVATORY
SITE NO. 1 - HANFORD, WASHINGTON

TITLE
ARCHITECTURAL
CORNER STATION
OSB ROOF PLAN

SCALE	CONTRACT NUMBER	PROJECT NUMBER
	PP150969	8094

SHEET NUMBER: WA-A-132
REVISIONS: C

LIGOWAF3.PDR