



This document and the design it covers are the property of **PARSONS**. They are loaned only with the borrower's expressed written agreement that they will not be reproduced, copied, loaned, exhibited, or used in any other way, except by written consent from **PARSONS** to the borrower.

This document and the design it covers are the property of **PARSONS**. They are loaned only with the borrower's expressed written agreement that they will

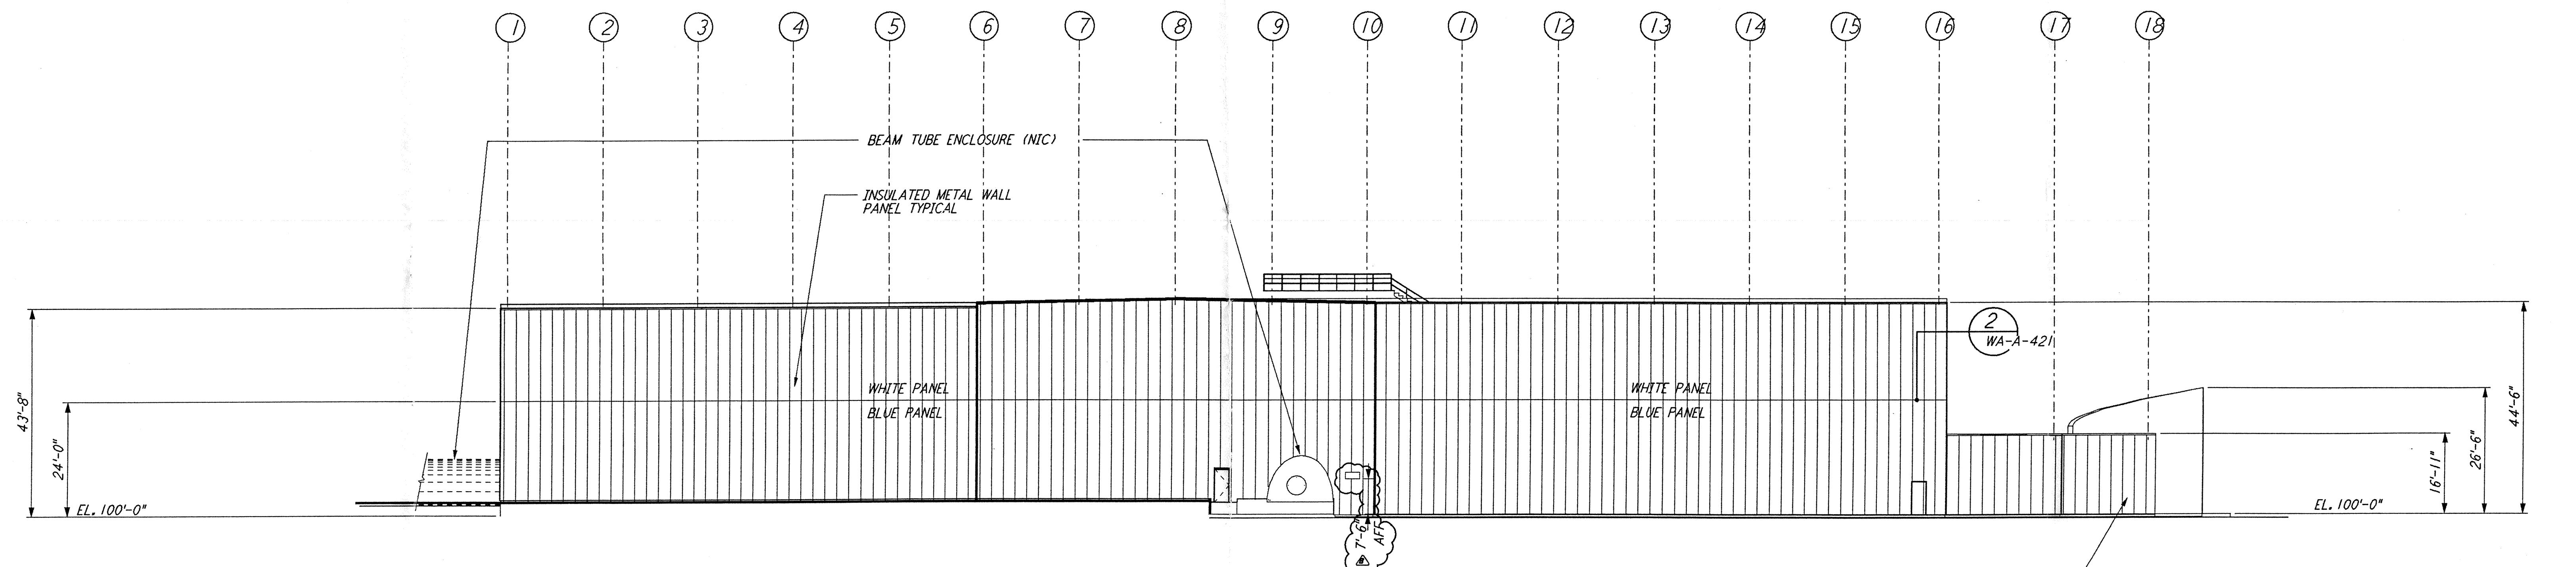

ELEVATION A REF  
 $\frac{1}{16}'' = 1'-0''$   
WA-A-541 WA-A-107  
WA-A-501

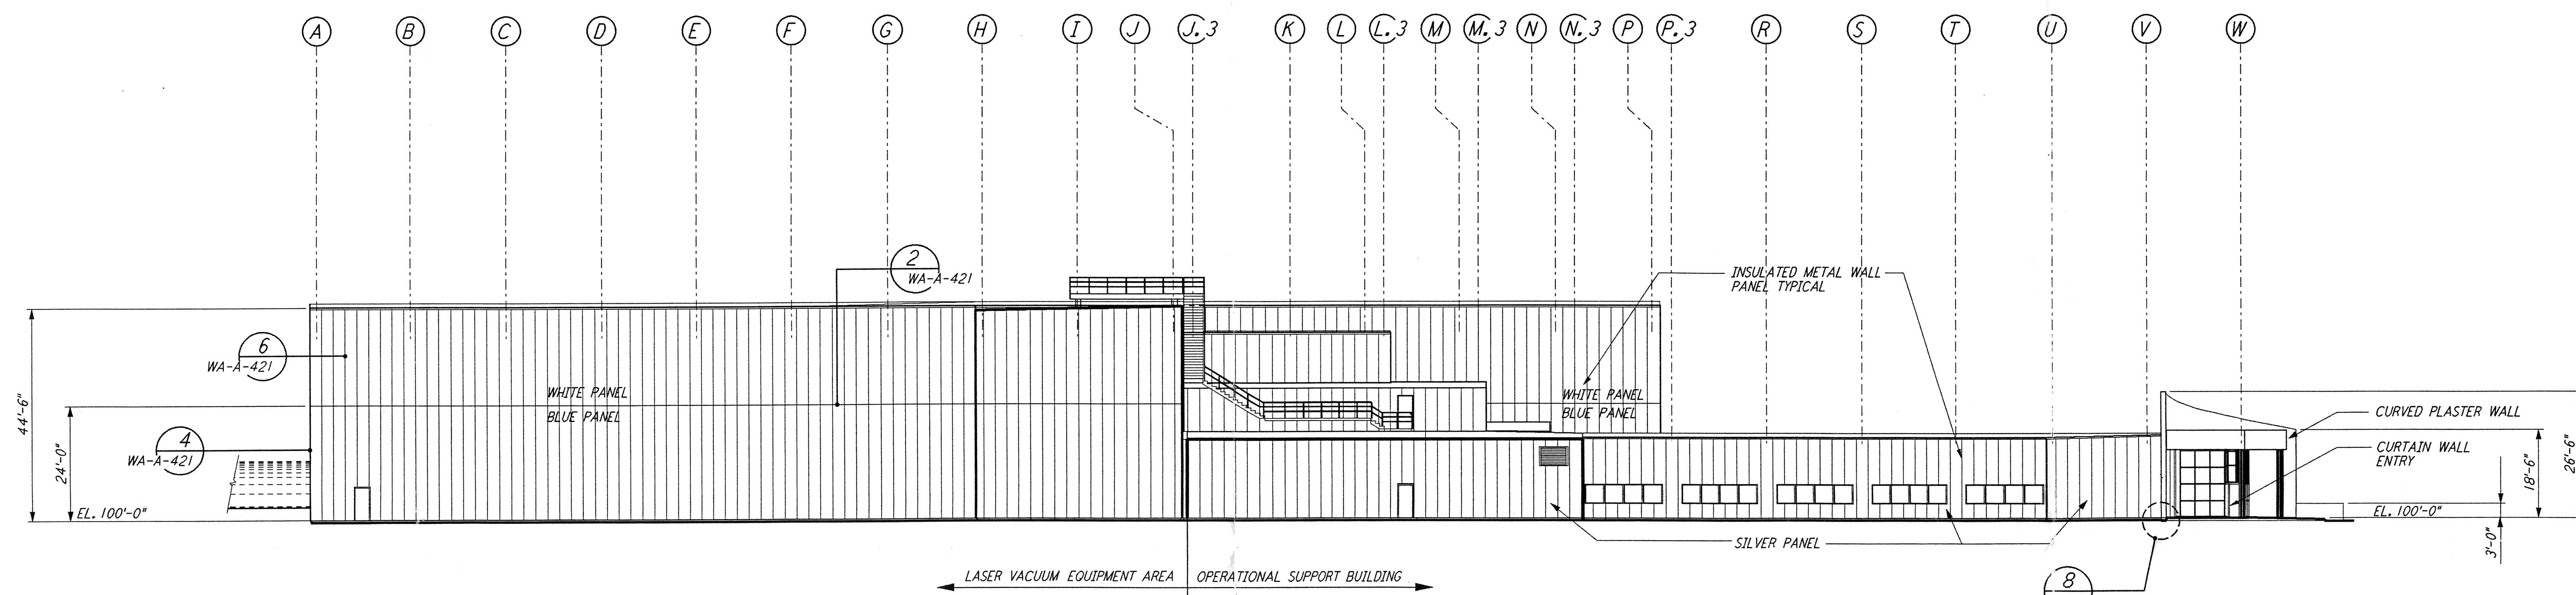

ELEVATION B REF  
 $\frac{1}{16}'' = 1'-0''$   
WA-A-541 WA-A-107  
WA-A-501

DATUM POINT EL +100,00 = 531.11' ( LVEA ) 0 8 16 24 32 40 48 56 64FT  
DATUM POINT EL +100,00 = 531.11' ( OSB ) 0 8 16 24 32 40 48 56 64FT  
 $\frac{1}{16}'' = 1'-0''$


LIGO-D960281-B-0

REFERENCES		REVISIONS			
		DRAWN	CKT	CHECKED	PROJ
B	5-22-96	BK	BK	SF	DOM
A	4-19-96	SF	SF	TDM	BID ADDENDUM #2 FINAL DESIGN REVIEW & BID

NO.	DATE	BY	CHKD	ENGR	PROJ

DESCRIPTION

DESCRIPTION

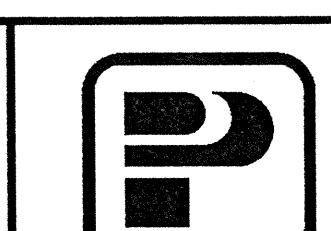

**PARSONS**

100 WEST WALNUT STREET  
PASADENA, CALIFORNIA



CALIFORNIA INSTITUTE OF TECHNOLOGY  
MASSACHUSETTS INSTITUTE OF TECHNOLOGY

TITLE		SCALE	CONTRACT NUMBER	PROJECT NUMBER
ARCHITECTURAL CORNER STATION LVEA & OSB ELEVATIONS SHEET 1	AS NOTED	PP150969	8094	
WA-A-541	REVISIONS			