



This document and the design it covers are the property of PARSONS. They are loaned only with the borrower's expressed written agreement that they will not be reproduced, copied, loaned, exhibited, or used in any other way, except by written consent from PARSONS to the borrower.

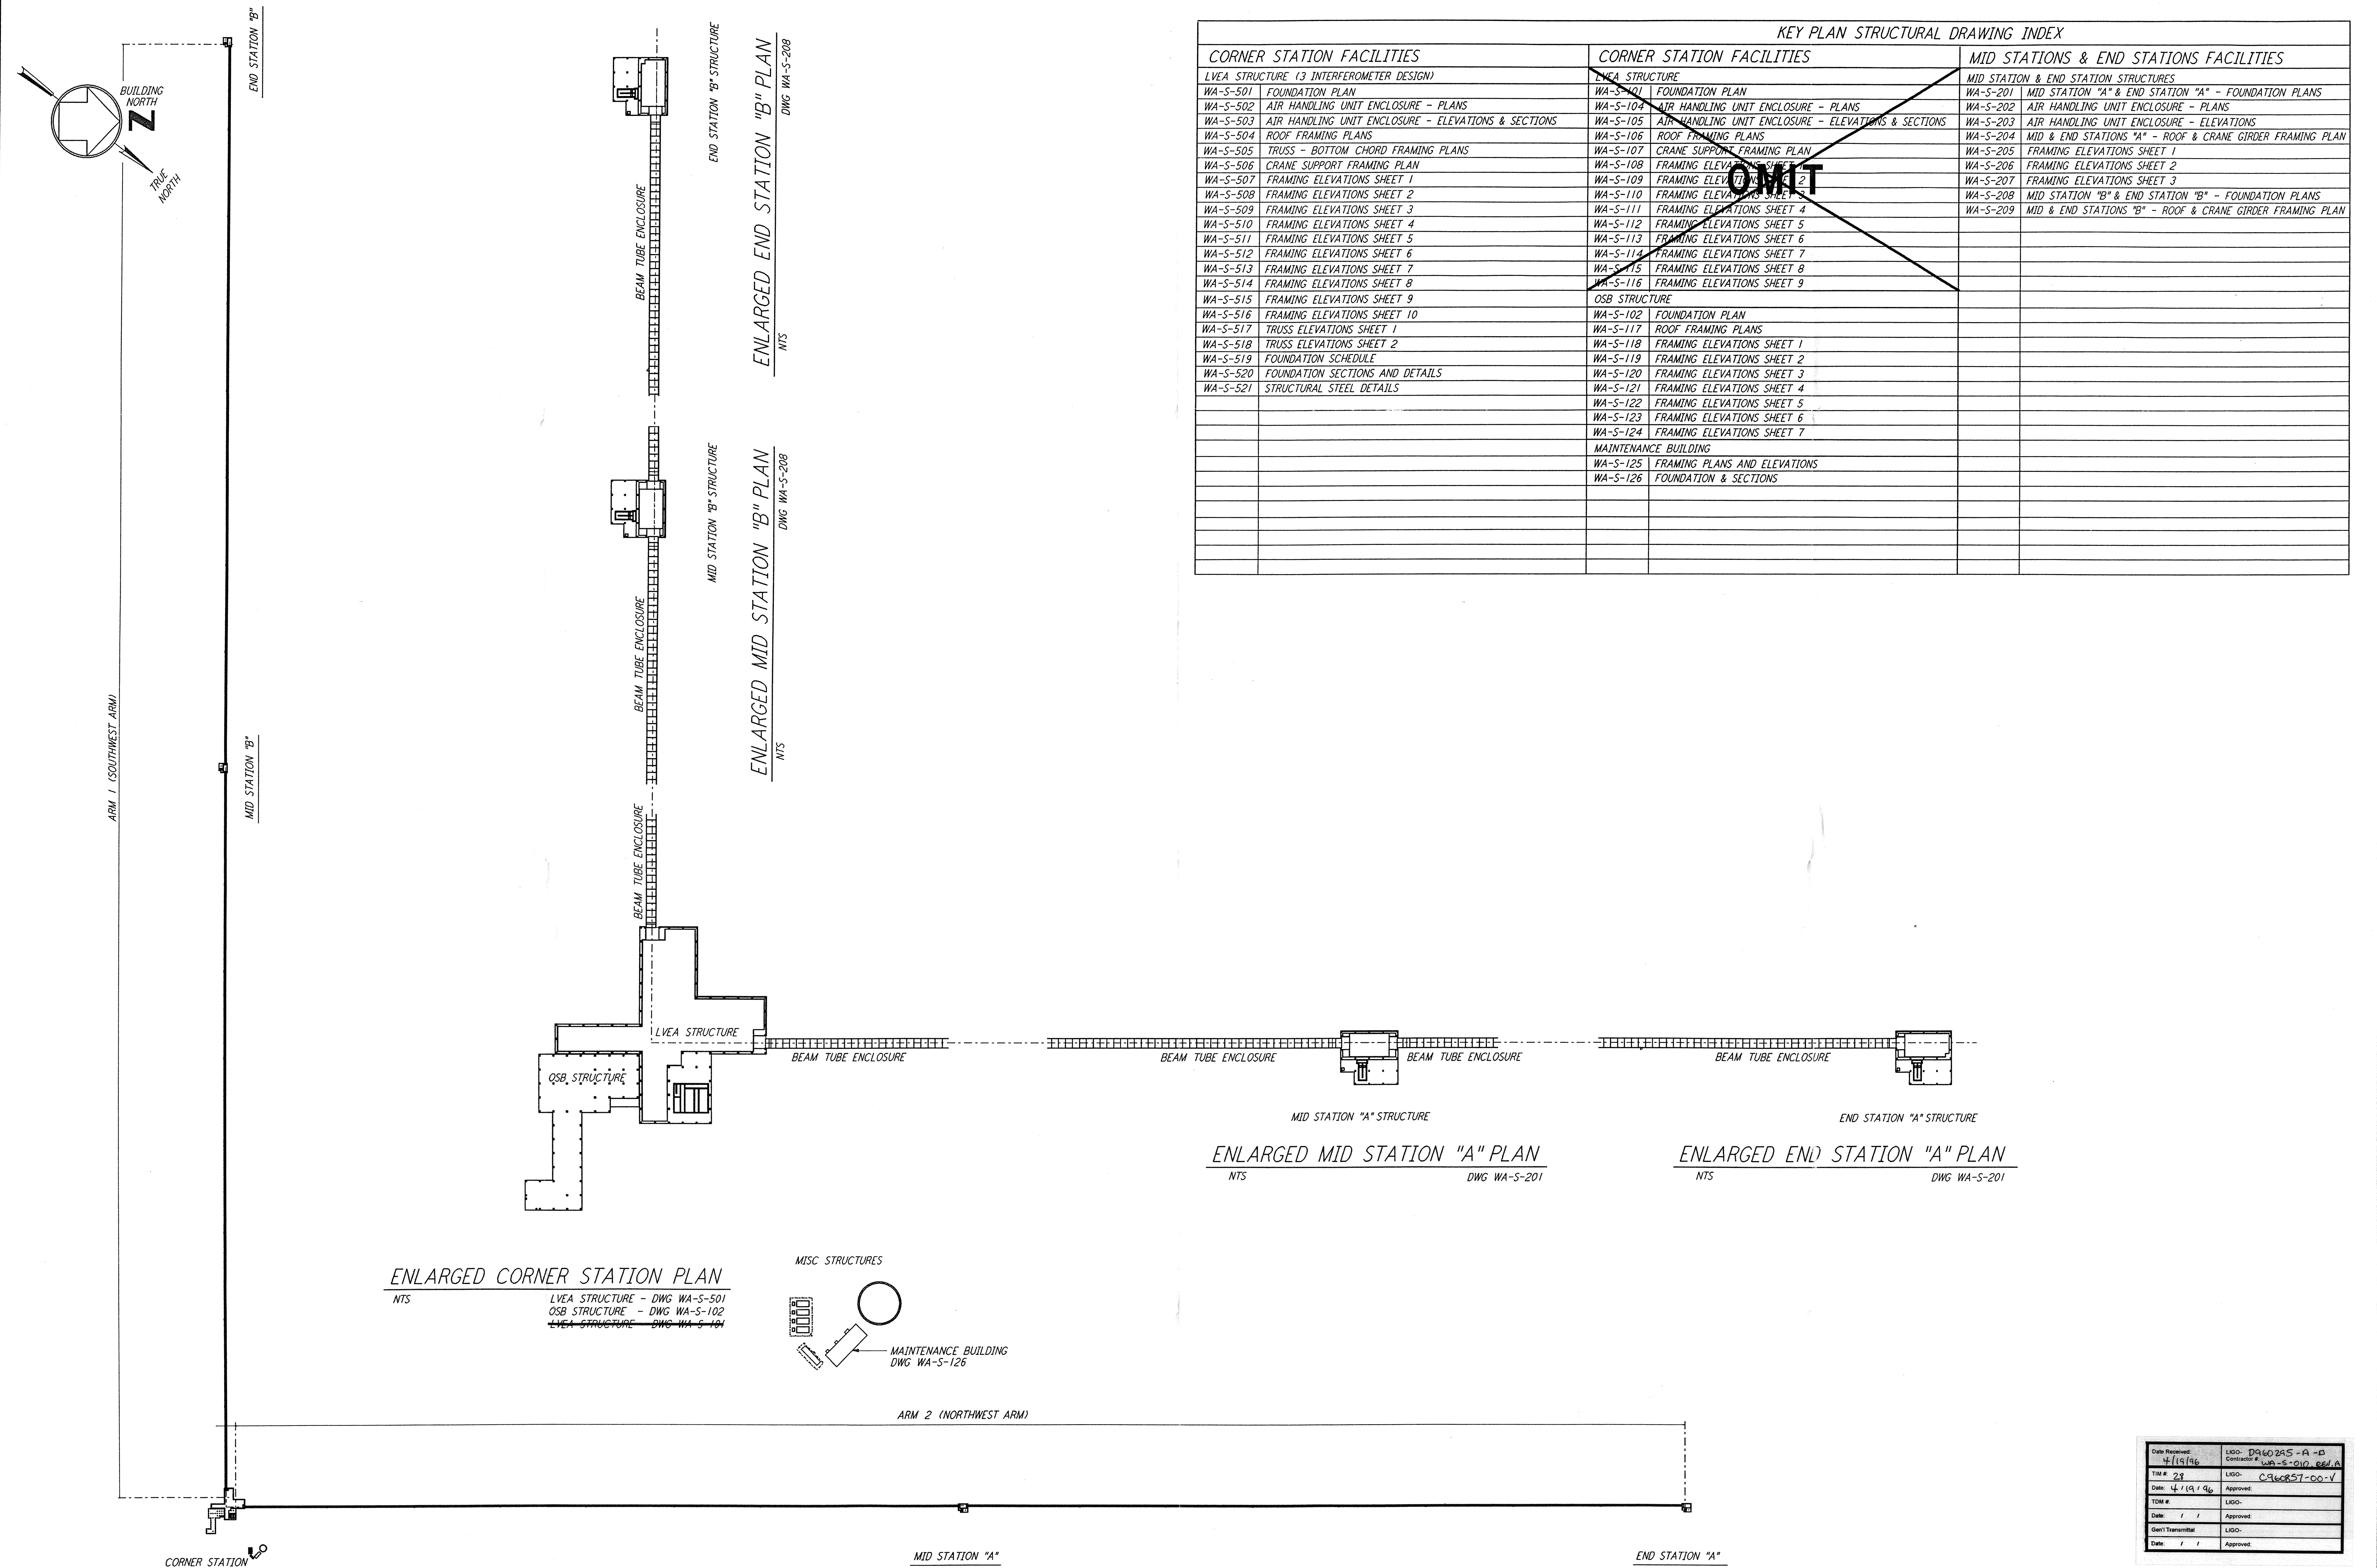

KEY PLAN STRUCTURAL DRAWING INDEX		
CORNER STATION FACILITIES	CORNER STATION FACILITIES	MID STATIONS & END STATIONS FACILITIES
LVEA STRUCTURE (3 INTERFEROMETER DESIGN)	LVEA STRUCTURE	MID STATION & END STATION STRUCTURES
WA-S-501 FOUNDATION PLAN	WA-S-101 FOUNDATION PLAN	WA-S-201 MID STATION "A" & END STATION "A" - FOUNDATION PLANS
WA-S-502 AIR HANDLING UNIT ENCLOSURE - PLANS	WA-S-102 AIR HANDLING UNIT ENCLOSURE - PLANS	WA-S-202 AIR HANDLING UNIT ENCLOSURE - PLANS
WA-S-503 AIR HANDLING UNIT ENCLOSURE - ELEVATIONS & SECTIONS	WA-S-103 AIR HANDLING UNIT ENCLOSURE - ELEVATIONS & SECTIONS	WA-S-203 AIR HANDLING UNIT ENCLOSURE - ELEVATIONS
WA-S-504 ROOF FRAMING PLANS	WA-S-104 ROOF FRAMING PLANS	WA-S-204 MID & END STATIONS "A" - ROOF & CRANE GIRDER FRAMING PLAN
WA-S-505 TRUSS - BOTTOM CHORD FRAMING PLANS	WA-S-105 CRANE SUPPORT FRAMING PLAN	WA-S-205 FRAMING ELEVATIONS SHEET 1
WA-S-506 CRANE SUPPORT FRAMING PLAN	WA-S-106 FRAMING ELEVATIONS SHEET 1	WA-S-206 FRAMING ELEVATIONS SHEET 2
WA-S-507 FRAMING ELEVATIONS SHEET 1	WA-S-107 FRAMING ELEVATIONS SHEET 2	WA-S-207 FRAMING ELEVATIONS SHEET 3
WA-S-508 FRAMING ELEVATIONS SHEET 2	WA-S-108 FRAMING ELEVATIONS SHEET 3	WA-S-208 MID STATION "B" & END STATION "B" - FOUNDATION PLANS
WA-S-509 FRAMING ELEVATIONS SHEET 3	WA-S-109 FRAMING ELEVATIONS SHEET 4	WA-S-209 MID & END STATIONS "B" - ROOF & CRANE GIRDER FRAMING PLAN
WA-S-510 FRAMING ELEVATIONS SHEET 4	WA-S-110 FRAMING ELEVATIONS SHEET 5	
WA-S-511 FRAMING ELEVATIONS SHEET 5	WA-S-111 FRAMING ELEVATIONS SHEET 6	
WA-S-512 FRAMING ELEVATIONS SHEET 6	WA-S-112 FRAMING ELEVATIONS SHEET 7	
WA-S-513 FRAMING ELEVATIONS SHEET 7	WA-S-113 FRAMING ELEVATIONS SHEET 8	
WA-S-514 FRAMING ELEVATIONS SHEET 8	WA-S-114 FRAMING ELEVATIONS SHEET 9	
WA-S-515 FRAMING ELEVATIONS SHEET 9	OSB STRUCTURE	
WA-S-516 FRAMING ELEVATIONS SHEET 10	WA-S-102 FOUNDATION PLAN	
WA-S-517 TRUSS ELEVATIONS SHEET 1	WA-S-117 ROOF FRAMING PLANS	
WA-S-518 TRUSS ELEVATIONS SHEET 2	WA-S-118 FRAMING ELEVATIONS SHEET 1	
WA-S-519 FOUNDATION SCHEDULE	WA-S-119 FRAMING ELEVATIONS SHEET 2	
WA-S-520 FOUNDATION SECTIONS AND DETAILS	WA-S-120 FRAMING ELEVATIONS SHEET 3	
WA-S-521 STRUCTURAL STEEL DETAILS	WA-S-121 FRAMING ELEVATIONS SHEET 4	
	WA-S-122 FRAMING ELEVATIONS SHEET 5	
	WA-S-123 FRAMING ELEVATIONS SHEET 6	
	WA-S-124 FRAMING ELEVATIONS SHEET 7	
	MAINTENANCE BUILDING	
	WA-S-125 FRAMING PLANS AND ELEVATIONS	
	WA-S-126 FOUNDATION & SECTIONS	

ENLARGED CORNER STATION PLAN
 NTS
 LVEA STRUCTURE - DWG WA-S-501
 OSB STRUCTURE - DWG WA-S-102
 LVEA STRUCTURE - DWG WA-S-101

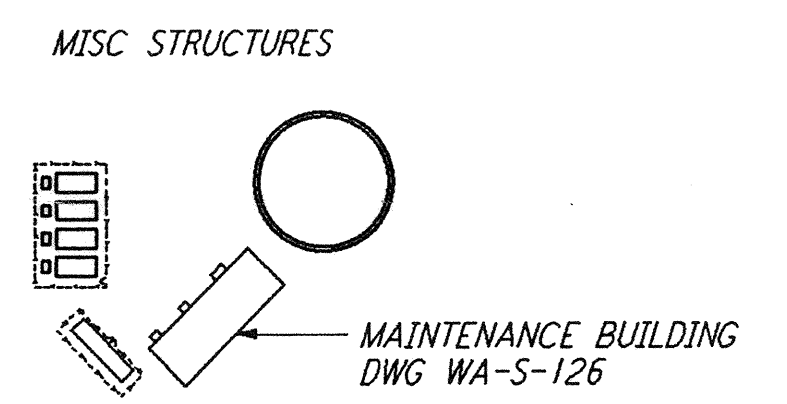

ENLARGED MID STATION "A" PLAN
 NTS
 DWG WA-S-201

ENLARGED END STATION "A" PLAN
 NTS
 DWG WA-S-201

REFERENCES	REVISIONS	DATE	BY	CHKD	ENGR	PROJ	DESCRIPTION
	A	4-19-96	MCS	DDM	PJH	DDM	FINAL DESIGN REVIEW & BID

DRAWN	MCS
CHECKED	
ENGINEER	
PROJ	

100 WEST WALNUT STREET
 PASADENA, CALIFORNIA

CALIFORNIA INSTITUTE OF TECHNOLOGY
 MASSACHUSETTS INSTITUTE OF TECHNOLOGY

LASER INTERFEROMETER
 GRAVITATIONAL-WAVE OBSERVATORY
 SITE NO. 1 - HANFORD, WASHINGTON

TITLE	SCALE	CONTRACT NUMBER	PROJECT NUMBER
STRUCTURAL KEY PLAN	NONE	PP150969	8094
SHEET NUMBER	WA-S-010		REVISIONS

Date Received	4/19/96	LIGO-D960295-A-B
Contract #	PP150969	WA-S-010, REV A
Date	4/19/96	Approved: C960295-00-V
TCM #		LIGO:
Date	/ /	Approved:
Gen'l Transmittal		LIGO:
Date	/ /	Approved: