



This document and the design it covers are the property of PARSONS. They are loaned only with the borrower's expressed written agreement that they will not be reproduced, copied, loaned, exhibited, or used in any other way, except by written consent from PARSONS to the borrower.

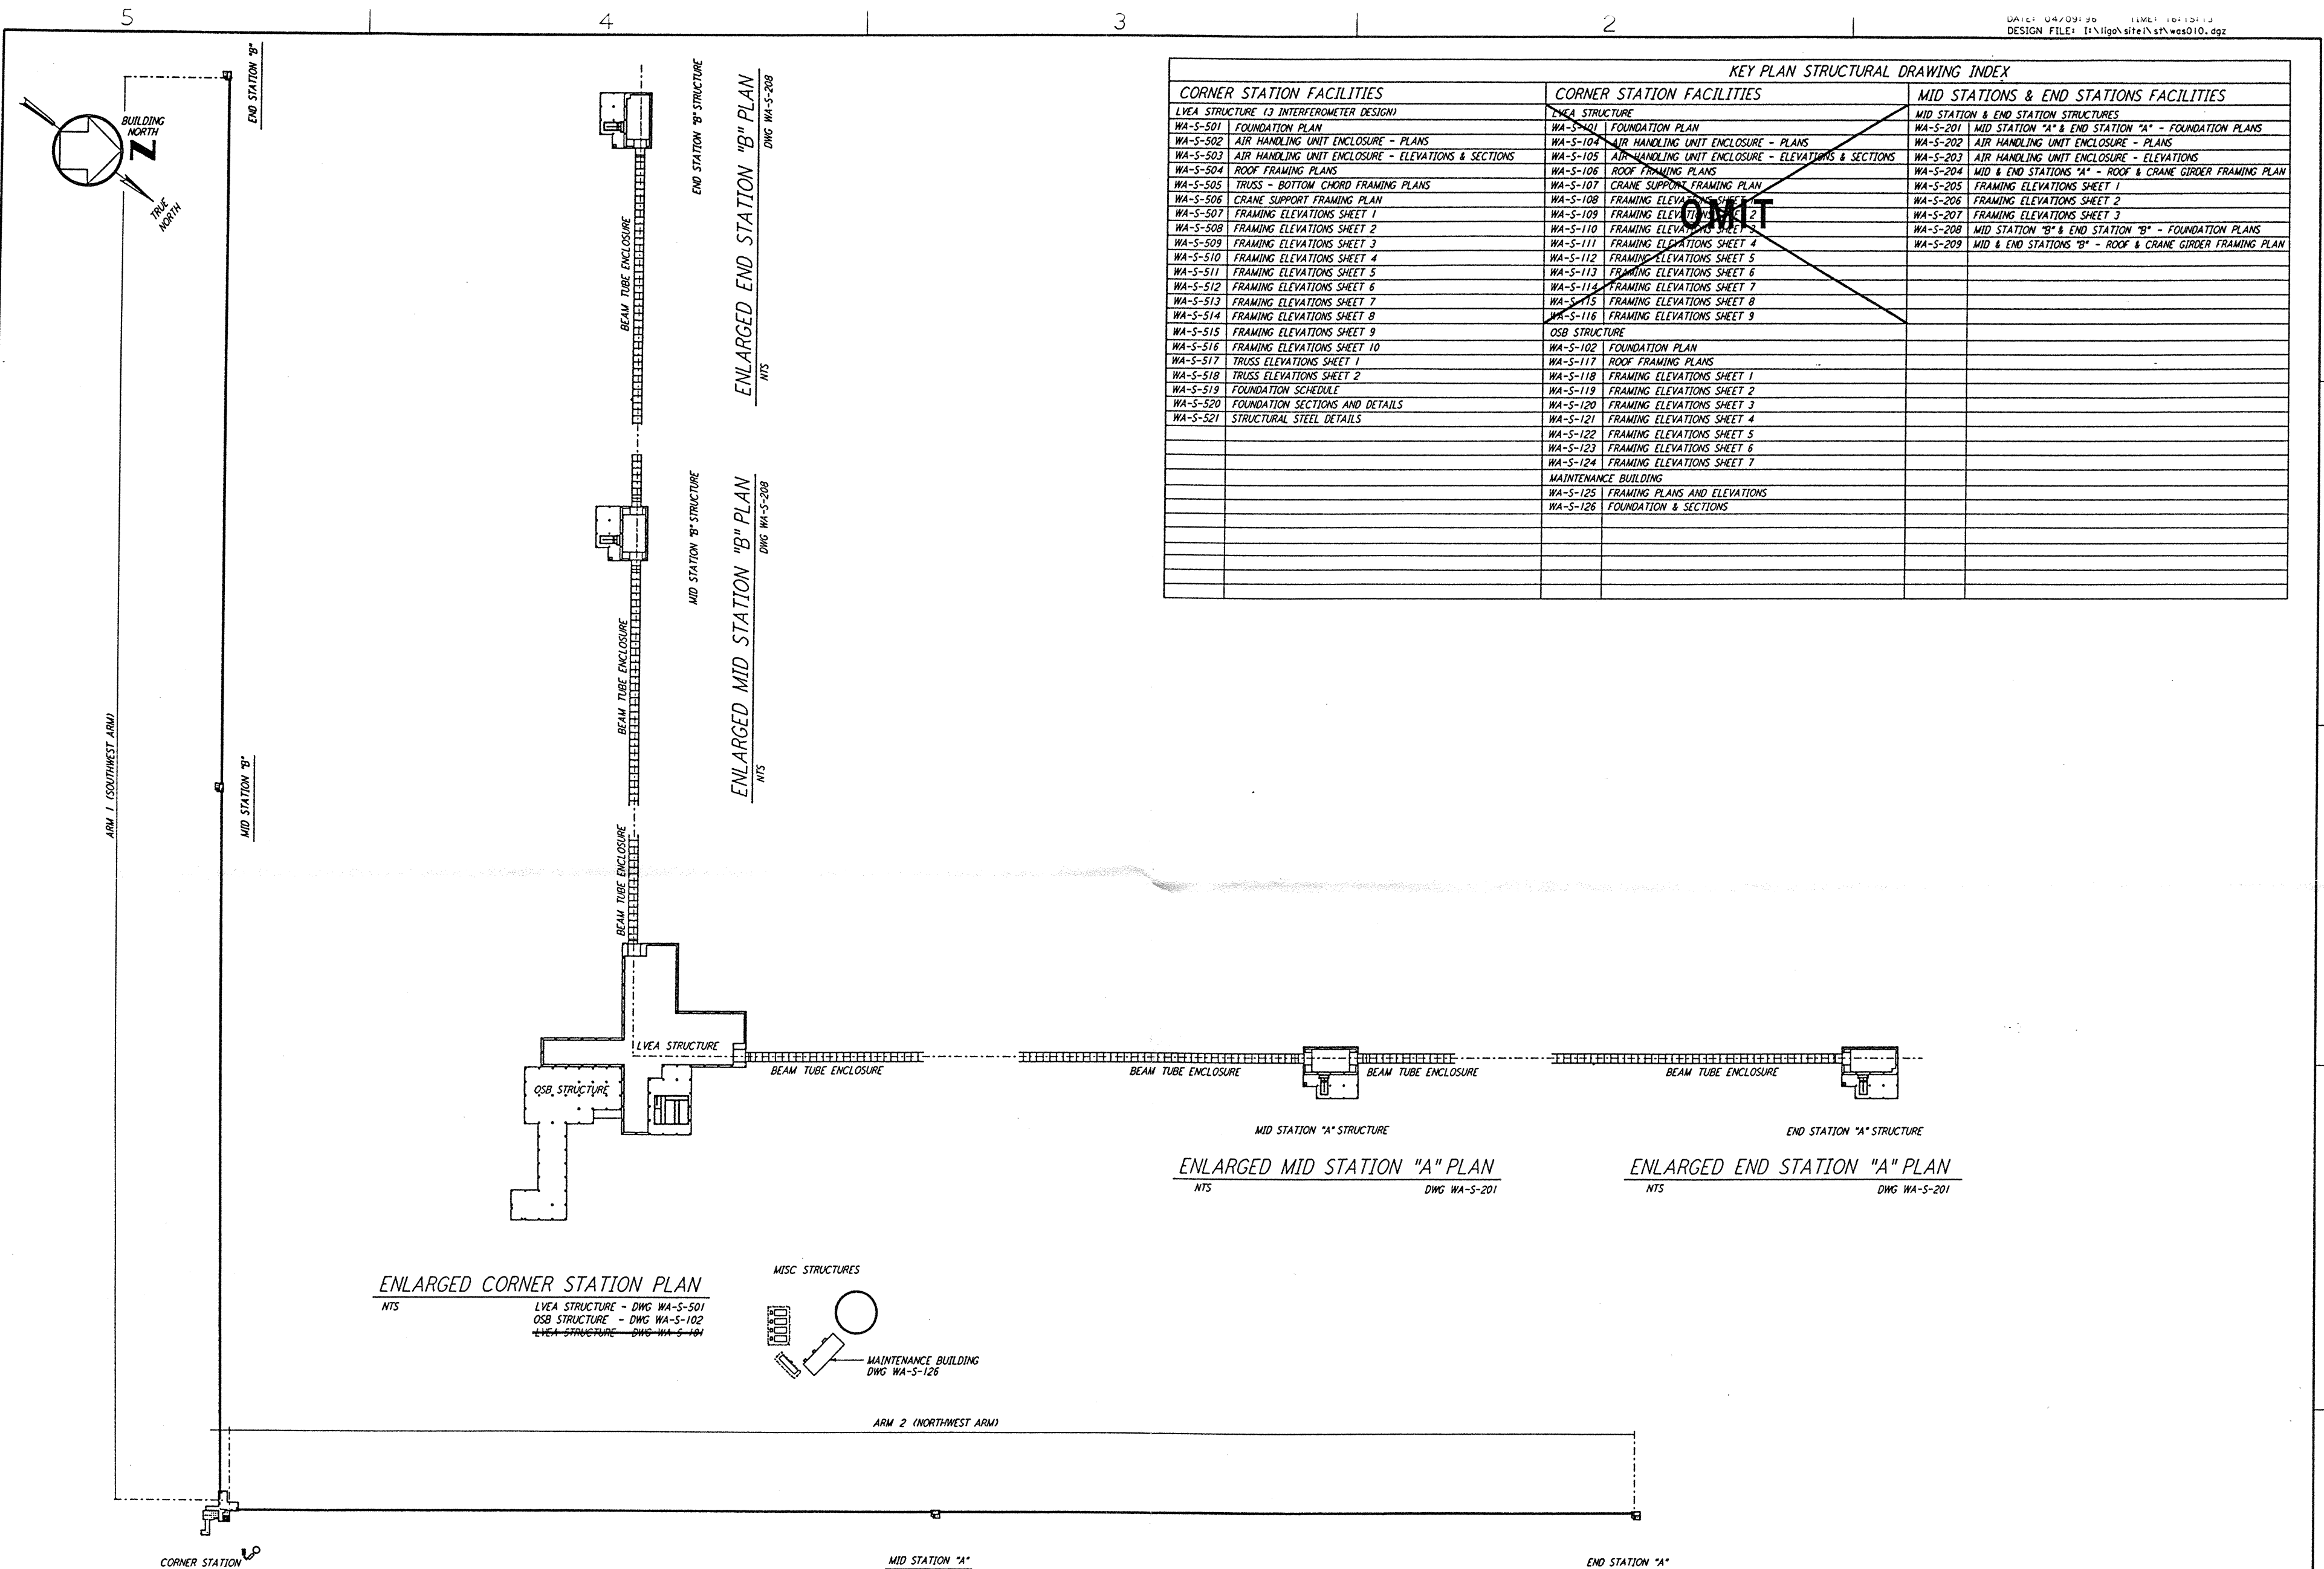

| KEY PLAN STRUCTURAL DRAWING INDEX | | |
|--|--|--|
| CORNER STATION FACILITIES | CORNER STATION FACILITIES | MID STATIONS & END STATIONS FACILITIES |
| LVEA STRUCTURE (3 INTERFEROMETER DESIGN) | LVEA STRUCTURE | MID STATION & END STATION STRUCTURES |
| WA-5-501 FOUNDATION PLAN | WA-5-101 FOUNDATION PLAN | WA-5-201 MID STATION "A" & END STATION "A" - FOUNDATION PLANS |
| WA-5-502 AIR HANDLING UNIT ENCLOSURE - PLANS | WA-5-104 AIR HANDLING UNIT ENCLOSURE - PLANS | WA-5-202 AIR HANDLING UNIT ENCLOSURE - PLANS |
| WA-5-503 AIR HANDLING UNIT ENCLOSURE - ELEVATIONS & SECTIONS | WA-5-105 AIR HANDLING UNIT ENCLOSURE - ELEVATIONS & SECTIONS | WA-5-203 AIR HANDLING UNIT ENCLOSURE - ELEVATIONS |
| WA-5-504 ROOF FRAMING PLANS | WA-5-106 ROOF FRAMING PLANS | WA-5-204 MID & END STATIONS "A" - ROOF & CRANE GIRDER FRAMING PLAN |
| WA-5-505 TRUSS - BOTTOM CHORD FRAMING PLANS | WA-5-107 CRANE SUPPORT FRAMING PLAN | WA-5-205 FRAMING ELEVATIONS SHEET 1 |
| WA-5-506 CRANE SUPPORT FRAMING PLAN | WA-5-108 FRAMING ELEVATIONS SHEET 1 | WA-5-206 FRAMING ELEVATIONS SHEET 2 |
| WA-5-507 FRAMING ELEVATIONS SHEET 1 | WA-5-109 FRAMING ELEVATIONS SHEET 2 | WA-5-207 FRAMING ELEVATIONS SHEET 3 |
| WA-5-508 FRAMING ELEVATIONS SHEET 2 | WA-5-110 FRAMING ELEVATIONS SHEET 3 | WA-5-208 MID STATION "B" & END STATION "B" - FOUNDATION PLANS |
| WA-5-509 FRAMING ELEVATIONS SHEET 3 | WA-5-111 FRAMING ELEVATIONS SHEET 4 | WA-5-209 MID & END STATIONS "B" - ROOF & CRANE GIRDER FRAMING PLAN |
| WA-5-510 FRAMING ELEVATIONS SHEET 4 | WA-5-112 FRAMING ELEVATIONS SHEET 5 | |
| WA-5-511 FRAMING ELEVATIONS SHEET 5 | WA-5-113 FRAMING ELEVATIONS SHEET 6 | |
| WA-5-512 FRAMING ELEVATIONS SHEET 6 | WA-5-114 FRAMING ELEVATIONS SHEET 7 | |
| WA-5-513 FRAMING ELEVATIONS SHEET 7 | WA-5-115 FRAMING ELEVATIONS SHEET 8 | |
| WA-5-514 FRAMING ELEVATIONS SHEET 8 | WA-5-116 FRAMING ELEVATIONS SHEET 9 | |
| WA-5-515 FRAMING ELEVATIONS SHEET 9 | OSB STRUCTURE | |
| WA-5-516 FRAMING ELEVATIONS SHEET 10 | WA-5-102 FOUNDATION PLAN | |
| WA-5-517 TRUSS ELEVATIONS SHEET 1 | WA-5-117 ROOF FRAMING PLANS | |
| WA-5-518 TRUSS ELEVATIONS SHEET 2 | WA-5-118 FRAMING ELEVATIONS SHEET 1 | |
| WA-5-519 FOUNDATION SCHEDULE | WA-5-119 FRAMING ELEVATIONS SHEET 2 | |
| WA-5-520 FOUNDATION SECTIONS AND DETAILS | WA-5-120 FRAMING ELEVATIONS SHEET 3 | |
| WA-5-521 STRUCTURAL STEEL DETAILS | WA-5-121 FRAMING ELEVATIONS SHEET 4 | |
| | WA-5-122 FRAMING ELEVATIONS SHEET 5 | |
| | WA-5-123 FRAMING ELEVATIONS SHEET 6 | |
| | WA-5-124 FRAMING ELEVATIONS SHEET 7 | |
| | MAINTENANCE BUILDING | |
| | WA-5-125 FRAMING PLANS AND ELEVATIONS | |
| | WA-5-126 FOUNDATION & SECTIONS | |

ENLARGED CORNER STATION PLAN
 NTS
 LVEA STRUCTURE - DWG WA-5-501
 OSB STRUCTURE - DWG WA-5-102
 LVEA STRUCTURE - DWG WA-5-104

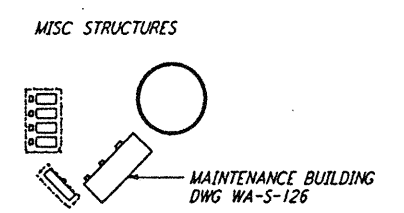

ENLARGED MID STATION "A" PLAN
 NTS
 DWG WA-5-201

ENLARGED END STATION "A" PLAN
 NTS
 DWG WA-5-201

| | | | | | | | | | | | | | | | |
|-------------|-------------|--------------|---------|----------|------|--|---------------------------|--|--|---------------------------------|---------------|-----------------------------|------------------------|---------------------------------|-----------|
| REFERENCES | REVISIONS | DRAWN MCS | CHECKED | ENGINEER | PROJ | 100 WEST WALNUT STREET PASADENA, CALIFORNIA | PARSONS | LIGO CALIFORNIA INSTITUTE OF TECHNOLOGY MASSACHUSETTS INSTITUTE OF TECHNOLOGY | LASER INTERFEROMETER GRAVITATIONAL-WAVE OBSERVATORY SITE NO. 1 - HANFORD, WASHINGTON | TITLE STRUCTURAL KEY PLAN | SCALE NONE | CONTRACT NUMBER PP150969 | PROJECT NUMBER 8094 | SHEET NUMBER WA-S-010 | REVISIONS |
| DRAWING NO. | DESCRIPTION | NO. | DATE | BY | CHKD | ENGR | PROJ | | | | | | | | |
| | | A | 4-19-96 | MCS | DM | PR | FINAL DESIGN REVIEW & BID | | | | | | | | |

L160-D960295-A-0