DATE: 05/22/96 TIME: 10:34:56
DESIGN FILE: I:\ligo\site1\mid\wa242.d3z

NOTES:

1. FOR LEGEND, ABBREVIATIONS AND GENERAL NOTES SEE SHEETS WA-H-001 AND WA-H-002.

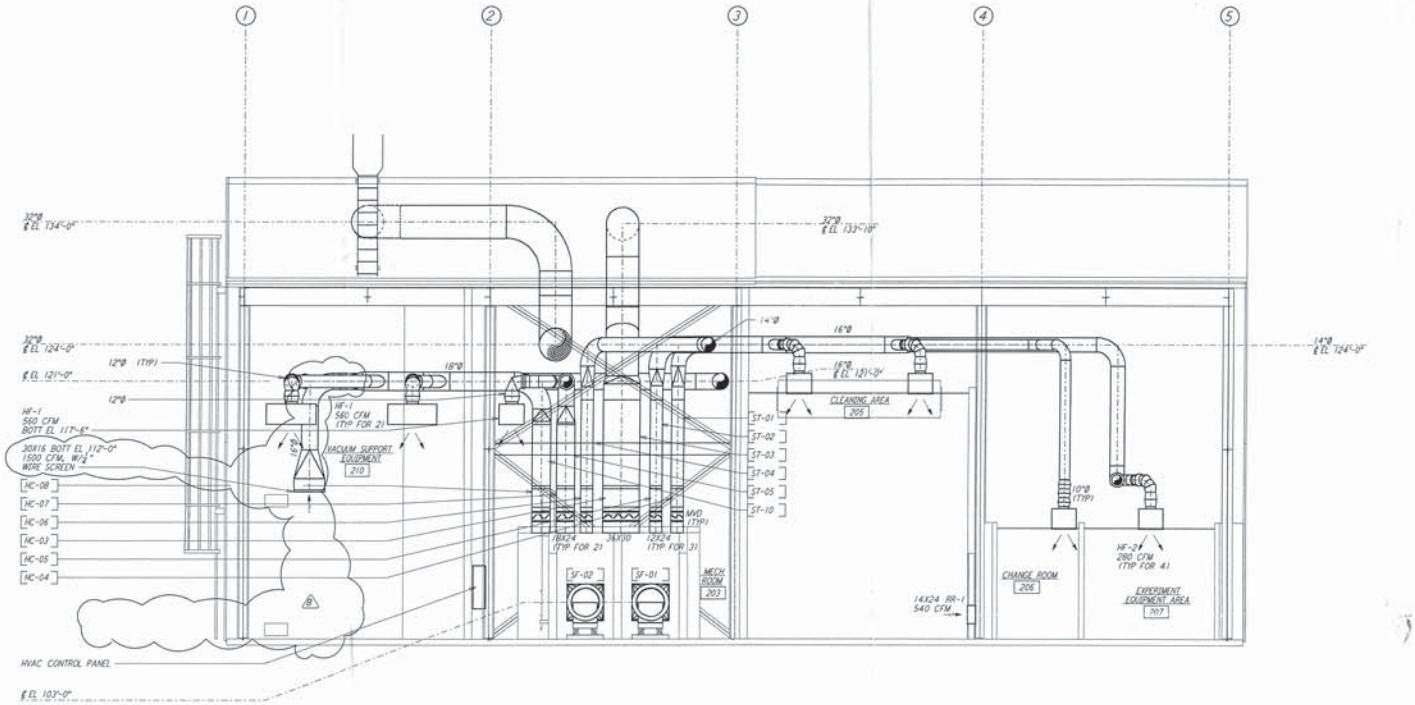


SECTION (B) REF
WA-H-242 WA-H-211
1/4" = 1'-0"

0 4 8 12 16FT
1/4" = 1'-0"

LIGO-D960369-B-O

| REFERENCES | | REVISIONS | | | | | | | |
|---|---|---|---|---|---|---|---|---|---|
| DRAWING NO. | DESCRIPTION | NO. | DATE | BY | CHKD | ENGR | PROJ | DESCRIPTION |
| | | B | 5-22-96 | CLP | [illegible] | AA | [illegible] | BID ADDENDUM #2 |
| | | A | 4-19-96 | CLP | ME | AA | TDM | FINAL DESIGN REVIEW & BID |

| | |
|---|---|
| DRAWN | CLP |
| CHECKED | |
| ENGINEER | |
| PROJ | |

PARSONS
100 WEST WALNUT STREET
PASADENA, CALIFORNIA

LIGO
CALIFORNIA INSTITUTE OF TECHNOLOGY
MASSACHUSETTS INSTITUTE OF TECHNOLOGY

LASER INTERFEROMETER
GRAVITATIONAL-WAVE OBSERVATORY
SITE NO. 1 - HANFORD, WASHINGTON

TITLE
HVAC
MID & END STATIONS
SECTIONS SHEET 2

| SCALE | CONTRACT NUMBER | PROJECT NUMBER |
|---|---|---|
| AS NOTED | PP150969 | 8094 |

SHEET NUMBER: WA-H-242 REVISIONS: A

L100WNF3.BDR

This document and the design it covers are the property of PARSONS. They are loaned only with the borrower's expressed written agreement that they will not be reproduced, copied, loaned, exhibited, or used in any other way, except by written consent from PARSONS to the borrower.