DATE: 09/03/98 TIME: 20:20:12
DESIGN FILE: I:\ligo\site\ee\wae105.d3z

not be reproduced, copied, loaned, exhibited, or used in any other way, except by written consent from PARSONS to the borrower.

This document and the design it covers are the property of PARSONS. They are loaned only with the borrower's expressed written agreement that they will

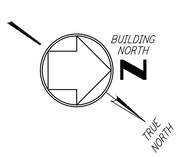

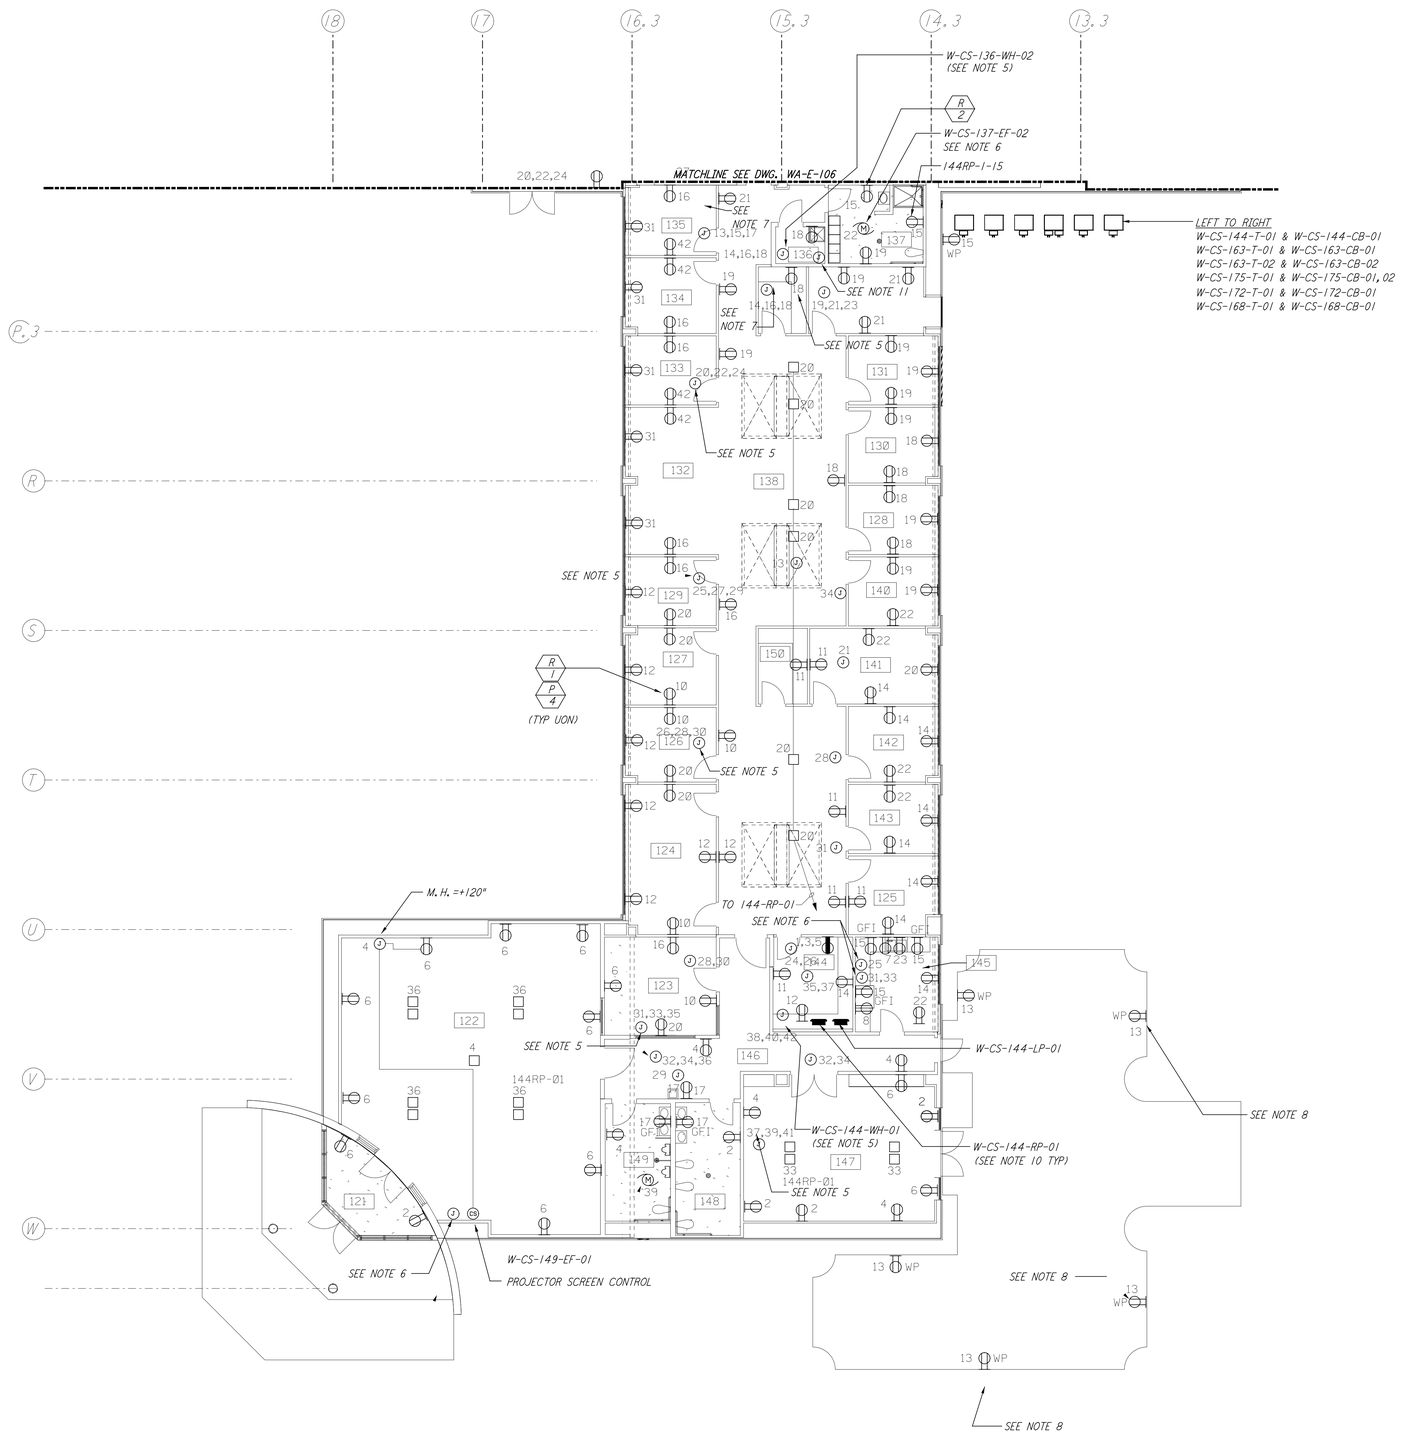

NOTES:

1. FOR ABBREVATIONS AND ACROMYMS SEE DWG WA-E-001.
2. FOR SYMBOLS SEE DWG WA-E-002.
3. FOR GENERAL NOTES, SEE DWG. WA-E-101.
4. ALL CIRCUITS SHOWN ON THIS DRAWING ARE FROM PANEL W-CS-144-RP-01 UNLESS OTHERWISE NOTED.
5. CIRCUITS SHOWN FEEDING THESE ITEMS ARE FROM PANEL W-CS-144-LP-01.
6. CIRCUITS SHOWN FEEDING THIS ITEM IS FROM PANEL W-CS-163-RP-01.
7. CIRCUITS SHOWN FEEDING THESE ITEMS ARE FROM PANEL W-CS-163-LP-01
8. CONDUIT AND WIRE FEEDING RECEPTACLES LOCATED ON PATIO WALLS SHALL ROUTE WITHIN PATIO BLOCK WALLS TO EXTERIOR WALLS OF THE OSB AS REQUIRED.
9. CONDUIT AND WIRE SHALL ROUTE WITHIN FLOOR SLAB TO WALL AS INDICATED.
10. FOR ALL PANEL FEEDER CONDUIT AND WIRE SIZES SEE SINGLE LINE DIAGRAM DWG WA-E-006.
11. HEAT TRACE 163-RP-01 #40.

REFERENCE DRAWINGS:

WA-E-115 LIGHTING AND POWER PANEL SCHEDULES
WA-E-116 LIGHTING AND POWER PANEL SCHEDULES

LEGEND:

RECEPTACLE, 208V, 3Ø, 5W, 4 POLE GROUNDING
NEMA L21-30R HUBBELL #2810 WITH BOX AND COVER

0 8 16 24 32FT
1/8" = 1'-0"

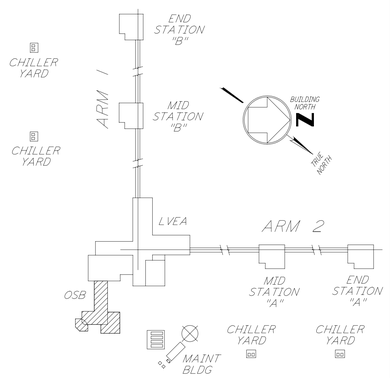

KEY PLAN

LIGO-D960394-02-O

REFERENCES		REVISIONS							
DRAWING NO.	DESCRIPTION	NO.	DATE	BY	CHKD	ENGR	PROJ	DESCRIPTION
		2	6-15-98	J. G.				ISSUED FOR AS-BUILT
		1	3-21-97	J. G.	K. R.	K. R.	TDM	GENERAL REVISIONS

ISSUED FOR CONSTRUCTION		
DRAWN	M. M.	6-25-96
CHECKED	J. K.	7-3-96
ENGINEER	K. R.	7-3-96
PROJ	M. D. W.	7-8-96

AS-BUILT DRAWINGS

PARSONS
100 WEST WALNUT STREET
PASADENA, CALIFORNIA

LIGO
CALIFORNIA INSTITUTE OF TECHNOLOGY
MASSACHUSETTS INSTITUTE OF TECHNOLOGY

LASER INTERFEROMETER GRAVITATIONAL-WAVE OBSERVATORY
SITE NO. 1 - HANFORD, WASHINGTON

TITLE: ELECTRICAL CORNER STATION OSB OFFICE AREA RECEPTACLE & POWER PLAN

SCALE	CONTRACT NUMBER	PROJECT NUMBER
AS NOTED	PP150969	8094

SHEET NUMBER: WA-E-105
REVISIONS: 2

LIGOWAF3.BDR