This document and the design it covers are the property of PARSONS. They are loaned only with the borrower's expressed written agreement that they will not be reproduced, copied, loaned, exhibited, or used in any other way, except by written consent from PARSONS to the borrower.

DATE: 05/20/96 TIME: 18:01:56
DESIGN FILE: I:\ligo\site\cad\wae109.dgz

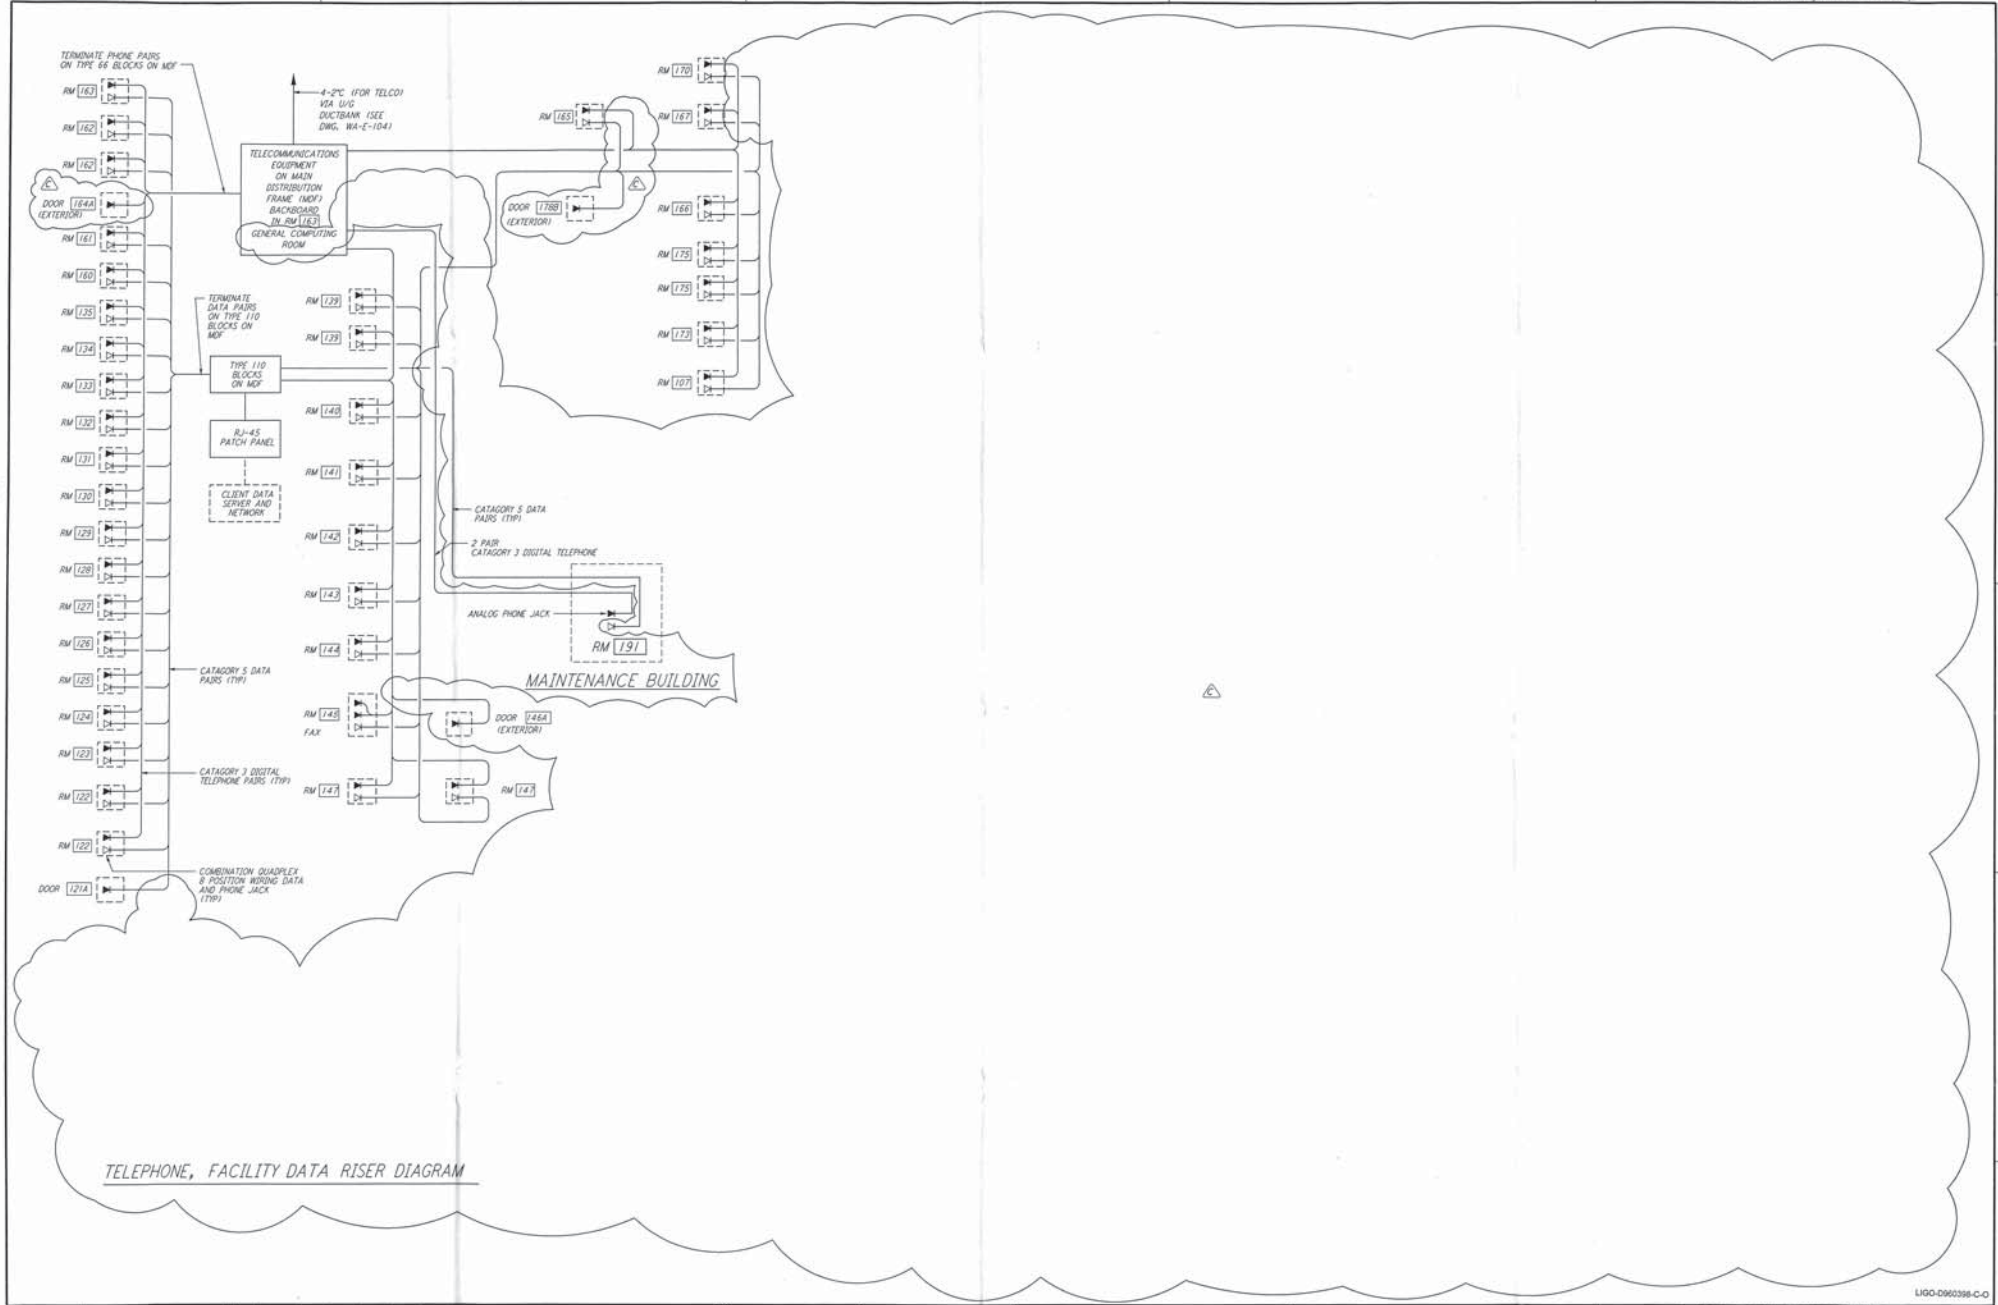

TELEPHONE, FACILITY DATA RISER DIAGRAM

LIGO-D960398-C-O

REFERENCES			REVISIONS							
DRAWING NO.	DESCRIPTION		NO.	DATE	BY	CHKD	ENGR	PROJ	DESCRIPTION
			C	5-22-96	RAC	[illegible]	[illegible]	TDM	BID ADDENDUM #2
			B	4-19-96				TDM	FINAL DESIGN REVIEW & BID
			A	10-31-95				TDM	PRELIMINARY DESIGN REVIEW

DRAWN	J. G.
CHECKED	
ENGINEER	
PROJ	

PARSONS
100 WEST WALNUT STREET
PASADENA, CALIFORNIA

LIGO
CALIFORNIA INSTITUTE OF TECHNOLOGY
MASSACHUSETTS INSTITUTE OF TECHNOLOGY

LASER INTERFEROMETER GRAVITATIONAL-WAVE OBSERVATORY
SITE NO. 1 - HANFORD, WASHINGTON

TITLE: ELECTRICAL CORNER STATION COMMUNICATIONS RISER DIAGRAM

SCALE	CONTRACT NUMBER	PROJECT NUMBER
NONE	PP150969	8094

SHEET NUMBER: WA-E-109
REVISION: C

LIGOWAF.BDR