
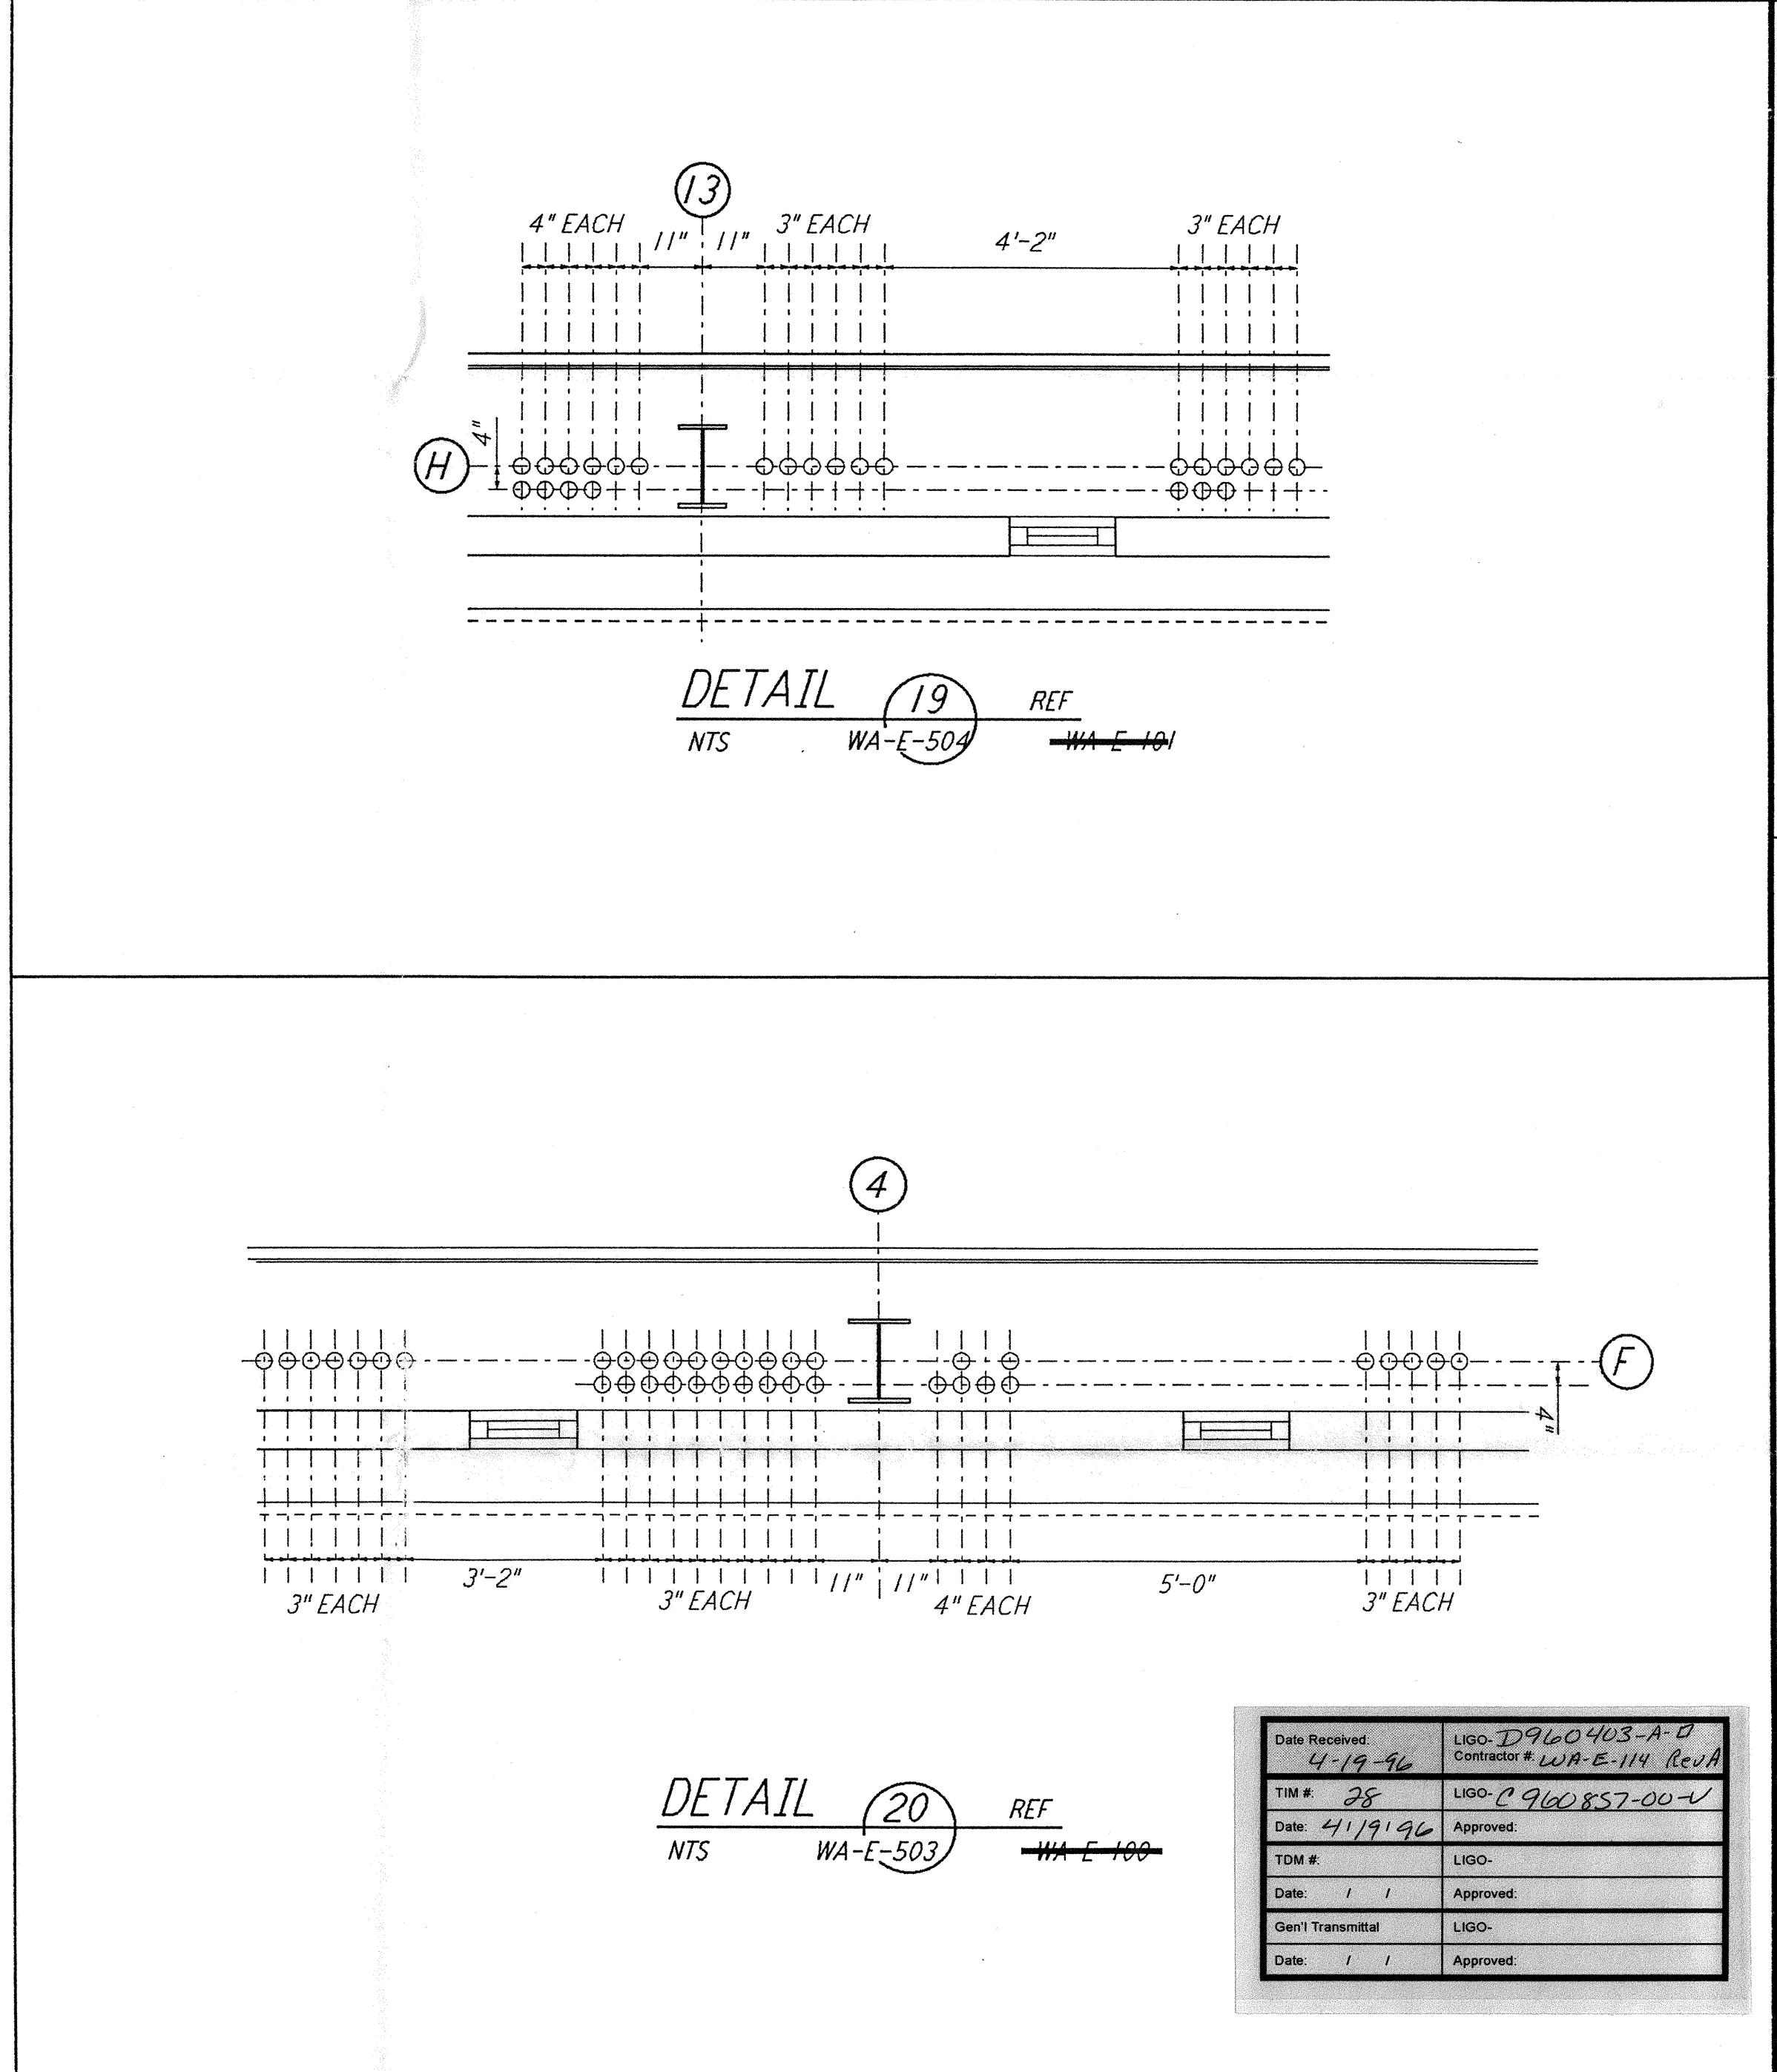
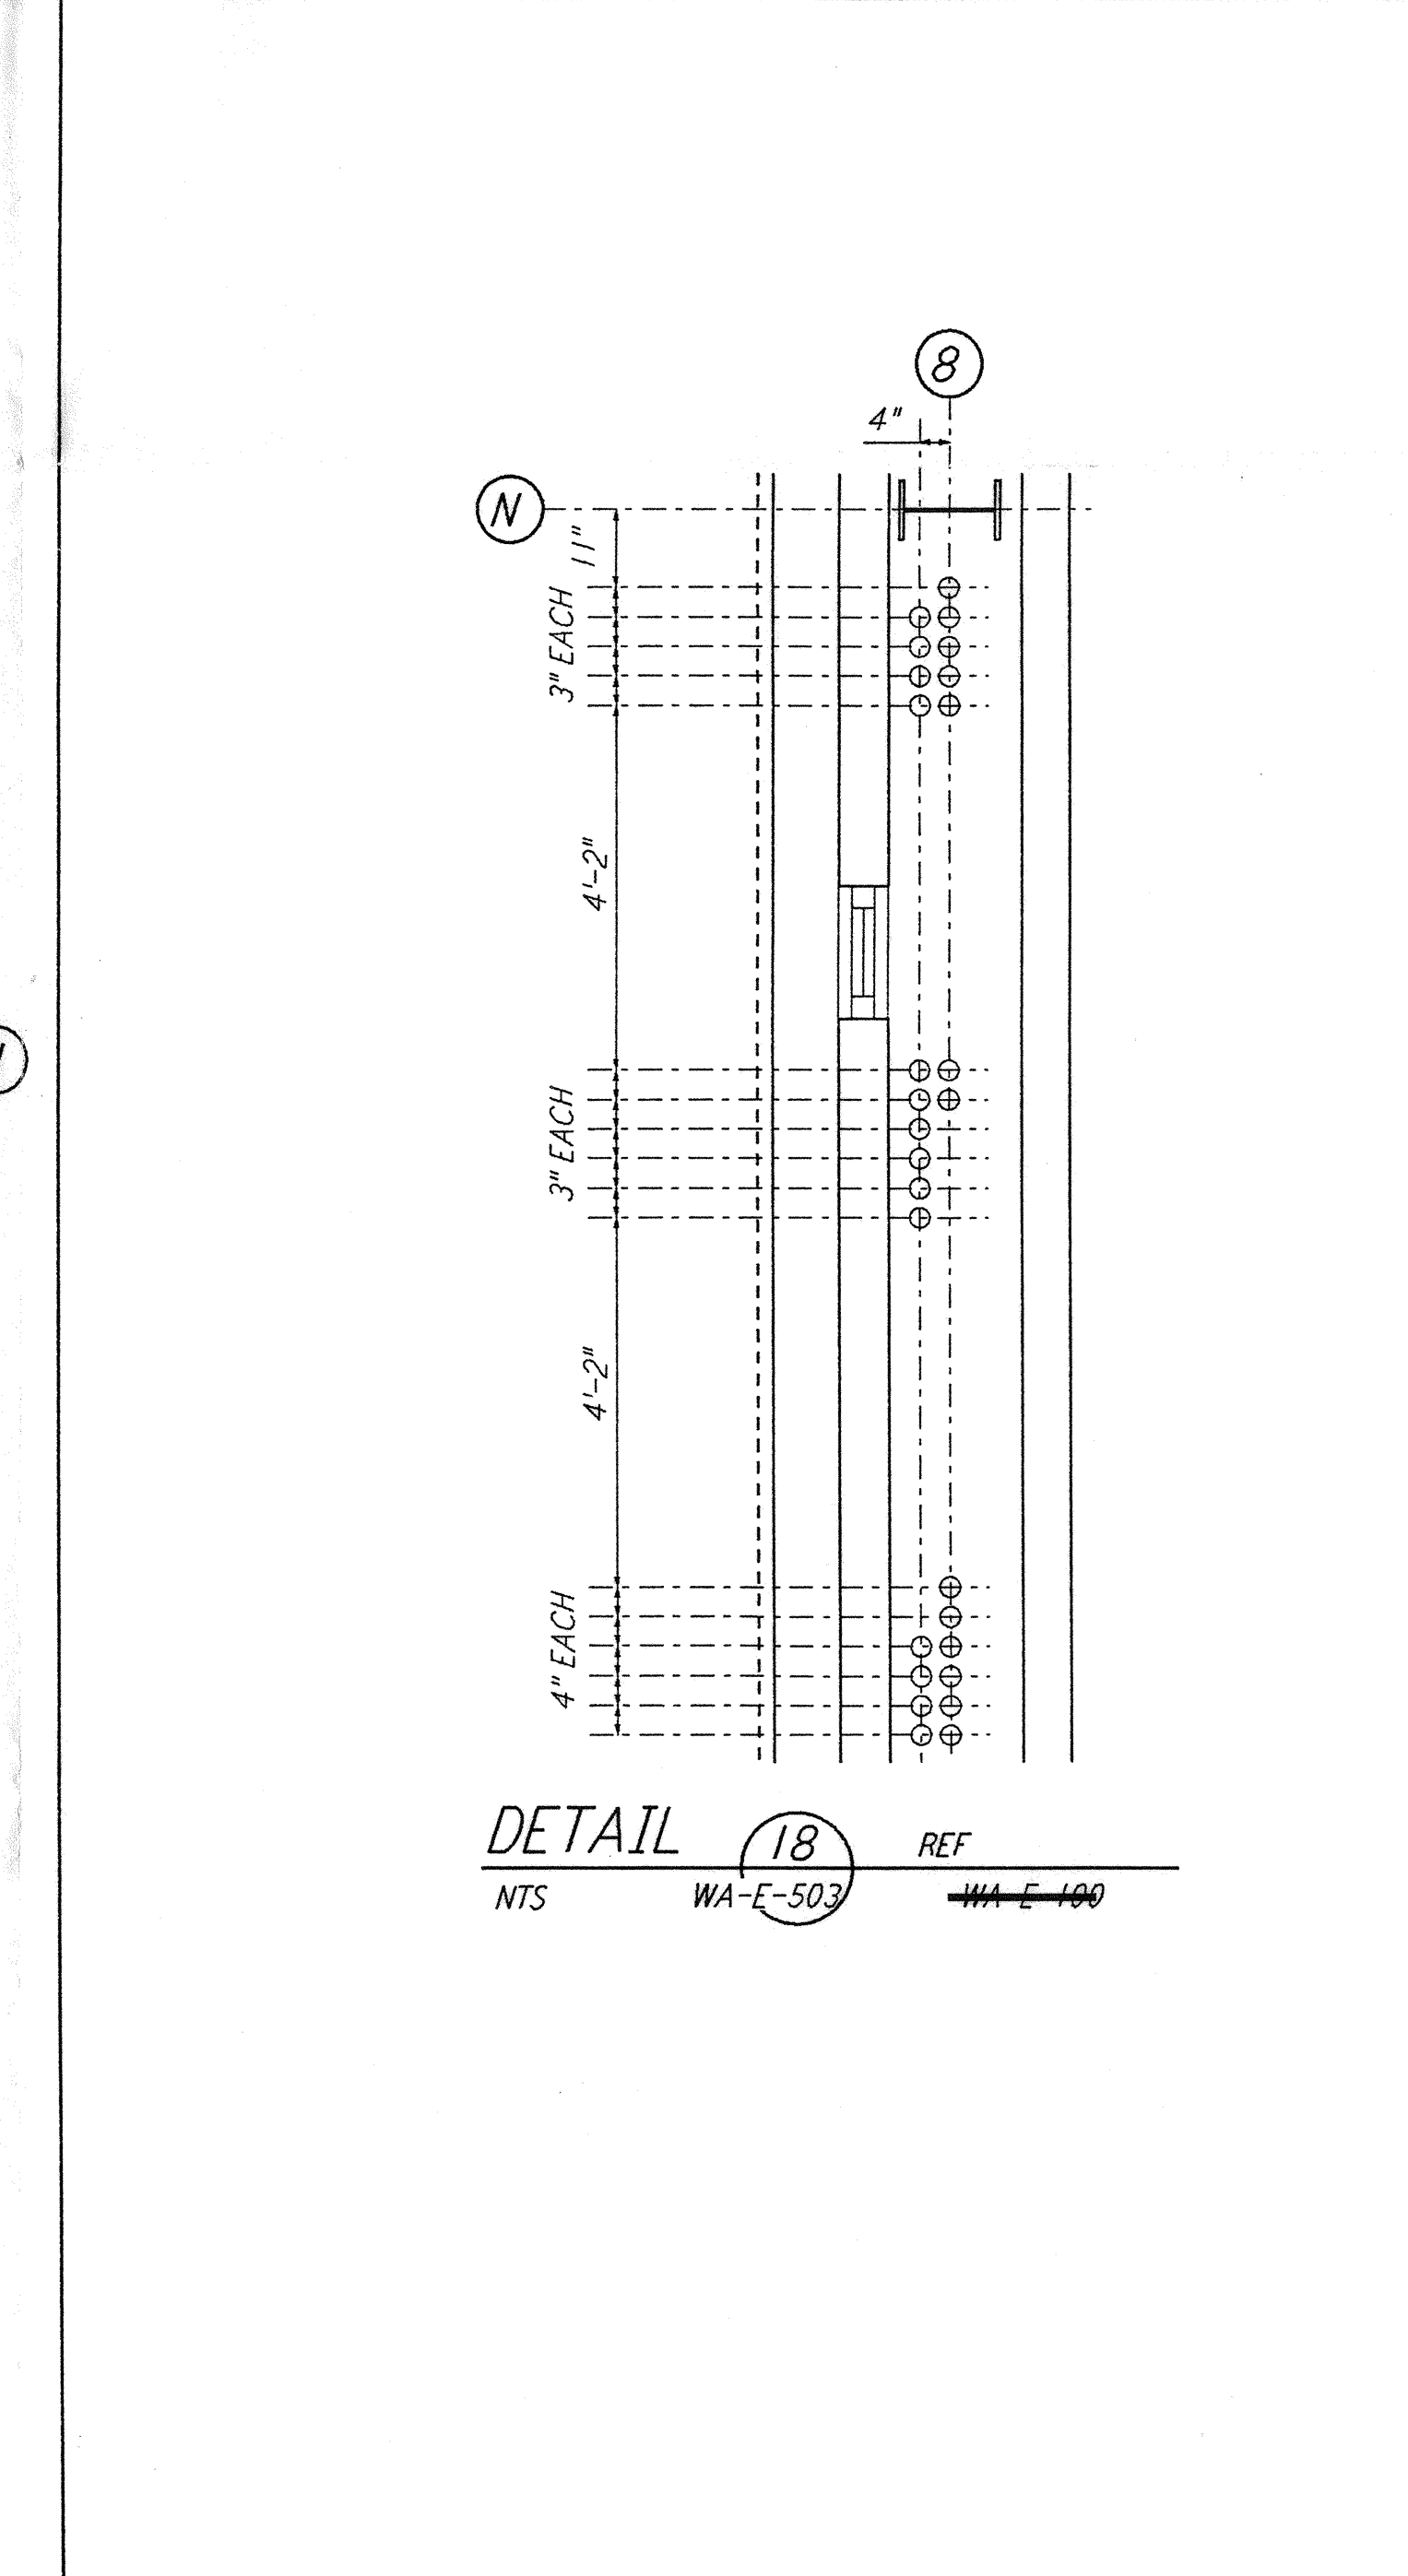
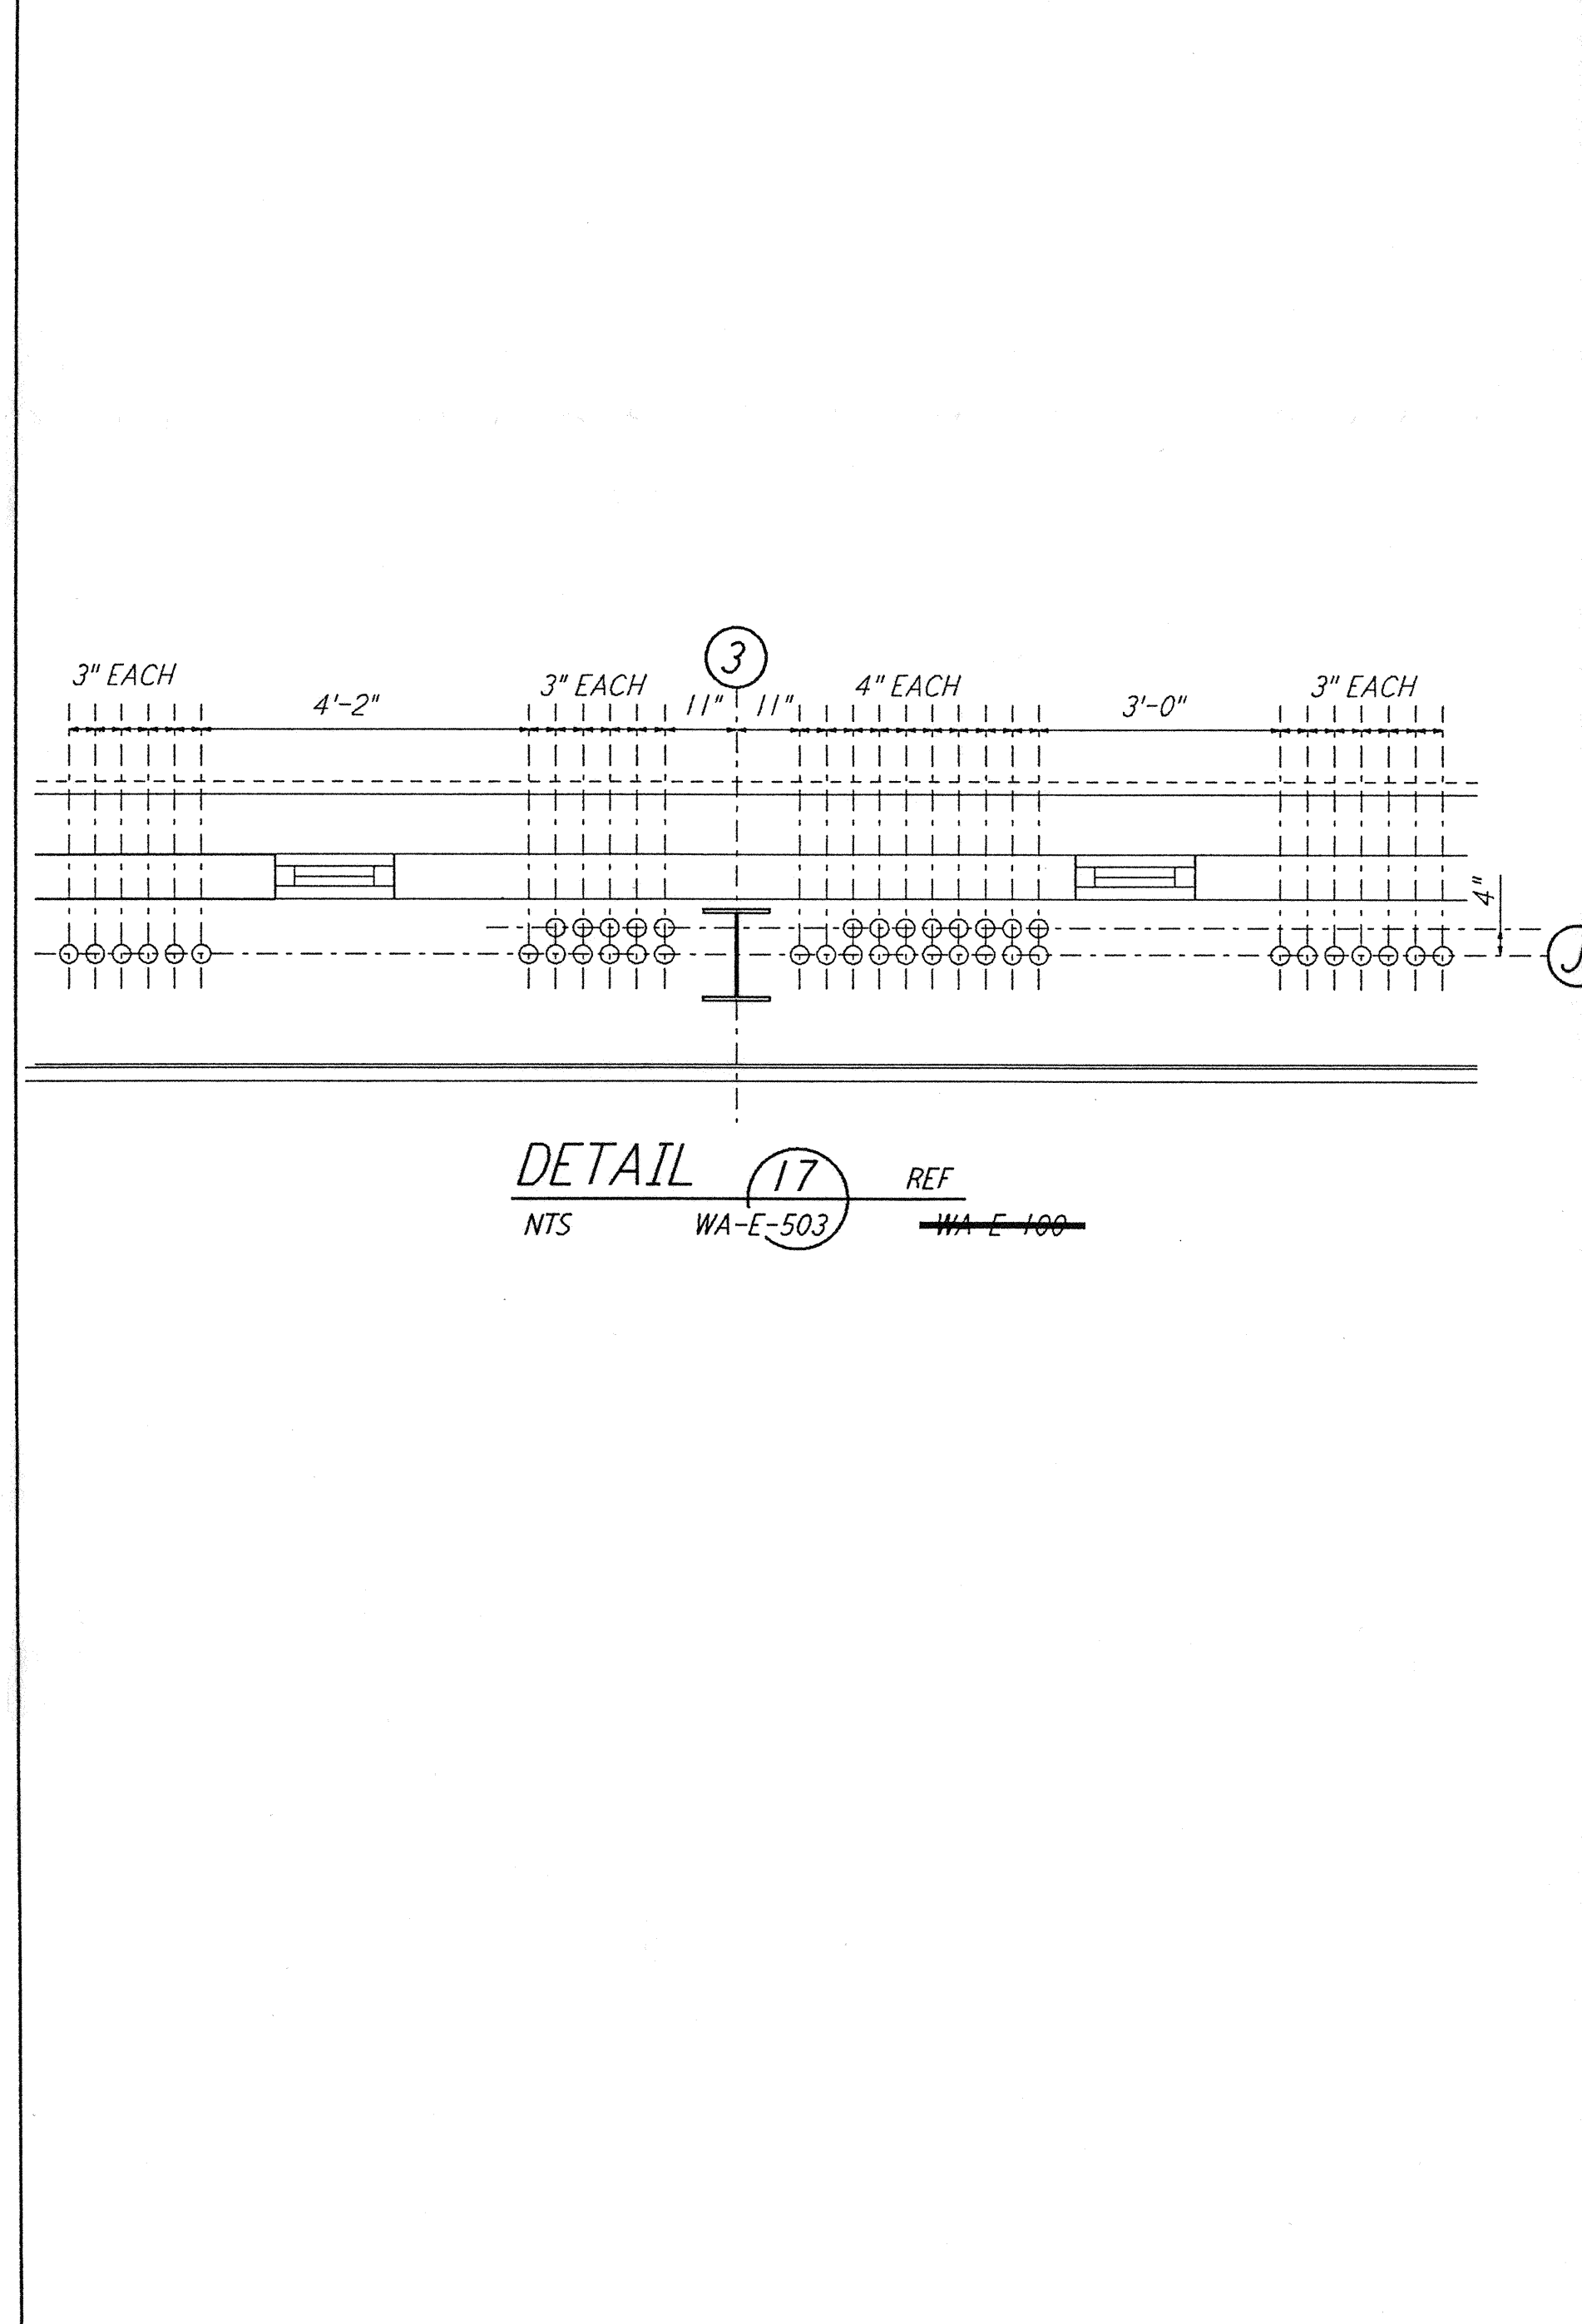
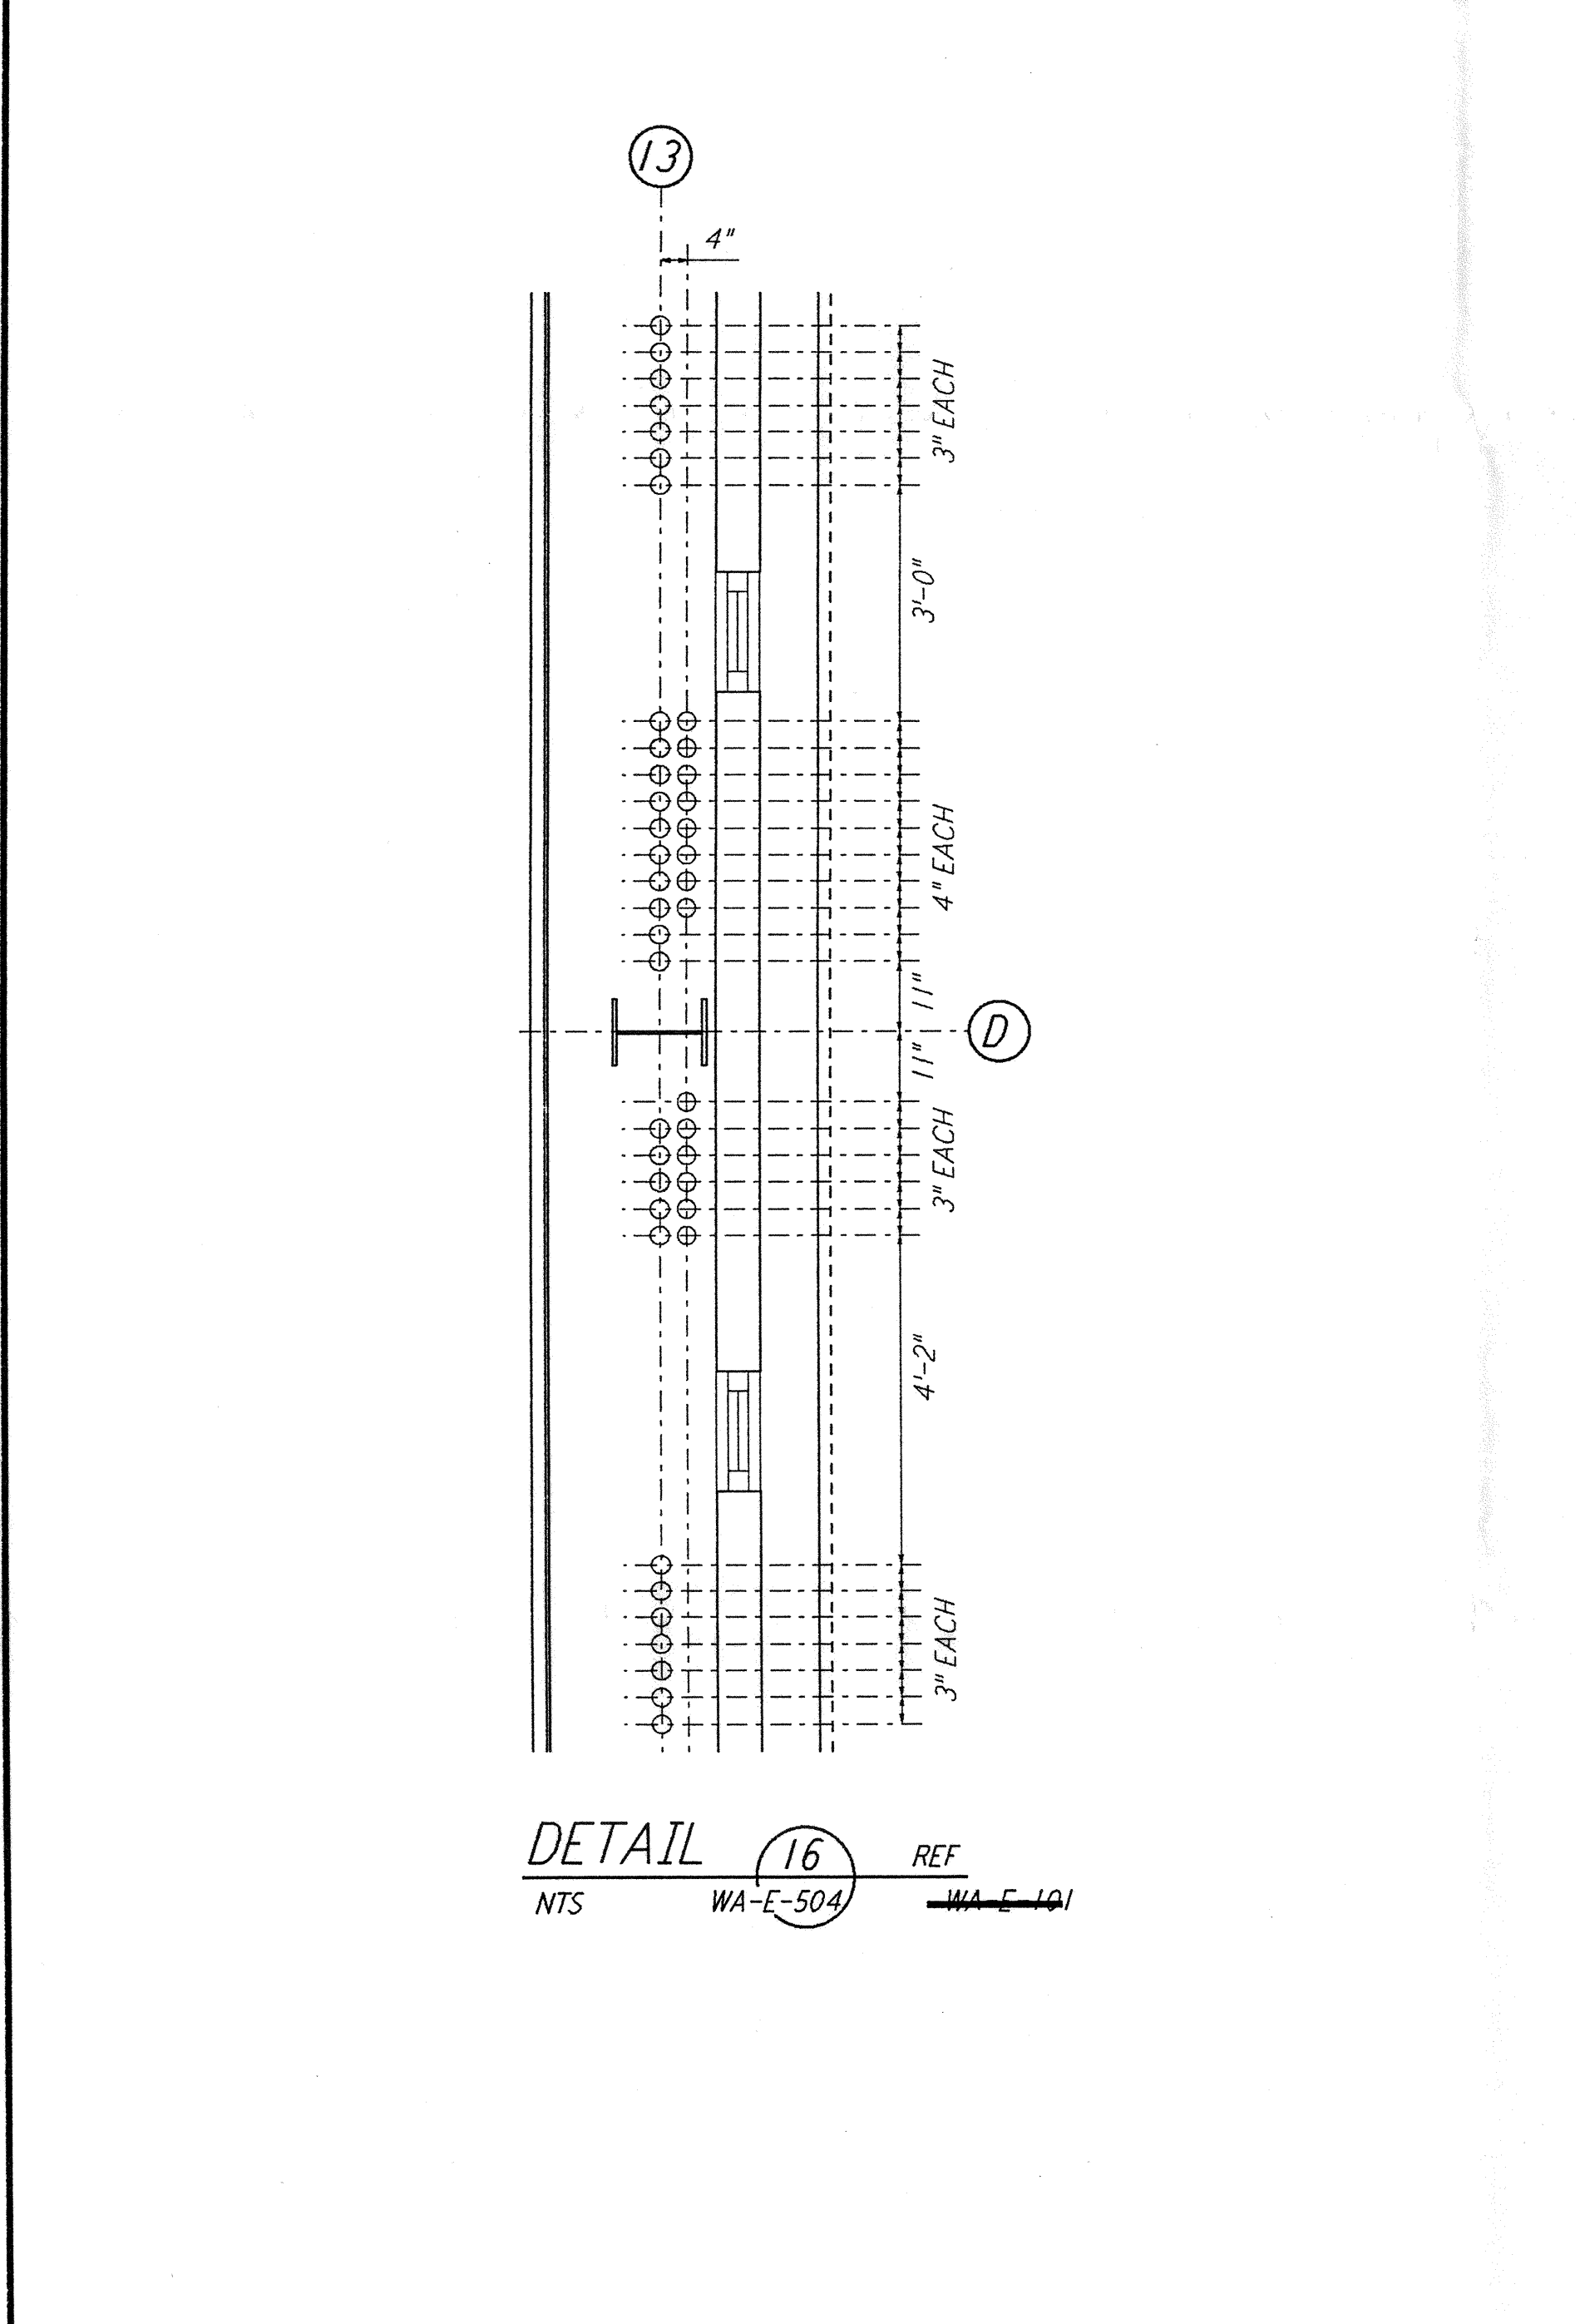
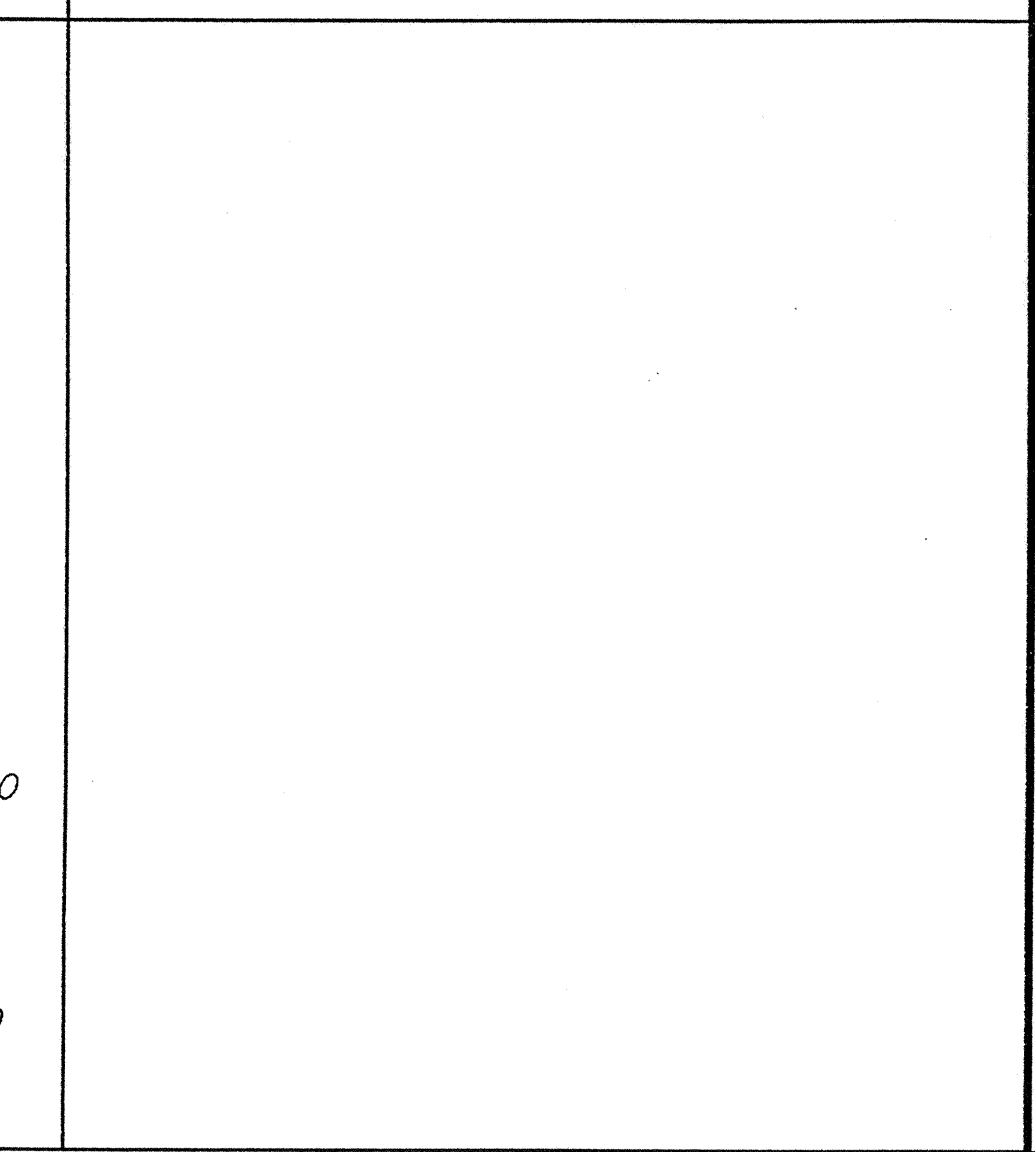
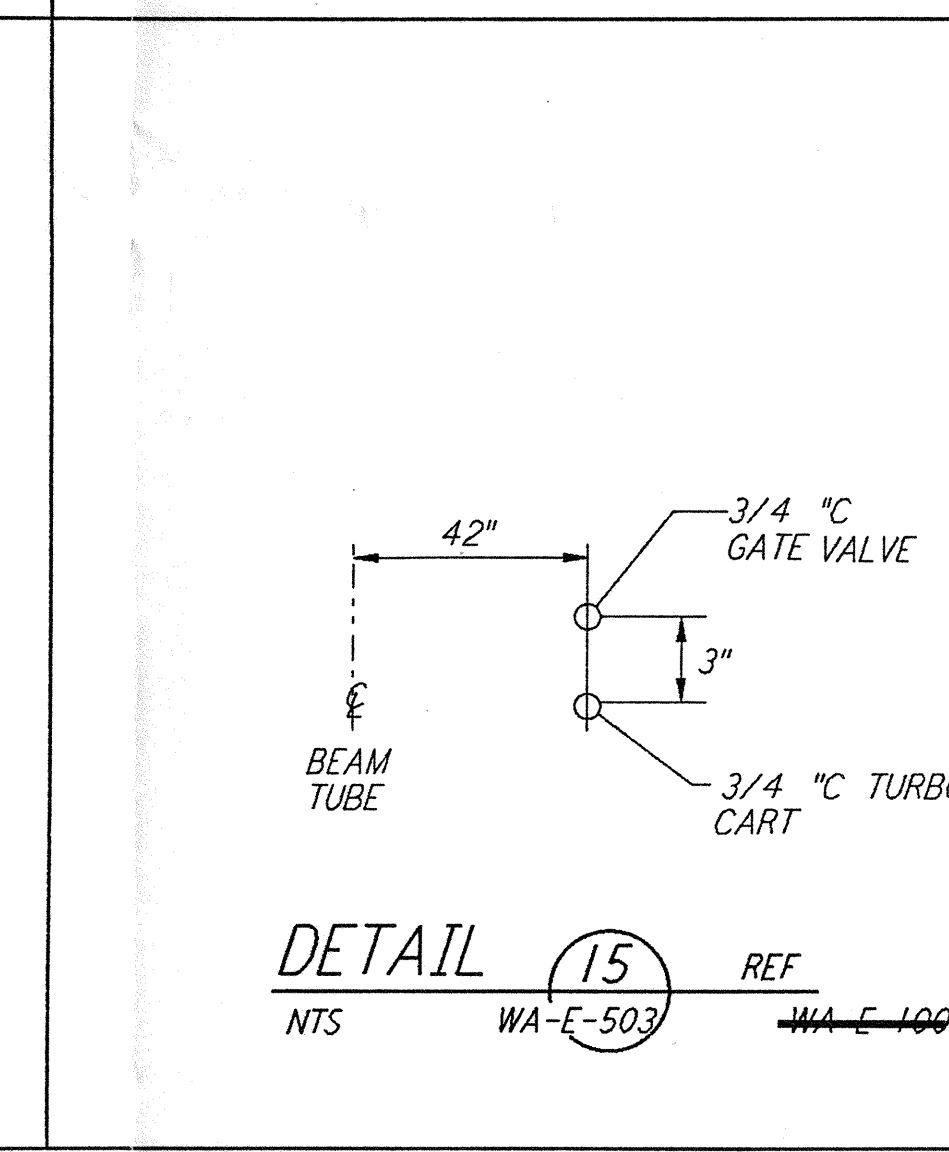
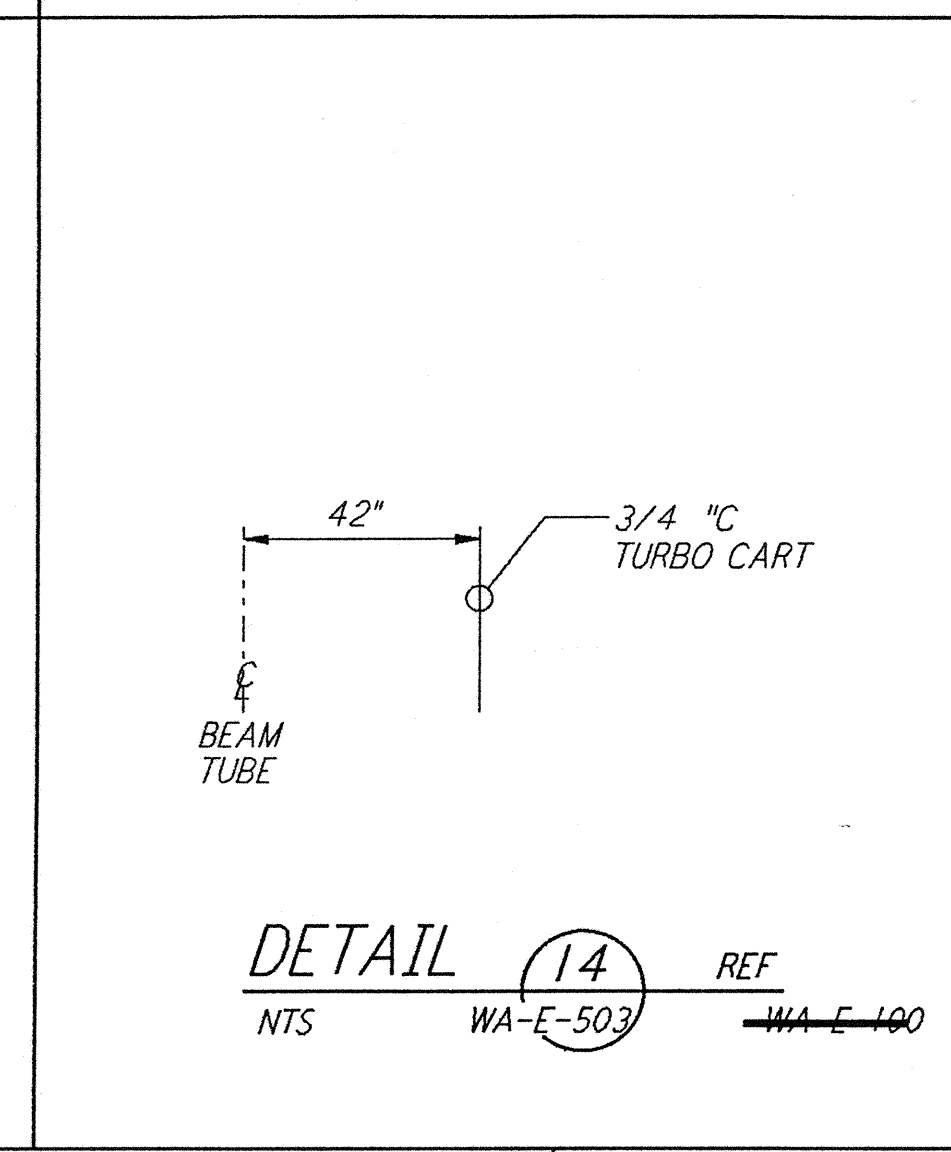
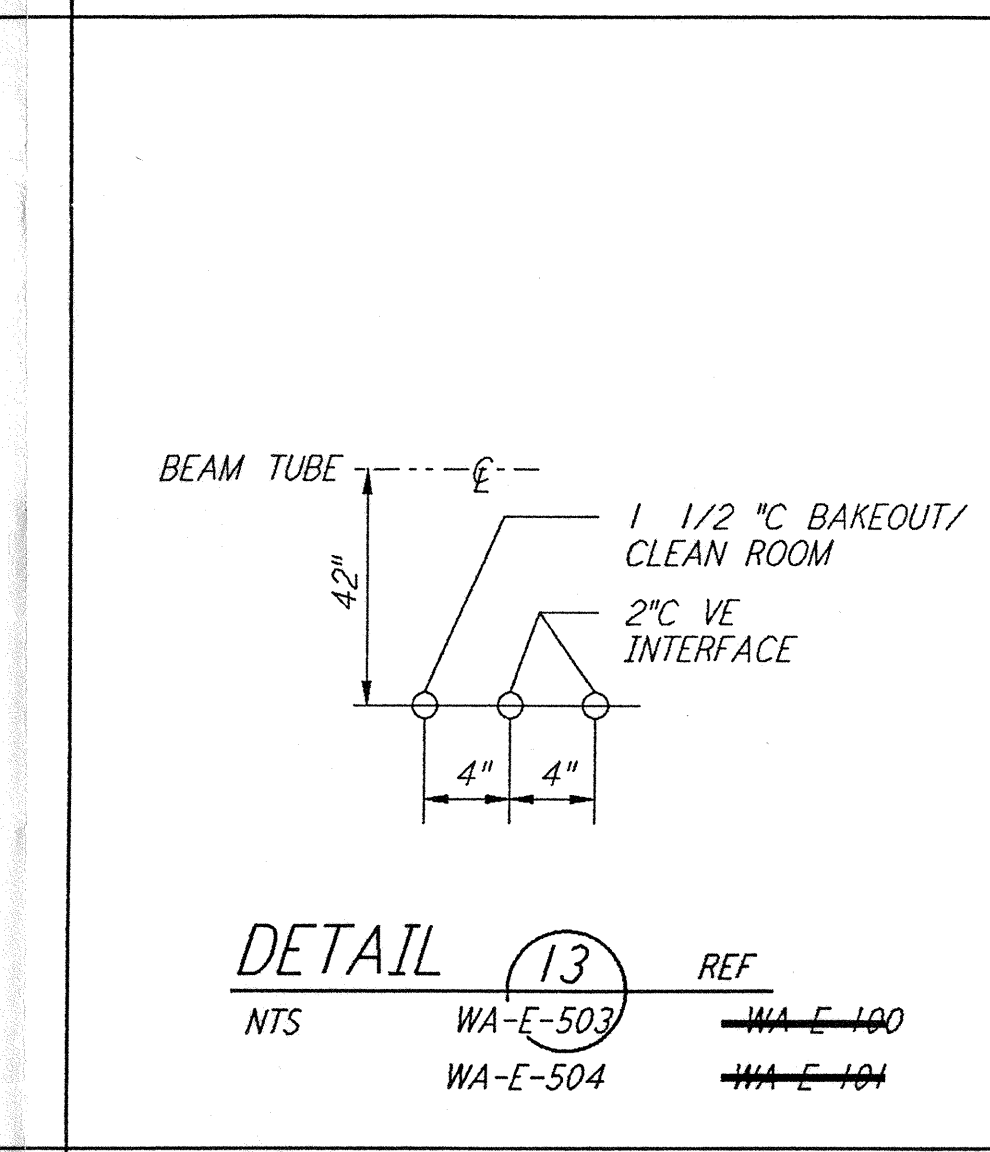
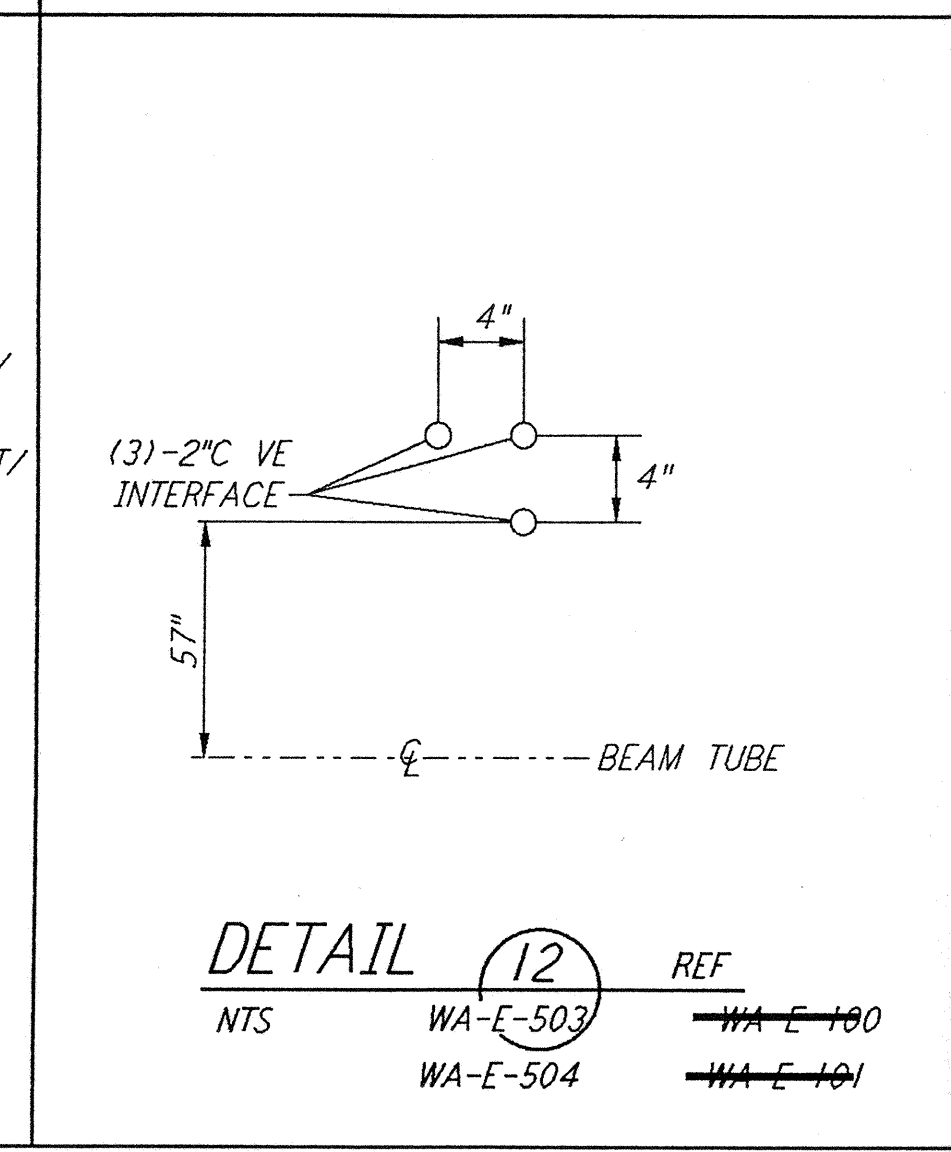
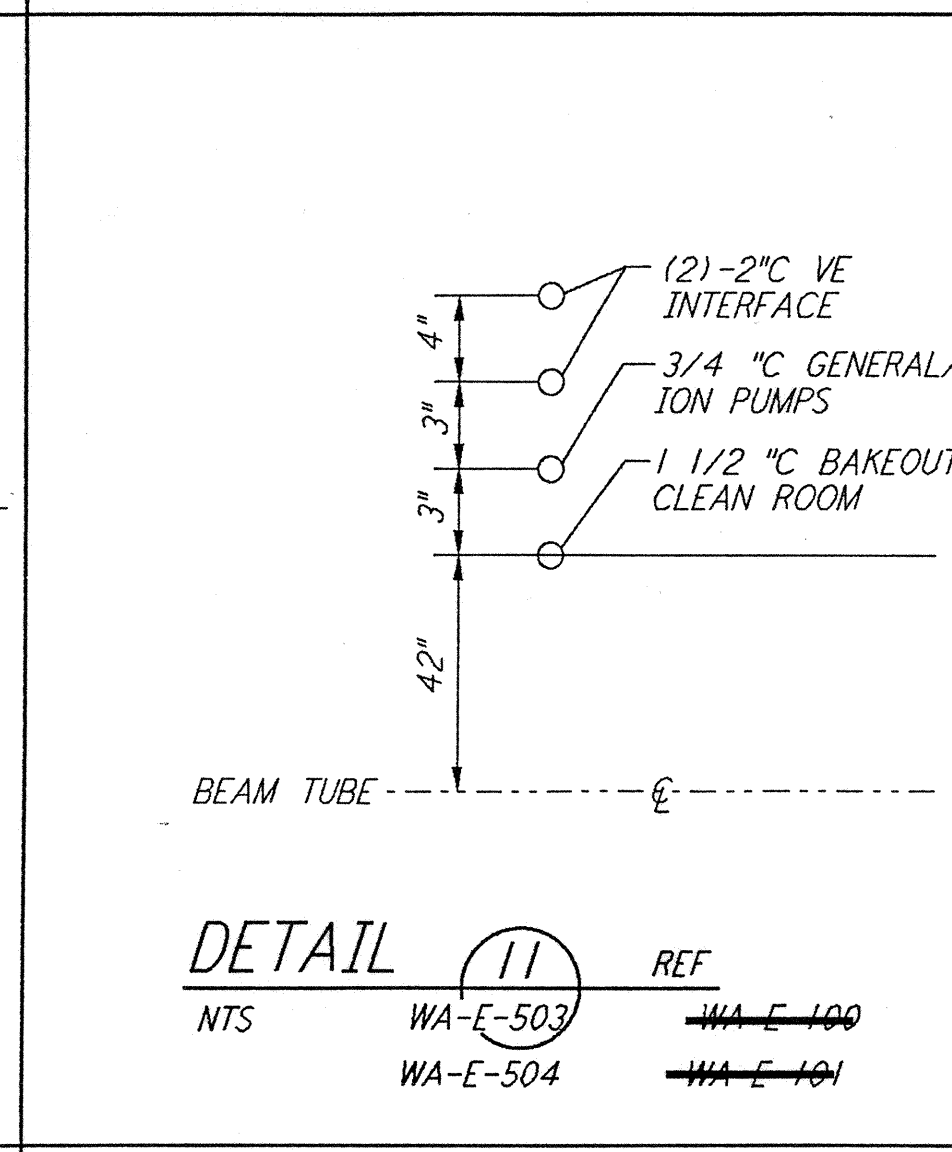
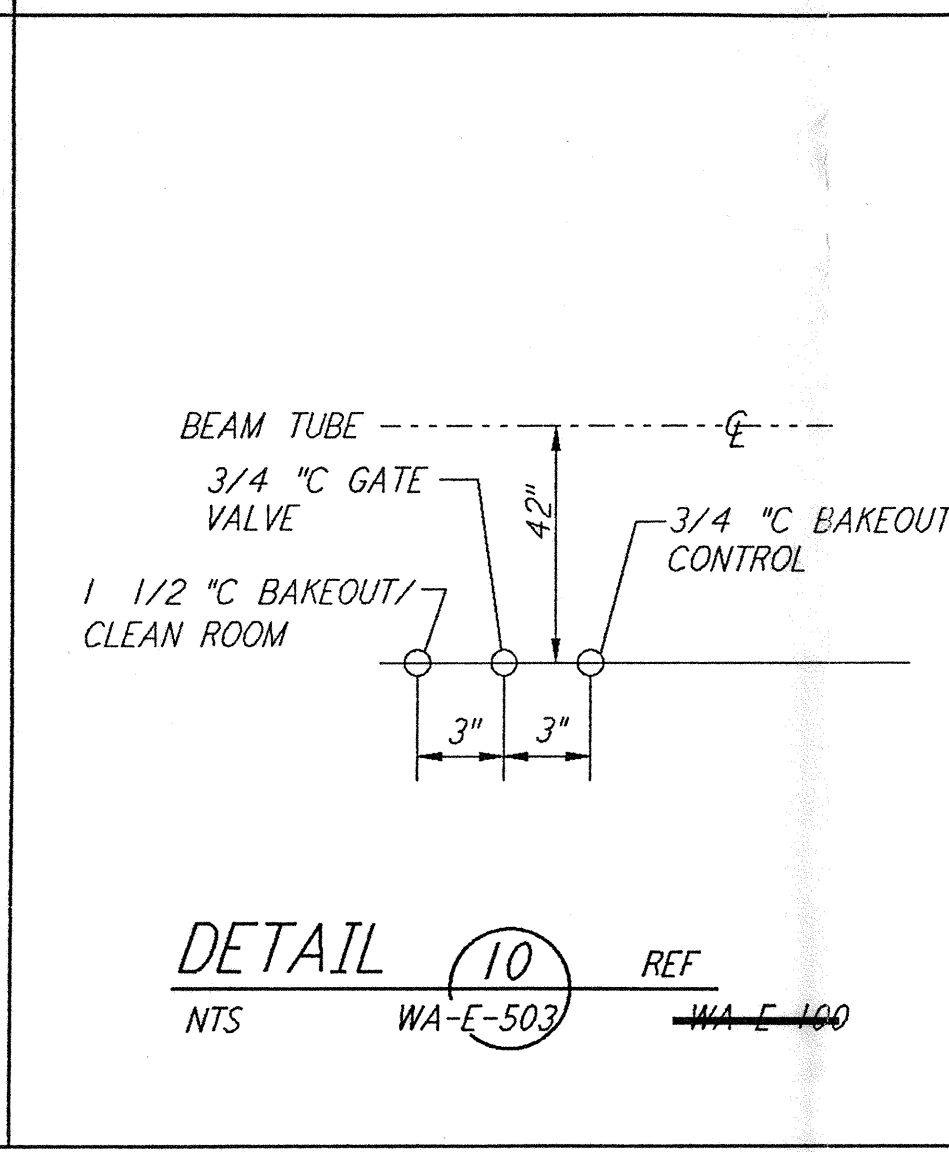
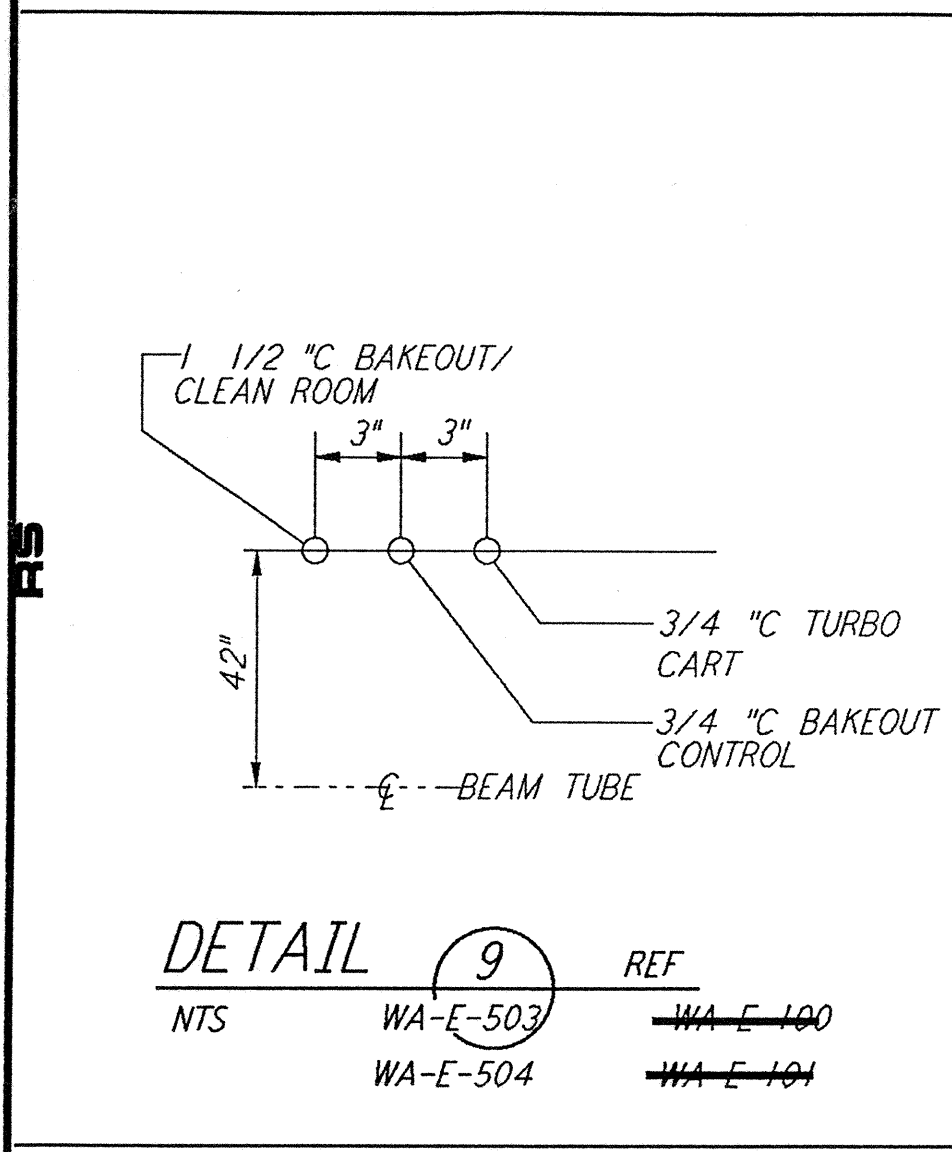
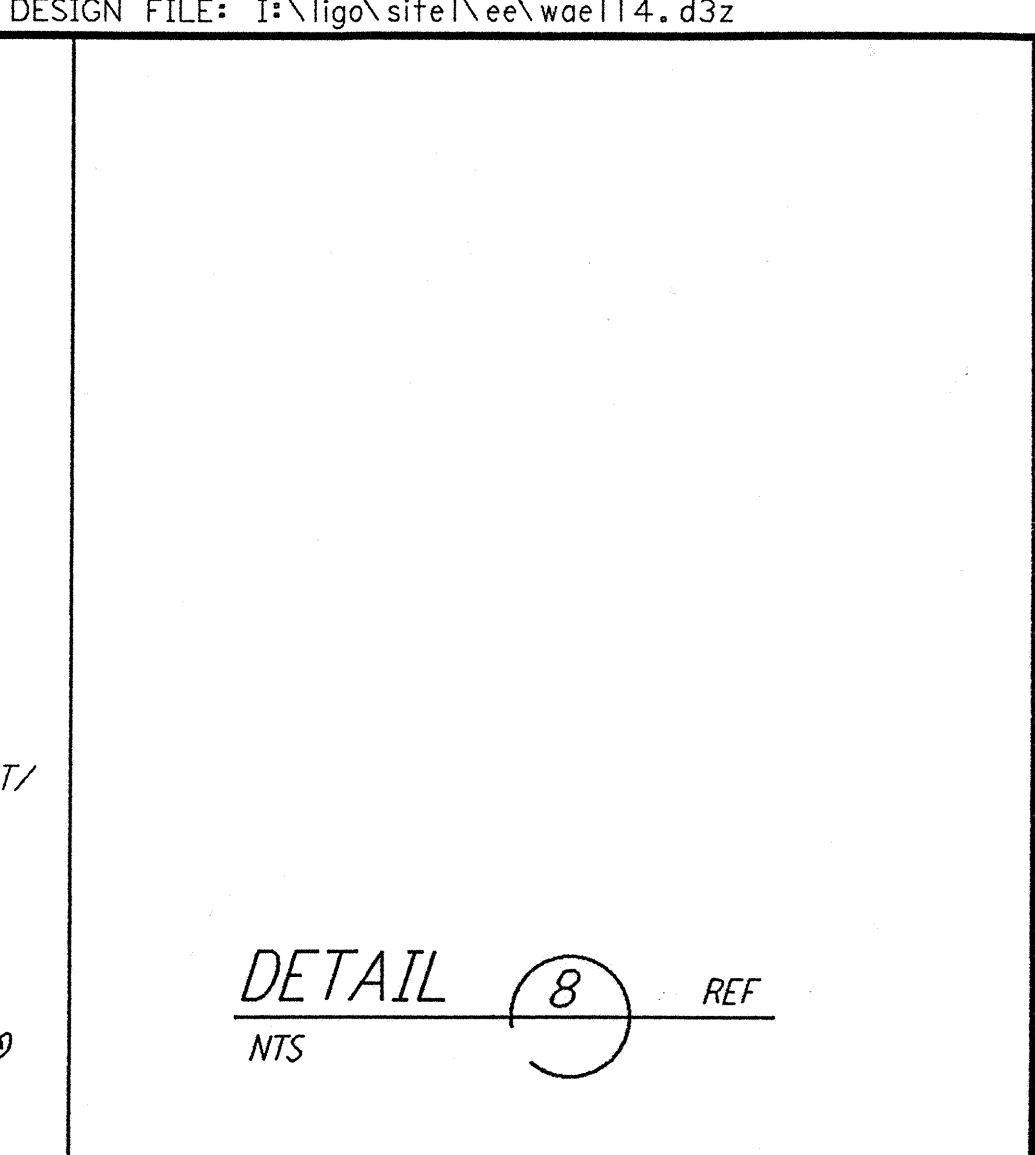
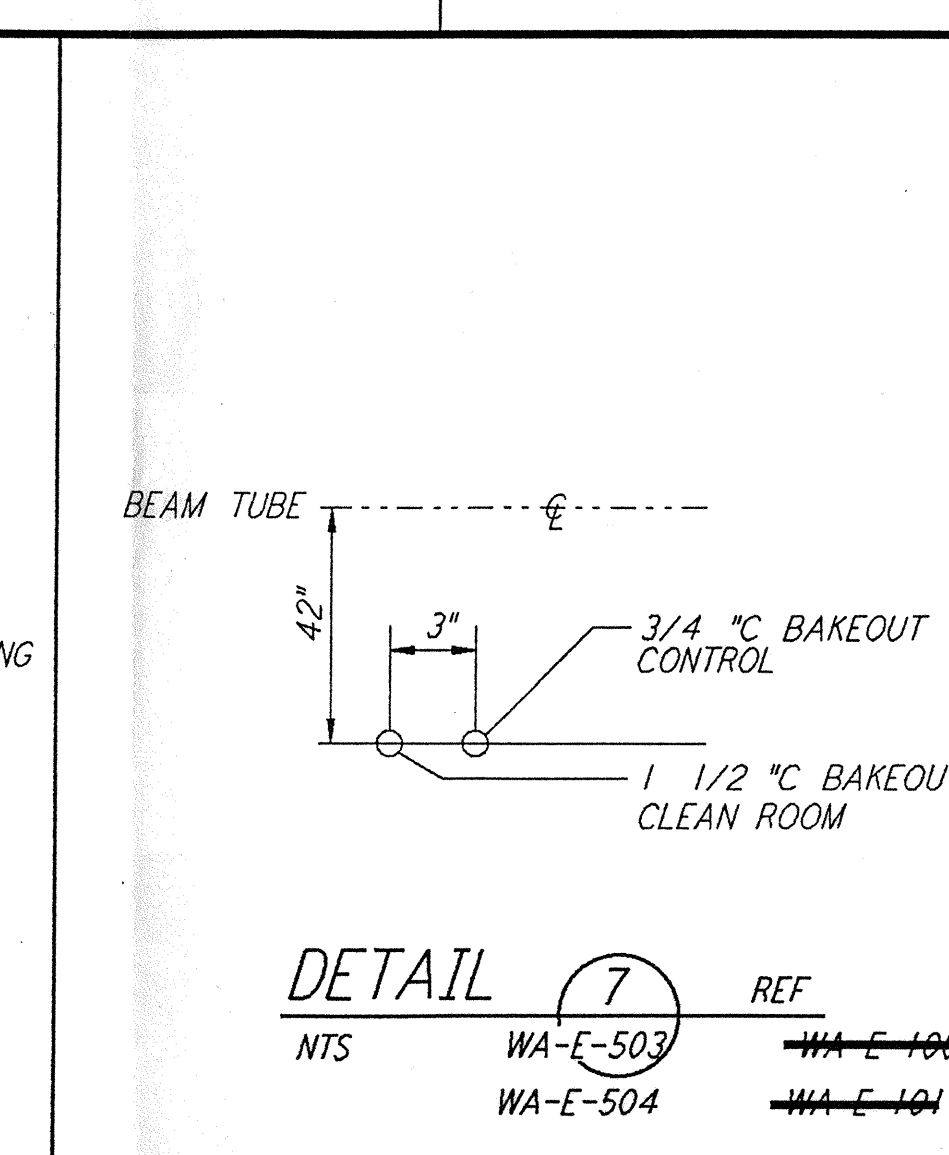
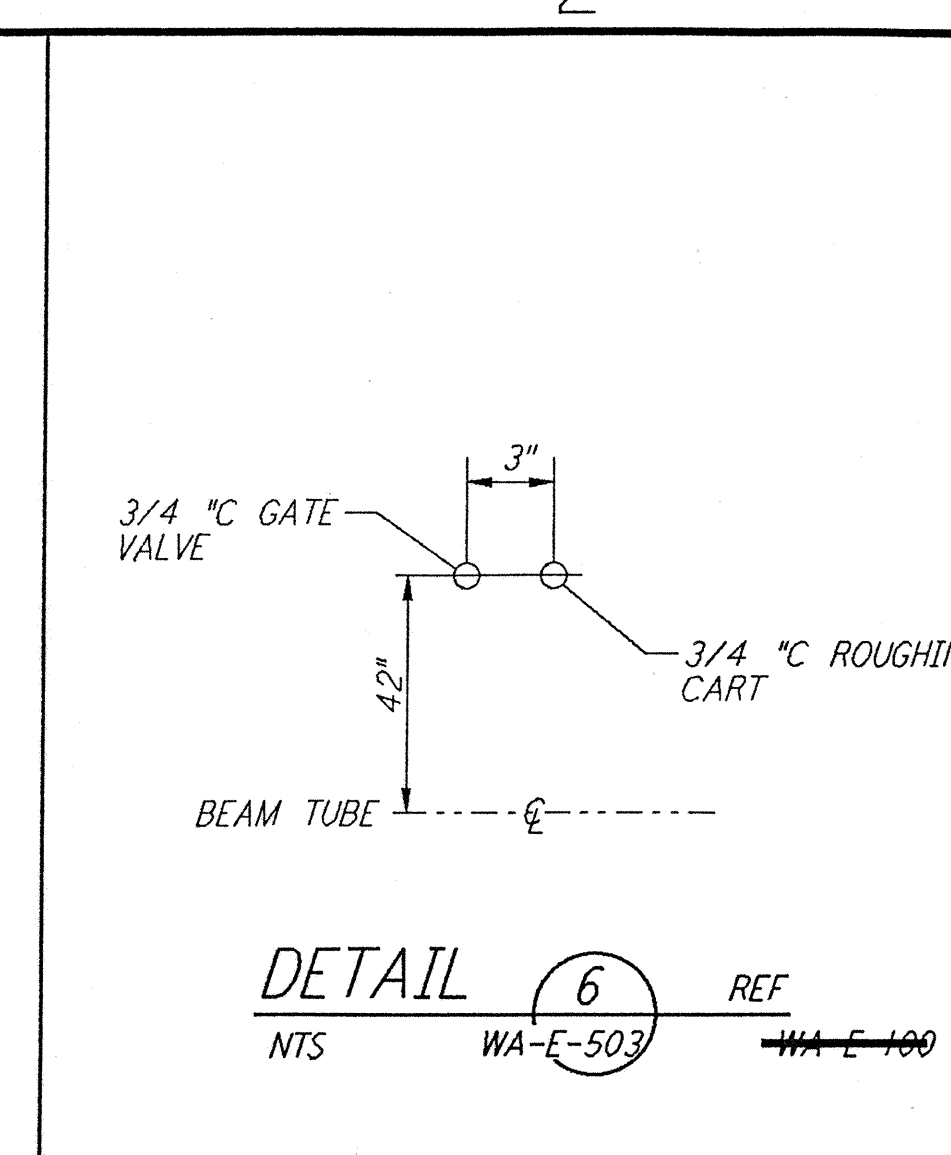
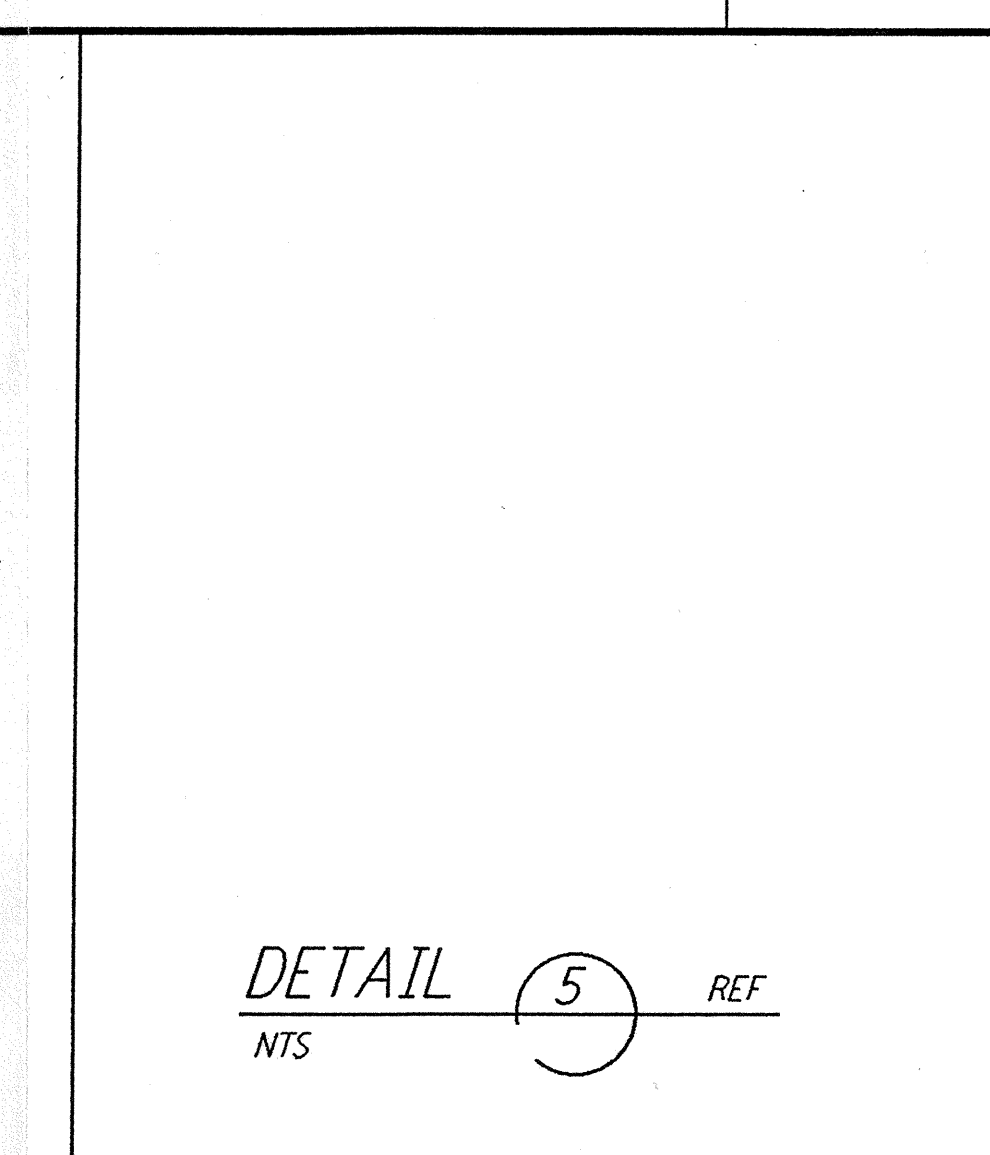
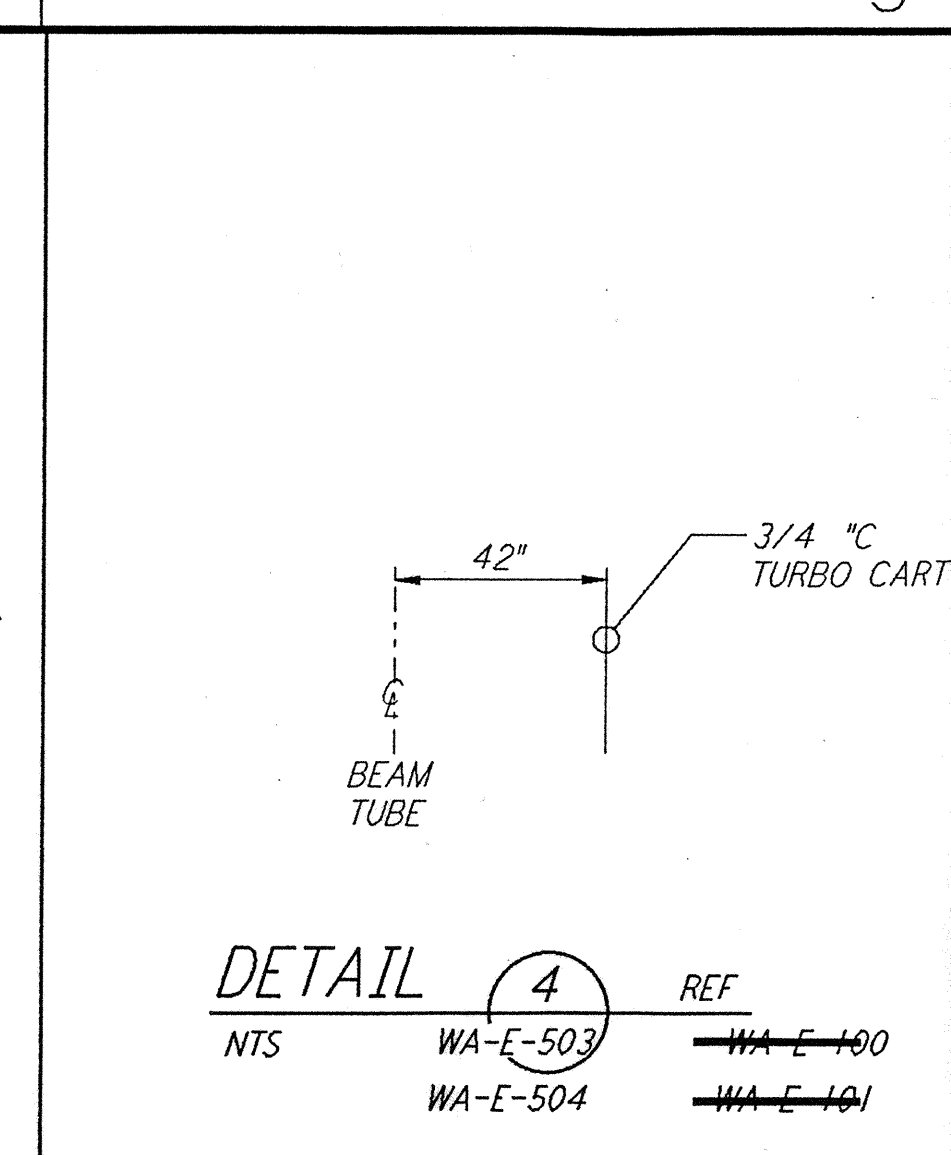
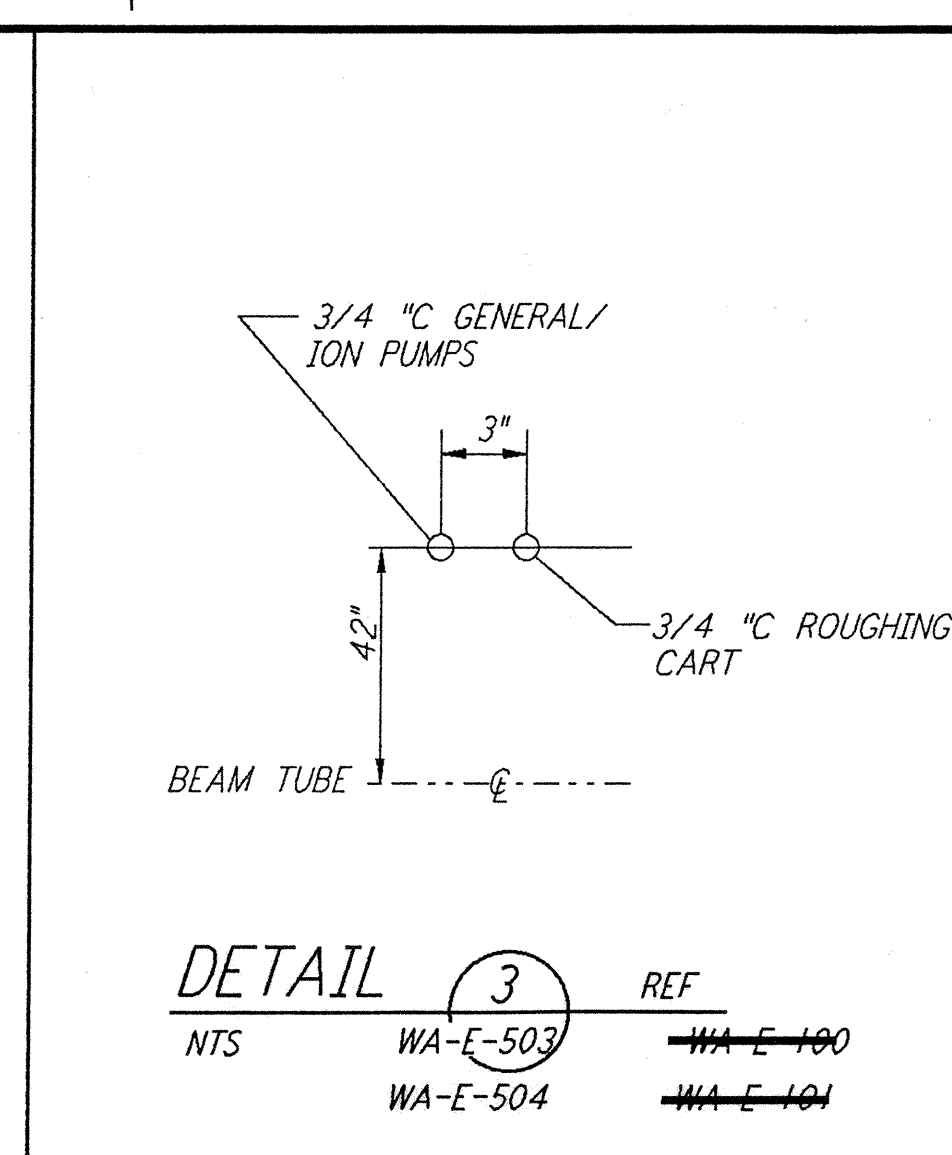
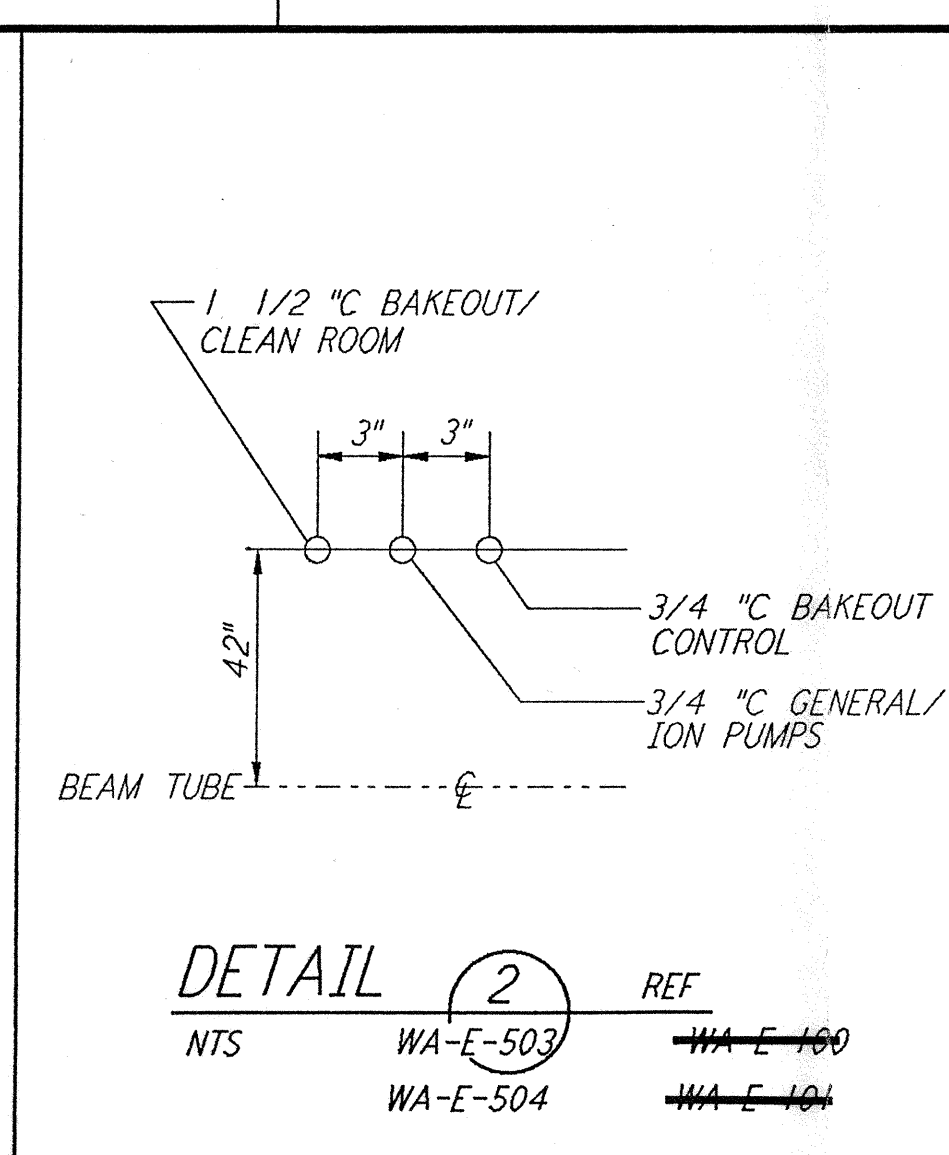


not be reproduced, copied, loaned, exhibited, or used in any other way, except by written consent from PARSONS to the borrower.

This document and the design it covers are the property of PARSONS. They are loaned only with the borrower's expressed written agreement that they will

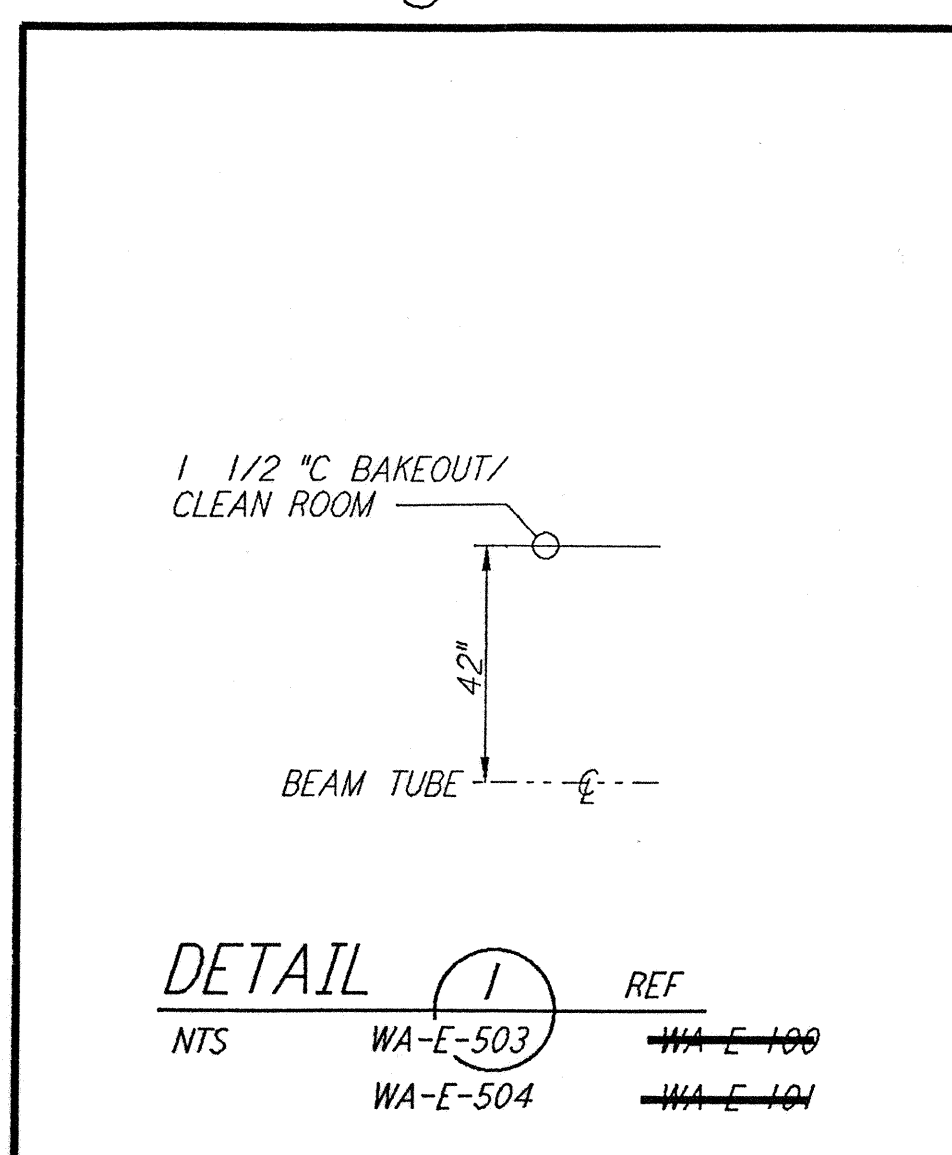

NO.	DATE	BY	CHKD	ENGR	PROJ	DESCRIPTION
A	4-19-96	M.M.	ML	ML	ML	FINAL DESIGN REVIEW & BID

NO.	DATE	BY	CHKD	ENGR	PROJ	DESCRIPTION
A	4-19-96	M.M.	ML	ML	ML	FINAL DESIGN REVIEW & BID

DRAWN	M.M.
CHECKED	
ENGINEER	
PROJ	

DATE	4-19-96
BY	M.M.
CHKD	ML
ENGR	ML
PROJ	ML

PARSONS
 100 WEST WALNUT STREET
 PASADENA, CALIFORNIA

LIGO
 CALIFORNIA INSTITUTE OF TECHNOLOGY
 MASSACHUSETTS INSTITUTE OF TECHNOLOGY

LASER INTERFEROMETER
 GRAVITATIONAL-WAVE OBSERVATORY
 SITE NO. 1 - HANFORD, WASHINGTON

ELECTRICAL CORNER STATION
 LVEA AREAS 101, 102, 103, 104
 DETAILS

SCALE: NONE
 CONTRACT NUMBER: PPI50969
 PROJECT NUMBER: 8094

SHEET NUMBER: **WA-E-114**

Date Received: 4/19/96	LIGO-D960403-A-0
