not be reproduced, copied, loaned, exhibited, or used in any other way, except by written consent from **PARSONS** to the borrower.

This document and the design it covers are the property of **PARSONS**. They are loaned only with the borrower's expressed written agreement that they will

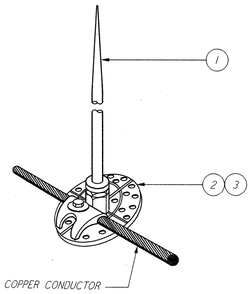

LIST OF MATERIAL

ITEM NO.	QTY	DESCRIPTION
1	1	AIR TERMINAL, SOLID COPPER, 1/2" X 12" HARGER # 718
2	1	BRONZE ADHESIVE BASE, HARGER # 152
3	1	ADHESIVE, HARGER # 263

AIR TERMINAL HORIZONTAL MTG. (1/—) REF
N. T. S.

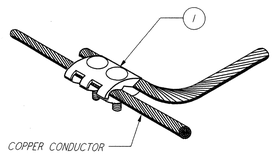

LIST OF MATERIAL

ITEM NO.	QTY	DESCRIPTION
1	1	2 BOLT PARALLEL SPLICER, HARGER # 204

CABLE TAP (2/—) REF
N. T. S.

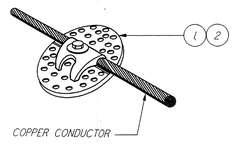

LIST OF MATERIAL

ITEM NO.	QTY	DESCRIPTION
1	1	ADHESIVE CABLE HOLDER, HARGER # 260
2	1	ADHESIVE, HARGER # 263

CABLE BONDING TO SURFACE (3/—) REF
N. T. S.

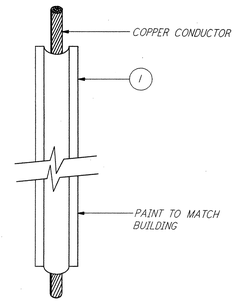

LIST OF MATERIAL

ITEM NO.	QTY	DESCRIPTION
1	AR	PVC CABLE GAURD HARGER # 321

EXTERIOR BUILDING CABLE SUPPORT (4/—) REF
N. T. S.

REFERENCES

DRAWING NO.	DESCRIPTION

REVISIONS

NO.	DATE	BY	CHKD	ENGR	PROJ	DESCRIPTION
1	6-15-98	J. G.				ISSUED FOR AS-BUILT

ISSUED FOR CONSTRUCTION		
DRAWN	M. M.	6-25-96
CHECKED	J. K.	7-3-96
ENGINEER	K. R.	7-3-96
PROJ	M. D. W.	7-8-96

AS-BUILT DRAWINGS

PARSONS
100 WEST WALNUT STREET
PASADENA, CALIFORNIA

LIGO
CALIFORNIA INSTITUTE OF TECHNOLOGY
MASSACHUSETTS INSTITUTE OF TECHNOLOGY

LIGO-D960428-01-O

LASER INTERFEROMETER
GRAVITATIONAL-WAVE OBSERVATORY
SITE NO. 1 - HANFORD, WASHINGTON

TITLE
ELECTRICAL LIGHTNING PROTECTION DETAILS

SCALE	CONTRACT NUMBER	PROJECT NUMBER
NONE	PP150969	8094

SHEET NUMBER **WA-E-408** REVISIONS 1

LIGOWAF.BDR

Thu Jul 09 12:49:34 1998 C:\PLOT\DJE\S3-V36B2.DCF 52085 K:\V36B2\ee408.prf