DATE: 07/09/98 TIME: 13:56:07
DESIGN FILE: I:\ligo\site1\ee\wae504.d3z

This document and the design it covers are the property of PARSONS. They are loaned only with the borrower's expressed written agreement that they will not be reproduced, copied, loaned, exhibited, or used in any other way, except by written consent from PARSONS to the borrower.

BUILDING NORTH
TRUE NORTH

NOTES:

1. FOR GENERAL NOTES AND LEGEND, SEE DWG. WA-E-503.
2. ALL CDSAC CONDUIT EMBEDED WITHIN AND BELOW LVEA FLOOD SLABS SHALL BE 2" IN SIZE AND SPACED 4" ON CENTER AT STUB-UPS.

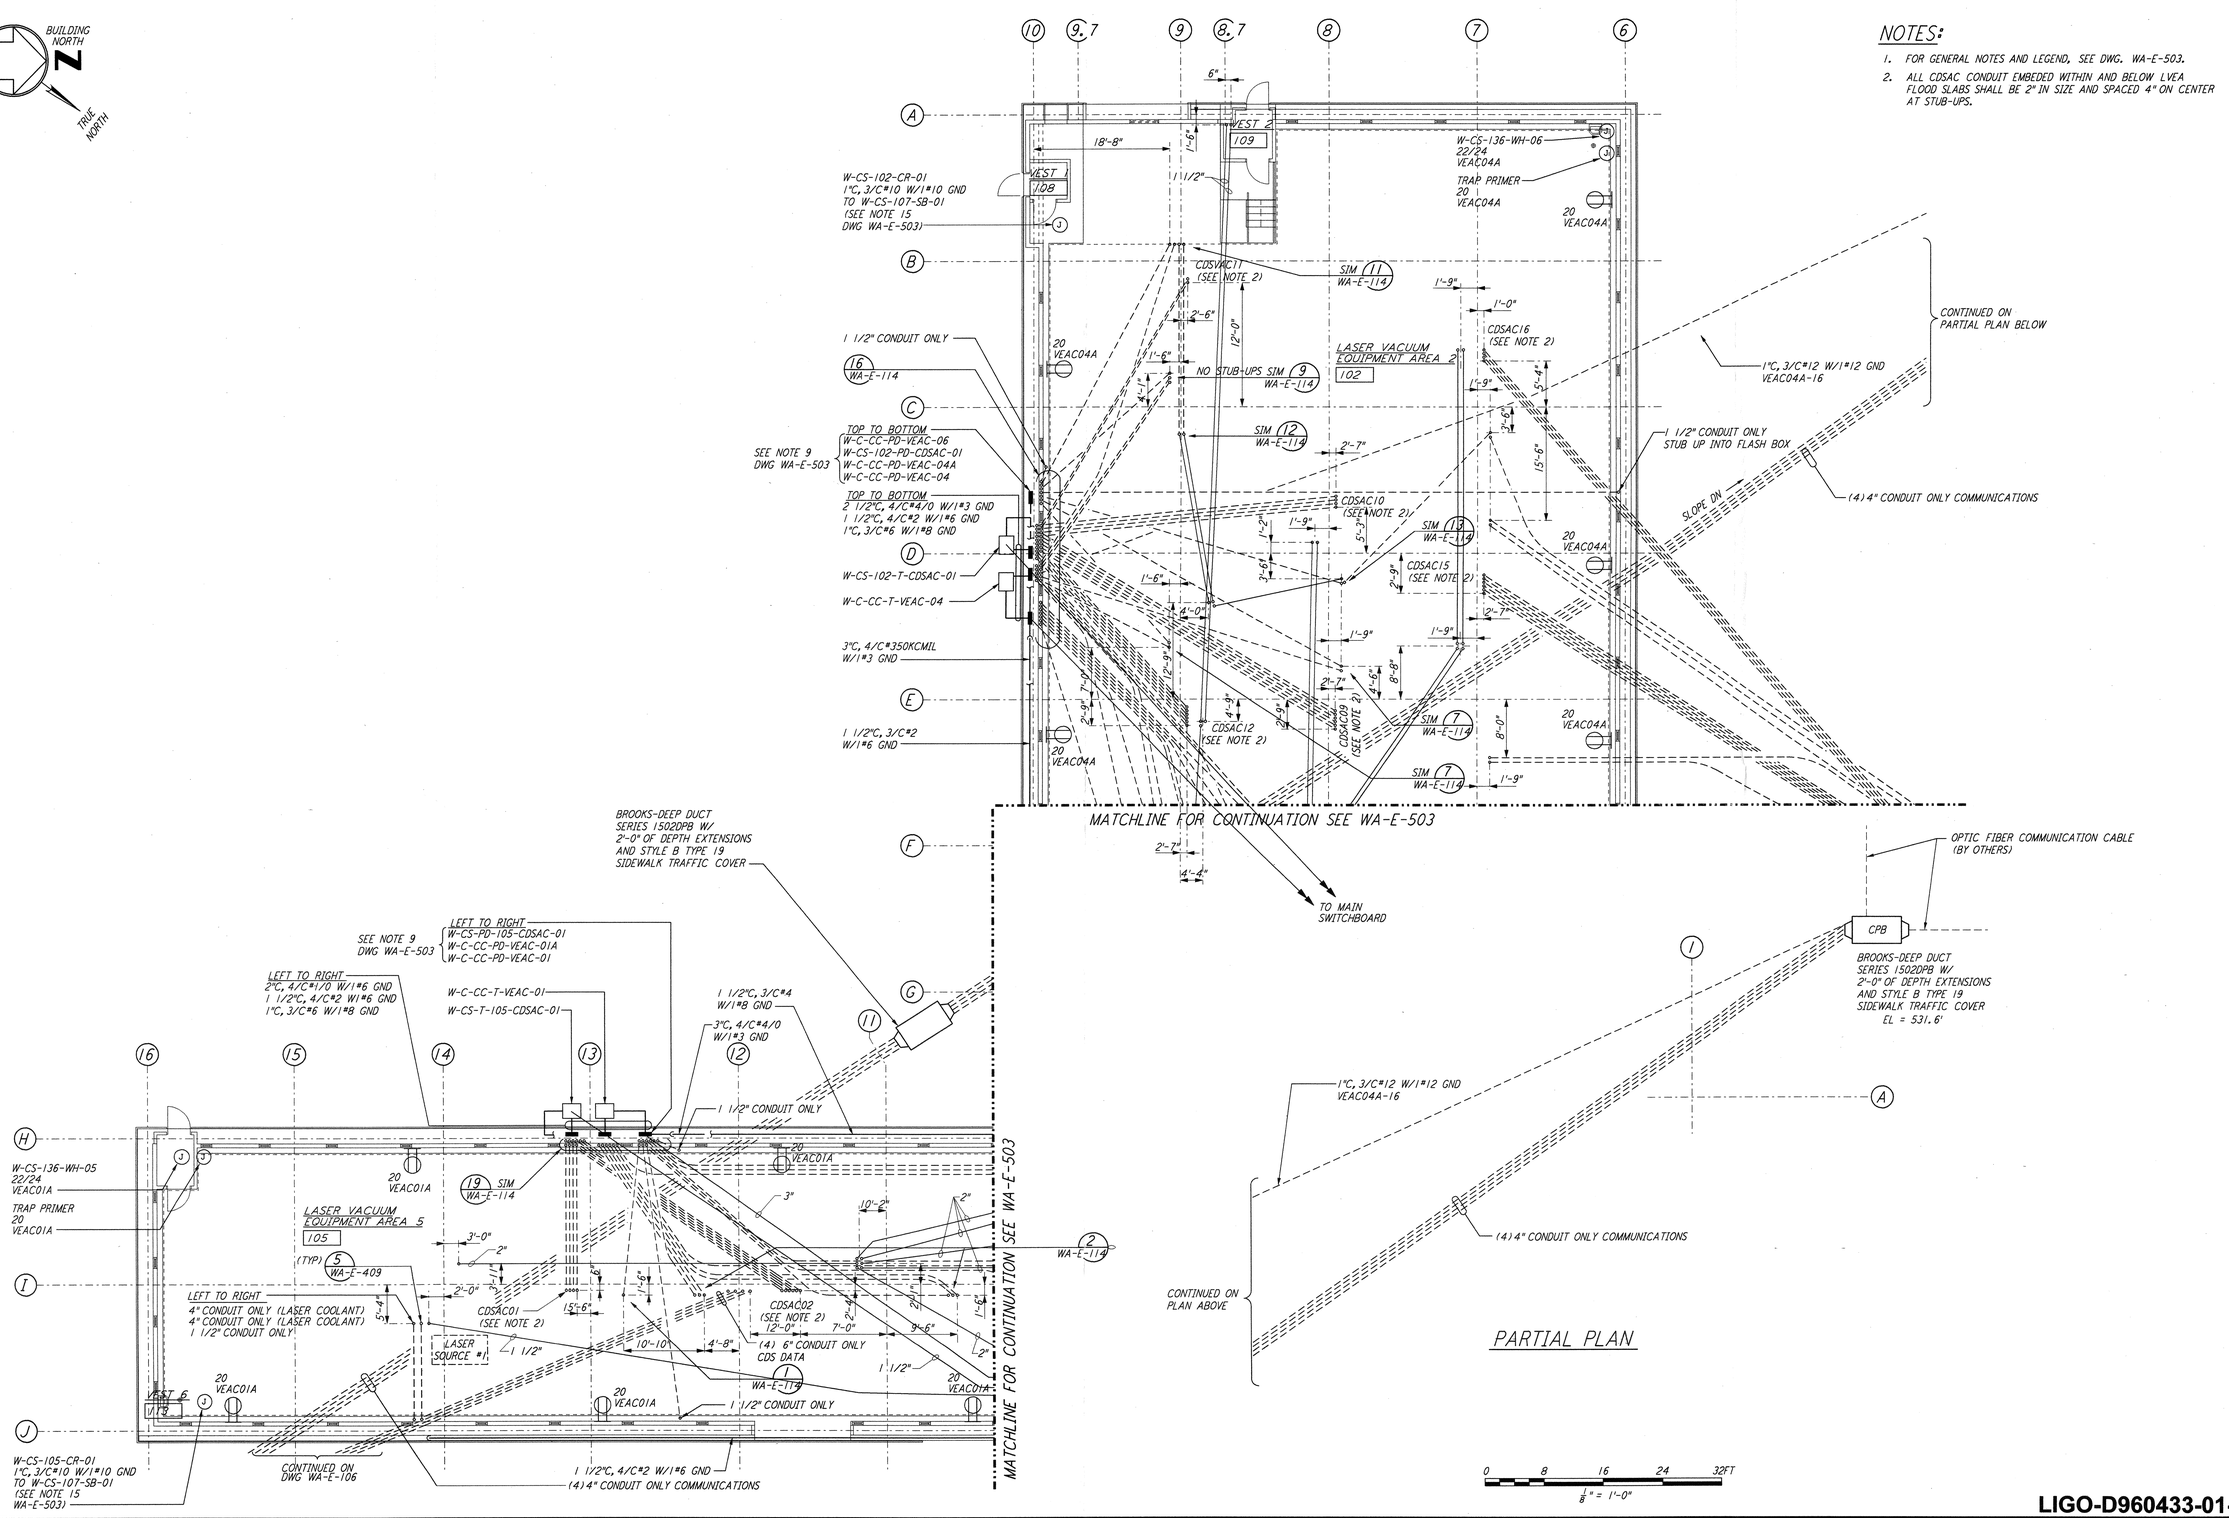

LIGO-D960433-01-O

REFERENCES		REVISIONS						
DRAWING NO.	DESCRIPTION	NO.	DATE	BY	CHKD	ENGR	PROJ	DESCRIPTION
		1	6-15-98	J.G.				ISSUED FOR AS-BUILT

ISSUED FOR CONSTRUCTION		
DRAWN	M. M.	6-25-96
CHECKED	J. K.	7-3-96
ENGINEER	K. R.	7-3-96
PROJ	M. D. W.	7-8-96

AS-BUILT DRAWINGS

PARSONS
100 WEST WALNUT STREET
PASADENA, CALIFORNIA

LIGO
CALIFORNIA INSTITUTE OF TECHNOLOGY
MASSACHUSETTS INSTITUTE OF TECHNOLOGY

LASER INTERFEROMETER
GRAVITATIONAL-WAVE OBSERVATORY
SITE NO. 1 - HANFORD, WASHINGTON

TITLE
ELECTRICAL CORNER STATION 3RD INTERFEROMETER LVEA RECEPTACLE & POWER PLAN

SCALE	CONTRACT NUMBER	PROJECT NUMBER
AS NOTED	PP150969	8094

SHEET NUMBER: **WA-E-504**
REVISIONS: 1

LIGOWAF3.BDR

Thu Jul 09 13:55:42 1998 C:\PLOT\QUES3-V36B2.DCF 52895 K:\V36B2\ee504.prf