
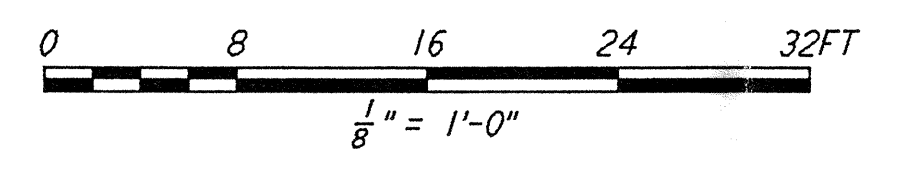


NOTES:
 1. FOR GENERAL NOTES AND LEGEND, SEE DWG. WA-E-503.
 2. ALL CDSAC CONDUIT EMBEDDED WITHIN AND BELOW LVEA FLOOD SLABS SHALL BE 2" IN SIZE AND SPACED 4" ON CENTER AT STUB-UPS.

not be reproduced, copied, loaned, exhibited, or used in any other way, except by written consent from PARSONS to the borrower.

This document and the design it covers are the property of PARSONS. They are loaned only with the borrower's expressed written agreement that they will

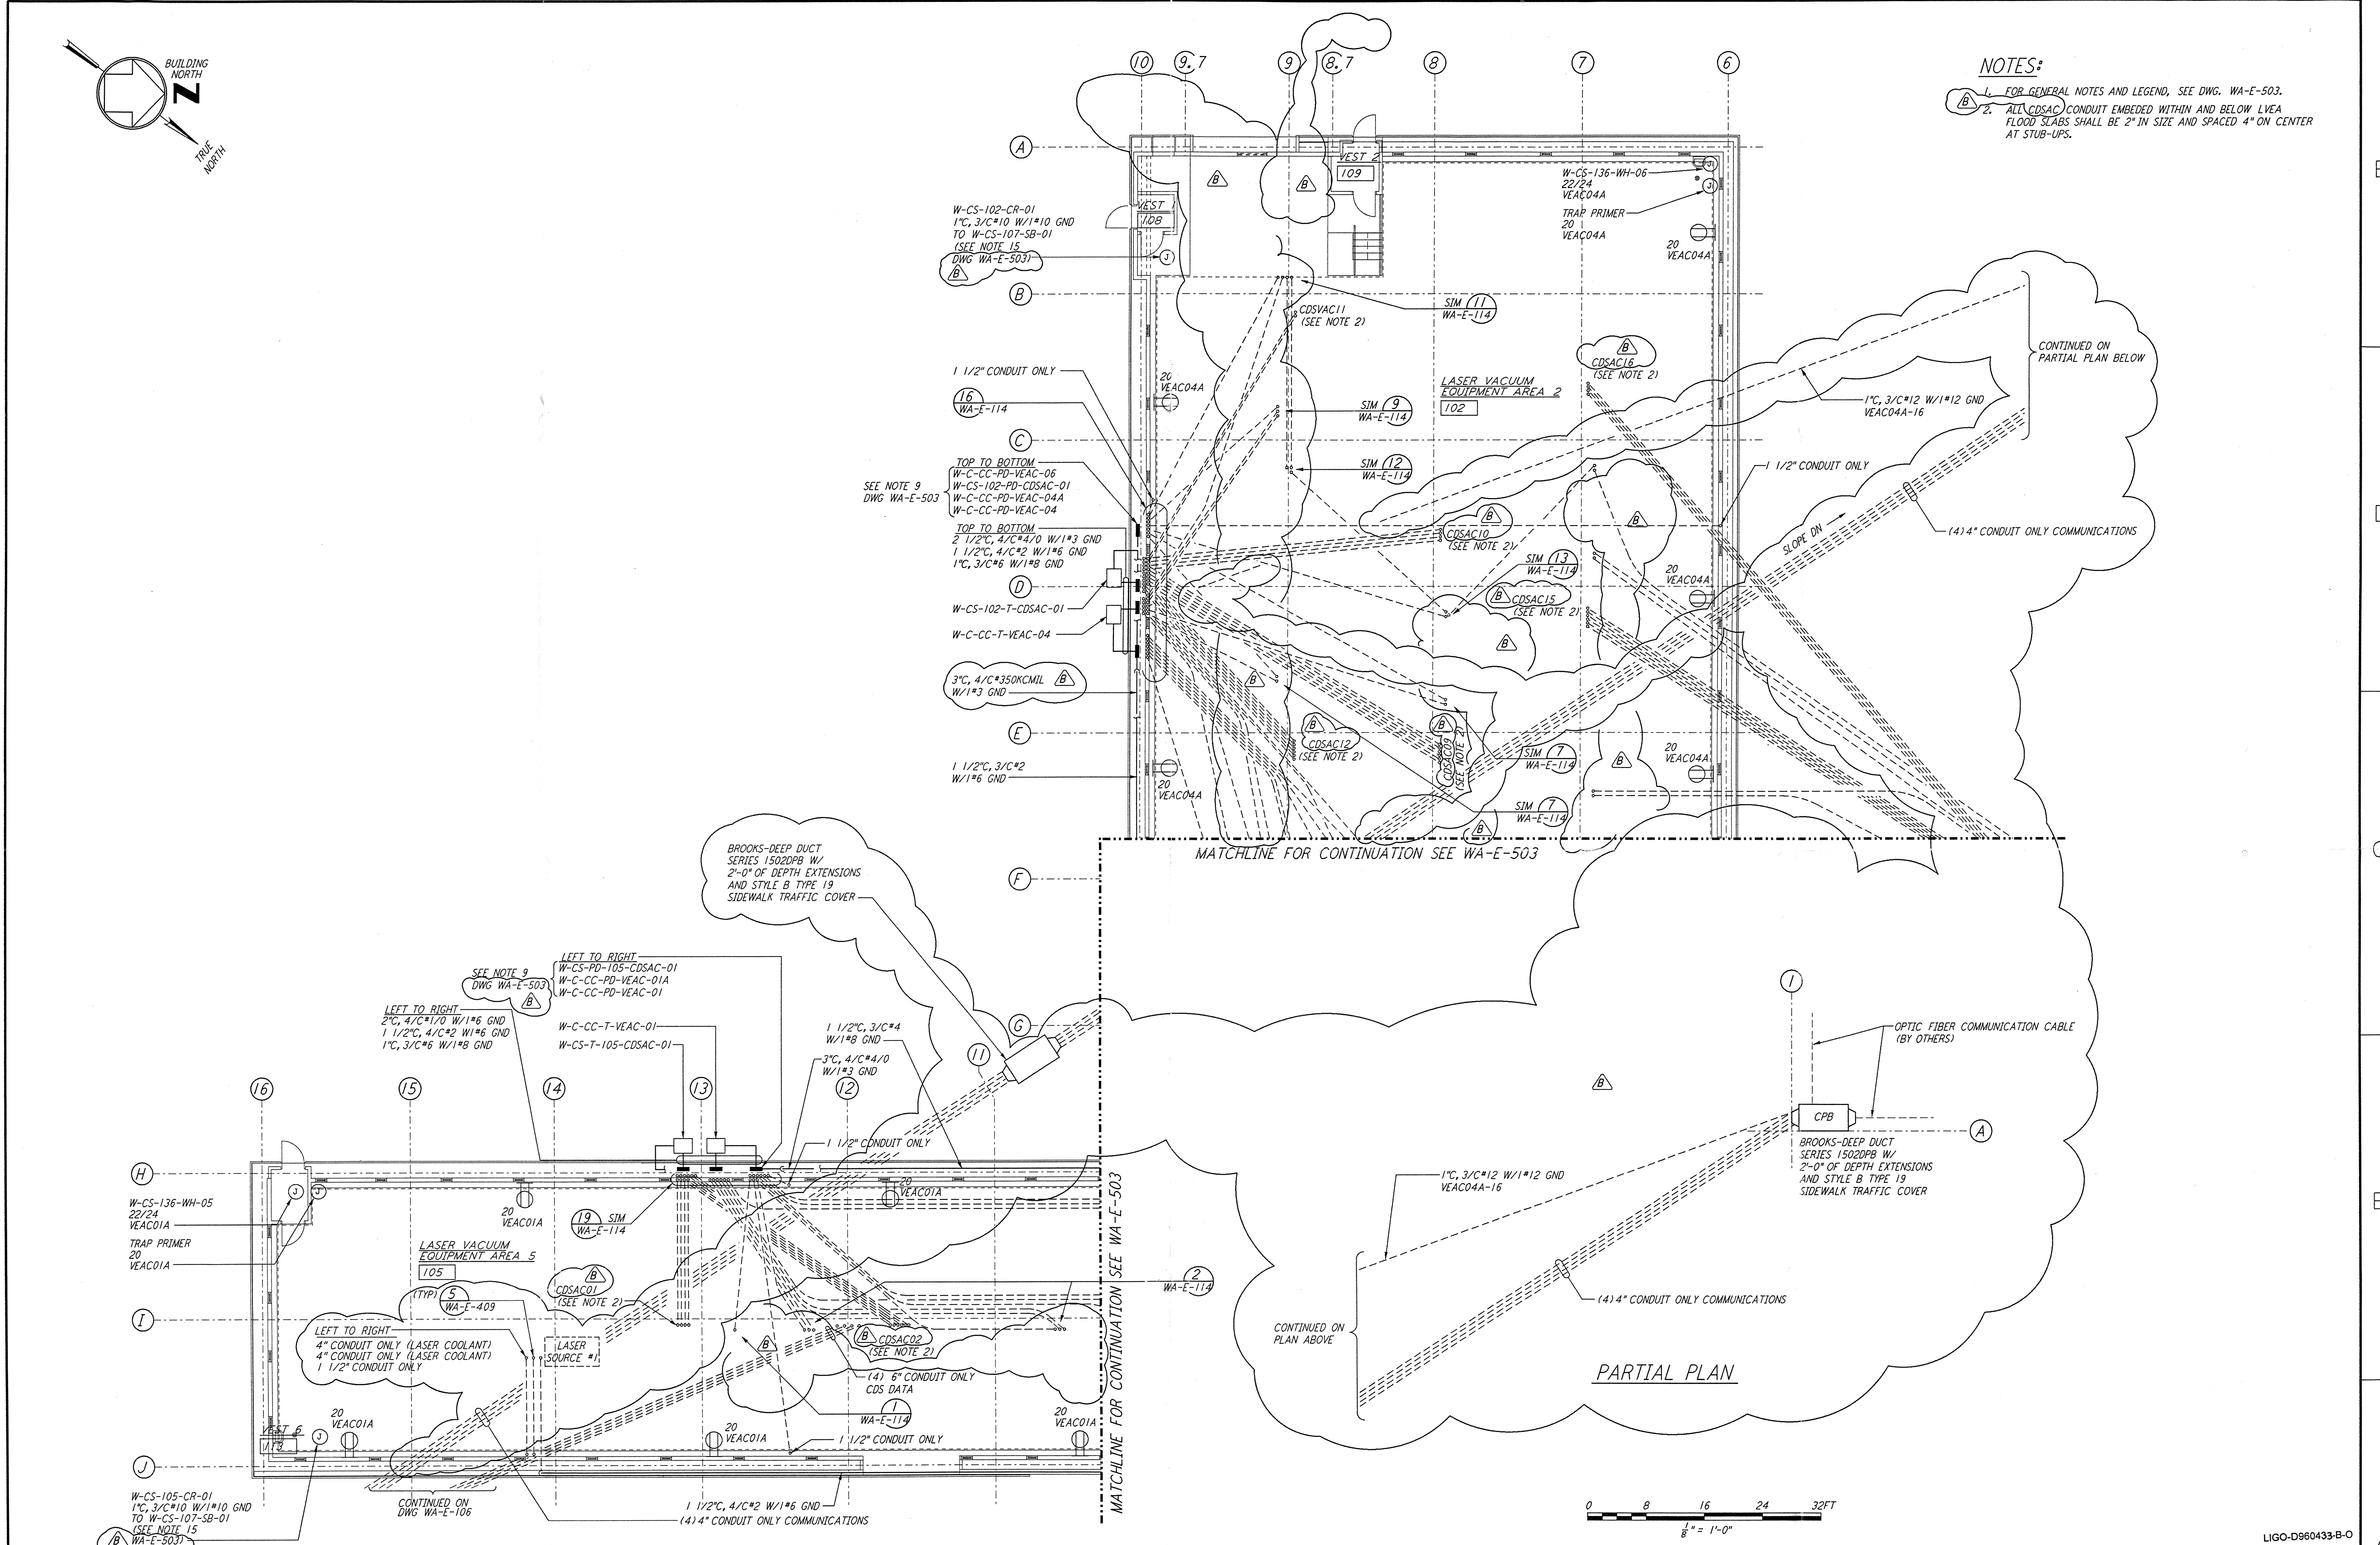

NO.	DATE	BY	CHKD	ENGR	PROJ	DESCRIPTION
B	5-22-96	RAE	TM	W	DOM	BID ADDENDUM #2
A	4-19-96				TDM	FINAL DESIGN REVIEW & BID

DRAWN	K. R.
CHECKED	
ENGINEER	
PROJ	

PARSONS
 100 WEST WALNUT STREET
 PASADENA, CALIFORNIA

LIGO
 CALIFORNIA INSTITUTE OF TECHNOLOGY
 MASSACHUSETTS INSTITUTE OF TECHNOLOGY

LASER INTERFEROMETER
 GRAVITATIONAL-WAVE OBSERVATORY
 SITE NO. 1 - HANFORD, WASHINGTON

TITLE	SCALE	CONTRACT NUMBER	PROJECT NUMBER
ELECTRICAL CORNER STATION 3RD INTERFEROMETER LVEA RECEPTACLE & POWER PLAN	AS NOTED	PP150969	8094
SHEET NUMBER		REVISIONS	
WA-E-504		B	

LIGO-D960433-B-0