DATE: 01/21/99 TIME: 13:50:00
DESIGN FILE: I:\ligo\site1\ce\btc027.dgz

This document and the design it covers are the property of **PARSONS**. They are loaned only with the borrower's expressed written agreement that they will not be reproduced, copied, loaned, exhibited, or used in any other way, except by written consent from **PARSONS** to the borrower.

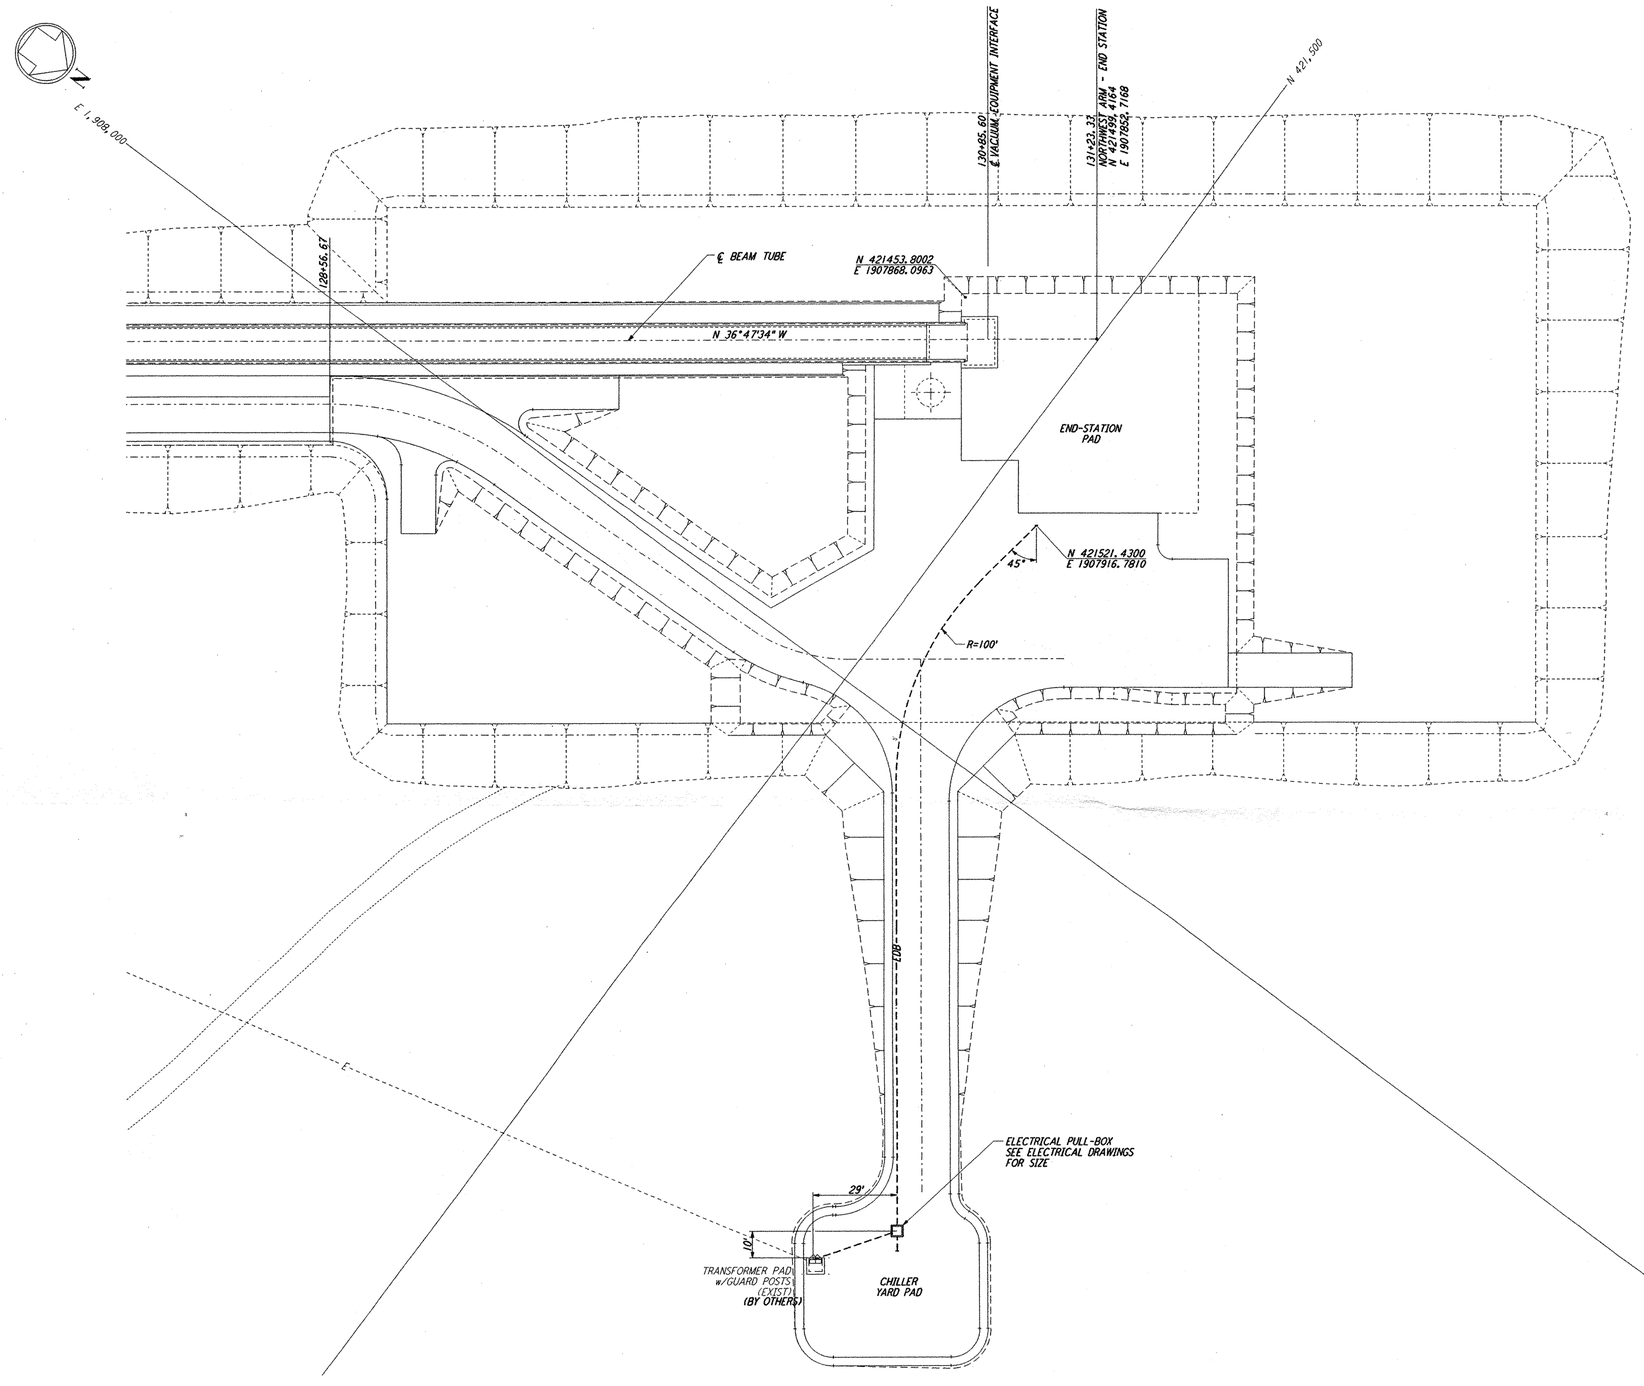

NOTES:

1. SEE SHEET WA-C-002 FOR GENERAL NOTES, LEGEND AND ABBREVIATIONS.

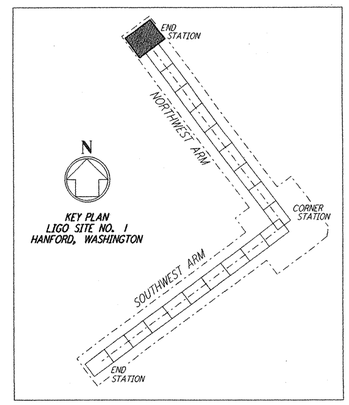

LIGO-D960721-00-O

GRAPHIC SCALE
0 20 40 60 80
SCALE: 1" = 20'

REFERENCES		REVISIONS						
DRAWING NO.	DESCRIPTION	NO.	DATE	BY	CHKD	ENGR	PROJ	DESCRIPTION
		0	1-22-99	MEI	--	--	MDW	ISSUED FOR AS BUILT
		A	4-19-96	WRB	TDM		MDW	CHANGE ORDER NO. 4

DRAWN	WRB
CHECKED	
ENGINEER	
PROJ	

AS-BUILT DRAWINGS

PARSONS
100 WEST WALNUT STREET
PASADENA, CALIFORNIA

LIGO
CALIFORNIA INSTITUTE OF TECHNOLOGY
MASSACHUSETTS INSTITUTE OF TECHNOLOGY

LASER INTERFEROMETER GRAVITATIONAL-WAVE OBSERVATORY
BTE SITEWORK & FABRICATION - HANFORD, WA

TITLE: **CIVIL NORTHWEST ARM END-STATION UTILITY PLAN**

SCALE	CONTRACT NUMBER	PROJECT NUMBER
1" = 20'	PP150969	8094

SHEET NUMBER: **BT-C-027** REVISIONS: 0

LIGOBTF3.BDR

Thu Jan 21 13:49:47 1999 C:\PLOT\QUE\S3-V3682.OCF 52085 K:\V3682\ce027.apr.f