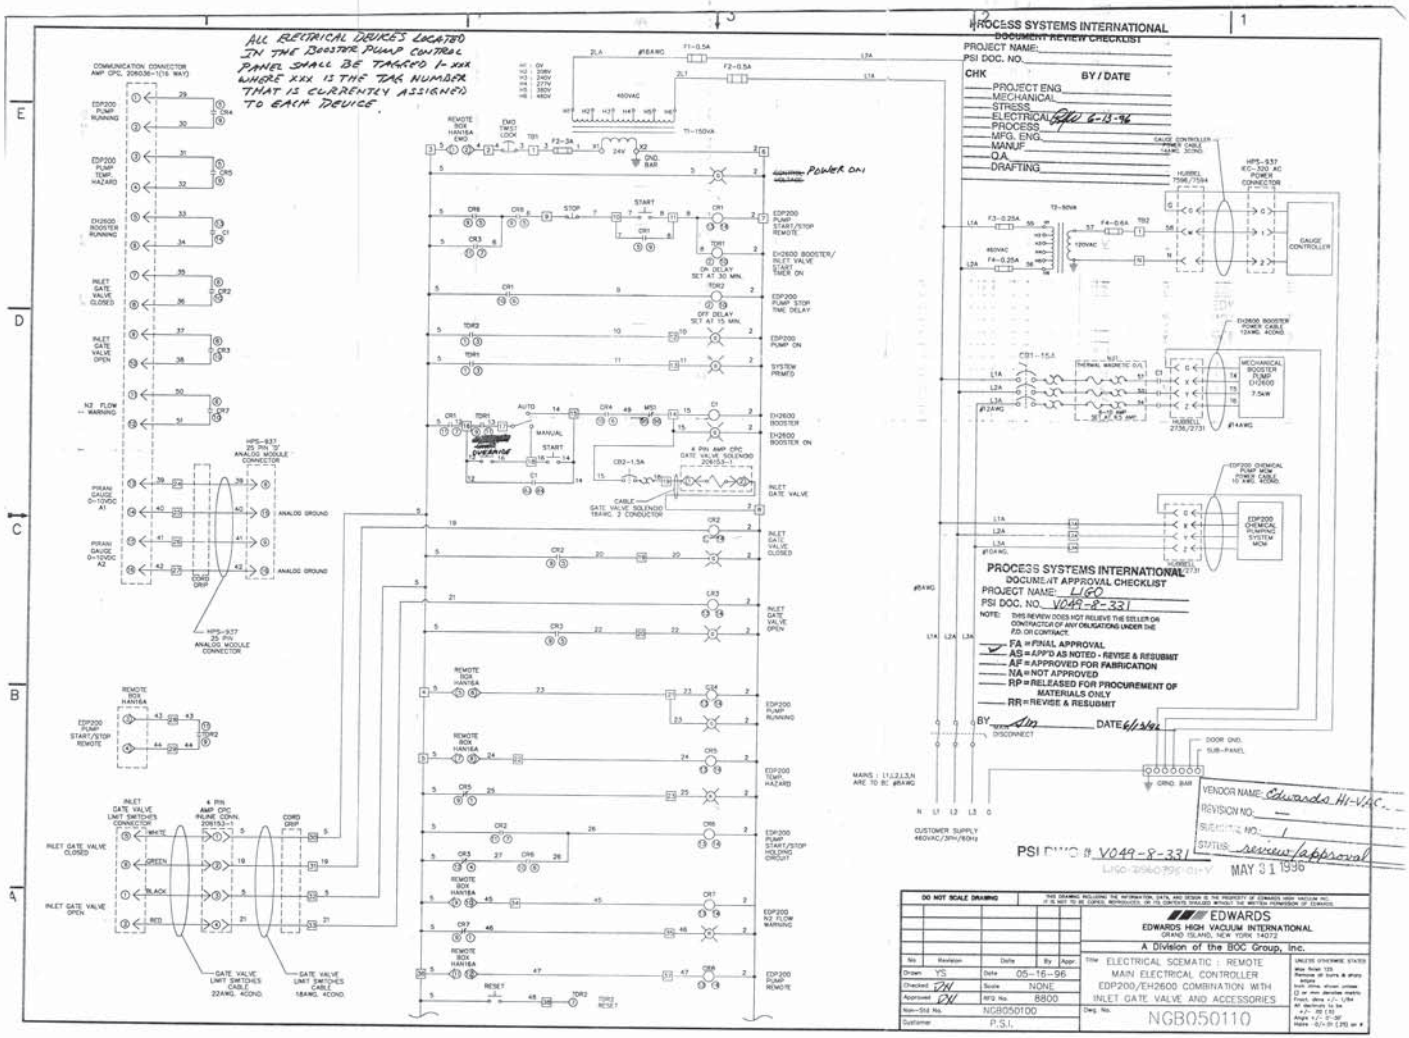
ALL ELECTRICAL DEVICES LOCATED IN THE BOOSTER PUMP CONTROL PANEL SHALL BE TAGGED 1-XXX WHERE XXX IS THE TAG NUMBER THAT IS CURRENTLY ASSIGNED TO EACH DEVICE.
PROCESS SYSTEMS INTERNATIONAL
DOCUMENT REVIEW CHECKLIST
PROJECT NAME:
PSI DOC. NO.
CHK BY / DATE
PROJECT ENG.
MECHANICAL
STRESS
ELECTRICAL
PROCESS
MFG. ENG.
MANUF.
Q.A.
DRAFTING
PROCESS SYSTEMS INTERNATIONAL
DOCUMENT APPROVAL CHECKLIST
PROJECT NAME: LIGO
PSI DOC. NO. V049-8-331
NOTE: THIS REVIEW DOES NOT RELIEVE THE SELLER OR CONTRACTOR OF ANY OBLIGATIONS UNDER THE P.O. OR CONTRACT.
FA = FINAL APPROVAL
AS = APP'D AS NOTED - REVISE & RESUBMIT
AF = APPROVED FOR FABRICATION
NA = NOT APPROVED
RP = RELEASED FOR PROCUREMENT OF MATERIALS ONLY
RR = REVISE & RESUBMIT
BY
DATE 6/1/96
VENDOR NAME: Edwards Hi-Vac
REVISION NO:
SUBMITTAL NO: 1
STATUS: review/approval
MAY 31 1996
DO NOT SCALE DRAWING
EDWARDS
EDWARDS HIGH VACUUM INTERNATIONAL
GRAND ISLAND, NEW YORK 14072
A Division of the BOC Group, Inc.
Title: ELECTRICAL SCEMATIC : REMOTE MAIN ELECTRICAL CONTROLLER EDP200/EH2600 COMBINATION WITH INLET GATE VALVE AND ACCESSORIES
Drawn YS Date 05-16-96
Checked DH Scale NONE
Approved DH MFG No. 8800
Non-Std No. NGB050100
Customer P.S.I.
Dwg. No. NGB050110