
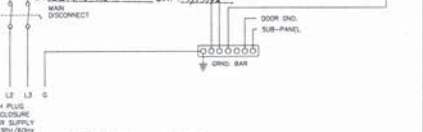
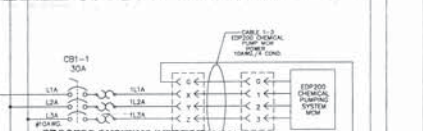


**PROCESS SYSTEMS INTERNATIONAL**  
**DOCUMENT REVIEW CHECKLIST**  
 PROJECT NAME: L160  
 PSI DOC. NO. W049-8-331  
 CHK BY / DATE: 7/1/96

PROJECT ENG: Am 7/1/96  
 STRESS: \_\_\_\_\_  
 MECHANICAL: \_\_\_\_\_  
 ELECTRICAL: 7-1-96  
 PROCESS: \_\_\_\_\_  
 MFG. ENG: \_\_\_\_\_  
 MANUF: \_\_\_\_\_  
 QA: \_\_\_\_\_  
 DRAFTING: \_\_\_\_\_

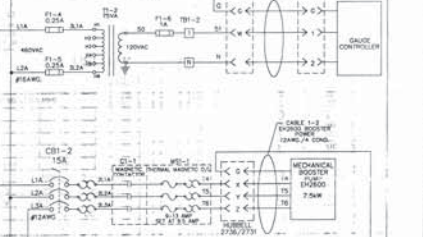

**PROCESS SYSTEMS INTERNATIONAL**  
**DOCUMENT APPROVAL CHECKLIST**  
 PROJECT NAME: L160  
 PSI DOC. NO. W049-8-331

NOTE: THE REVIEWER'S SIGNATURE IS REQUIRED FOR ALL APPROVALS. APPROVALS MUST BE OBTAINED FROM THE DESIGN ENGINEER, THE DESIGN CHECKER, AND THE DESIGNER.

\_\_\_\_\_  
 FINAL APPROVAL  
 AS NOTED AS NOTES - REVISE & RESUBMIT  
 AS APPROVED FOR FABRICATION  
 NOT APPROVED  
 RP = RELEASED FOR PROCUREMENT OF MATERIALS ONLY  
 RR = REVISE & RESUBMIT

BY: [Signature] DATE: 7/1/96

DOOR SHD. SUB-PANEL  
 GND. BAR

NOTE: 1. LINE WITH PLUS FROM ENCLOSURE CUSTOMER SUPPLY 480VAC/3PH/3W

PSI DWG # W049-8-331  
 JUL 0 9 1996  
 JUL 3 1996

DO NOT SCALE DRAWING	THIS DRAWING INCLUDES THE INFORMATION, DATA, AND DESIGN IS THE PROPERTY OF EDWARDS HIGH VACUUM INTERNATIONAL. IT IS TO BE USED ONLY FOR THE PROJECT AND UNDER THE CLOSEST SUPERVISION OF EDWARDS INTERNATIONAL.
EDWARDS HIGH VACUUM INTERNATIONAL 6000 CLARKSON, NEW YORK, NY 12122 A Division of the BOC Group, Inc.	

REVISION	DATE	BY	APP	DESCRIPTION
1	05-16-96	NGR		MAIN ELECTRICAL CONTROLLER
2	06-29-96	NGR		ED2000/ED2000 COMBINATION WITH INLET GATE VALVE AND ACCESSORIES

VENDOR NAME: Edwards HI-VAC  
 REVISION NO.: \_\_\_\_\_  
 SUBMITTAL NO.: 2  
 STATUS: review/approval

NGBO50110  
 P.S.I.

E  
D  
C  
B  
A