not be reproduced, copied, loaned, exhibited, or used in any other way, except by written consent from PARSONS to the borrower.

This document and the design it covers are the property of PARSONS. They are loaned only with the borrower's expressed written agreement that they will

DATE: 08/25/98 TIME: 03:58:16
DESIGN FILE: I:\ligo\site2\ce\lc008.dgz

NOTES:

1. SEE SHEET LA-C-002 FOR GENERAL NOTES, LEGEND AND ABBREVIATIONS.

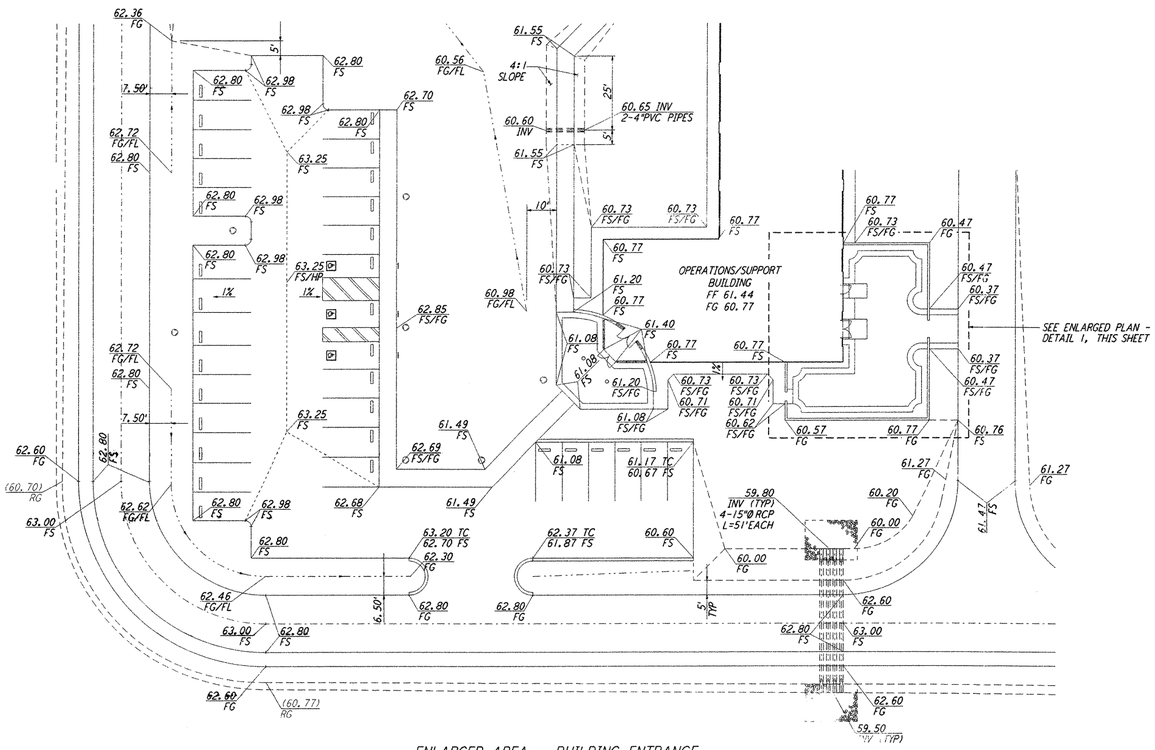

ENLARGED AREA - BUILDING ENTRANCE
SCALE: 1" = 20'

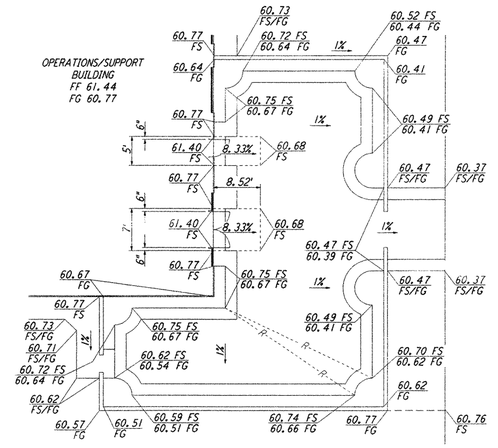

ENLARGED AREA - DETAIL 1
SCALE: 1" = 10'

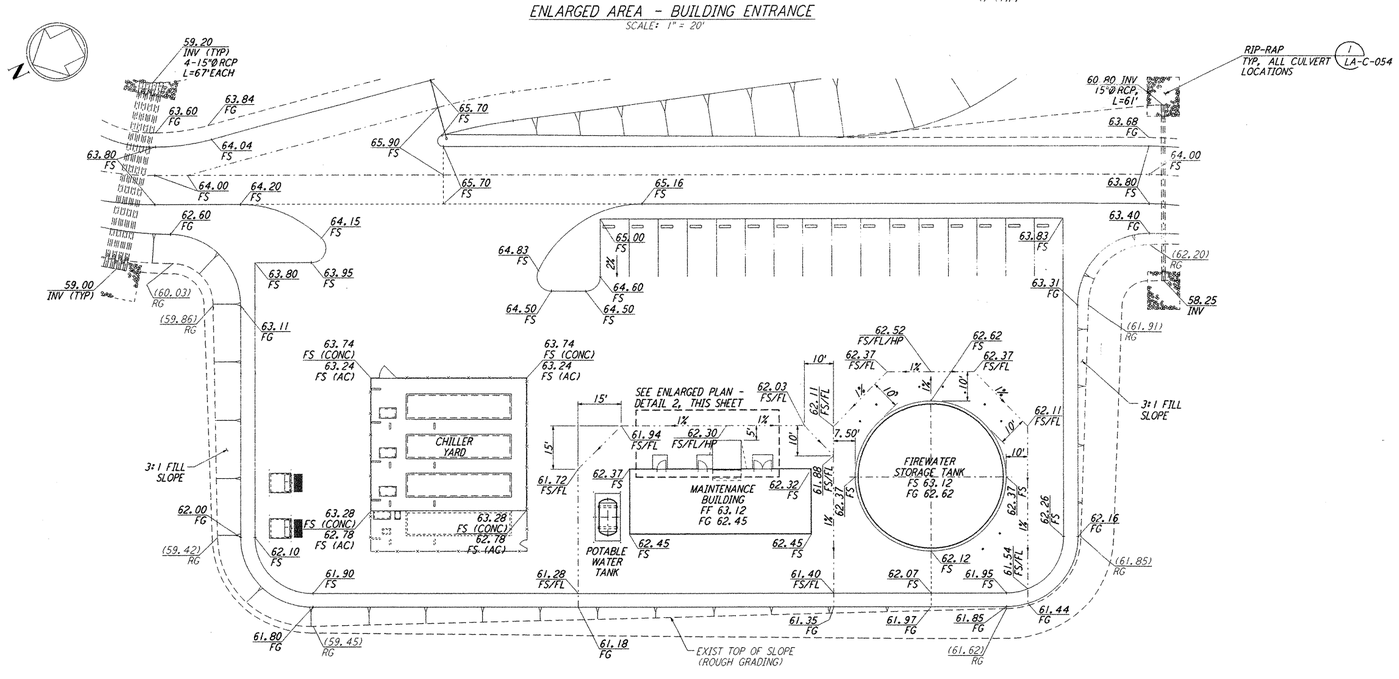

ENLARGED AREA - MAINTENANCE YARD
SCALE: 1" = 20'

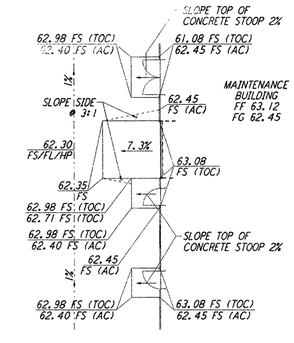

ENLARGED AREA - DETAIL 2
SCALE: 1" = 10'

LIGO-D960826-02-O

GRAPHIC SCALE
0 20 40 60 80
SCALE: 1" = 20'

REFERENCES		REVISIONS							
		2	08-07-98	WRB				TDM	ISSUED FOR AS-BUILT
		1	2-28-97	WRB	ML	JB	TDM	PROJ	ADDED WALK/WALL OPENING, REVISED GRADING
DRAWING NO.	DESCRIPTION	NO.	DATE	BY	CHKD	ENGR	PROJ		DESCRIPTION

ISSUED FOR CONSTRUCTION		
DRAWN	WRB	11-15-96
CHECKED	ML	11-15-96
ENGINEER	JB	11-15-96
PROJ	TDM	11-15-96

AS-BUILT DRAWINGS

PARSONS
100 WEST WALNUT STREET
PASADENA, CALIFORNIA

LIGO
CALIFORNIA INSTITUTE OF TECHNOLOGY
MASSACHUSETTS INSTITUTE OF TECHNOLOGY

LASER INTERFEROMETER
GRAVITATIONAL-WAVE OBSERVATORY
SITE NO. 2 - LIVINGSTON, LOUISIANA

TITLE: CIVIL
CORNER STATION
GRADING PLAN
ENLARGED PLAN

SCALE	CONTRACT NUMBER	PROJECT NUMBER
AS NOTED	PP150969	8094

SHEET NUMBER: LA-C-008
REVISIONS: 2

LIGOLAF3.BDR

Tue Aug 25 03:57:37 1998 C:\PLOT\QUE\53-1388.qef 52805 K:\T388C\ce008a.prf