

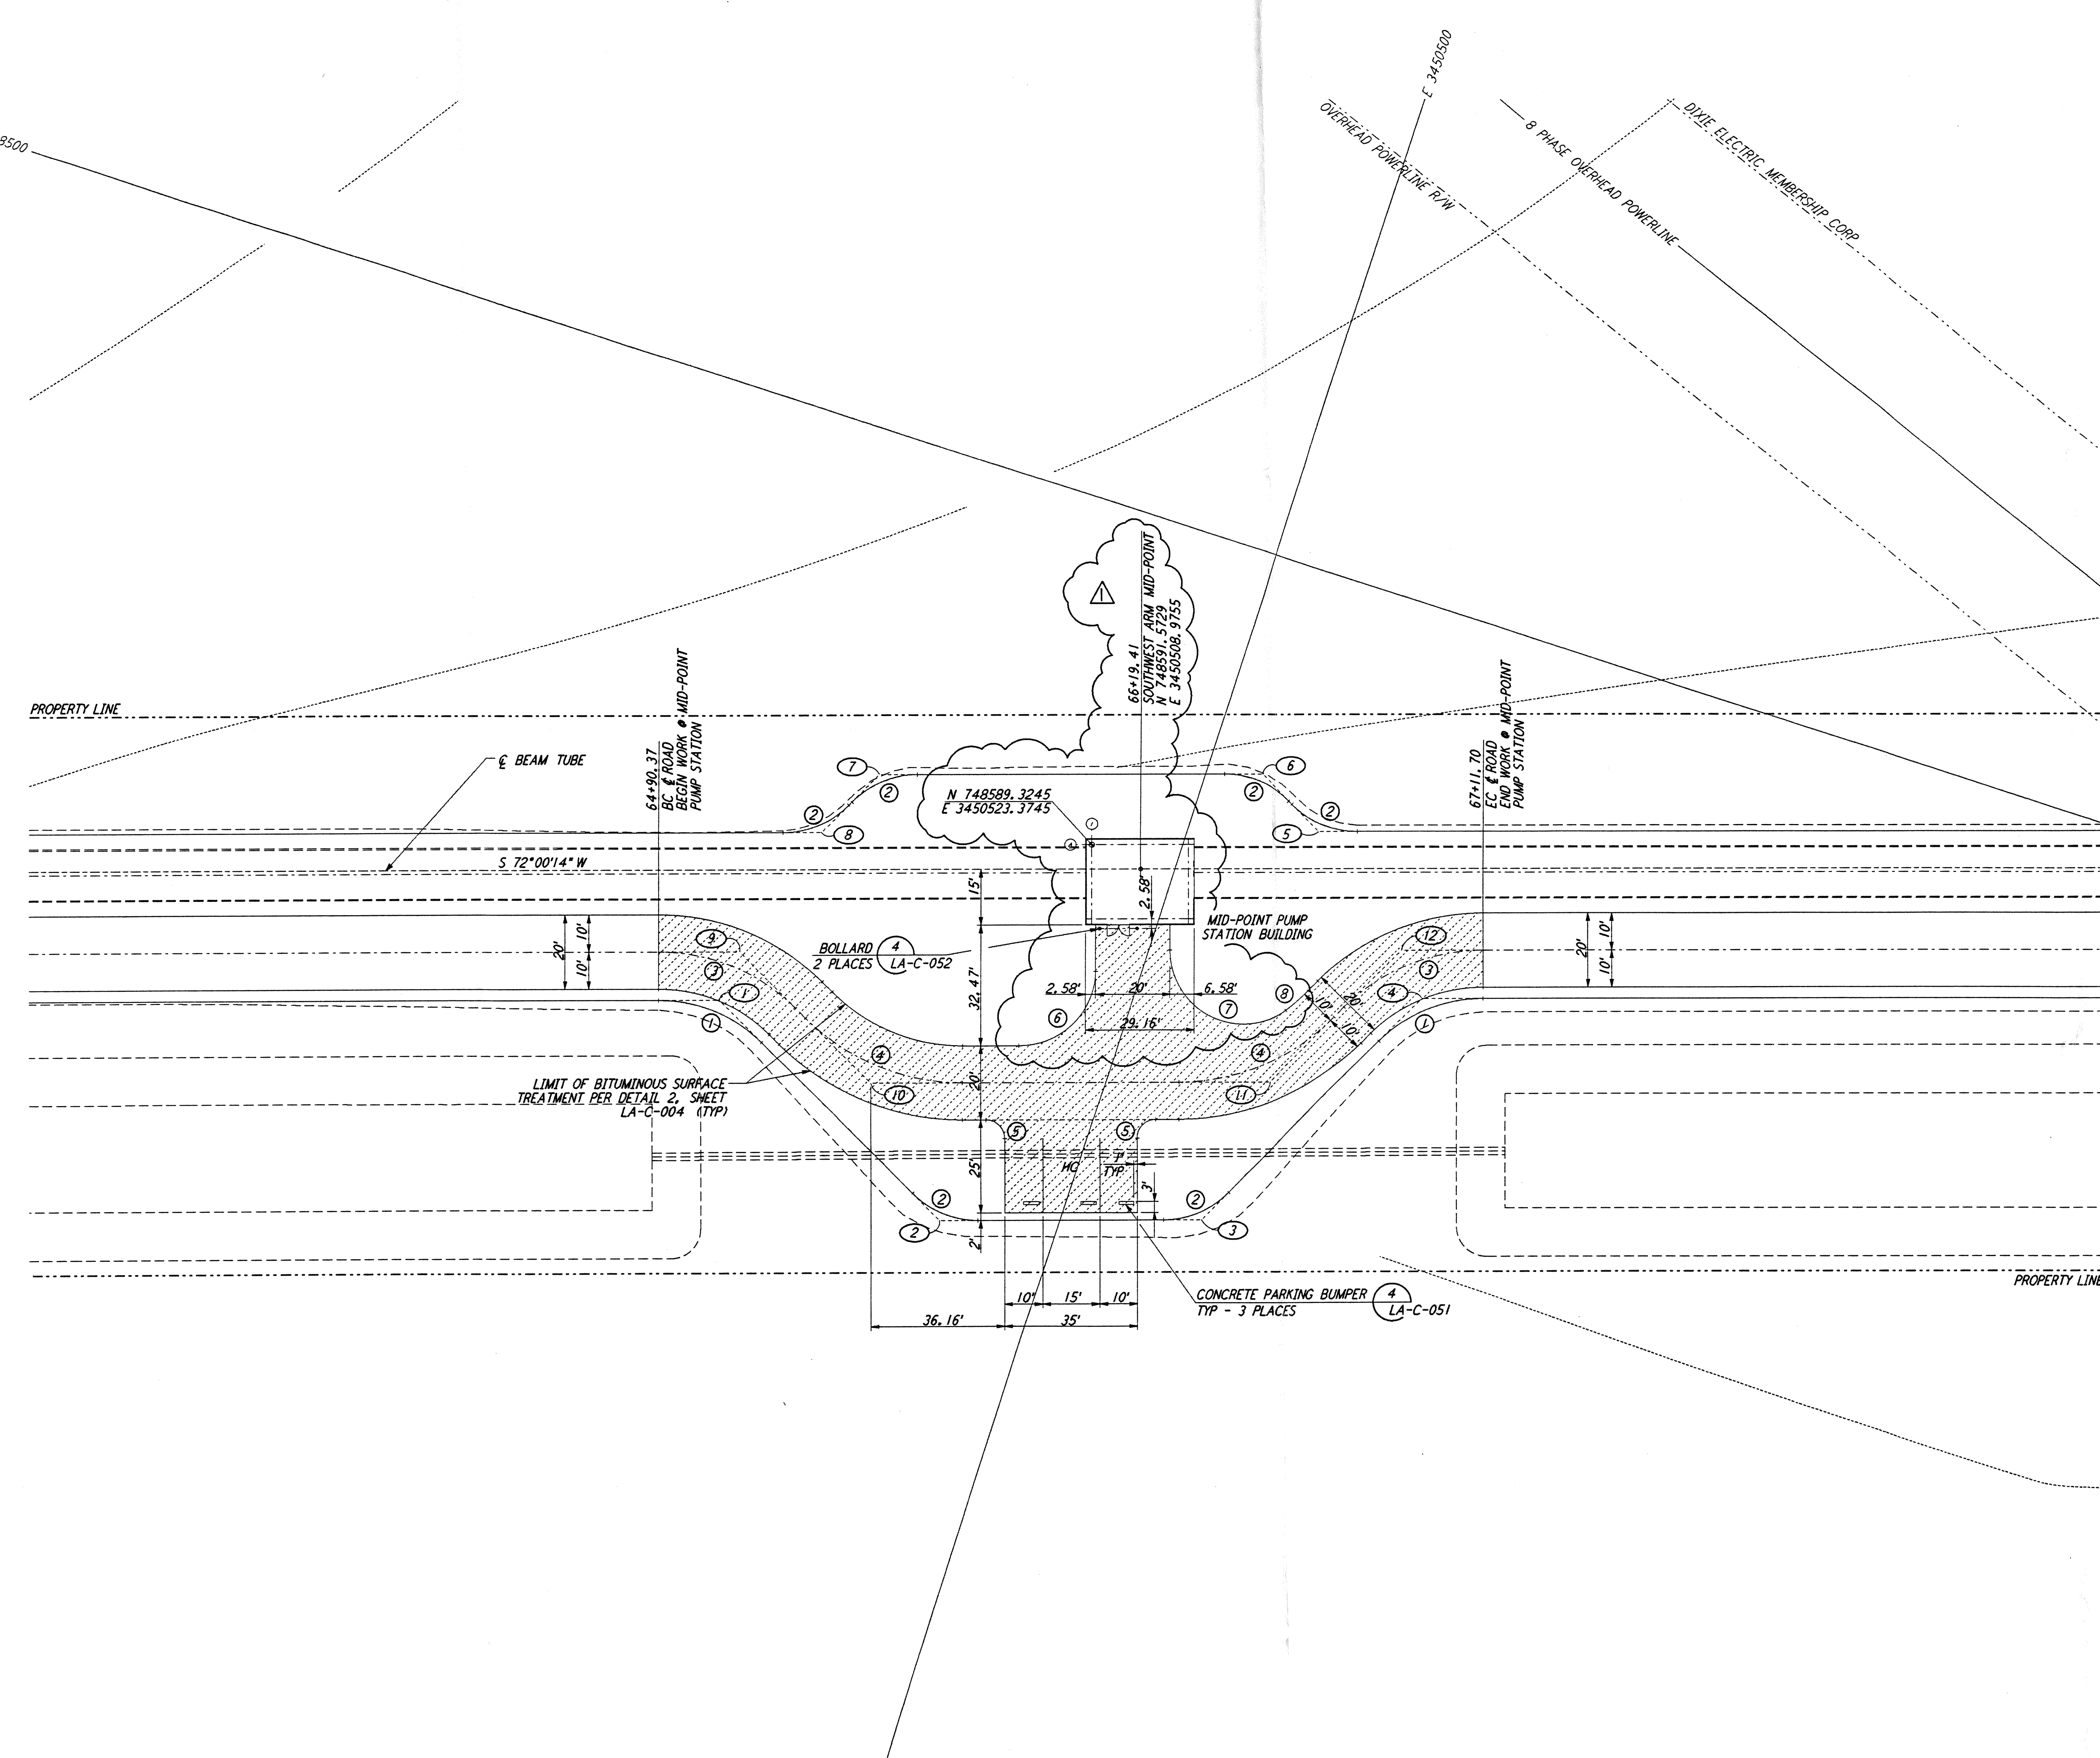
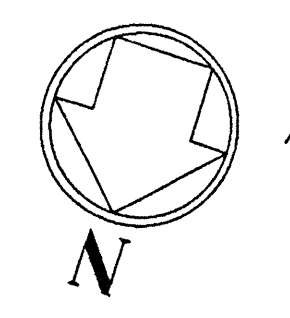


NOTES:  
 1. SEE SHEET LA-C-002 FOR GENERAL NOTES, LEGEND AND ABBREVIATIONS.

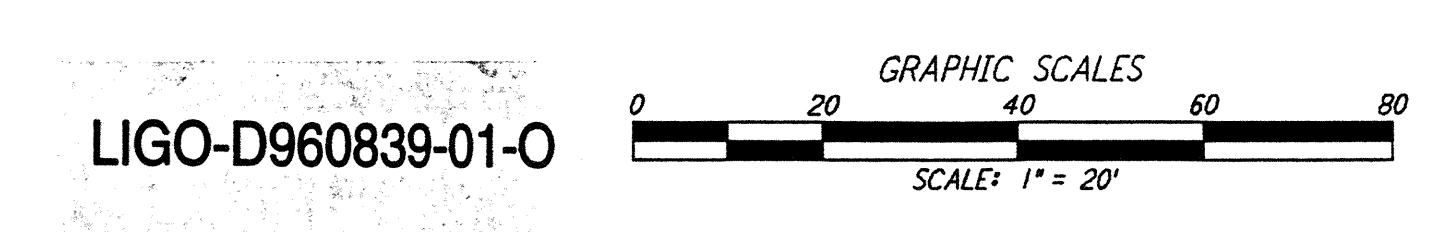

CURVE DATA					
Δ	RADIUS	LENGTH	TANGENT	REMARK	
1	45°00'00"	39'	30.63'	16.16'	EDGE OF PAD (EXIST)
2	45°00'00"	25'	19.63'	10.36'	EDGE OF PAD (EXIST)
3	45°00'00"	52'	40.84'	21.54'	EDGE OF ROAD
4	45°00'00"	60'	47.12'	24.85'	EDGE OF ROAD
5	90°00'00"	5'	7.85'	5.00'	
6	90°00'00"	20'	31.42'	20.00'	
7	125°49'51"	20'	43.92'	39.11'	
8	9°10'08"	50'	8.00'	4.01'	

COORDINATES			
Δ	NORTH	EAST	REMARK
1	748659.7365	3450605.5239	PI EDGE OF PAD (EXIST)
2	748697.9299	3450530.5654	PI EDGE OF PAD (EXIST)
3	748676.2822	3450463.9403	PI EDGE OF PAD (EXIST)
4	748601.3395	3450425.7549	PI EDGE OF PAD (EXIST)
5	748567.0708	3450465.7924	PI EDGE OF PAD (EXIST)
6	748557.0626	3450485.3564	PI EDGE OF PAD (EXIST)
7	748588.8911	3450583.3149	PI EDGE OF PAD (EXIST)
8	748608.4436	3450593.2774	PI EDGE OF PAD (EXIST)
9	748645.7089	3450604.4199	PI EDGE OF ROAD
10	748668.4802	3450559.7285	PI EDGE OF ROAD
11	748635.3154	3450457.6570	PI EDGE OF ROAD
12	748590.6389	3450434.8926	PI EDGE OF ROAD

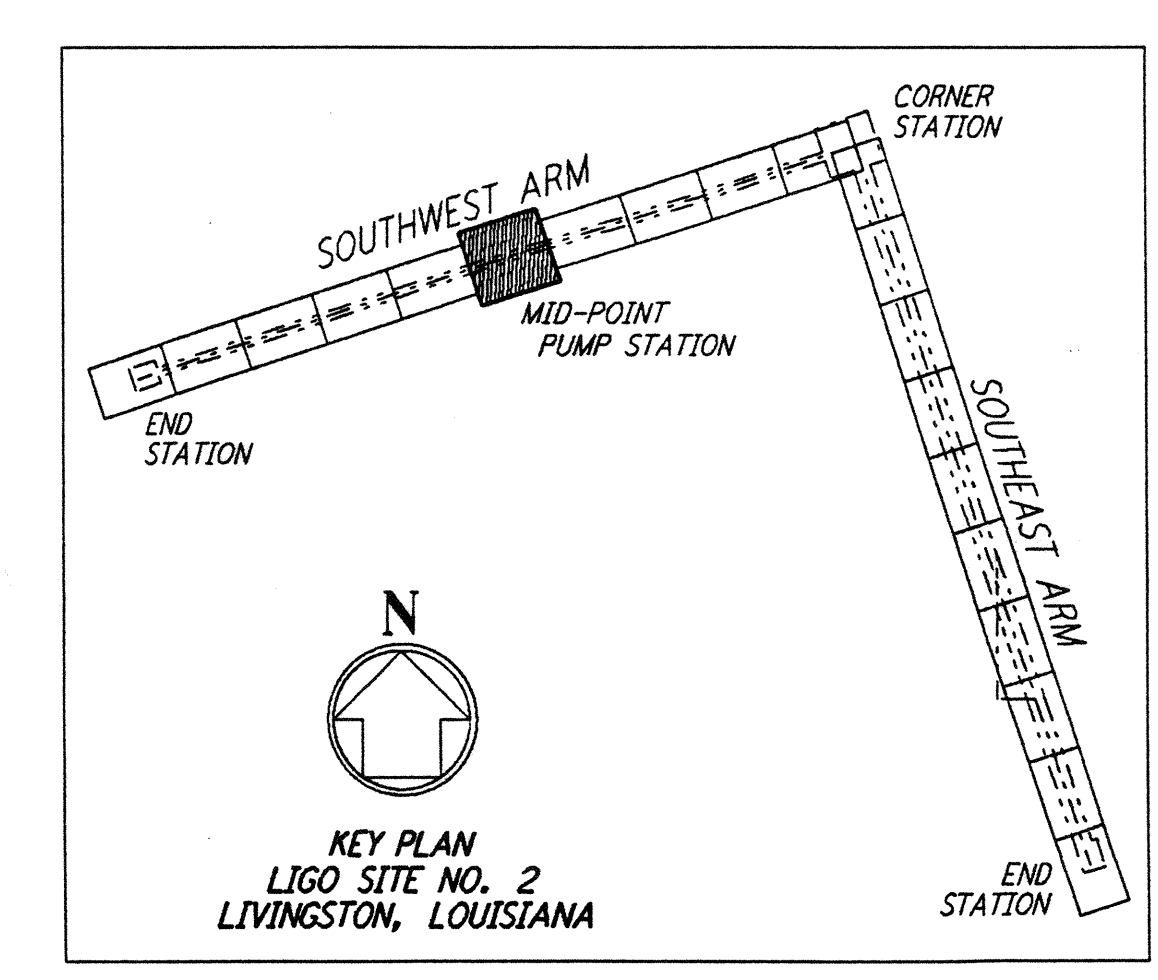


not be reproduced, copied, loaned, exhibited, or used in any other way, except by written consent from PARSONS to the borrower.

This document and the design it covers are the property of PARSONS. They are loaned only with the borrower's expressed written agreement that they will

NO.	DATE	BY	CHKD	ENGR	PROJ	DESCRIPTION
1	2-3-97	WRB	CL	EP	SPR	REVISED MID STATION, CURVE DATA

ISSUED FOR CONSTRUCTION			
DRAWN	WRB	11-15-96	
CHECKED	ML	11-15-96	
ENGINEER	JB	11-15-96	
PROJ	TDM	11-15-96	

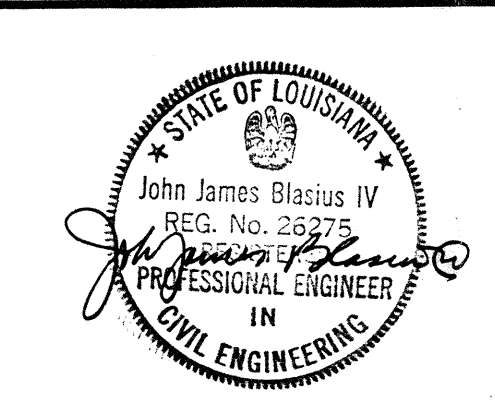

**PARSONS**  
 100 WEST WALNUT STREET  
 PASADENA, CALIFORNIA

**LIGO**  
 CALIFORNIA INSTITUTE OF TECHNOLOGY  
 MASSACHUSETTS INSTITUTE OF TECHNOLOGY

LASER INTERFEROMETER  
 GRAVITATIONAL-WAVE OBSERVATORY  
 SITE NO. 2 - LIVINGSTON, LOUISIANA

TITLE	SCALE	CONTRACT NUMBER	PROJECT NUMBER
CIVIL SOUTHWEST ARM PUMP STATION PLOT PLAN	1" = 20'	PP150969	8094
SHEET NUMBER		REVISIONS	
<b>LA-C-021</b>			