This document and the design it covers are the property of PARSONS. They are loaned only with the borrower's expressed written agreement that they will not be reproduced, copied, loaned, exhibited, or used in any other way, except by written consent from PARSONS, to the borrower.

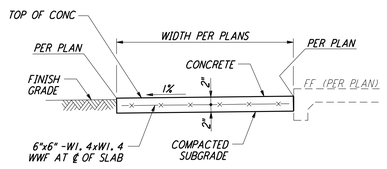

CONCRETE WALKWAY (1 / LA-C-051)

NOT TO SCALE

REF: LA-C-005, LA-C-006, LA-C-007, LA-C-008

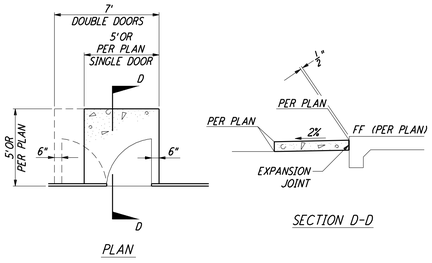

PLAN

SECTION D-D

CONCRETE STOOP (2 / LA-C-051)

NOT TO SCALE

REF: LA-C-005, LA-C-006, LA-C-025, LA-C-045

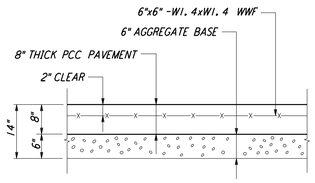

CONCRETE PAVEMENT (3 / LA-C-051)

NOT TO SCALE

REF: LA-C-005, LA-C-006, LA-C-021, LA-C-025, LA-C-041, LA-C-045

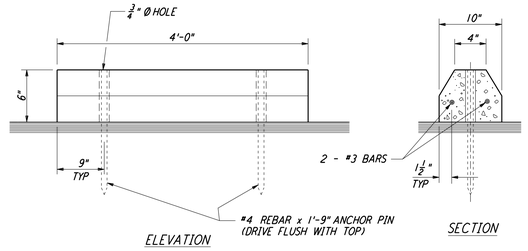

CONCRETE PARKING BUMPER (4 / LA-C-051)

NOT TO SCALE

REF: LA-C-005, LA-C-006, LA-C-021, LA-C-025, LA-C-041, LA-C-045

NOTES:

1. SEE SHEET LA-C-002 FOR GENERAL NOTES, LEGEND AND ABBREVIATIONS.

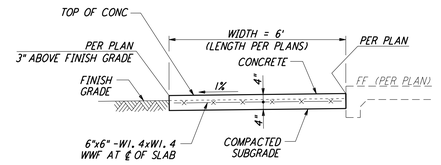

RAISED CONCRETE PAD FOR ELECTRICAL TANSFORMERS (9 / LA-C-051)

NOT TO SCALE

REF: LA-C-005

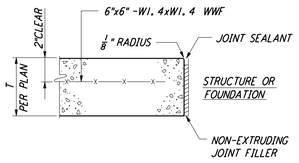

EXPANSION JOINT (EJ) (5 / LA-C-051)

NOT TO SCALE

REF: LA-C-005, LA-C-006, LA-C-021, LA-C-025, LA-C-041, LA-C-045

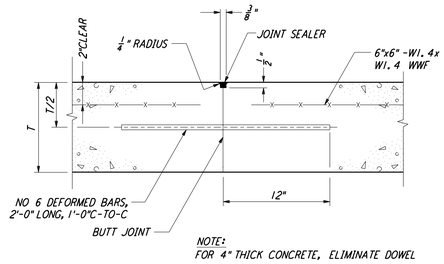

NOTE:
FOR 4" THICK CONCRETE, ELIMINATE DOWEL

CONSTRUCTION JOINT (CJ) (6 / LA-C-051)

NOT TO SCALE

(SEPARATE POURS OR END OF DAY)

REF: LA-C-005, LA-C-006, LA-C-021, LA-C-025, LA-C-041, LA-C-045

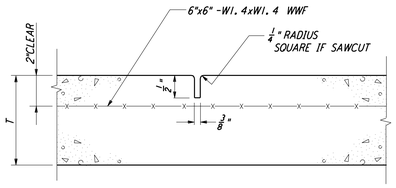

CONTRACTION JOINT (CO) (7 / LA-C-051)

NOT TO SCALE

(SPACING: 20'MAX)

REF: LA-C-005, LA-C-006, LA-C-021, LA-C-025, LA-C-041, LA-C-045

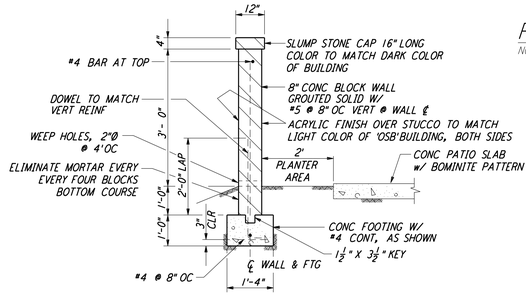

PATIO WALL (8 / LA-C-051)

NOT TO SCALE

REF: LA-C-006

BLOCK WALL ENCLOSURE DIMENSIONS					
	"L"	"L1"	"L2"	"W"	"W1"
HAZARDOUS WASTE STORAGE	30'	28'-4"	10'-8 1/2"	15'	13'-8"
TRASH ENCLOSURE	18'	16'-4"	4'-8 1/2"	10'	8'-8"

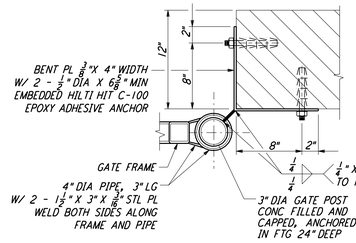

PARTIAL GATE SECTION C-C

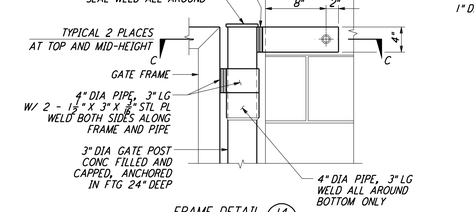

FRAME DETAIL (13 / -)

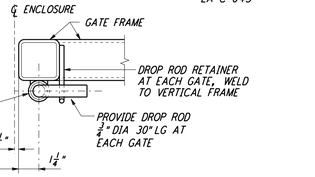

FRAME DETAIL (14 / -)

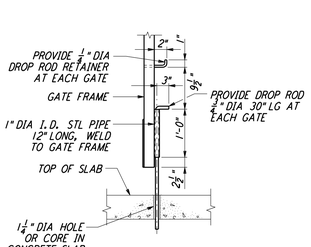

PARTIAL GATE SECTION A-A

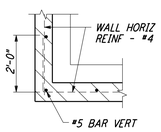

PARTIAL WALL PLAN (12 / -)

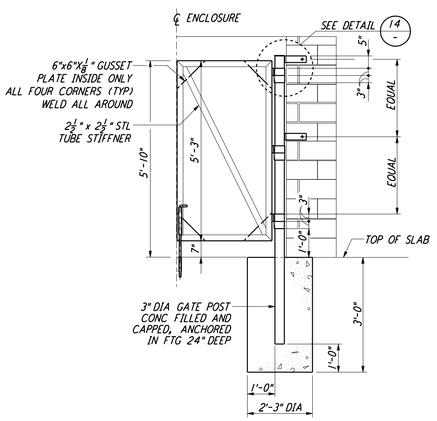

GATE ELEVATION

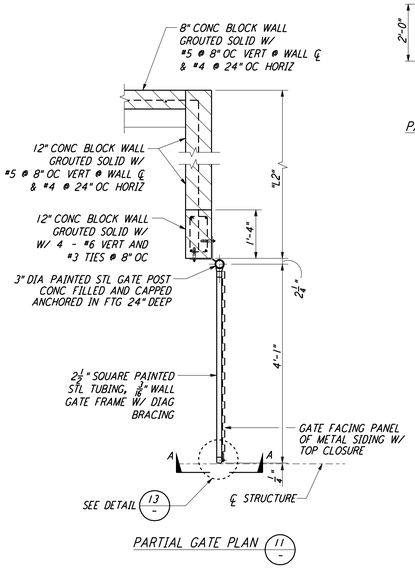

PARTIAL GATE PLAN (11 / -)

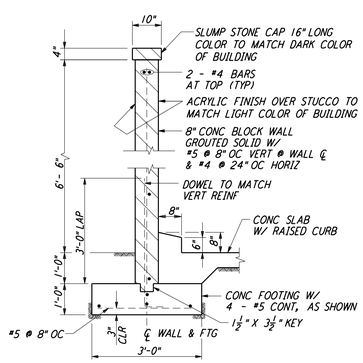

SECTION B-B

NOTE:
1. FOR SLAB FINISHED GRADES, SEE GRADING PLAN.

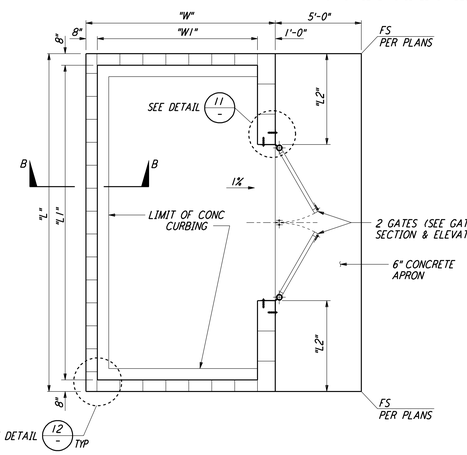

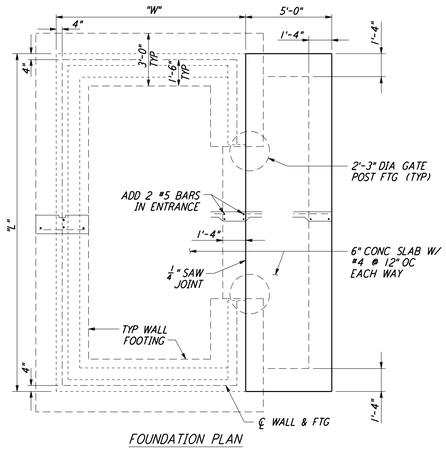

FOUNDATION PLAN

BLOCK WALL ENCLOSURE FOR TRASH AND HAZARDOUS WASTE STORAGE (10 / LA-C-051)

NOT TO SCALE

REF: LA-C-005

LIGO-D960861-01-O

REFERENCES			REVISIONS						
DRAWING NO.	DESCRIPTION		NO.	DATE	BY	CHKD	ENGR	PROJ	DESCRIPTION
			1	08-07-98	WRB				ISSUED FOR AS-BUILT

ISSUED FOR CONSTRUCTION		
DRAWN	WRB	11-15-96
CHECKED	ML	11-15-96
ENGINEER	JB	11-15-96
PROJ	TDM	11-15-96

AS-BUILT DRAWINGS

PARSONS
100 WEST WALNUT STREET
PASADENA, CALIFORNIA

LIGO
CALIFORNIA INSTITUTE OF TECHNOLOGY
MASSACHUSETTS INSTITUTE OF TECHNOLOGY

LASER INTERFEROMETER GRAVITATIONAL-WAVE OBSERVATORY
SITE NO.2 - LIVINGSTON, LOUISIANA

TITLE	SCALE	CONTRACT NUMBER	PROJECT NUMBER
CIVIL SITEWORK DETAILS SHEET 1	AS NOTED	PP150969	8094
	SHEET NUMBER		REVISIONS
	LA-C-051		1

LIGOLAF3.BDR

Tue Oct 6 16:02:17 1998 e:\plot\acf\S3-30.acf N:\DUEUES\E30B2\CE0B51.PRF