



WALL TYPE SCHEDULE

WALL TYPES LEGEND

WALL KEY	DETAIL PLAN	DESCRIPTION	WALL KEY	DETAIL PLAN	DESCRIPTION	WALL KEY	DETAIL PLAN	DESCRIPTION
18		EXTERIOR INSULATED METAL WALL PANELS (VERTICAL)	11		6" METAL STUDS 5/8" GYPSUM BOARD	4		4" METAL STUD 5/8" GYPSUM BOARD
19		7/8" SMOOTH PLASTER OVER METAL LATH 1/2" PLYWOOD 8" METAL STUDS 1/2" PLYWOOD 7/8" SMOOTH PLASTER OVER METAL LATH	12		6" METAL STUDS 1/4" CERAMIC TILE 1" GROUT/BACKER BOARD 1/4" CERAMIC TILE	5		4" METAL STUDS 5/8" GYPSUM BOARD 1" GROUT/BACKER BOARD 1/4" CERAMIC TILE
20			13		5/8" GYPSUM BOARD 6" METAL STUDS 1" GROUT/BACKER BOARD 1/4" CERAMIC TILE	6		5/8" GYPSUM BOARD 4" METAL STUD 5/8" GYPSUM BOARD
21			14		1/4" CERAMIC TILE 1" GROUT/BACKER BOARD 6" METAL STUDS 1" GROUT/BACKER BOARD 1/4" CERAMIC TILE	7		5/8" GYPSUM BOARD 4" METAL STUD 1" GROUT/BACKER BOARD 1/4" CERAMIC TILE
22			15		6" METAL STUDS 5/8" GYPSUM BOARD 5/8" GYPSUM BOARD	8		4" METAL STUD 5/8" GYPSUM BOARD 5/8" GYPSUM BOARD
23			16		5/8" GYPSUM BOARD 6" METAL STUDS 5/8" GYPSUM BOARD	9		5/8" GYPSUM BOARD 5/8" GYPSUM BOARD 4" METAL STUD 5/8" GYPSUM BOARD 5/8" GYPSUM BOARD
24			17		5/8" GYPSUM BOARD 5/8" GYPSUM BOARD 6" METAL STUDS 5/8" GYPSUM BOARD 5/8" GYPSUM BOARD	10		5/8" GYPSUM BOARD 5/8" GYPSUM BOARD 4" METAL STUD 5/8" GYPSUM BOARD 1" GROUT/BACKER BOARD 1/4" CERAMIC TILE

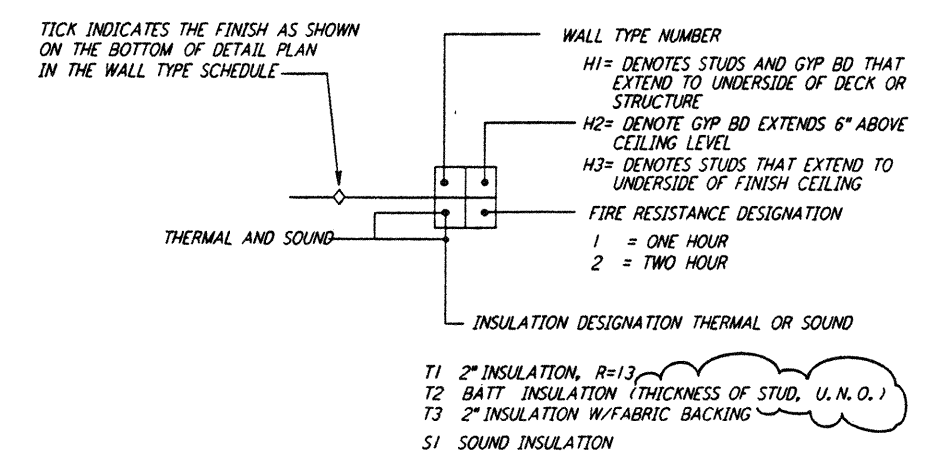

NOTE:
INDICATED INSULATION VALUES FOR THERMAL AND SOUND ARE THE MINIMUM REQUIRED VALUES

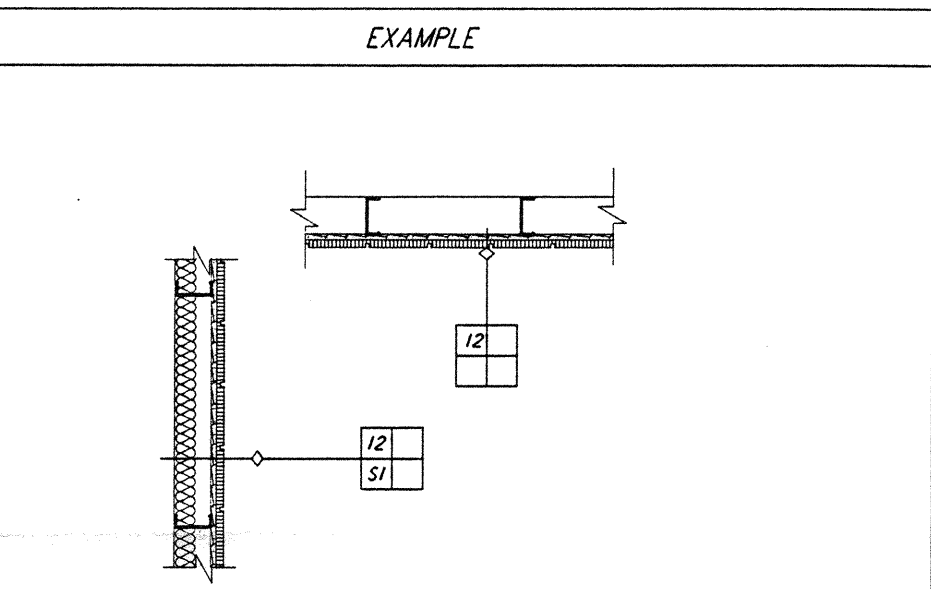


WALL KEY	DETAIL PLAN	DESCRIPTION
1		2 1/2" METAL STUD 5/8" GYPSUM BOARD
2		5/8" GYPSUM BOARD 2 1/2" METAL STUD 5/8" GYPSUM BOARD
3		1/4" CERAMIC TILE 1" GROUT/BACKER BOARD 6" METAL STUDS 1" GROUT/BACKER BOARD 1/4" CERAMIC TILE

LIGO-D960905-01-O

NO.	DATE	BY	CHKD	ENGR	PROJ	DESCRIPTION
1	2-28-97	CKT	TB	AK	TDM	CORNER STATION VSEA PARTITION

ISSUED FOR CONSTRUCTION
DRAWN CKT 11-15-96
CHECKED TB 11-15-96
ENGINEER SF 11-15-96
PROJ MDW 11-15-96

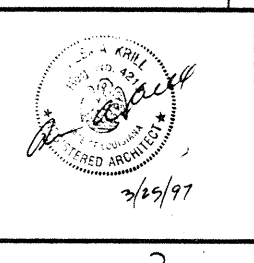

PARSONS
100 WEST WALNUT STREET
PASADENA, CALIFORNIA

LIGO
CALIFORNIA INSTITUTE OF TECHNOLOGY
MASSACHUSETTS INSTITUTE OF TECHNOLOGY

LASER INTERFEROMETER
GRAVITATIONAL-WAVE OBSERVATORY
SITE NO. 2 - LIVINGSTON, LOUISIANA

ARCHITECTURAL WALL TYPE SCHEDULES

CONTRACT NUMBER: PPI50969
PROJECT NUMBER: 8094
SHEET NUMBER: LA-A-428

This document and the design it covers are the property of PARSONS. They are loaned only with the borrower's expressed written agreement that they will not be reproduced, copied, loaned, exhibited, or used in any other way, except by written consent from PARSONS to the borrower.

I:\lgo\site2\ar\lga428.dwg 5/15/97 17:42:31