DATE: 10/07/98 TIME: 16:00:12
DESIGN FILE: I:\ligo\site2\st\las121.dgz

This document and the design it covers are the property of **PARSONS**. They are loaned only with the borrower's expressed written agreement that they will not be reproduced, copied, loaned, exhibited, or used in any other way, except by written consent from **PARSONS** to the borrower.

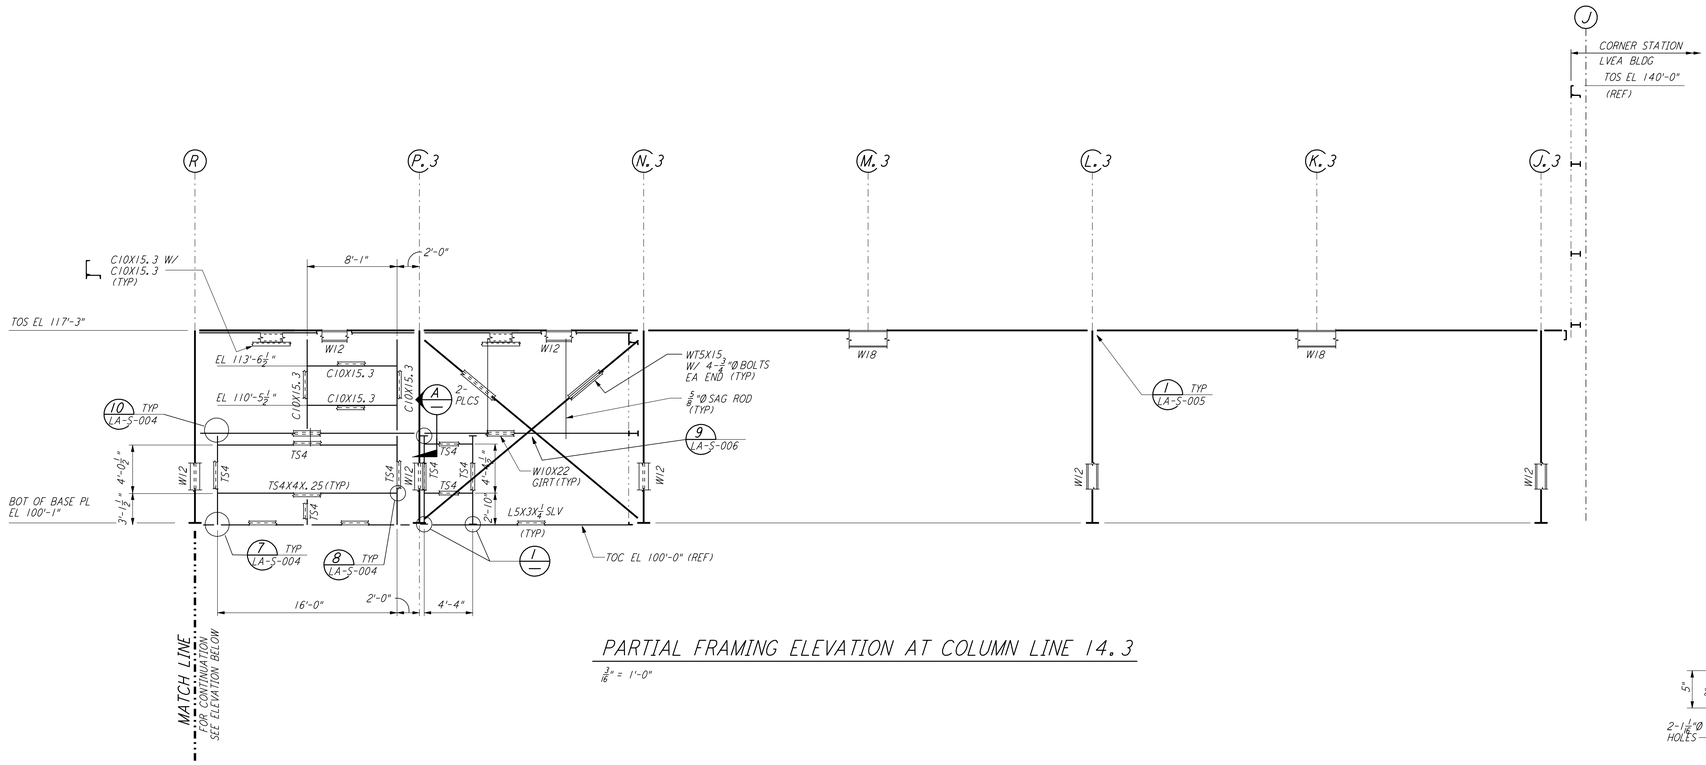


## PARTIAL FRAMING ELEVATION AT COLUMN LINE 14.3

3/16" = 1'-0"

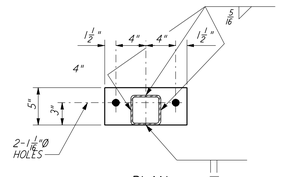


PLAN

DETAIL 1
1 1/2"=1'-0"

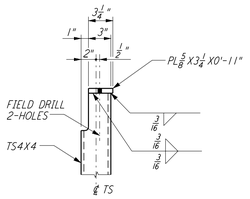


SECTION A
1 1/2"=1'-0"

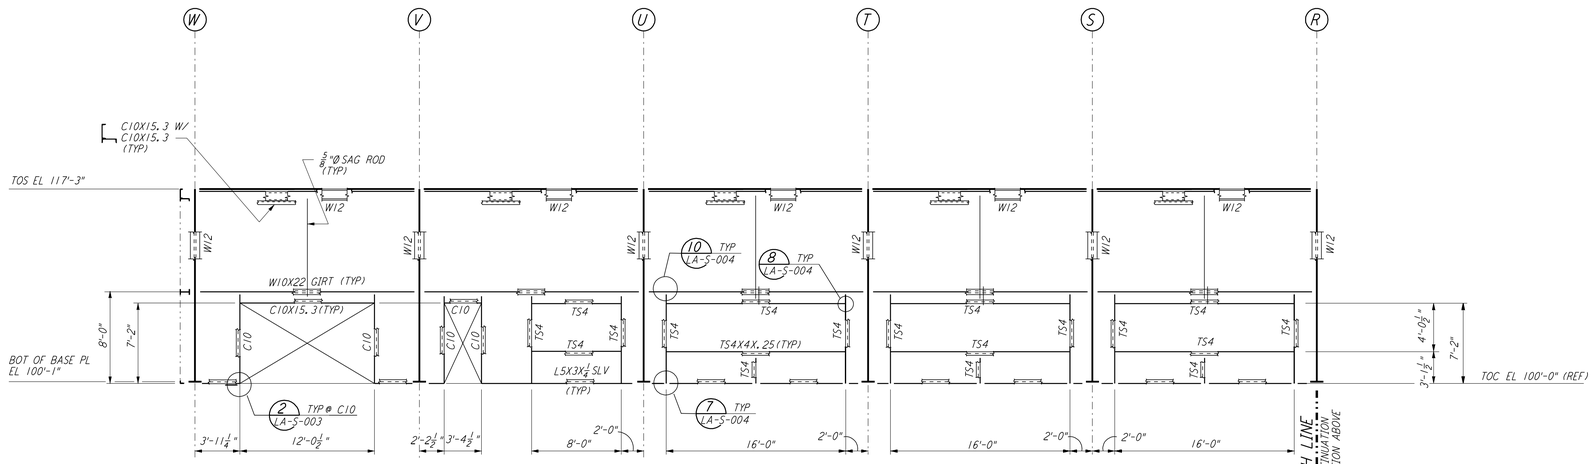


## PARTIAL FRAMING ELEVATION AT COLUMN LINE 14.3

3/16" = 1'-0"

### NOTES:

1. FOR GENERAL NOTES, ABBREVIATIONS AND SYMBOLS SEE DRAWING LA-S-001.
2. FOR CHANNEL, GIRT AND EAVE STRUT CONNECTION DETAILS SEE DRAWING LA-S-005.
3. FOR W BEAM TO COLUMN WEB/FLANGE CONNECTIONS, SEE DETAILS 6 LA-S-004, 3 LA-S-007 & 4 LA-S-007 TYPICAL UNLESS OTHERWISE NOTED.
4. FOR BASE ANGLE (L5X3) CONNECTIONS, SEE SECTION A LA-S-003.
5. FOR VERT BRCG CONNECTIONS SEE 2 LA-S-006 8 LA-S-006 1 LA-S-007 2 LA-S-007 TYP UON.

0 4 8 12 16 20FT
3/16" = 1'-0"

LIGO-D960937-02-O

REFERENCES

| DRAWING NO. | DESCRIPTION |
|---|---|

REVISIONS

| NO. | DATE | BY | CHKD | ENGR | PROJ | DESCRIPTION |
|---|---|---|---|---|---|---|
| 2 | 08-07-98 | WA | | | | ISSUED FOR AS-BUILT |
| 1 | 2-28-97 | RM | AB | BP | | REV DIM AT ELEV LN 14.3 |

| ISSUED FOR CONSTRUCTION | | |
|---|---|---|
| DRAWN | MCS | 11-15-96 |
| CHECKED | DDM | 11-15-96 |
| ENGINEER | BP | 11-15-96 |
| PROJ | TDM | 11-15-96 |

**AS-BUILT DRAWINGS**

PARSONS
100 WEST WALNUT STREET
PASADENA, CALIFORNIA

LIGO
CALIFORNIA INSTITUTE OF TECHNOLOGY
MASSACHUSETTS INSTITUTE OF TECHNOLOGY

LASER INTERFEROMETER
GRAVITATIONAL-WAVE OBSERVATORY
SITE NO.2 - LIVINGSTON, LOUISIANA

| TITLE | SCALE | CONTRACT NUMBER | PROJECT NUMBER |
|---|---|---|---|
| STRUCTURAL CORNER STATION OSB FRAMING ELEVATIONS SHEET 5 | AS NOTED | PP150969 | 8094 |

SHEET NUMBER: LA-S-121 REVISIONS: 2



LIGOLAF.BDR

Wed Oct 7 15:59:35 1998 e:\plot\wef\s3-36.epf N:\DWE\DES\SITE2082\ST121.PRF